
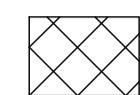


REVISIONS:

 Hatching denotes recently built extension

20.466 X 6.360 = 130.16 SQ.M.

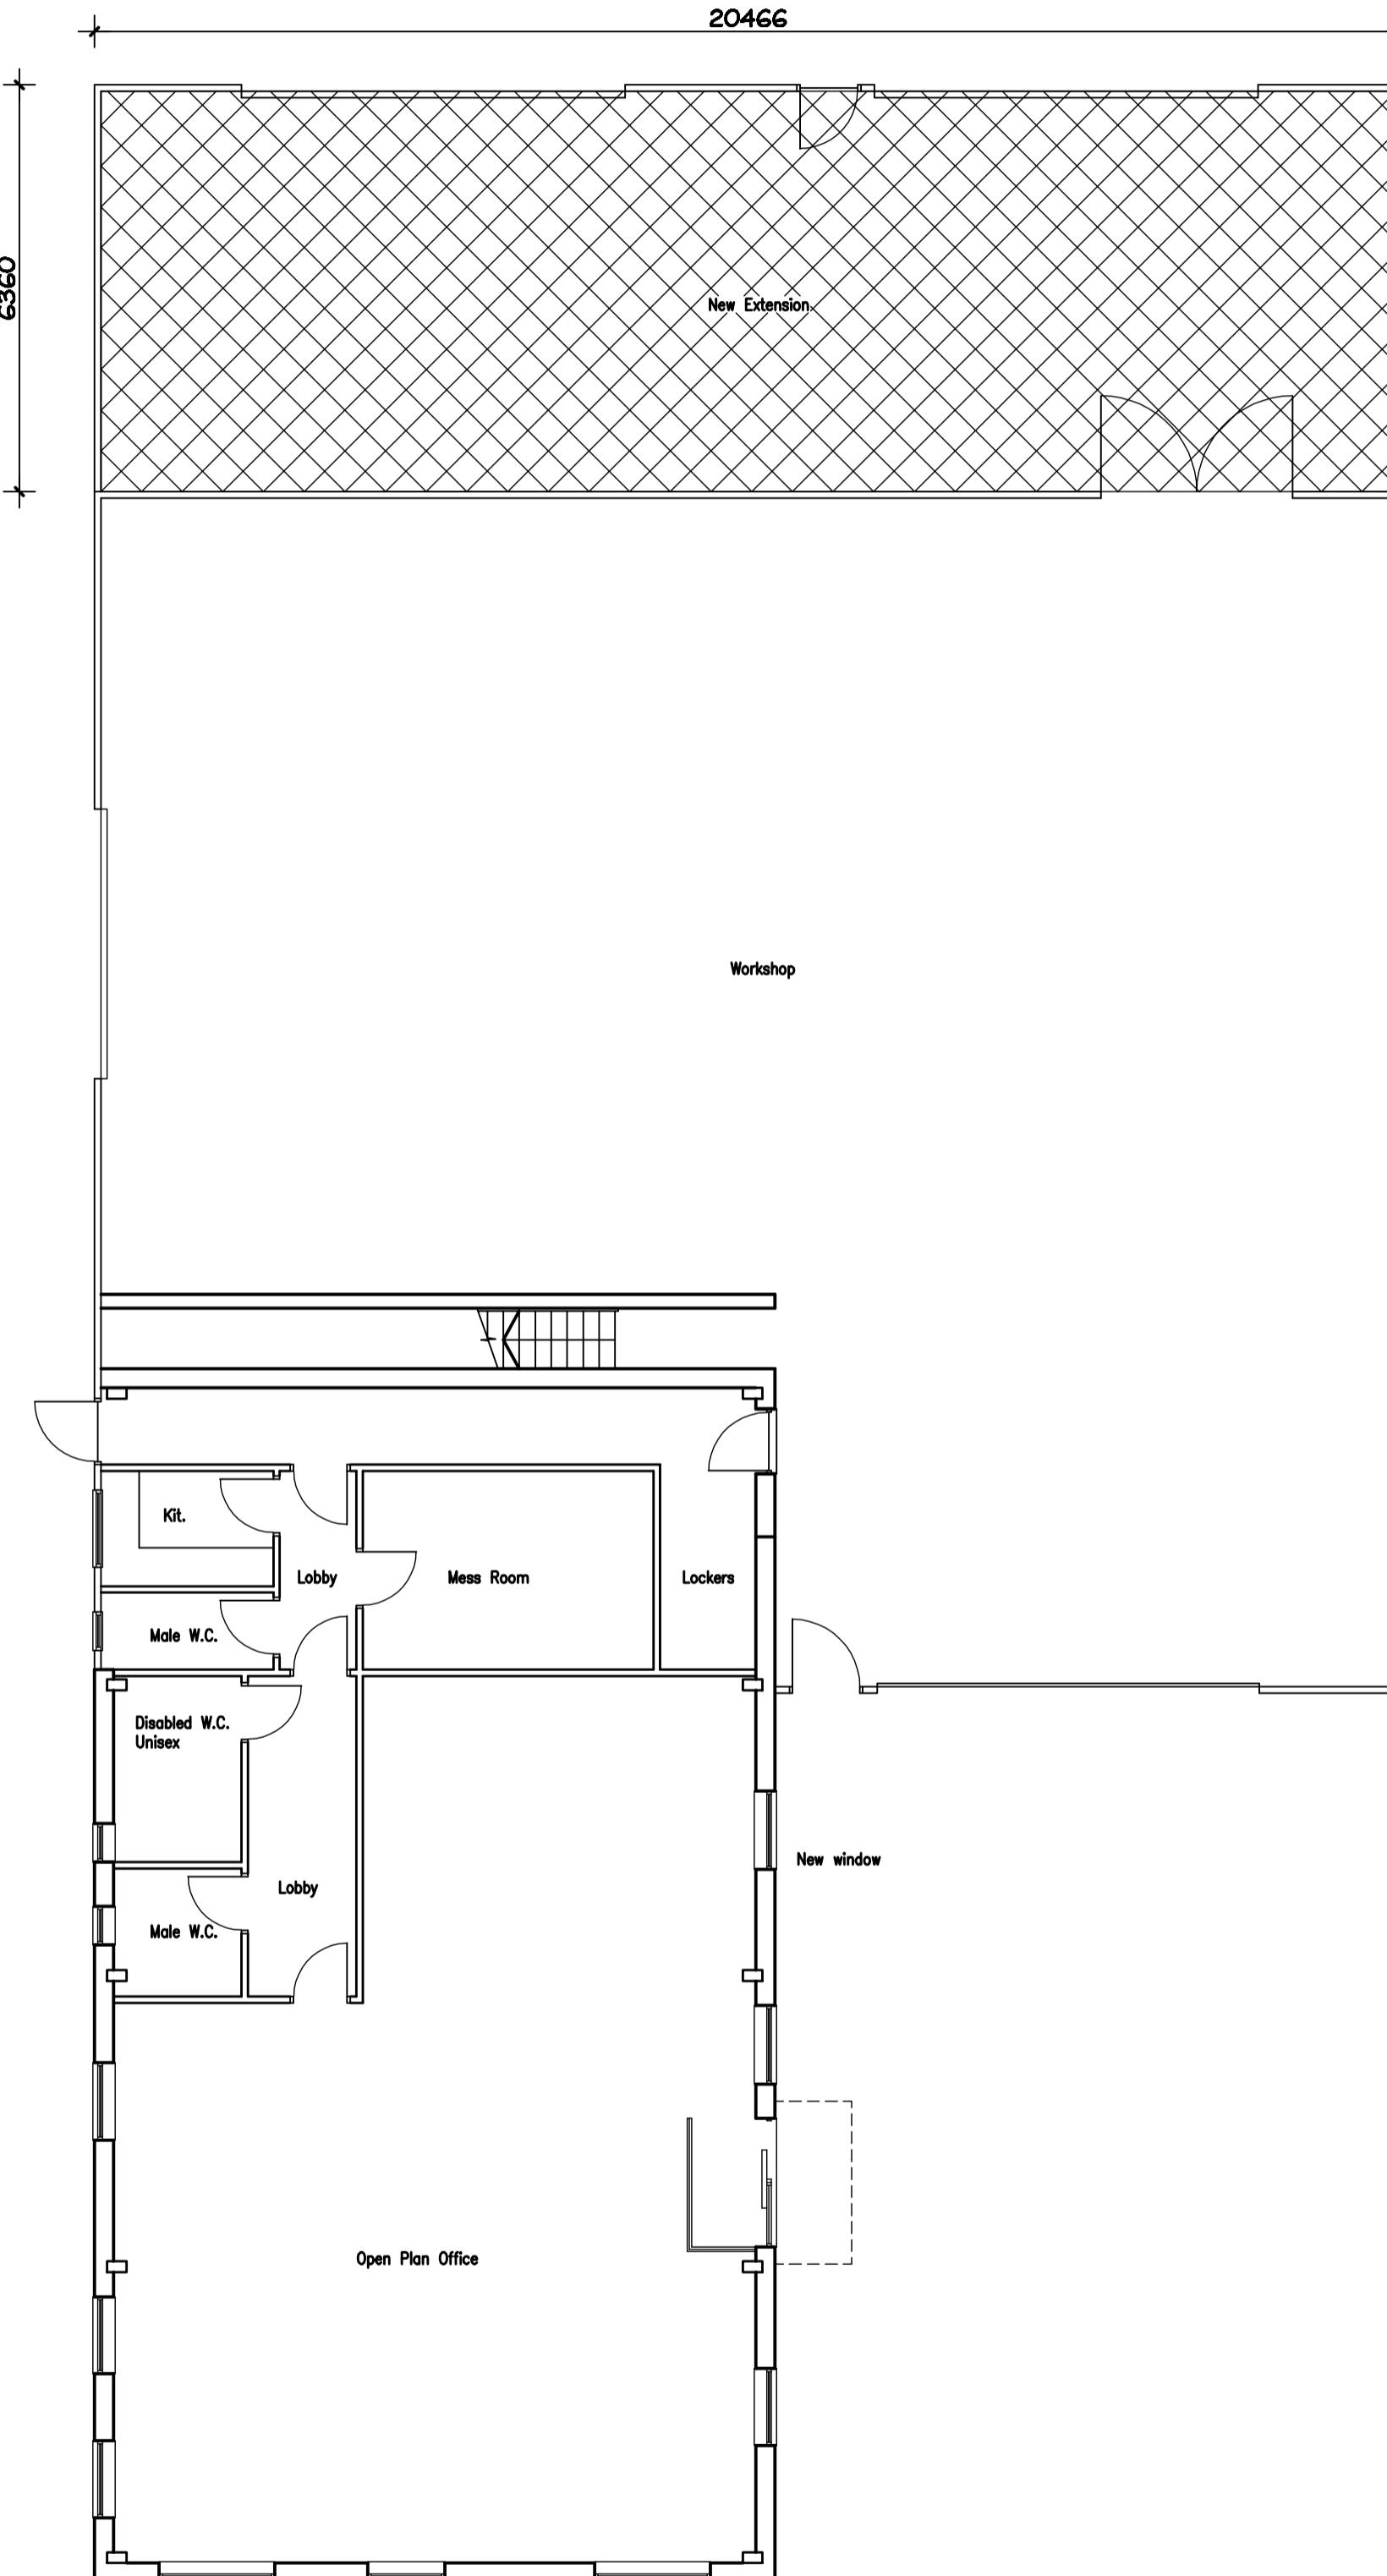


PROPOSED GROUND FLOOR PLAN

Scale 1:100


0m 5m 10m

Scale Bar - 1:100

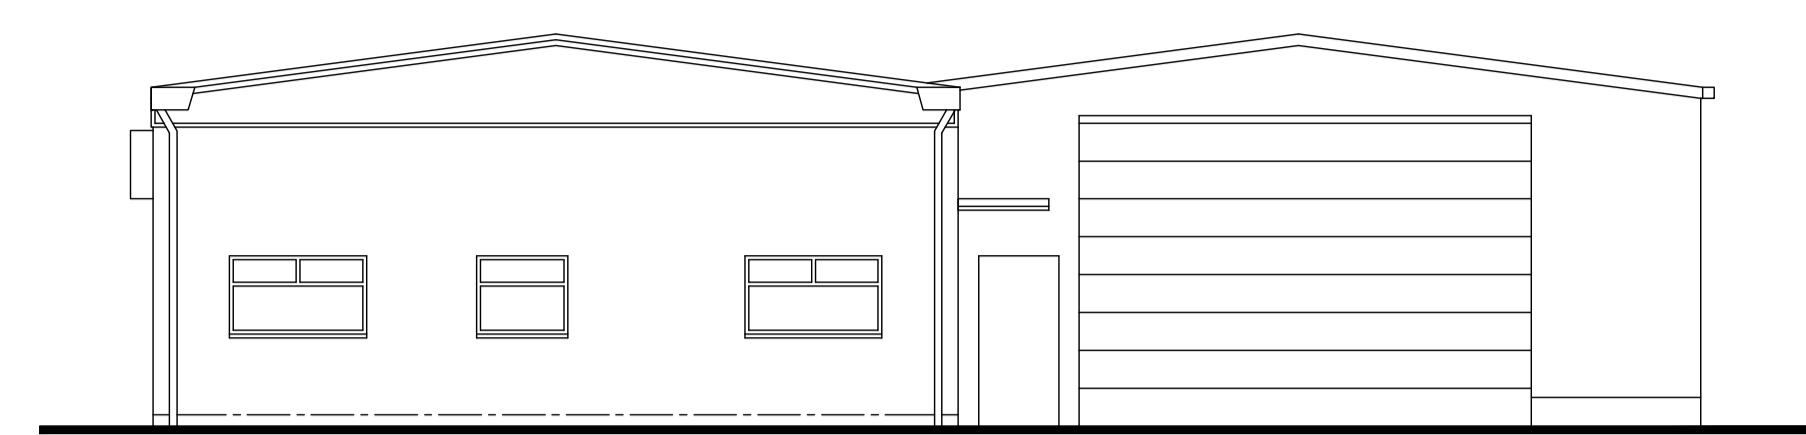


FRONT EAST ELEVATION
PROPOSED ELEVATIONS

Scale 1:100

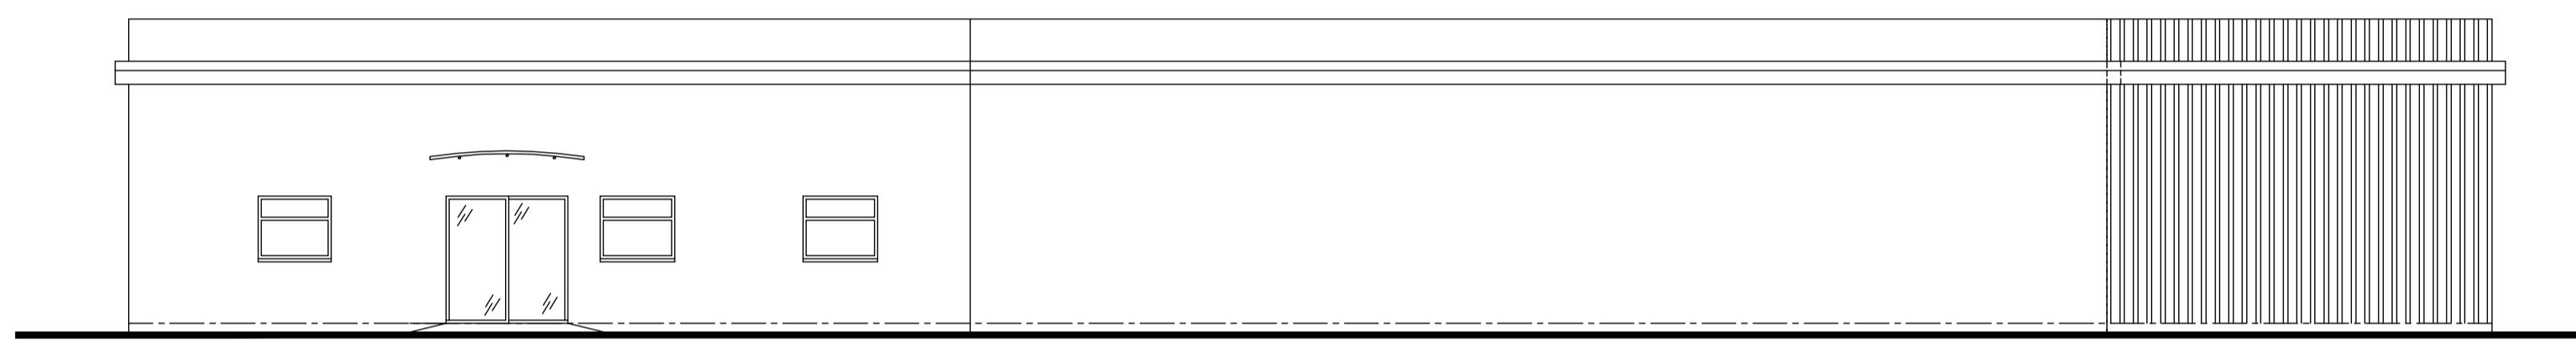


SIDE NORTH ELEVATION

New Extension

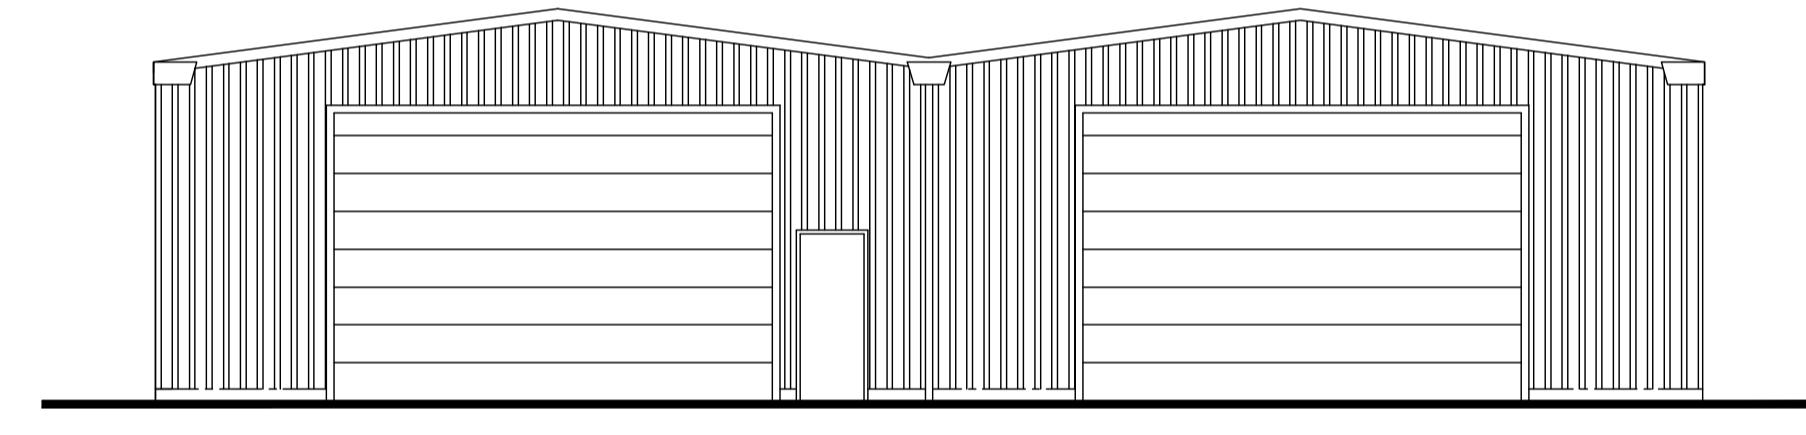

REAR WEST ELEVATION

SCHEDULE OF MATERIALS
ENTRANCE DOORS - ALUMINIUM COLOUR WHITE
WINDOWS - PVCu COLOUR BROWN

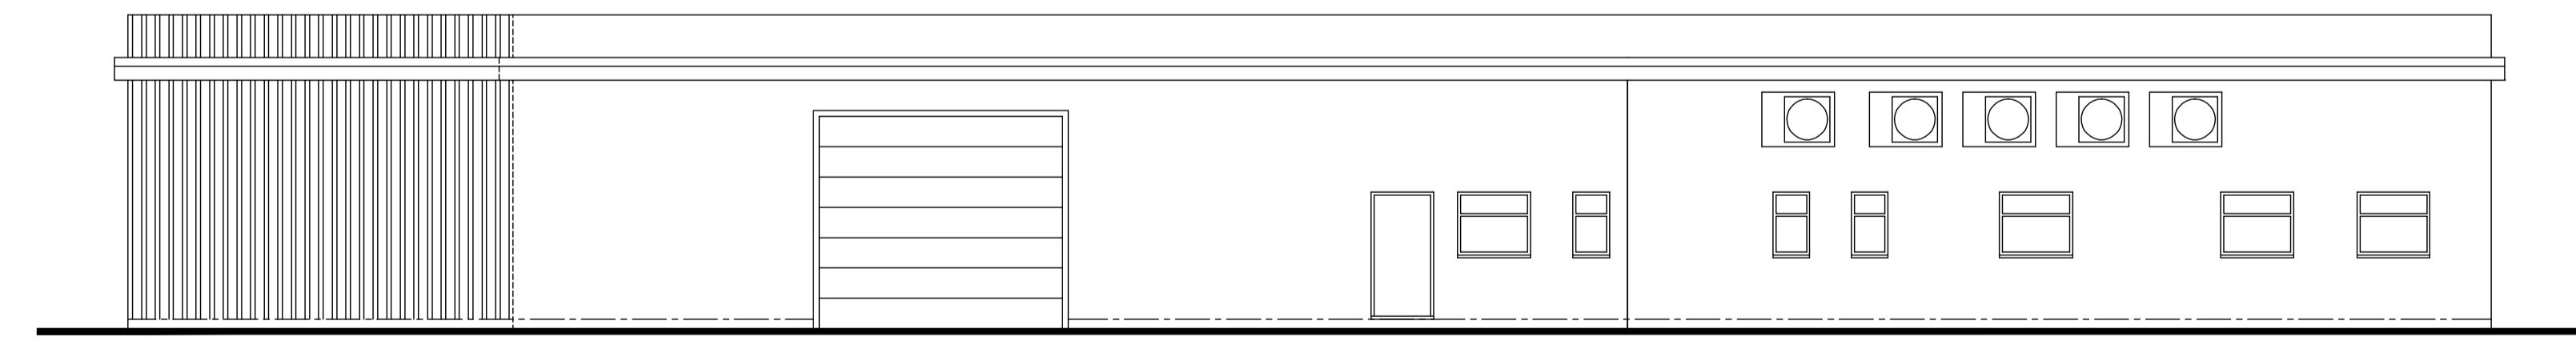

SIDE SOUTH ELEVATION

New Extension

ADCS
Architectural Design
Computer Services

30 Foxley Lane
Worthing
West Sussex
BN13 3AD
Tel: 01903 260701
E-mail:
adcs@sky.com

Client

L & W CONTRACTORS LTD

Project: **PROPOSED REAR EXTENSION**
L & W HOUSE, STANE STREET
BILLINGSHURST
WEST SUSSEX RH14 9AE

Drawing
AS-BUILT FLOOR PLAN & ELEVATIONS

Scale Date Drawn
1:100 @ A1 02.05.25 TP

Drawing No. 1626/P020

Revision