


NB. Levels quoted in metres Ordnance Newlyn Datum. The value -9999.00 indicates that no survey information is available

| Manhole Reference | Manhole Cover Level | Manhole Invert Level |
|-------------------|---------------------|----------------------|
| 9802 | 77.9 | 75.15 |
| 9851 | 81.04 | 79.21 |
| 9854 | 78.14 | 75.49 |
| 9850 | 80.82 | 79.62 |
| 9803 | 78.71 | 74.95 |
| 971A | n/a | n/a |
| 971D | n/a | n/a |
| 971B | n/a | n/a |
| 981B | n/a | n/a |
| 981A | n/a | n/a |
| 971C | n/a | n/a |
| 9955 | 80.72 | 78.57 |
| 9855 | 79.33 | 75.33 |
| 9902 | 80.61 | 79.01 |
| 9804 | 79.3 | 74.87 |
| 8902 | 85.77 | 83.98 |
| 8953 | 85.81 | 83.31 |
| 9901 | 81.52 | 79.27 |
| 9954 | 81.55 | 79.3 |
| 9960 | 83.95 | 82.02 |
| 9953 | 83.64 | 81.34 |
| 9958 | 82.14 | 79.84 |
| 9952 | 83.77 | 81.67 |
| 8952 | 86.53 | 85.39 |
| 9959 | 84.66 | 83.44 |
| 8951 | 86.65 | 85.64 |
| 8950 | 87.2 | 85.96 |
| 8956 | 86.46 | 85.05 |
| 9951 | 83.74 | 82.2 |
| 9957 | 84.7 | 83.44 |
| 891A | n/a | n/a |
| 9956 | 85.52 | 83.66 |
| 9950 | 84.48 | 82.91 |
| 8851 | 83.3 | 81.92 |
| 8802 | 83.23 | 81.52 |
| 8901 | 86.06 | 84.35 |
| 8852 | 82.84 | 81.05 |
| 8803 | 82.56 | 81.19 |
| 8804 | 82.56 | 81.08 |
| 8853 | 80.2 | 78.83 |
| 8954 | 85.05 | 83.12 |
| 8903 | 85.06 | 83.01 |
| 8854 | 78.47 | 77.18 |
| 8805 | 82.08 | 80.77 |
| 881A | n/a | n/a |
| 8750 | 77.47 | 75.79 |
| 8904 | 84.4 | 82.41 |
| 8806 | 81.78 | 80.37 |
| 881B | n/a | n/a |
| 8955 | 84.33 | 82.6 |
| 881C | n/a | n/a |
| 8905 | 83.75 | 80.74 |
| 9805 | 77.68 | 75.89 |
| 9856 | 79.35 | 78.14 |
| 981D | n/a | n/a |
| 981C | n/a | n/a |
| 9961 | 83.41 | 79.79 |
| 9801 | 81.25 | 78.98 |
| 9852 | 81.67 | 78.91 |
| 9853 | 79.14 | 77.86 |
| 5902 | 89.61 | 88 |
| 5951 | 89.66 | 88.32 |
| 5952 | 90.89 | 89.21 |
| 5901 | 89.85 | 87.8 |
| 5950 | 89.9 | 88.18 |
| 6952 | 91.77 | 89.67 |
| 6953 | 92.12 | n/a |
| 6901 | 89.4 | 87.4 |
| 6950 | 89.55 | 87.8 |
| 6956 | 91.86 | 90.6 |
| 6850 | 92.06 | 90.87 |
| 6955 | 91.83 | n/a |
| 6954 | 91.73 | 90.47 |
| 6951 | 91.17 | 89.84 |
| 6902 | 91.75 | 90.05 |
| 6903 | 91.45 | 89.73 |
| 7850 | 90.43 | 88.84 |
| 7801 | 90.37 | 88.81 |
| 7904 | 90.63 | 89.01 |
| 7802 | 90.1 | 87.99 |
| 7903 | 90.22 | 88.62 |
| 7953 | 90.66 | 89.36 |
| 7851 | 89.78 | 88.44 |
| 7952 | 90.13 | 88.89 |
| 791B | n/a | n/a |
| 791A | n/a | n/a |
| 791C | n/a | n/a |
| 781A | n/a | n/a |
| 7803 | 89.44 | 87.51 |
| 7804 | 89.24 | 87.19 |

| Manhole Reference | Manhole Cover Level | Manhole Invert Level |
|-------------------|---------------------|----------------------|
| 7805 | 87.85 | 85.91 |
| 7852 | 87.92 | 86.38 |
| 7806 | 86.89 | 85.09 |
| 7853 | 86.82 | 85.44 |
| 7902 | 88.05 | 85.36 |
| 7901 | 88.51 | 86.3 |
| 7951 | 87.87 | 86.32 |
| 7950 | 89.49 | 88.14 |
| 8801 | 85.78 | 83.89 |
| 8850 | 85.75 | 84.35 |
| 891E | n/a | n/a |


The position of the apparatus shown on this plan is given without obligation and warranty, and the accuracy cannot be guaranteed. Service pipes are not shown but their presence should be anticipated. No liability of any kind whatsoever is accepted by Thames Water for any error or omission. The actual position of mains and services must be verified and established on site before any works are undertaken.

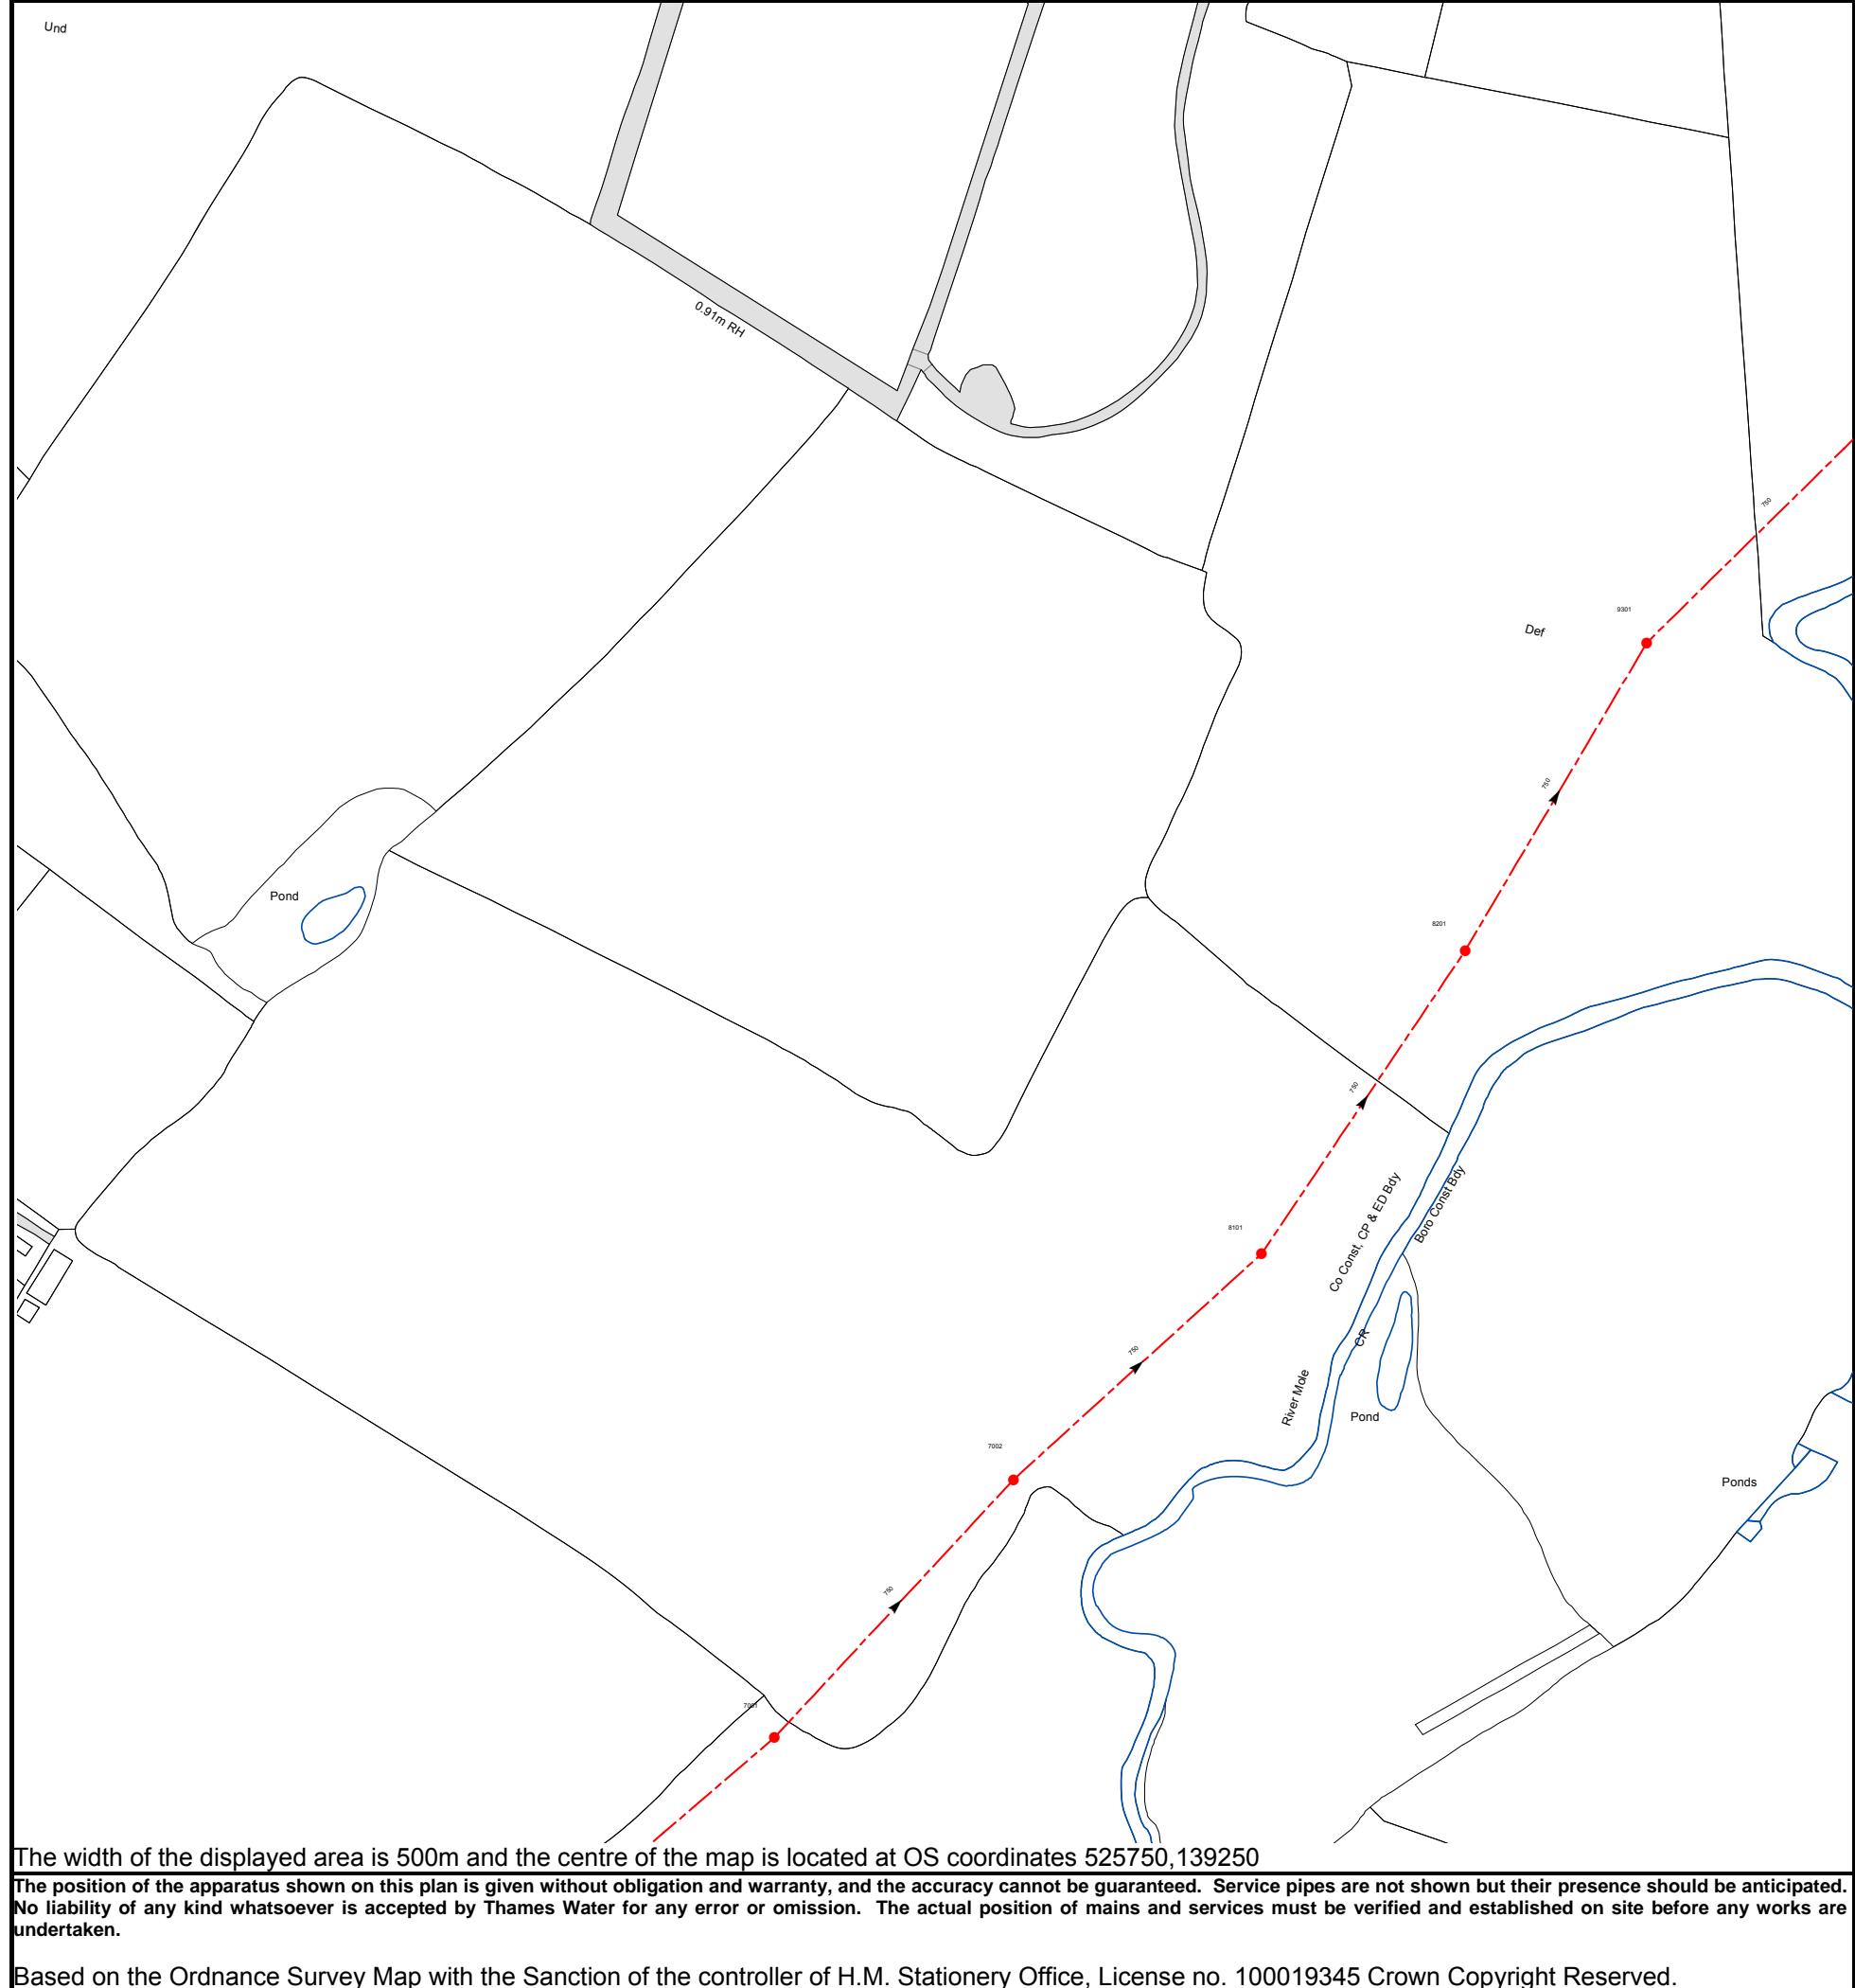

NB. Levels quoted in metres Ordnance Newlyn Datum. The value -9999.00 indicates that no survey information is available

| Manhole Reference | Manhole Cover Level | Manhole Invert Level |
|-------------------|---------------------|----------------------|
| 7001 | 61.09 | 56.43 |
| 7002 | 59.85 | 56.35 |
| 8101 | 59.77 | 56.16 |
| 8201 | 59.77 | 55.96 |
| 9301 | 59.64 | 55.83 |

The position of the apparatus shown on this plan is given without obligation and warranty, and the accuracy cannot be guaranteed. Service pipes are not shown but their presence should be anticipated. No liability of any kind whatsoever is accepted by Thames Water for any error or omission. The actual position of mains and services must be verified and established on site before any works are undertaken.

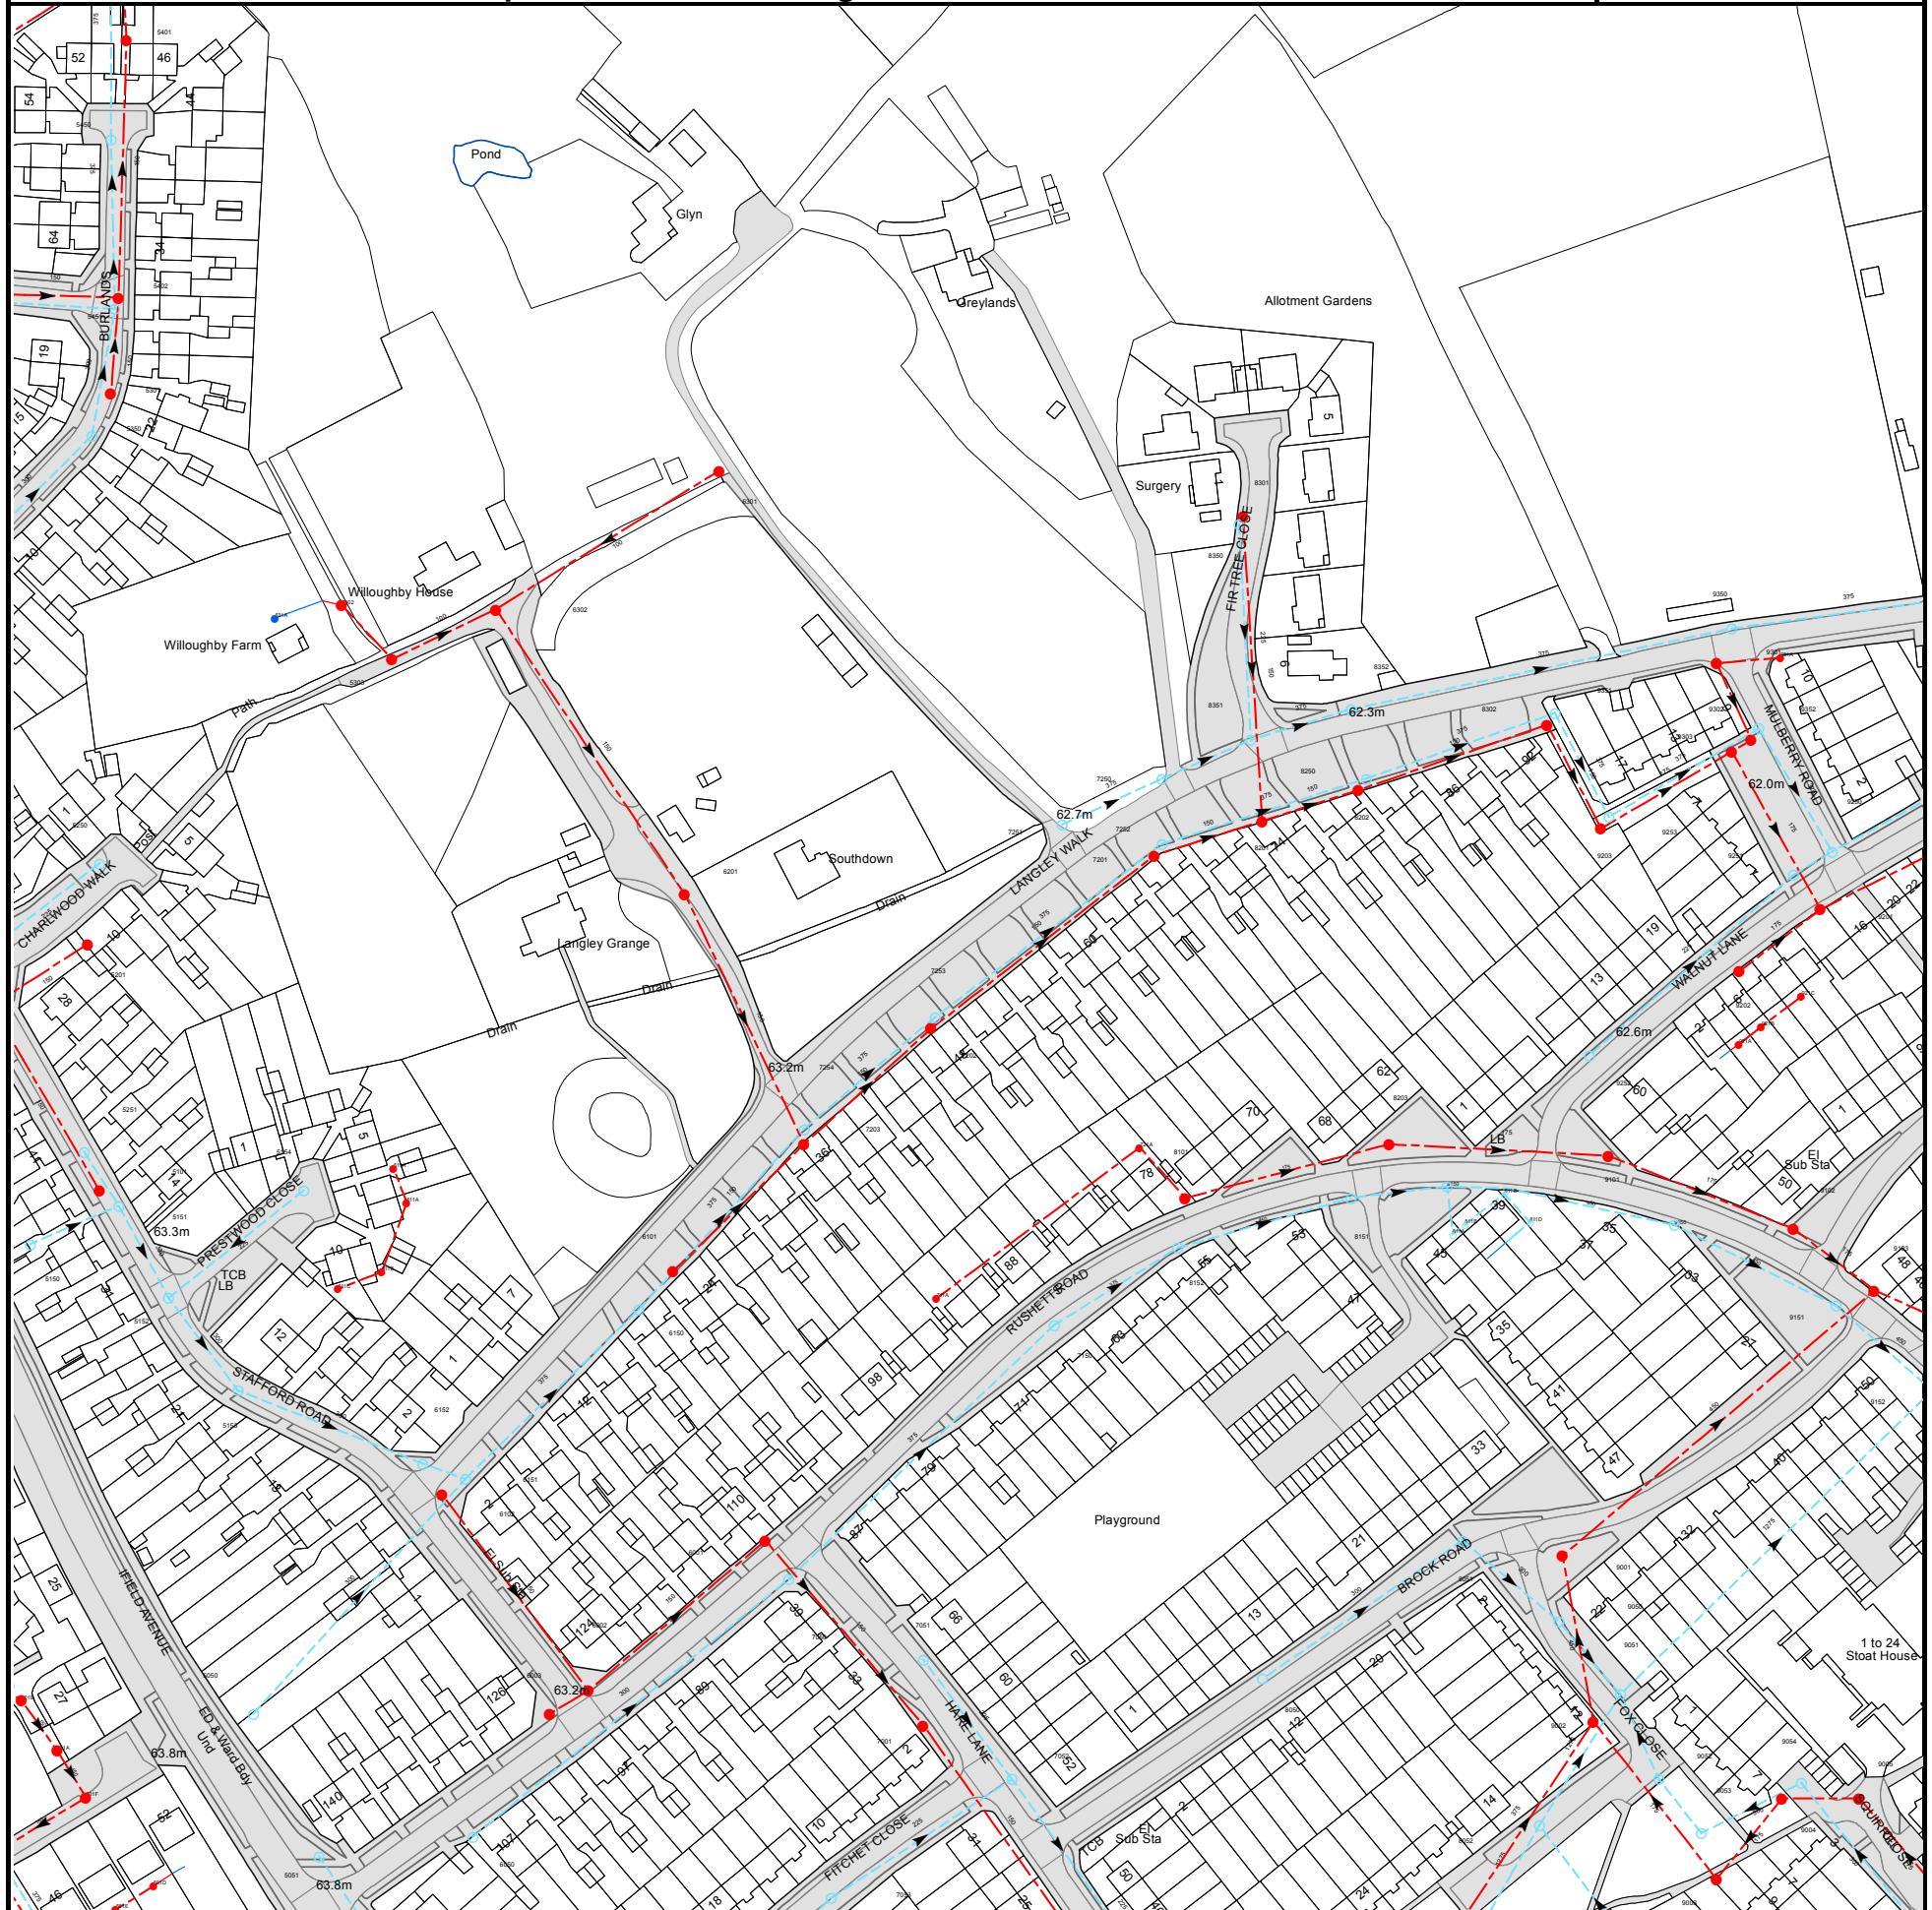

The width of the displayed area is 500m and the centre of the map is located at OS coordinates 525750,138250

The position of the apparatus shown on this plan is given without obligation and warranty, and the accuracy cannot be guaranteed. Service pipes are not shown but their presence should be anticipated. No liability of any kind whatsoever is accepted by Thames Water for any error or omission. The actual position of mains and services must be verified and established on site before any works are undertaken.

Based on the Ordnance Survey Map with the Sanction of the controller of H.M. Stationery Office, License no. 100019345 Crown Copyright Reserved.

NB. Levels quoted in metres Ordnance Newlyn Datum. The value -9999.00 indicates that no survey information is available

| Manhole Reference | Manhole Cover Level | Manhole Invert Level |
|-------------------|---------------------|----------------------|
| 9350 | n/a | n/a |
| 931A | n/a | n/a |
| 5350 | 63.55 | 61.05 |
| 5450 | 62.67 | 60.73 |
| 5301 | 63.54 | 60.85 |
| 5451 | 63.4 | 61.08 |
| 5402 | n/a | n/a |
| 5401 | 62.24 | 59.34 |
| 531A | n/a | n/a |
| 5302 | n/a | n/a |
| 5303 | 63.29 | 62.6 |
| 6302 | 63.22 | 61.96 |
| 6301 | n/a | n/a |
| 8350 | 62.53 | 61.31 |
| 8301 | 62.53 | 60.95 |
| 9301 | 62.16 | 60.73 |
| 9101 | 62.67 | 59.47 |
| 8203 | 62.78 | 60.07 |
| 9252 | 62.67 | 61.15 |
| 921A | n/a | n/a |
| 921B | n/a | n/a |
| 921C | n/a | n/a |
| 9202 | 62.37 | 59.89 |
| 9201 | 62.08 | 58.78 |
| 9251 | 62.09 | 60.13 |
| 9250 | 61.83 | 59.8 |
| 9203 | 62.54 | 59.58 |
| 9253 | 62.47 | 60.08 |
| 9303 | 62.38 | 59.08 |
| 9302 | 62.34 | 59.59 |
| 9352 | 62.17 | 59.96 |
| 8302 | 62.32 | 59.68 |
| 9351 | 62.54 | 60.18 |
| 6150 | 63.22 | 61.16 |
| 5152 | 63.02 | 61.78 |
| 511C | n/a | n/a |
| 511B | n/a | n/a |
| 5150 | 63.25 | 62.25 |
| 5151 | 63.05 | 61.92 |
| 611A | n/a | n/a |
| 5154 | 62.94 | 62.07 |
| 5101 | 63.09 | 61.68 |
| 511A | n/a | n/a |
| 5251 | 63.14 | 62.05 |
| 5201 | 63.33 | 61.47 |
| 5250 | 63.55 | 62 |
| 6101 | 63.15 | 61.4 |
| 6201 | 62.87 | 61.42 |
| 6001 | 63.22 | 60.48 |
| 7050 | 63.24 | 61.43 |
| 7254 | 62.97 | 60.98 |
| 7203 | 62.93 | 61.03 |
| 7051 | 63.46 | 61.39 |
| 7001 | 63.53 | 60.02 |
| 7202 | 62.77 | 60.71 |
| 7253 | 62.76 | 60.83 |
| 711A | n/a | n/a |
| 7052 | 63.24 | 61.19 |
| 7150 | 63.11 | 61.05 |
| 7251 | n/a | n/a |
| 721A | n/a | n/a |
| 7201 | 62.55 | 60.25 |
| 7252 | 62.57 | 60.61 |
| 7250 | 62.62 | 60.79 |
| 8152 | 62.95 | 60.87 |
| 8101 | 63.06 | 60.42 |
| 8351 | 62.44 | 60.57 |
| 8201 | 62.47 | 60.11 |
| 8050 | 62.89 | 61.24 |
| 8352 | 62.45 | 60.35 |
| 8151 | 62.66 | 60.69 |
| 8202 | 62.43 | 59.96 |
| 8250 | 62.39 | 60.42 |
| 9004 | 62.2 | 59.63 |
| 9005 | 62.05 | 59.88 |
| 9054 | 61.94 | 60.69 |
| 9052 | 61.92 | 60.45 |
| 9002 | 62.24 | 58.67 |
| 9051 | 62.15 | 59.45 |
| 9050 | 62.36 | 60.6 |
| 9001 | 62.49 | 58.49 |
| 8051 | 62.66 | 60.78 |
| 9152 | 61.83 | 59.06 |
| 9151 | 62.01 | 60.05 |
| 9103 | 62.05 | 58.25 |
| 811A | n/a | n/a |
| 9102 | 62.21 | 58.75 |
| 9150 | 62.24 | 60.26 |
| 811B | n/a | n/a |
| 811D | n/a | n/a |

| Manhole Reference | Manhole Cover Level | Manhole Invert Level |
|-------------------|---------------------|----------------------|
| 811C | n/a | n/a |
| 8150 | 62.54 | 60.52 |
| 9003 | 62.12 | 59.35 |
| 9053 | 62.11 | 60.57 |
| 8052 | 62.21 | 59.63 |
| 7053 | 63.47 | 61.56 |
| 501E | n/a | n/a |
| 501D | n/a | n/a |
| 5051 | 63.85 | 62.16 |
| 6050 | 63.67 | 61.92 |
| 501F | 63.77 | 61.96 |
| 501A | 63.62 | 62.05 |
| 6003 | 63.32 | 60.93 |
| 5050 | 63.71 | 61.71 |
| 501B | 63.44 | 62.17 |
| 6002 | 63.28 | 60.81 |
| 6102 | 63.6 | 61.23 |
| 6151 | 63.48 | 61.41 |
| 6152 | 63.6 | 61.51 |
| 5153 | 63.17 | 61.65 |

The position of the apparatus shown on this plan is given without obligation and warranty, and the accuracy cannot be guaranteed. Service pipes are not shown but their presence should be anticipated. No liability of any kind whatsoever is accepted by Thames Water for any error or omission. The actual position of mains and services must be verified and established on site before any works are undertaken.



ALS Sewer Map Key

Public Sewer Types (Operated & Maintained by Thames Water)

| | |
|--|---|
| | Foul: A sewer designed to convey waste water from domestic and industrial sources to a treatment works. |
| | Surface Water: A sewer designed to convey surface water (e.g. rain water from roofs, yards and car parks) to rivers or watercourses. |
| | Combined: A sewer designed to convey both waste water and surface water from domestic and industrial sources to a treatment works. |
| | Trunk Surface Water |
| | Trunk Foul |
| | Storm Relief |
| | Trunk Combined |
| | Vent Pipe |
| | Bio-solids (Sludge) |
| | Proposed Thames Surface Water Sewer |
| | Proposed Thames Water Foul Sewer |
| | Gallery |
| | Foul Rising Main |
| | Surface Water Rising Main |
| | Combined Rising Main |
| | Sludge Rising Main |
| | Vacuum |

Notes:

- 1) All levels associated with the plans are to Ordnance Datum Newlyn.
- 2) All measurements on the plans are metric.
- 3) Arrows (on gravity fed sewers) or flecks (on rising mains) indicate direction of flow.
- 4) Most private pipes are not shown on our plans, as in the past, this information has not been recorded.
- 5) 'na' or '0' on a manhole level indicates that data is unavailable.

Sewer Fittings

A feature in a sewer that does not affect the flow in the pipe. Example: a vent is a fitting as the function of a vent is to release excess gas.

| | |
|--|-------------|
| | Air Valve |
| | Dam Chase |
| | Fitting |
| | Meter |
| | Vent Column |

Operational Controls

A feature in a sewer that changes or diverts the flow in the sewer. Example: A hydrobrake limits the flow passing downstream.

| | |
|--|---------------|
| | Control Valve |
| | Drop Pipe |
| | Ancillary |
| | Weir |

End Items

End symbols appear at the start or end of a sewer pipe. Examples: an Undefined End at the start of a sewer indicates that Thames Water has no knowledge of the position of the sewer upstream of that symbol. Outfall on a surface water sewer indicates that the pipe discharges into a stream or river.

| | |
|--|---------------|
| | Outfall |
| | Undefined End |
| | Inlet |

Other Symbols

Symbols used on maps which do not fall under other general categories

| | |
|--|---|
| | Public/Private Pumping Station |
| | Change of characteristic indicator (C.O.C.I.) |
| | Invert Level |
| | Summit |

Areas

Lines denoting areas of underground surveys, etc.

| | |
|--|------------------|
| | Agreement |
| | Operational Site |
| | Chamber |
| | Tunnel |
| | Conduit Bridge |

Other Sewer Types (Not Operated or Maintained by Thames Water)

| | | | |
|--|-----------------------|--|---------------------|
| | Foul Sewer | | Surface Water Sewer |
| | Combined Sewer | | Gully |
| | Culverted Watercourse | | Proposed |
| | Abandoned Sewer | | |

Terms and Conditions

All sales are made in accordance with Thames Water Utilities Limited (TWUL) standard terms and conditions unless previously agreed in writing.

1. All goods remain in the property of Thames Water Utilities Ltd until full payment is received.
2. Provision of service will be in accordance with all legal requirements and published TWUL policies.
3. All invoices are strictly due for payment 14 days from due date of the invoice. Any other terms must be accepted/agreed in writing prior to provision of goods or service, or will be held to be invalid.
4. Thames Water does not accept post-dated cheques-any cheques received will be processed for payment on date of receipt.
5. In case of dispute TWUL's terms and conditions shall apply.
6. Penalty interest may be invoked by TWUL in the event of unjustifiable payment delay. Interest charges will be in line with UK Statute Law 'The Late Payment of Commercial Debts (Interest) Act 1998'.
7. Interest will be charged in line with current Court Interest Charges, if legal action is taken.
8. A charge may be made at the discretion of the company for increased administration costs.

A copy of Thames Water's standard terms and conditions are available from the Commercial Billing Team (cashoperations@thameswater.co.uk).

We publish several Codes of Practice including a guaranteed standards scheme. You can obtain copies of these leaflets by calling us on 0800 316 9800

If you are unhappy with our service you can speak to your original goods or customer service provider. If you are not satisfied with the response, your complaint will be reviewed by the Customer Services Director. You can write to her at: Thames Water Utilities Ltd. PO Box 492, Swindon, SN38 8TU.

If the Goods or Services covered by this invoice falls under the regulation of the 1991 Water Industry Act, and you remain dissatisfied you can refer your complaint to Consumer Council for Water on 0121 345 1000 or write to them at Consumer Council for Water, 1st Floor, Victoria Square House, Victoria Square, Birmingham, B2 4AJ.

Ways to pay your bill

| Credit Card | BACS Payment | Telephone Banking | Cheque |
|--|---|---|---|
| Call 0845 070 9148 quoting your invoice number starting CBA or ADS / OSS | Account number 90478703 Sort code 60-00-01 A remittance advice must be sent to: Thames Water Utilities Ltd., PO Box 3189, Slough SL1 4WW. or email ps.billing@thameswater.co.uk | By calling your bank and quoting: Account number 90478703 Sort code 60-00-01 and your invoice number | Made payable to ' Thames Water Utilities Ltd' Write your Thames Water account number on the back. Send to: Thames Water Utilities Ltd., PO Box 3189, Slough SL1 4WW or by DX to 151280 Slough 13 |

Thames Water Utilities Ltd Registered in England & Wales No. 2366661 Registered Office Clearwater Court, Vastern Rd, Reading, Berks, RG1 8DB.

Search Code



IMPORTANT CONSUMER PROTECTION INFORMATION

This search has been produced by Thames Water Property Searches, Clearwater Court, Vastern Road, Reading RG1 8DB, which is registered with the Property Codes Compliance Board (PCCB) as a subscriber to the Search Code. The PCCB independently monitors how registered search firms maintain compliance with the Code.

The Search Code:

- provides protection for homebuyers, sellers, estate agents, conveyancers and mortgage lenders who rely on the information included in property search reports undertaken by subscribers on residential and commercial property within the United Kingdom
- sets out minimum standards which firms compiling and selling search reports have to meet
- promotes the best practise and quality standards within the industry for the benefit of consumers and property professionals
- enables consumers and property professionals to have confidence in firms which subscribe to the code, their products and services.

By giving you this information, the search firm is confirming that they keep to the principles of the Code. This provides important protection for you.

The Code's core principles

Firms which subscribe to the Search Code will:

- display the Search Code logo prominently on their search reports
- act with integrity and carry out work with due skill, care and diligence
- at all times maintain adequate and appropriate insurance to protect consumers
- conduct business in an honest, fair and professional manner
- handle complaints speedily and fairly
- ensure that products and services comply with industry registration rules and standards and relevant laws
- monitor their compliance with the Code

Complaints

If you have a query or complaint about your search, you should raise it directly with the search firm, and if appropriate ask for any complaint to be considered under their formal internal complaints procedure. If you remain dissatisfied with the firm's final response, after your complaint has been formally considered, or if the firm has exceeded the response timescales, you may refer your complaint for consideration under The Property Ombudsman scheme (TPOs). The Ombudsman can award compensation of up to £5,000 to you if he finds that you have suffered actual loss as a result of your search provider failing to keep to the Code.

Please note that all queries or complaints regarding your search should be directed to your search provider in the first instance, not to TPOs or to the PCCB.

TPOs Contact Details

The Property Ombudsman scheme
Milford House
43-55 Milford Street
Salisbury
Wiltshire SP1 2BP
Tel: 01722 333306
Fax: 01722 332296
Email: admin@tpos.co.uk

You can get more information about the PCCB from www.propertycodes.org.uk

PLEASE ASK YOUR SEARCH PROVIDER IF YOU WOULD LIKE A COPY OF THE SEARCH CODE

Asset location search



Property Searches

Mrs Asil Amin
Arcadis Consulting UK Ltd
Arcadis Cymru House
1 Fortran Road
CARDIFF
CF3 0EY

Search address supplied 522500 136000
Land Of Ifield
London Road
RH12 4SL

Your reference N/A

Our reference ALS/ALS Non Chargeable/2018_3857215

Search date 22 August 2018

Keeping you up-to-date

Notification of Price Changes

From 1 September 2018 Thames Water Property Searches will be increasing the price of its Asset Location Search in line with RPI at 3.23%.

For further details on the price increase please visit our website: www.thameswater-propertysearches.co.uk
Please note that any orders received with a higher payment prior to the 1 September 2018 will be non-refundable.



Thames Water Utilities Ltd
Property Searches, PO Box 3189, Slough SL1 4WW
DX 151280 Slough 13



searches@thameswater.co.uk
www.thameswater-propertysearches.co.uk



0845 070 9148



Asset location search



Property Searches

Search address supplied: 522500 136000, Land Of Ifield, London Road, RH12 4SL

Dear Sir / Madam

An Asset Location Search is recommended when undertaking a site development. It is essential to obtain information on the size and location of clean water and sewerage assets to safeguard against expensive damage and allow cost-effective service design.

The following records were searched in compiling this report: - the map of public sewers & the map of waterworks. Thames Water Utilities Ltd (TWUL) holds all of these.

This search provides maps showing the position, size of Thames Water assets close to the proposed development and also manhole cover and invert levels, where available.

Please note that none of the charges made for this report relate to the provision of Ordnance Survey mapping information. The replies contained in this letter are given following inspection of the public service records available to this company. No responsibility can be accepted for any error or omission in the replies.

You should be aware that the information contained on these plans is current only on the day that the plans are issued. The plans should only be used for the duration of the work that is being carried out at the present time. Under no circumstances should this data be copied or transmitted to parties other than those for whom the current work is being carried out.

Thames Water do update these service plans on a regular basis and failure to observe the above conditions could lead to damage arising to new or diverted services at a later date.

Contact Us

If you have any further queries regarding this enquiry please feel free to contact a member of the team on 0845 070 9148, or use the address below:

Thames Water Utilities Ltd
Property Searches
PO Box 3189
Slough
SL1 4WW

Email: searches@thameswater.co.uk

Web: www.thameswater-propertysearches.co.uk

Asset location search



Property Searches

Waste Water Services

Please provide a copy extract from the public sewer map.

The following quartiles have been printed as they fall within Thames' sewerage area:

TQ2337SE
TQ2336SE
TQ2336NE
TQ2335NE

Enclosed is a map showing the approximate lines of our sewers. Our plans do not show sewer connections from individual properties or any sewers not owned by Thames Water unless specifically annotated otherwise. Records such as "private" pipework are in some cases available from the Building Control Department of the relevant Local Authority.

Where the Local Authority does not hold such plans it might be advisable to consult the property deeds for the site or contact neighbouring landowners.

This report relates only to sewerage apparatus of Thames Water Utilities Ltd, it does not disclose details of cables and or communications equipment that may be running through or around such apparatus.

The sewer level information contained in this response represents all of the level data available in our existing records. Should you require any further Information, please refer to the relevant section within the 'Further Contacts' page found later in this document.

The following quartiles have not been printed as they contain no assets:

TQ2437NW
TQ2135SE
TQ2236SE
TQ2237SE
TQ2335NW
TQ2338SE
TQ2234NE
TQ2234SW
TQ2134SE
TQ2136SE
TQ2337NE
TQ2236NW
TQ2235SW
TQ2137SE
TQ2235NE
TQ2235NW
TQ2235SE
TQ2234NW

Asset location search



Property Searches

TQ2134NE
TQ2337NW
TQ2336NW
TQ2136NE
TQ2236NE
TQ2135NE
TQ2234SE
TQ2236SW
TQ2337SW
TQ2336SW
TQ2237SW

For your guidance:

- The Company is not generally responsible for rivers, watercourses, ponds, culverts or highway drains. If any of these are shown on the copy extract they are shown for information only.
- Any private sewers or lateral drains which are indicated on the extract of the public sewer map as being subject to an agreement under Section 104 of the Water Industry Act 1991 are not an 'as constructed' record. It is recommended these details be checked with the developer.

Clean Water Services

Please provide a copy extract from the public water main map.

Following examination of our statutory maps, Thames Water has been unable to find any plans of water mains within this area. If you require a connection to the public water supply system, please write to:

New Connections / Diversions
Thames Water
Network Services Business Centre
Brentford
Middlesex
TW8 0EE

Tel: 0845 850 2777
Fax: 0207 713 3858
Email: developer.services@thameswater.co.uk

The following quartiles have not been printed as they are out of Thames' water catchment area. For details of the assets requested please contact the water company indicated below:

TQ2437NW Southern
TQ2135SE Southern

Asset location search



Property Searches

| | |
|----------|----------|
| TQ2236SE | Southern |
| TQ2337SE | Southern |
| TQ2237SE | Southern |
| TQ2335NW | Southern |
| TQ2338SE | Southern |
| TQ2336SE | Southern |
| TQ2234NE | Southern |
| TQ2234SW | Southern |
| TQ2134SE | Southern |
| TQ2136SE | Southern |
| TQ2337NE | Southern |
| TQ2236NW | Southern |
| TQ2235SW | Southern |
| TQ2137SE | Southern |
| TQ2336NE | Southern |
| TQ2235NE | Southern |
| TQ2235NW | Southern |
| TQ2235SE | Southern |
| TQ2234NW | Southern |
| TQ2134NE | Southern |
| TQ2337NW | Southern |
| TQ2336NW | Southern |
| TQ2136NE | Southern |
| TQ2236NE | Southern |
| TQ2135NE | Southern |
| TQ2234SE | Southern |
| TQ2236SW | Southern |
| TQ2337SW | Southern |
| TQ2336SW | Southern |
| TQ2335NE | Southern |
| TQ2237SW | Southern |

Southern Water
Southern House
Yeoman Road
Worthing
West Sussex
BN13 3NX

Tel: 01903 264 444
Fax: 01903 691 435
Website: www.southernwater.co.uk.

For your guidance:

- Assets other than vested water mains may be shown on the plan, for information only.
- If an extract of the public water main record is enclosed, this will show known public water mains in the vicinity of the property. It should be possible to estimate the likely length and route of any private water supply pipe connecting the property to the public water network.

Asset location search



Property Searches

Payment for this Search

There is no fee associated with this enquiry, and thus no payment is required.

Asset location search



Property Searches

Further contacts:

Waste Water queries

Should you require verification of the invert levels of public sewers, by site measurement, you will need to approach the relevant Thames Water Area Network Office for permission to lift the appropriate covers. This permission will usually involve you completing a TWOSA form. For further information please contact our Customer Centre on Tel: 0845 920 0800. Alternatively, a survey can be arranged, for a fee, through our Customer Centre on the above number.

If you have any questions regarding sewer connections, budget estimates, diversions, building over issues or any other questions regarding operational issues please direct them to our service desk. Which can be contacted by writing to:

Developer Services (Waste Water)
Thames Water
Clearwater Court
Vastern Road
Reading
RG1 8DB


Tel: 0800 009 3921
Email: developer.services@thameswater.co.uk

Clean Water queries

Should you require any advice concerning clean water operational issues or clean water connections, please contact:

Developer Services (Clean Water)
Thames Water
Clearwater Court
Vastern Road
Reading
RG1 8DB

Tel: 0800 009 3921
Email: developer.services@thameswater.co.uk

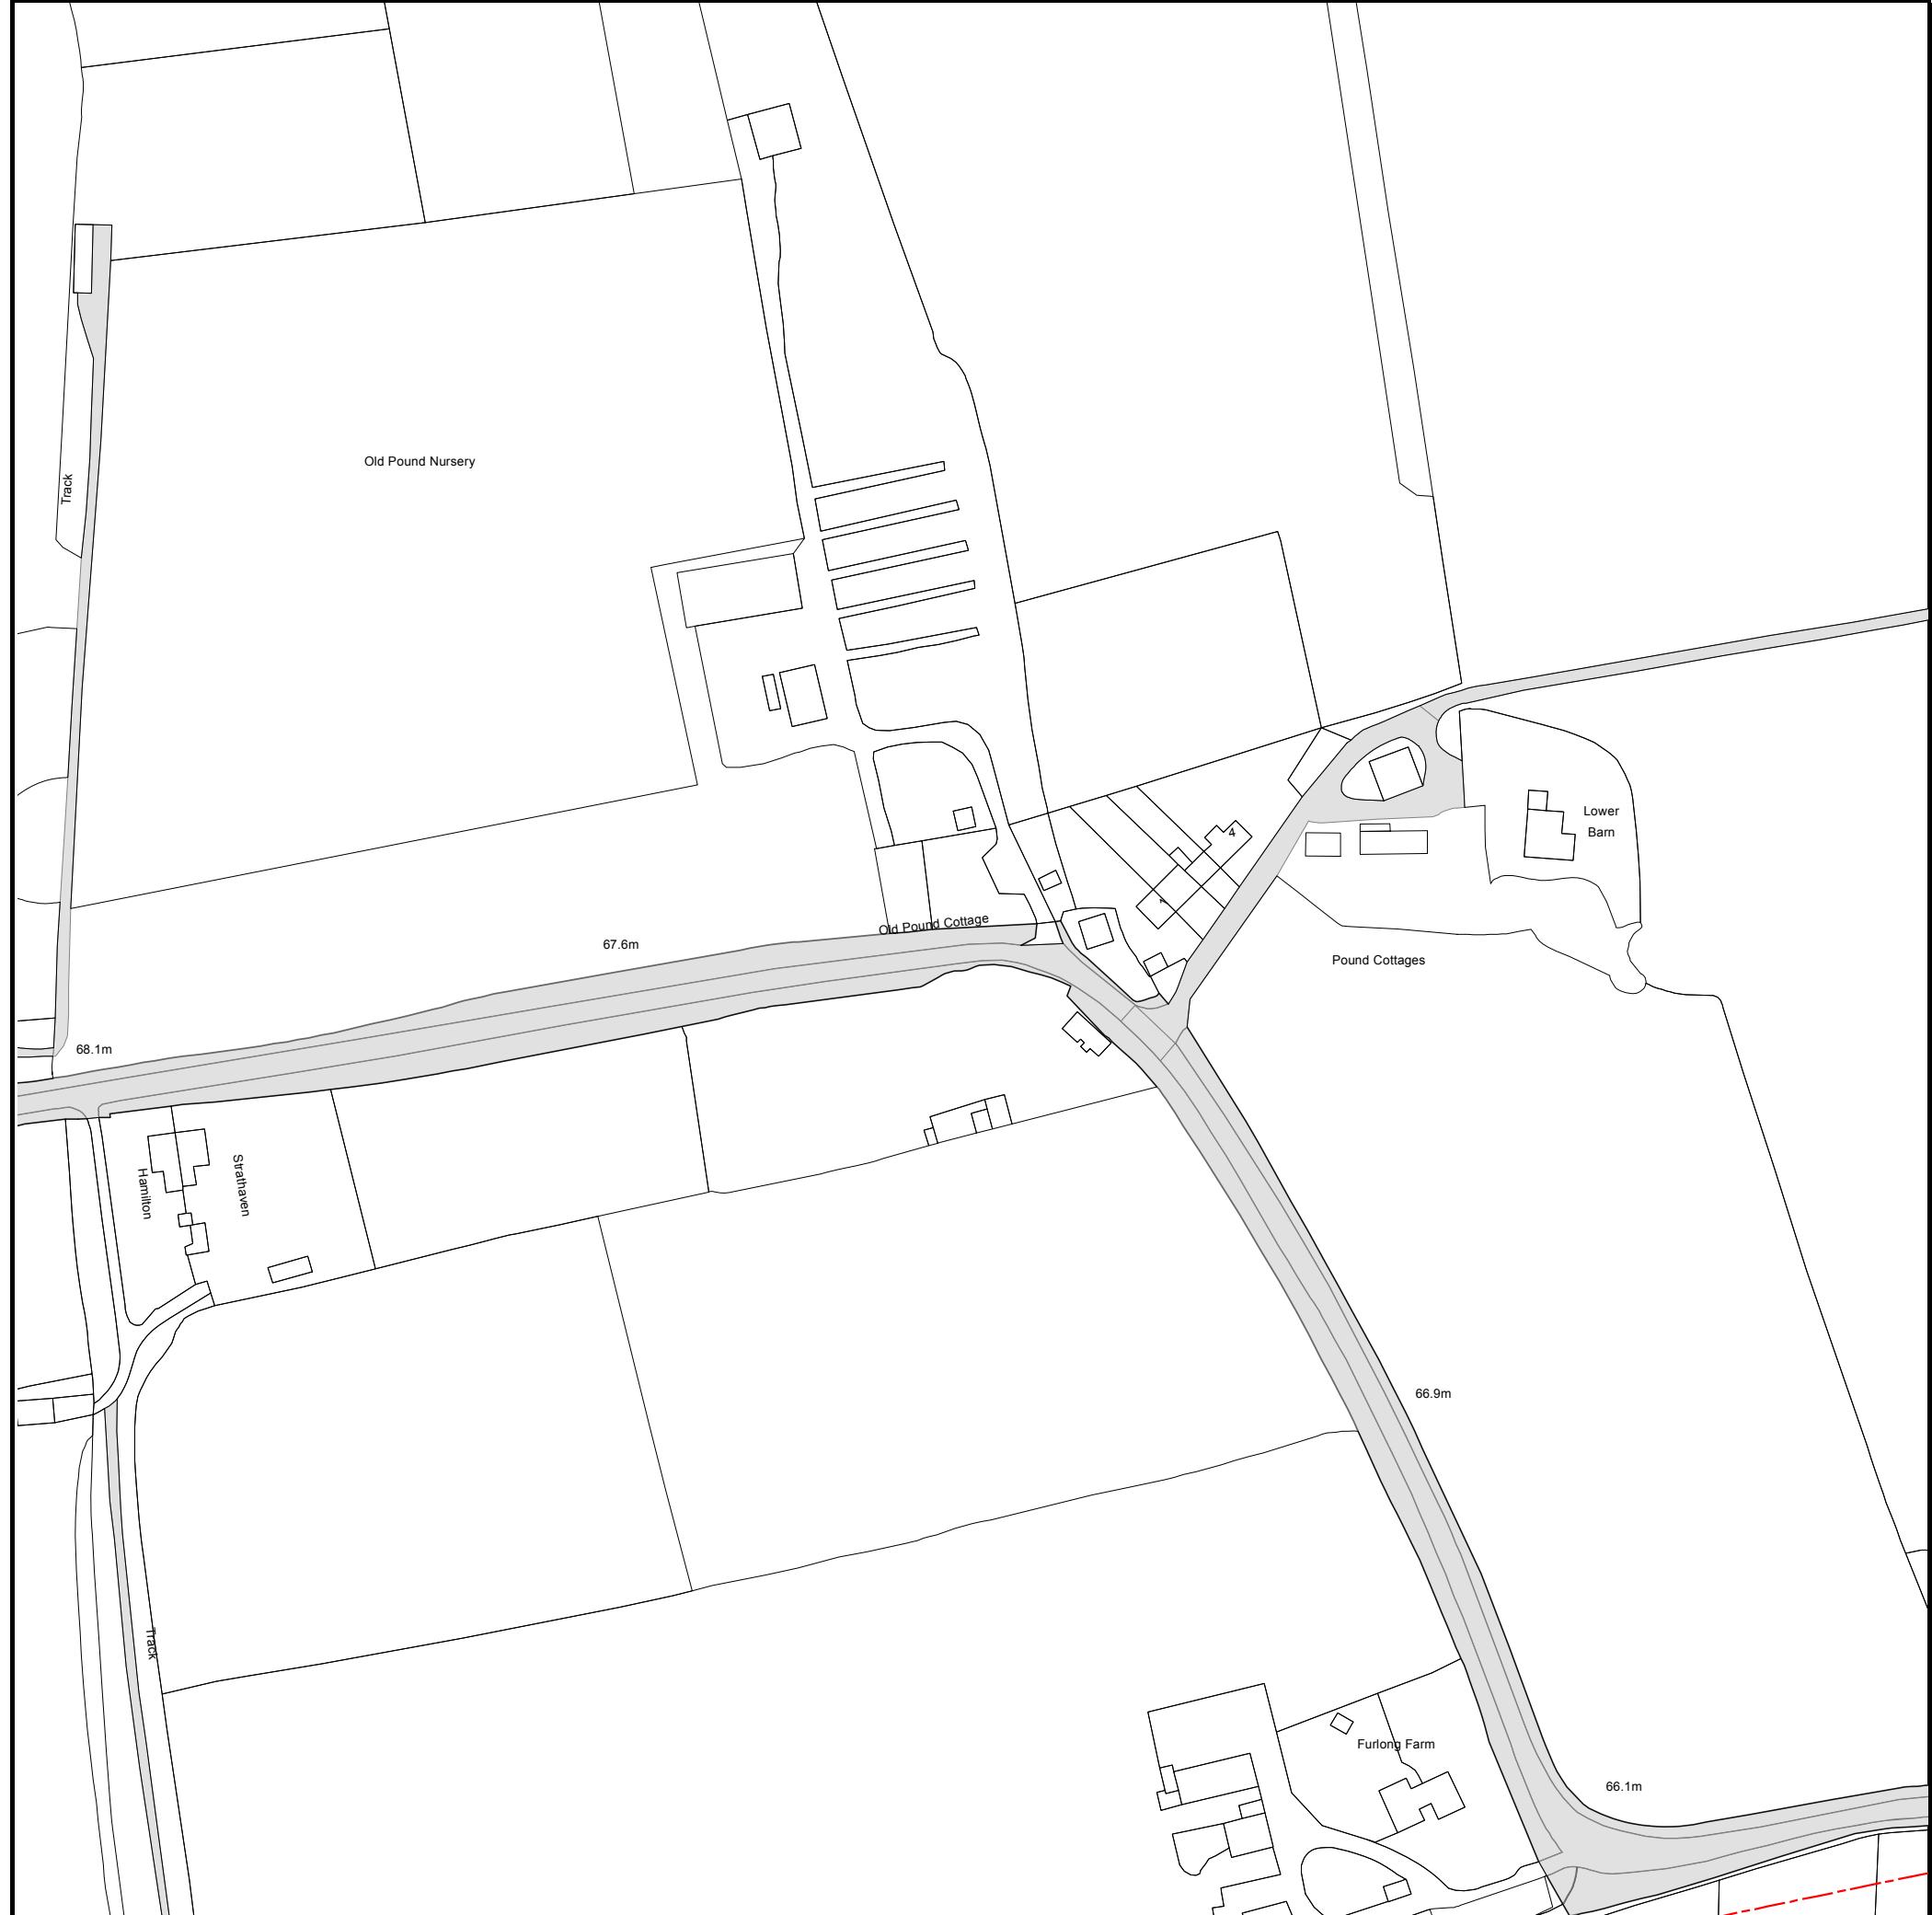

The width of the displayed area is 500m and the centre of the map is located at OS coordinates 523750,137250

The position of the apparatus shown on this plan is given without obligation and warranty, and the accuracy cannot be guaranteed. Service pipes are not shown but their presence should be anticipated. No liability of any kind whatsoever is accepted by Thames Water for any error or omission. The actual position of mains and services must be verified and established on site before any works are undertaken.

Based on the Ordnance Survey Map with the Sanction of the controller of H.M. Stationery Office, License no. 100019345 Crown Copyright Reserved.

NB. Levels quoted in metres Ordnance Newlyn Datum. The value -9999.00 indicates that no survey information is available

| Manhole Reference | Manhole Cover Level | Manhole Invert Level |
|-------------------|---------------------|----------------------|
| n/a | n/a | n/a |

The position of the apparatus shown on this plan is given without obligation and warranty, and the accuracy cannot be guaranteed. Service pipes are not shown but their presence should be anticipated. No liability of any kind whatsoever is accepted by Thames Water for any error or omission. The actual position of mains and services must be verified and established on site before any works are undertaken.



Based on the Ordnance Survey Map with the Sanction of the controller of H.M. Stationery Office, License no. 100019345 Crown Copyright Reserved.


NB. Levels quoted in metres Ordnance Newlyn Datum. The value -9999.00 indicates that no survey information is available

| Manhole Reference | Manhole Cover Level | Manhole Invert Level |
|-------------------|---------------------|----------------------|
| 9256 | 74.8 | 73.73 |
| 9255 | 74.94 | 73.5 |
| 9205 | 75.29 | 73.22 |
| 921B | n/a | n/a |
| 921A | n/a | n/a |
| 9250 | 74.3 | 72.85 |
| 9303 | n/a | n/a |
| 9351 | n/a | n/a |
| 9251 | 75.11 | 73.19 |
| 9201 | 75.07 | 72.71 |
| 9352 | n/a | n/a |
| 9052 | 85.96 | 84.45 |
| 801B | n/a | n/a |
| 801D | n/a | n/a |
| 801C | n/a | n/a |
| 9003 | 86.03 | 83.78 |
| 9004 | 85.77 | 83.34 |
| 9002 | 86.73 | 85.23 |
| 8002 | 86.26 | 84.4 |
| 8051 | 86.33 | 84.89 |
| 8001 | 86.41 | 84.32 |
| 9050 | 85.75 | 83.95 |
| 9001 | 85.73 | 83.47 |
| 9051 | 85.29 | 83.19 |
| 801F | n/a | n/a |
| 801E | n/a | n/a |
| 9103 | 85.12 | 82.34 |
| 8105 | 85.42 | 82.86 |
| 9155 | 83.73 | 81.77 |
| 9154 | 83.95 | 81.91 |
| 911A | n/a | n/a |
| 8104 | 83.39 | 80.73 |
| 8150 | 83.44 | 81.04 |
| 8151 | 83.07 | 80.91 |
| 911B | n/a | n/a |
| 8102 | 83.05 | 80.47 |
| 8103 | 82.37 | 80.56 |
| 9152 | 82.35 | 80.63 |
| 8101 | 82.4 | 80.05 |
| 9153 | 81.63 | 79.81 |
| 9151 | 80.48 | 79.27 |
| 9102 | 80.43 | 78.61 |
| 9101 | 79.91 | 77.42 |
| 9150 | 79.72 | n/a |
| 9204 | 78.94 | 77 |
| 8257 | 78.77 | 77.16 |
| 9254 | 78.68 | 77.66 |
| 8256 | 77.41 | 75.92 |
| 9203 | 77.48 | 75.4 |
| 8253 | 77.3 | 75.18 |
| 9253 | 77.34 | 75.84 |
| 921C | n/a | n/a |
| 921D | n/a | n/a |
| 8204 | 77.22 | 74.52 |
| 8254 | 77.56 | 75.66 |
| 921E | n/a | n/a |
| 8205 | 77.57 | 75.44 |
| 821B | n/a | n/a |
| 9202 | 75.78 | 72.98 |
| 821D | n/a | n/a |
| 9252 | 75.78 | 73.38 |
| 8203 | 75.92 | 73.26 |
| 8052 | 86.98 | 84.8 |
| 9056 | 85.97 | 84.72 |
| 9055 | 85.23 | 83.66 |
| 9005 | 86.11 | 84.07 |
| 9054 | 86.02 | 84.59 |
| 801A | n/a | n/a |
| 9053 | 85.74 | 84.39 |
| 6201 | 79.28 | 76.7 |
| 6301 | 78.7 | 76.13 |
| 7350 | 78.56 | 76.86 |
| 721A | n/a | n/a |
| 721B | n/a | n/a |
| 731B | n/a | n/a |
| 731A | n/a | n/a |
| 7201 | 78.65 | 75.17 |
| 7351 | 78.35 | 76.53 |
| 7202 | 77.7 | 74.69 |
| 7250 | 77.53 | 76.09 |
| 8250 | 75.86 | 74.56 |
| 8201 | 75.64 | 73.85 |
| 8350 | 74.51 | 73.27 |
| 821F | n/a | n/a |
| 821H | n/a | n/a |
| 821G | n/a | n/a |
| 821I | n/a | n/a |
| 821E | n/a | n/a |
| 8301 | 73.61 | 72.39 |
| 8207 | 76.07 | 73.46 |

| Manhole Reference | Manhole Cover Level | Manhole Invert Level |
|-------------------|---------------------|----------------------|
| 8252 | 75.86 | 74.13 |
| 8251 | 75.79 | 73.25 |
| 8202 | 75.73 | 72.16 |
| 8302 | 73.31 | 71.42 |
| 9301 | 73.57 | 71.08 |
| 9302 | n/a | n/a |
| 7160 | n/a | n/a |
| 7150 | 81.67 | 80.22 |
| 7103 | 81.81 | 79.86 |
| 7259 | n/a | n/a |
| 811A | n/a | n/a |
| 7256 | 81.98 | 80.54 |
| 7257 | 81.17 | 79.67 |
| 7205 | 81.22 | 79.57 |
| 7206 | 82.27 | 80.32 |
| 6205 | 82.43 | 80.38 |
| 7255 | 82.05 | 80.67 |
| 8206 | 79.38 | 77.3 |
| 6253 | 82.31 | 80.83 |
| 8255 | 79.3 | 77.46 |
| 721C | n/a | n/a |
| 7253 | 80.25 | 78.67 |
| 7258 | 78.32 | 77.04 |
| 6203 | 80.26 | 78.34 |
| 6251 | 80.2 | 78.98 |
| 7204 | 78.27 | 76.37 |
| 721D | n/a | n/a |
| 7251 | 78.16 | 76.61 |
| 7252 | 79.09 | 77.89 |
| 7203 | 78.2 | 76.12 |
| 6250 | 79.57 | 77.88 |
| 6202 | 79.53 | 77.23 |
| 7254 | 79.32 | 77.64 |
| 501A | n/a | n/a |
| 501B | n/a | n/a |
| 6002 | 86.7 | 85.38 |
| 6155 | 84.88 | 83.43 |
| 6050 | 86.78 | 85.69 |
| 6108 | 86.31 | 85.09 |
| 6158 | 86.42 | 85.2 |
| 601A | n/a | n/a |
| 621A | n/a | n/a |
| 611B | n/a | n/a |
| 611D | n/a | n/a |
| 611C | n/a | n/a |
| 6157 | 84.05 | 82.47 |
| 6107 | 84.12 | 82.1 |
| 6156 | 83.72 | 81.41 |
| 6154 | 84.85 | 83.14 |
| 6106 | 83.72 | 81.21 |
| 6105 | 84.74 | 82.75 |
| 6151 | 83.65 | 81.33 |
| 6102 | 83.71 | 80.87 |
| 6152 | 84.21 | 82.23 |
| 6150 | 82.9 | 81.2 |
| 6252 | 82.6 | 81.06 |
| 6101 | 82.9 | 80.68 |
| 6204 | 82.6 | 80.64 |
| 6103 | 84.68 | 82.22 |
| 6153 | 84.98 | 82.91 |
| 7051 | 88.67 | 87.28 |
| 7002 | 88.79 | 87.09 |
| 7001 | 88.27 | 86.49 |
| 8050 | 87.55 | 86.28 |
| 7154 | 86.93 | 84.49 |
| 7153 | 87.3 | 84.59 |
| 7152 | 86.3 | 84.39 |
| 6109 | n/a | n/a |
| 7101 | 86.59 | 83.96 |
| 7102 | 86.19 | 83.73 |
| 8106 | 85.59 | 83.21 |
| 611A | n/a | n/a |
| 711C | n/a | n/a |
| 711B | n/a | n/a |
| 7156 | 84.83 | 83.1 |
| 711A | n/a | n/a |
| 7106 | 84.65 | 82.49 |
| 7155 | 84.33 | 82.25 |
| 7105 | 84.24 | 81.77 |
| 6104 | 85.06 | 82.47 |
| 7107 | 84.73 | 83.07 |
| 7157 | 84.55 | 83.15 |
| 7151 | 83.56 | 82.04 |
| 7104 | 83.69 | 81.55 |
| 7158 | n/a | n/a |
| 7159 | 81.7 | n/a |
| 7161 | n/a | n/a |
| 501F | n/a | n/a |
| 501C | n/a | n/a |
| 5001 | 88.17 | 86.09 |
| 5050 | 88.21 | 86.33 |
| 501D | n/a | n/a |
| 501G | n/a | n/a |

| Manhole Reference | Manhole Cover Level | Manhole Invert Level |
|-------------------|---------------------|----------------------|
| 6051 | 89.66 | 88.23 |
| 601B | n/a | n/a |
| 601C | n/a | n/a |
| 6001 | 89.54 | 87.59 |
| 7050 | 89.17 | 87.72 |
| 801H | n/a | n/a |
| 801G | n/a | n/a |

The position of the apparatus shown on this plan is given without obligation and warranty, and the accuracy cannot be guaranteed. Service pipes are not shown but their presence should be anticipated. No liability of any kind whatsoever is accepted by Thames Water for any error or omission. The actual position of mains and services must be verified and established on site before any works are undertaken.

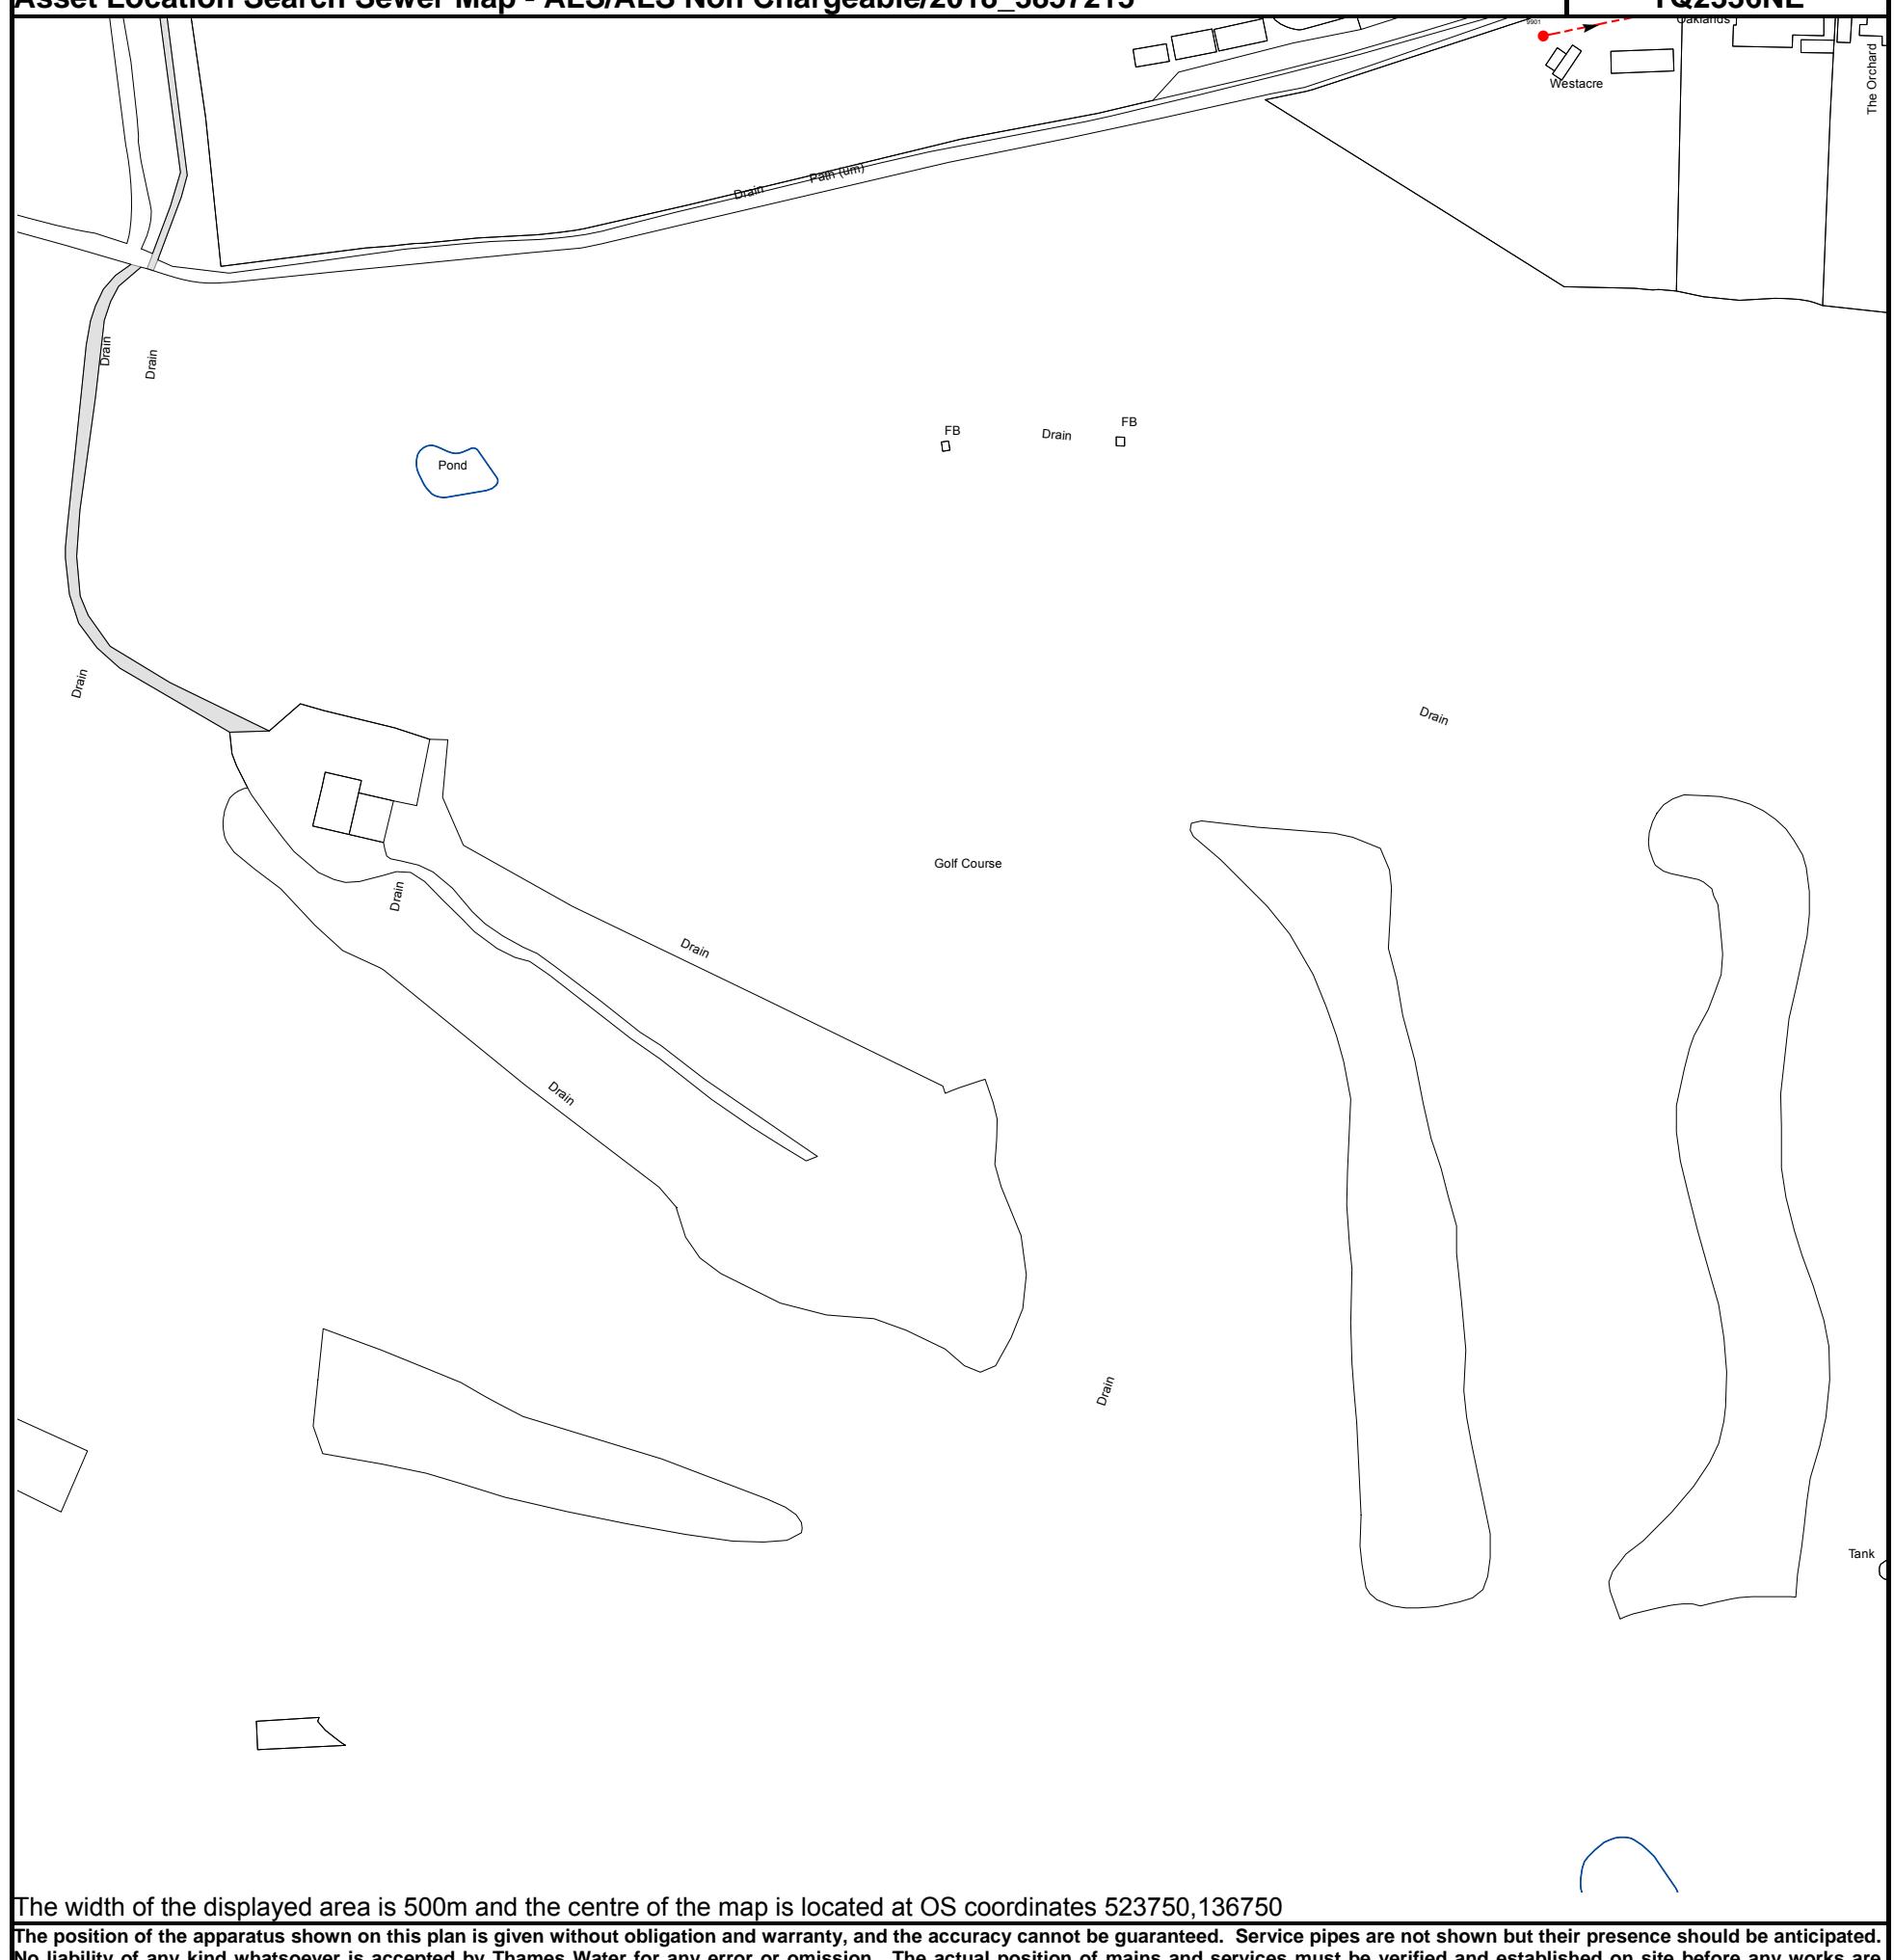


NB. Levels quoted in metres Ordnance Newlyn Datum. The value -9999.00 indicates that no survey information is available

| Manhole Reference | Manhole Cover Level | Manhole Invert Level |
|-------------------|---------------------|----------------------|
| 9901 | n/a | n/a |

The position of the apparatus shown on this plan is given without obligation and warranty, and the accuracy cannot be guaranteed. Service pipes are not shown but their presence should be anticipated. No liability of any kind whatsoever is accepted by Thames Water for any error or omission. The actual position of mains and services must be verified and established on site before any works are undertaken.

Asset Location Search Sewer Map - ALS/ALS Non Chargeable/2018_3857215

TQ2335NE

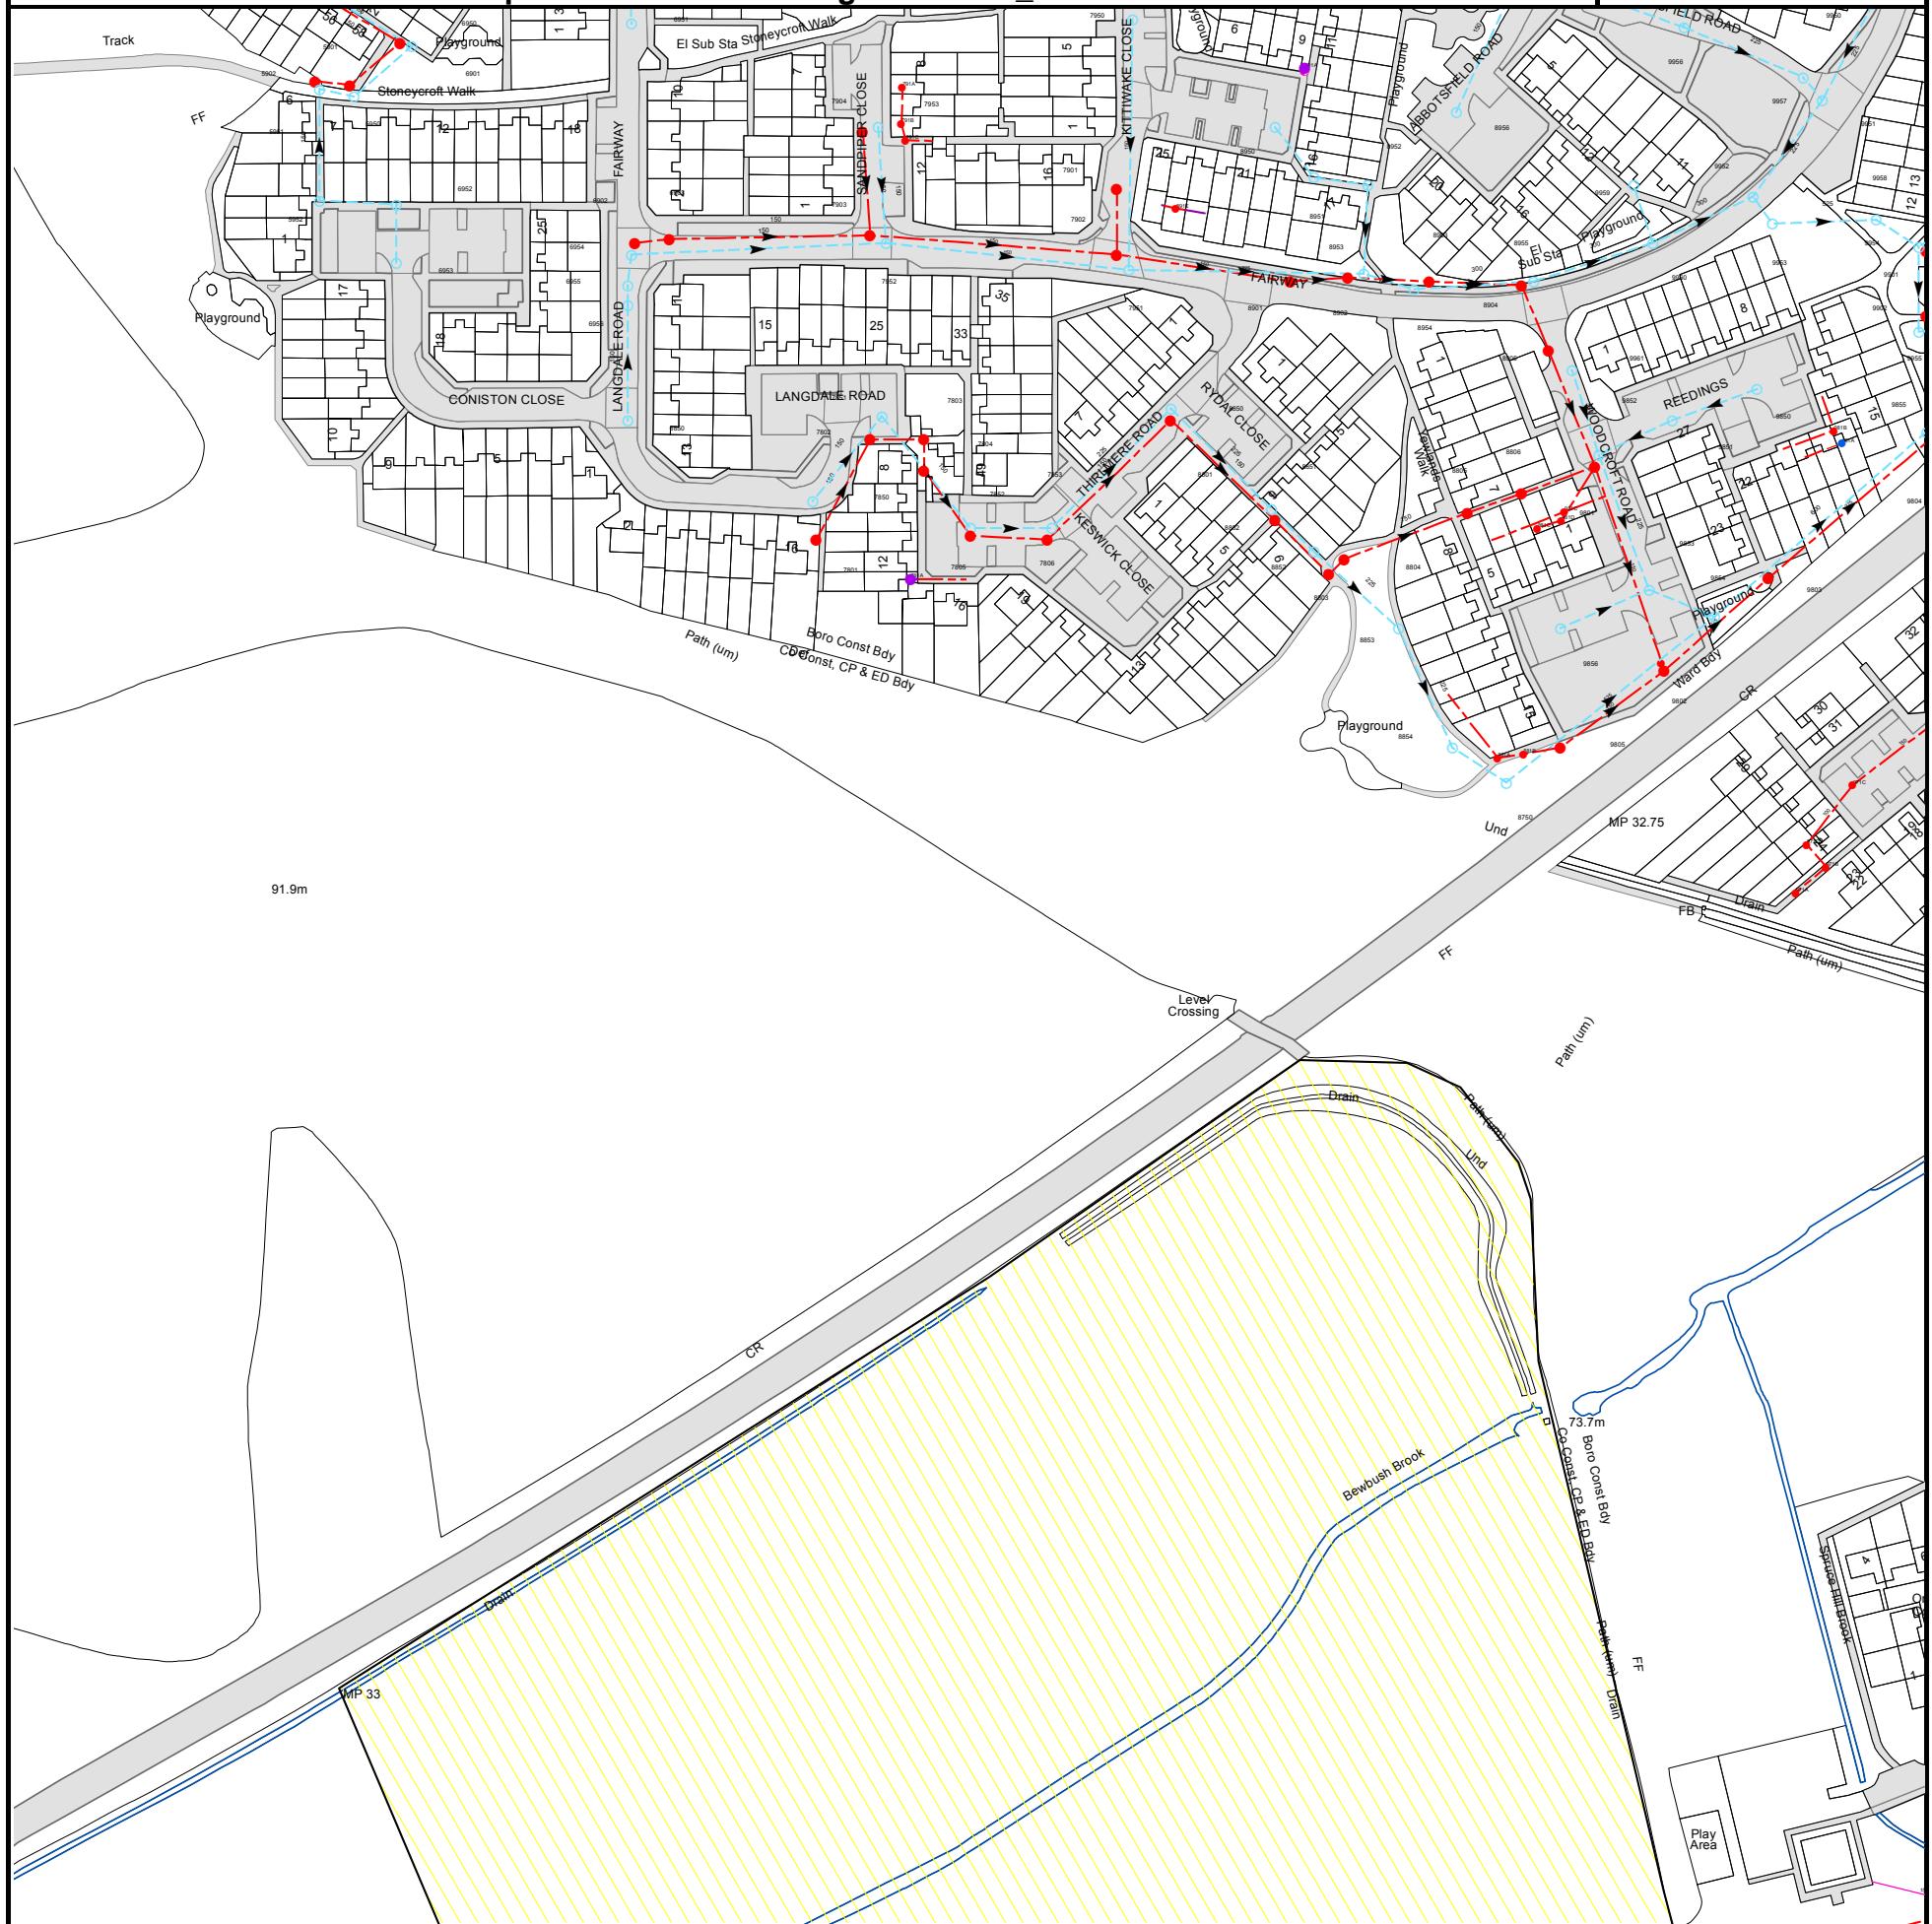

The width of the displayed area is 500m and the centre of the map is located at OS coordinates 523750,135750

The position of the apparatus shown on this plan is given without obligation and warranty, and the accuracy cannot be guaranteed. Service pipes are not shown but their presence should be anticipated. No liability of any kind whatsoever is accepted by Thames Water for any error or omission. The actual position of mains and services must be verified and established on site before any works are undertaken.

Based on the Ordnance Survey Map with the Sanction of the controller of H.M. Stationery Office. License no. 100019345 Crown Copyright Reserved.

NB. Levels quoted in metres Ordnance Newlyn Datum. The value -9999.00 indicates that no survey information is available

| Manhole Reference | Manhole Cover Level | Manhole Invert Level |
|-------------------|---------------------|----------------------|
| 9802 | 77.9 | 75.15 |
| 9851 | 81.04 | 79.21 |
| 9854 | 78.14 | 75.49 |
| 9850 | 80.82 | 79.62 |
| 9803 | 78.71 | 74.95 |
| 971A | n/a | n/a |
| 971D | n/a | n/a |
| 971B | n/a | n/a |
| 981B | n/a | n/a |
| 981A | n/a | n/a |
| 971C | n/a | n/a |
| 9955 | 80.72 | 78.57 |
| 9855 | 79.33 | 75.33 |
| 9902 | 80.61 | 79.01 |
| 9804 | 79.3 | 74.87 |
| 8902 | 85.77 | 83.98 |
| 8953 | 85.81 | 83.31 |
| 9901 | 81.52 | 79.27 |
| 9954 | 81.55 | 79.3 |
| 9960 | 83.95 | 82.02 |
| 9953 | 83.64 | 81.34 |
| 9958 | 82.14 | 79.84 |
| 9952 | 83.77 | 81.67 |
| 8952 | 86.53 | 85.39 |
| 9959 | 84.66 | 83.44 |
| 8951 | 86.65 | 85.64 |
| 8950 | 87.2 | 85.96 |
| 8956 | 86.46 | 85.05 |
| 9951 | 83.74 | 82.2 |
| 9957 | 84.7 | 83.44 |
| 891A | n/a | n/a |
| 9956 | 85.52 | 83.66 |
| 9950 | 84.48 | 82.91 |
| 8851 | 83.3 | 81.92 |
| 8802 | 83.23 | 81.52 |
| 8901 | 86.06 | 84.35 |
| 8852 | 82.84 | 81.05 |
| 8803 | 82.56 | 81.19 |
| 8804 | 82.56 | 81.08 |
| 8853 | 80.2 | 78.83 |
| 8954 | 85.05 | 83.12 |
| 8903 | 85.06 | 83.01 |
| 8854 | 78.47 | 77.18 |
| 8805 | 82.08 | 80.77 |
| 881A | n/a | n/a |
| 8750 | 77.47 | 75.79 |
| 8904 | 84.4 | 82.41 |
| 8806 | 81.78 | 80.37 |
| 881B | n/a | n/a |
| 8955 | 84.33 | 82.6 |
| 881C | n/a | n/a |
| 8905 | 83.75 | 80.74 |
| 9805 | 77.68 | 75.89 |
| 9856 | 79.35 | 78.14 |
| 981D | n/a | n/a |
| 981C | n/a | n/a |
| 9961 | 83.41 | 79.79 |
| 9801 | 81.25 | 78.98 |
| 9852 | 81.67 | 78.91 |
| 9853 | 79.14 | 77.86 |
| 5902 | 89.61 | 88 |
| 5951 | 89.66 | 88.32 |
| 5952 | 90.89 | 89.21 |
| 5901 | 89.85 | 87.8 |
| 5950 | 89.9 | 88.18 |
| 6952 | 91.77 | 89.67 |
| 6953 | 92.12 | n/a |
| 6901 | 89.4 | 87.4 |
| 6950 | 89.55 | 87.8 |
| 6956 | 91.86 | 90.6 |
| 6850 | 92.06 | 90.87 |
| 6955 | 91.83 | n/a |
| 6954 | 91.73 | 90.47 |
| 6951 | 91.17 | 89.84 |
| 6902 | 91.75 | 90.05 |
| 6903 | 91.45 | 89.73 |
| 7850 | 90.43 | 88.84 |
| 7801 | 90.37 | 88.81 |
| 7904 | 90.63 | 89.01 |
| 7802 | 90.1 | 87.99 |
| 7903 | 90.22 | 88.62 |
| 7953 | 90.66 | 89.36 |
| 7851 | 89.78 | 88.44 |
| 7952 | 90.13 | 88.89 |
| 791B | n/a | n/a |
| 791A | n/a | n/a |
| 791C | n/a | n/a |
| 781A | n/a | n/a |
| 7803 | 89.44 | 87.51 |
| 7804 | 89.24 | 87.19 |

| Manhole Reference | Manhole Cover Level | Manhole Invert Level |
|-------------------|---------------------|----------------------|
| 7805 | 87.85 | 85.91 |
| 7852 | 87.92 | 86.38 |
| 7806 | 86.89 | 85.09 |
| 7853 | 86.82 | 85.44 |
| 7902 | 88.05 | 85.36 |
| 7901 | 88.51 | 86.3 |
| 7951 | 87.87 | 86.32 |
| 7950 | 89.49 | 88.14 |
| 8801 | 85.78 | 83.89 |
| 8850 | 85.75 | 84.35 |
| 891E | n/a | n/a |

The position of the apparatus shown on this plan is given without obligation and warranty, and the accuracy cannot be guaranteed. Service pipes are not shown but their presence should be anticipated. No liability of any kind whatsoever is accepted by Thames Water for any error or omission. The actual position of mains and services must be verified and established on site before any works are undertaken.



ALS Sewer Map Key

Public Sewer Types (Operated & Maintained by Thames Water)

| | |
|--|---|
| | Foul: A sewer designed to convey waste water from domestic and industrial sources to a treatment works. |
| | Surface Water: A sewer designed to convey surface water (e.g. rain water from roofs, yards and car parks) to rivers or watercourses. |
| | Combined: A sewer designed to convey both waste water and surface water from domestic and industrial sources to a treatment works. |
| | Trunk Surface Water |
| | Trunk Foul |
| | Storm Relief |
| | Trunk Combined |
| | Vent Pipe |
| | Bio-solids (Sludge) |
| | Proposed Thames Surface Water Sewer |
| | Proposed Thames Water Foul Sewer |
| | Gallery |
| | Foul Rising Main |
| | Surface Water Rising Main |
| | Combined Rising Main |
| | Sludge Rising Main |
| | Vacuum |

Notes:

- 1) All levels associated with the plans are to Ordnance Datum Newlyn.
- 2) All measurements on the plans are metric.
- 3) Arrows (on gravity fed sewers) or flecks (on rising mains) indicate direction of flow.
- 4) Most private pipes are not shown on our plans, as in the past, this information has not been recorded.
- 5) 'na' or '0' on a manhole level indicates that data is unavailable.

Sewer Fittings

A feature in a sewer that does not affect the flow in the pipe. Example: a vent is a fitting as the function of a vent is to release excess gas.

| | |
|--|-------------|
| | Air Valve |
| | Dam Chase |
| | Fitting |
| | Meter |
| | Vent Column |

Operational Controls

A feature in a sewer that changes or diverts the flow in the sewer. Example: A hydrobrake limits the flow passing downstream.

| | |
|--|---------------|
| | Control Valve |
| | Drop Pipe |
| | Ancillary |
| | Weir |

End Items

End symbols appear at the start or end of a sewer pipe. Examples: an Undefined End at the start of a sewer indicates that Thames Water has no knowledge of the position of the sewer upstream of that symbol. Outfall on a surface water sewer indicates that the pipe discharges into a stream or river.

| | |
|--|---------------|
| | Outfall |
| | Undefined End |
| | Inlet |

Other Symbols

Symbols used on maps which do not fall under other general categories

| | |
|--|---|
| | ▲/▲ Public/Private Pumping Station |
| | * Change of characteristic indicator (C.O.C.I.) |
| | ☒ Invert Level |
| | <1 Summit |

Areas

Lines denoting areas of underground surveys, etc.

| | |
|--|------------------|
| | Agreement |
| | Operational Site |
| | Chamber |
| | Tunnel |
| | Conduit Bridge |

Other Sewer Types (Not Operated or Maintained by Thames Water)

| | | | |
|--|-----------------------|--|---------------------|
| | Foul Sewer | | Surface Water Sewer |
| | Combined Sewer | | Gully |
| | Culverted Watercourse | | Proposed |
| | Abandoned Sewer | | |

Terms and Conditions

All sales are made in accordance with Thames Water Utilities Limited (TWUL) standard terms and conditions unless previously agreed in writing.

1. All goods remain in the property of Thames Water Utilities Ltd until full payment is received.
2. Provision of service will be in accordance with all legal requirements and published TWUL policies.
3. All invoices are strictly due for payment 14 days from due date of the invoice. Any other terms must be accepted/agreed in writing prior to provision of goods or service, or will be held to be invalid.
4. Thames Water does not accept post-dated cheques-any cheques received will be processed for payment on date of receipt.
5. In case of dispute TWUL's terms and conditions shall apply.
6. Penalty interest may be invoked by TWUL in the event of unjustifiable payment delay. Interest charges will be in line with UK Statute Law 'The Late Payment of Commercial Debts (Interest) Act 1998'.
7. Interest will be charged in line with current Court Interest Charges, if legal action is taken.
8. A charge may be made at the discretion of the company for increased administration costs.

A copy of Thames Water's standard terms and conditions are available from the Commercial Billing Team (cashoperations@thameswater.co.uk).

We publish several Codes of Practice including a guaranteed standards scheme. You can obtain copies of these leaflets by calling us on 0800 316 9800

If you are unhappy with our service you can speak to your original goods or customer service provider. If you are not satisfied with the response, your complaint will be reviewed by the Customer Services Director. You can write to her at: Thames Water Utilities Ltd. PO Box 492, Swindon, SN38 8TU.

If the Goods or Services covered by this invoice falls under the regulation of the 1991 Water Industry Act, and you remain dissatisfied you can refer your complaint to Consumer Council for Water on 0121 345 1000 or write to them at Consumer Council for Water, 1st Floor, Victoria Square House, Victoria Square, Birmingham, B2 4AJ.

Ways to pay your bill

| Credit Card | BACS Payment | Telephone Banking | Cheque |
|--|---|---|---|
| Call 0845 070 9148 quoting your invoice number starting CBA or ADS / OSS | Account number 90478703 Sort code 60-00-01 A remittance advice must be sent to: Thames Water Utilities Ltd., PO Box 3189, Slough SL1 4WW. or email ps.billing@thameswater.co.uk | By calling your bank and quoting: Account number 90478703 Sort code 60-00-01 and your invoice number | Made payable to ' Thames Water Utilities Ltd' Write your Thames Water account number on the back. Send to: Thames Water Utilities Ltd., PO Box 3189, Slough SL1 4WW or by DX to 151280 Slough 13 |

Thames Water Utilities Ltd Registered in England & Wales No. 2366661 Registered Office Clearwater Court, Vastern Rd, Reading, Berks, RG1 8DB.

Search Code



IMPORTANT CONSUMER PROTECTION INFORMATION

This search has been produced by Thames Water Property Searches, Clearwater Court, Vastern Road, Reading RG1 8DB, which is registered with the Property Codes Compliance Board (PCCB) as a subscriber to the Search Code. The PCCB independently monitors how registered search firms maintain compliance with the Code.

The Search Code:

- provides protection for homebuyers, sellers, estate agents, conveyancers and mortgage lenders who rely on the information included in property search reports undertaken by subscribers on residential and commercial property within the United Kingdom
- sets out minimum standards which firms compiling and selling search reports have to meet
- promotes the best practise and quality standards within the industry for the benefit of consumers and property professionals
- enables consumers and property professionals to have confidence in firms which subscribe to the code, their products and services.

By giving you this information, the search firm is confirming that they keep to the principles of the Code. This provides important protection for you.

The Code's core principles

Firms which subscribe to the Search Code will:

- display the Search Code logo prominently on their search reports
- act with integrity and carry out work with due skill, care and diligence
- at all times maintain adequate and appropriate insurance to protect consumers
- conduct business in an honest, fair and professional manner
- handle complaints speedily and fairly
- ensure that products and services comply with industry registration rules and standards and relevant laws
- monitor their compliance with the Code

Complaints

If you have a query or complaint about your search, you should raise it directly with the search firm, and if appropriate ask for any complaint to be considered under their formal internal complaints procedure. If you remain dissatisfied with the firm's final response, after your complaint has been formally considered, or if the firm has exceeded the response timescales, you may refer your complaint for consideration under The Property Ombudsman scheme (TPOs). The Ombudsman can award compensation of up to £5,000 to you if he finds that you have suffered actual loss as a result of your search provider failing to keep to the Code.

Please note that all queries or complaints regarding your search should be directed to your search provider in the first instance, not to TPOs or to the PCCB.

TPOs Contact Details

The Property Ombudsman scheme
Milford House
43-55 Milford Street
Salisbury
Wiltshire SP1 2BP
Tel: 01722 333306
Fax: 01722 332296
Email: admin@tpos.co.uk

You can get more information about the PCCB from www.propertycodes.org.uk

PLEASE ASK YOUR SEARCH PROVIDER IF YOU WOULD LIKE A COPY OF THE SEARCH CODE

Asset location search



Property Searches

Amin Asil
Arcadis Consulting UK Ltd
Arcadis Cymru House
St Mellons Business Park
CARDIFF
CF3 0EY

Search address supplied 524195 137583
The Maples
Bovis Homes
Rusper Road
Horsham
West Sussex
England
RH11 0GE

Your reference N/A

Our reference ALS/ALS Non Chargeable/2023_4825611

Search date 12 May 2023

Notification of Price Changes

From 1st April 2023 Thames water Property Searches will be increasing the prices of its CON29DW, CommercialDW Drainage & Water Enquiries and Asset Location Searches. Historically costs would rise in line with RPI but as this currently sits at 14.2%, we are capping it at 10%.

Customers will be emailed with the new prices by January 1st 2023.

Any orders received with a higher payment prior to the 1st April 2023 will be non-refundable. For further details on the price increase please visit our website at www.thameswater-propertysearches.co.uk



Thames Water Utilities Ltd
Property Searches, PO Box 3189, Slough SL1 4WW



searches@thameswater.co.uk
www.thameswater-propertysearches.co.uk



0800 009 4540

Asset location search



Property Searches

Search address supplied: 524195 137583, The Maples, Bovis Homes, Rusper Road, Horsham, West Sussex, England, RH11 0GE

Dear Sir / Madam

An Asset Location Search is recommended when undertaking a site development. It is essential to obtain information on the size and location of clean water and sewerage assets to safeguard against expensive damage and allow cost-effective service design.

The following records were searched in compiling this report: - the map of public sewers & the map of waterworks. Thames Water Utilities Ltd (TWUL) holds all of these.

This search provides maps showing the position, size of Thames Water assets close to the proposed development and also manhole cover and invert levels, where available.

Please note that none of the charges made for this report relate to the provision of Ordnance Survey mapping information. The replies contained in this letter are given following inspection of the public service records available to this company. No responsibility can be accepted for any error or omission in the replies.

You should be aware that the information contained on these plans is current only on the day that the plans are issued. The plans should only be used for the duration of the work that is being carried out at the present time. Under no circumstances should this data be copied or transmitted to parties other than those for whom the current work is being carried out.

Thames Water do update these service plans on a regular basis and failure to observe the above conditions could lead to damage arising to new or diverted services at a later date.

Contact Us

If you have any further queries regarding this enquiry please feel free to contact a member of the team on 0800 009 4540, or use the address below:

Thames Water Utilities Ltd
Property Searches
PO Box 3189
Slough
SL1 4WW

Email: searches@thameswater.co.uk

Web: www.thameswater-propertysearches.co.uk

Asset location search



Property Searches

Waste Water Services

Please provide a copy extract from the public sewer map.

The following quartiles have been printed as they fall within Thames' sewerage area:

TQ2437SW
TQ2438SE
TQ2337SE
TQ2436NW
TQ2336SE
TQ2538NW
TQ2437SE
TQ2438NE
TQ2337SW
TQ2437NE
TQ2436SW
TQ2336NE
TQ2436NE
TQ2538SW

Enclosed is a map showing the approximate lines of our sewers. Our plans do not show sewer connections from individual properties or any sewers not owned by Thames Water unless specifically annotated otherwise. Records such as "private" pipework are in some cases available from the Building Control Department of the relevant Local Authority.

Where the Local Authority does not hold such plans it might be advisable to consult the property deeds for the site or contact neighbouring landowners.

This report relates only to sewerage apparatus of Thames Water Utilities Ltd, it does not disclose details of cables and or communications equipment that may be running through or around such apparatus.

The sewer level information contained in this response represents all of the level data available in our existing records. Should you require any further Information, please refer to the relevant section within the 'Further Contacts' page found later in this document.

The following quartiles have not been printed as they contain no assets:

TQ2437NW
TQ2438NW
TQ2337NW
TQ2336NW
TQ2338SE
TQ2336SW
TQ2438SW

Asset location search



Property Searches

TQ2337NE

For your guidance:

- The Company is not generally responsible for rivers, watercourses, ponds, culverts or highway drains. If any of these are shown on the copy extract they are shown for information only.
- Any private sewers or lateral drains which are indicated on the extract of the public sewer map as being subject to an agreement under Section 104 of the Water Industry Act 1991 are not an 'as constructed' record. It is recommended these details be checked with the developer.

Clean Water Services

Please provide a copy extract from the public water main map.

Following examination of our statutory maps, Thames Water has been unable to find any plans of water mains within this area. If you require a connection to the public water supply system, please write to:

New Connections / Diversions
Thames Water
Network Services Business Centre
Brentford
Middlesex
TW8 0EE

Tel: 0845 850 2777
Fax: 0207 713 3858
Email: developer.services@thameswater.co.uk

The following quartiles have not been printed as they are out of Thames' water catchment area. For details of the assets requested please contact the water company indicated below:

| | |
|----------|----------|
| TQ2437NW | Southern |
| TQ2437SW | Southern |
| TQ2438SE | Southern |
| TQ2337SE | Southern |
| TQ2438NW | Southern |
| TQ2337NW | Southern |
| TQ2336NW | Southern |
| TQ2436NW | Southern |
| TQ2338SE | Southern |
| TQ2336SE | Southern |
| TQ2538NW | Southern |
| TQ2437SE | Southern |

Asset location search



Property Searches

| | |
|----------|----------|
| TQ2438NE | Southern |
| TQ2337SW | Southern |
| TQ2437NE | Southern |
| TQ2336SW | Southern |
| TQ2438SW | Southern |
| TQ2337NE | Southern |
| TQ2436SW | Southern |
| TQ2336NE | Southern |
| TQ2436NE | Southern |
| TQ2538SW | Southern |

Southern Water
Southern House
Yeoman Road
Worthing
West Sussex
BN13 3NX

Tel: 01903 264 444
Fax: 01903 691 435
Website: www.southernwater.co.uk.

For your guidance:

- Assets other than vested water mains may be shown on the plan, for information only.
- If an extract of the public water main record is enclosed, this will show known public water mains in the vicinity of the property. It should be possible to estimate the likely length and route of any private water supply pipe connecting the property to the public water network.

Payment for this Search

There is no fee associated with this enquiry, and thus no payment is required.

Asset location search



Property Searches

Further contacts:

Waste Water queries

Should you require verification of the invert levels of public sewers, by site measurement, you will need to approach the relevant Thames Water Area Network Office for permission to lift the appropriate covers. This permission will usually involve you completing a TWOSA form. For further information please contact our Customer Centre on Tel: 0845 920 0800. Alternatively, a survey can be arranged, for a fee, through our Customer Centre on the above number.

If you have any questions regarding sewer connections, budget estimates, diversions, building over issues or any other questions regarding operational issues please direct them to our service desk. Which can be contacted by writing to:

Developer Services (Waste Water)
Thames Water
Clearwater Court
Vastern Road
Reading
RG1 8DB


Tel: 0800 009 3921
Email: developer.services@thameswater.co.uk

Clean Water queries

Should you require any advice concerning clean water operational issues or clean water connections, please contact:

Developer Services (Clean Water)
Thames Water
Clearwater Court
Vastern Road
Reading
RG1 8DB

Tel: 0800 009 3921
Email: developer.services@thameswater.co.uk

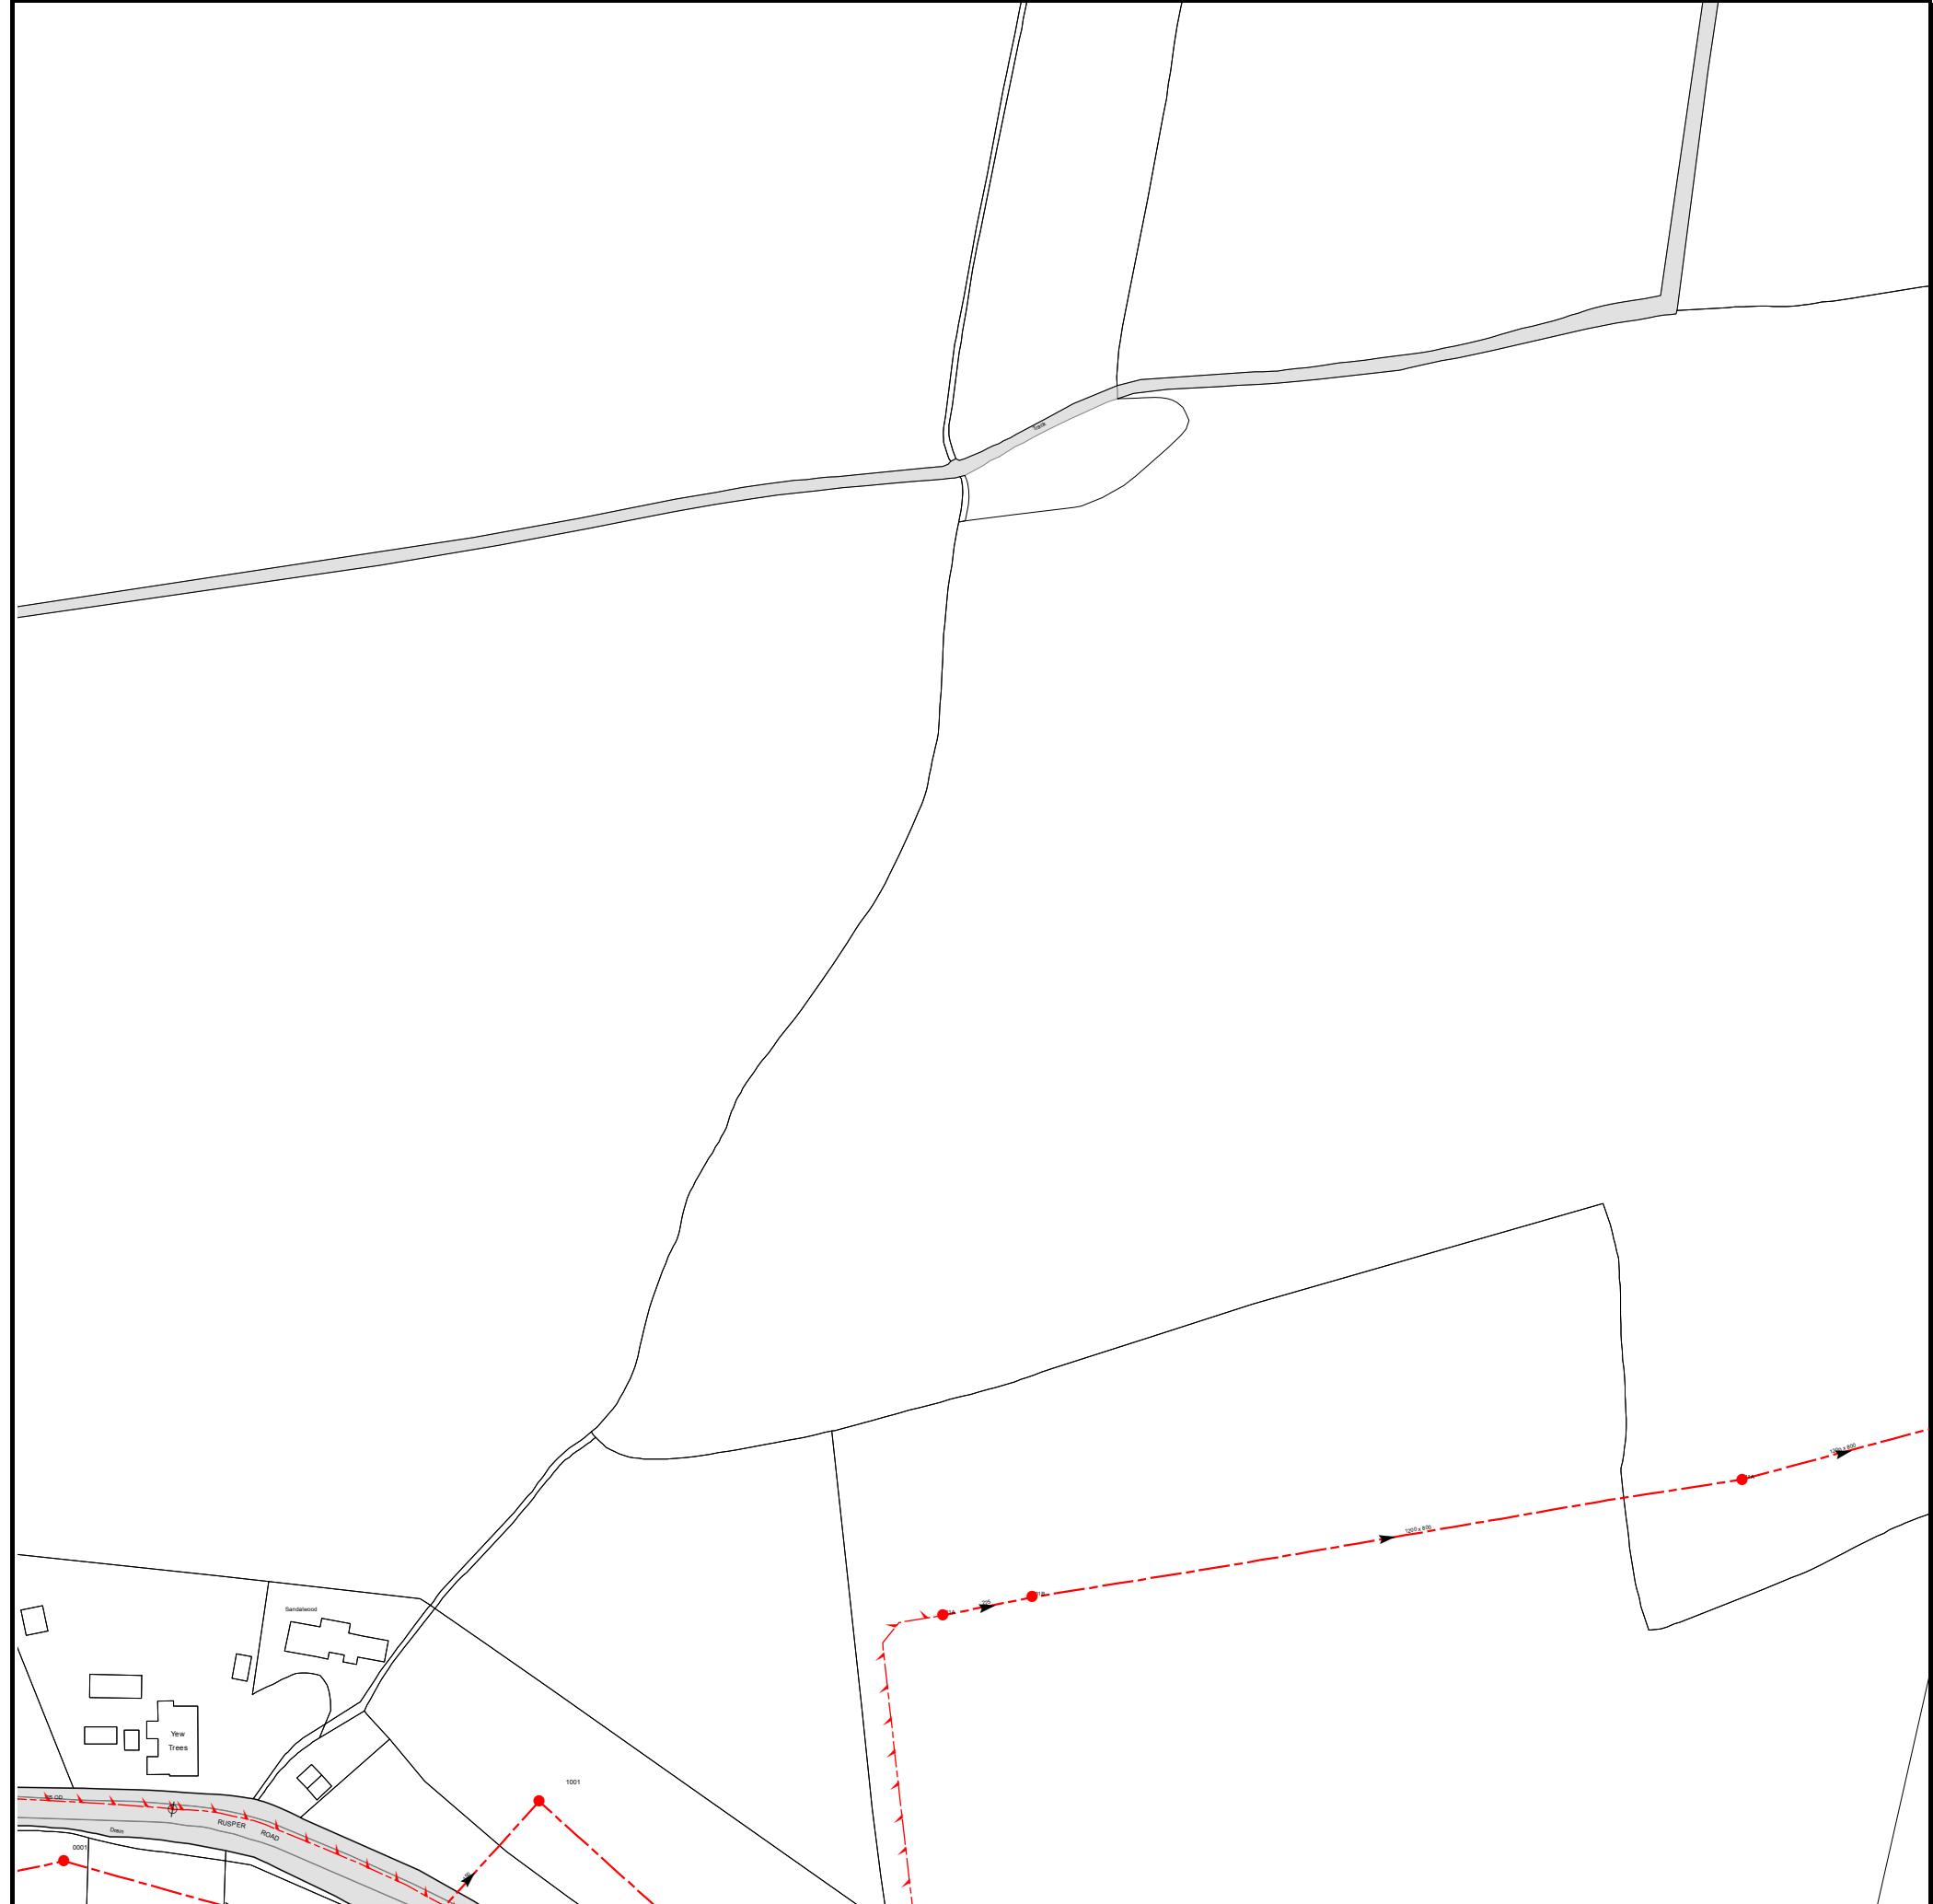

The width of the displayed area is 500m and the centre of the map is located at OS coordinates 524250,137250


The position of the apparatus shown on this plan is given without obligation and warranty, and the accuracy cannot be guaranteed. Service pipes are not shown but their presence should be anticipated. No liability of any kind whatsoever is accepted by Thames Water for any error or omission. The actual position of mains and services must be verified and established on site before any works are undertaken.

Based on the Ordnance Survey Map (2020) with the Sanction of the controller of H.M. Stationery Office, License no. 100019345 Crown Copyright Reserved.

NB. Levels quoted in metres Ordnance Newlyn Datum. The value -9999.00 indicates that no survey information is available

| Manhole Reference | Manhole Cover Level | Manhole Invert Level |
|-------------------|---------------------|----------------------|
| 411A | 66.95 | 63.11 |
| 201A | 65.89 | 64.61 |
| 201B | 66.34 | 63.86 |
| 1001 | 65.08 | 63.35 |
| 0001 | n/a | n/a |


The position of the apparatus shown on this plan is given without obligation and warranty, and the accuracy cannot be guaranteed. Service pipes are not shown but their presence should be anticipated. No liability of any kind whatsoever is accepted by Thames Water for any error or omission. The actual position of mains and services must be verified and established on site before any works are undertaken.

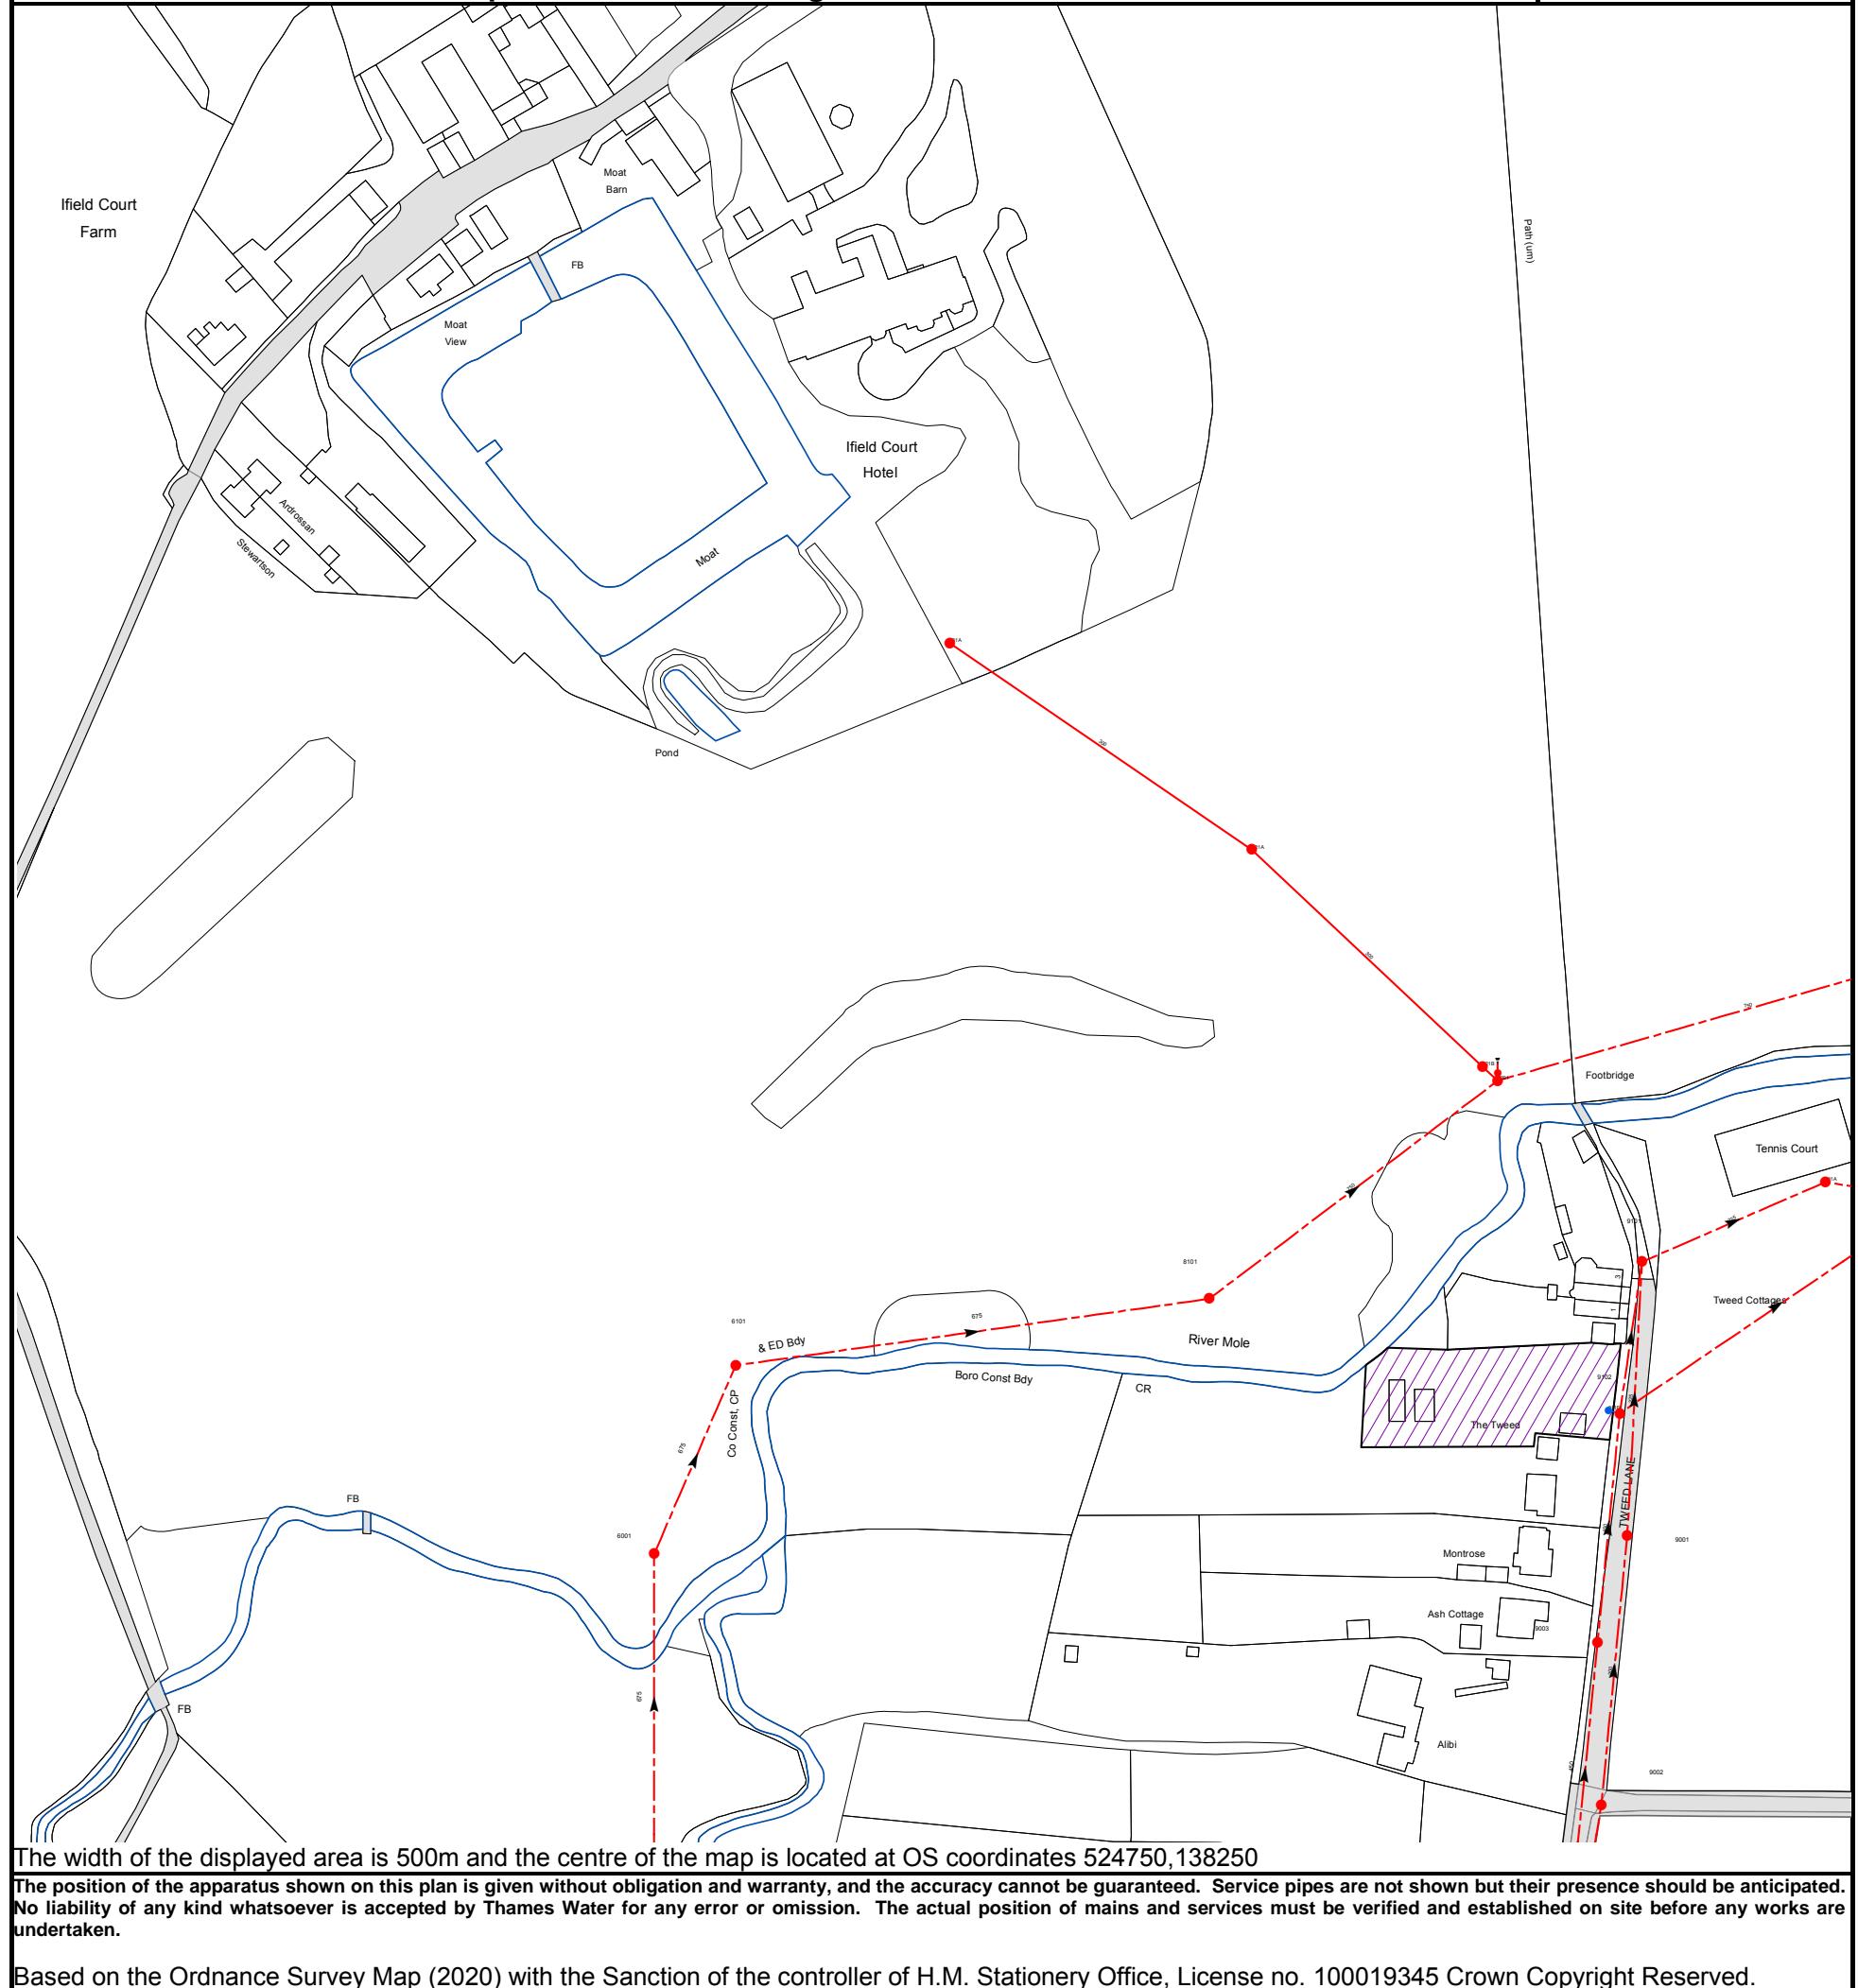

NB. Levels quoted in metres Ordnance Newlyn Datum. The value -9999.00 indicates that no survey information is available

| Manhole Reference | Manhole Cover Level | Manhole Invert Level |
|-------------------|---------------------|----------------------|
| 911A | n/a | n/a |
| 911B | n/a | n/a |
| 9102 | 63.45 | 60.3 |
| 9002 | 64.01 | n/a |
| 9003 | 63.77 | n/a |
| 6001 | 63.05 | 58.85 |
| 9001 | n/a | n/a |
| 6101 | 62.73 | 58.76 |
| 8101 | 62.5 | 58.42 |
| 9101 | 62.8 | 61.51 |
| 9201 | 62.47 | 58.15 |
| 821B | n/a | n/a |
| 821A | n/a | n/a |
| 731A | n/a | n/a |

The position of the apparatus shown on this plan is given without obligation and warranty, and the accuracy cannot be guaranteed. Service pipes are not shown but their presence should be anticipated. No liability of any kind whatsoever is accepted by Thames Water for any error or omission. The actual position of mains and services must be verified and established on site before any works are undertaken.

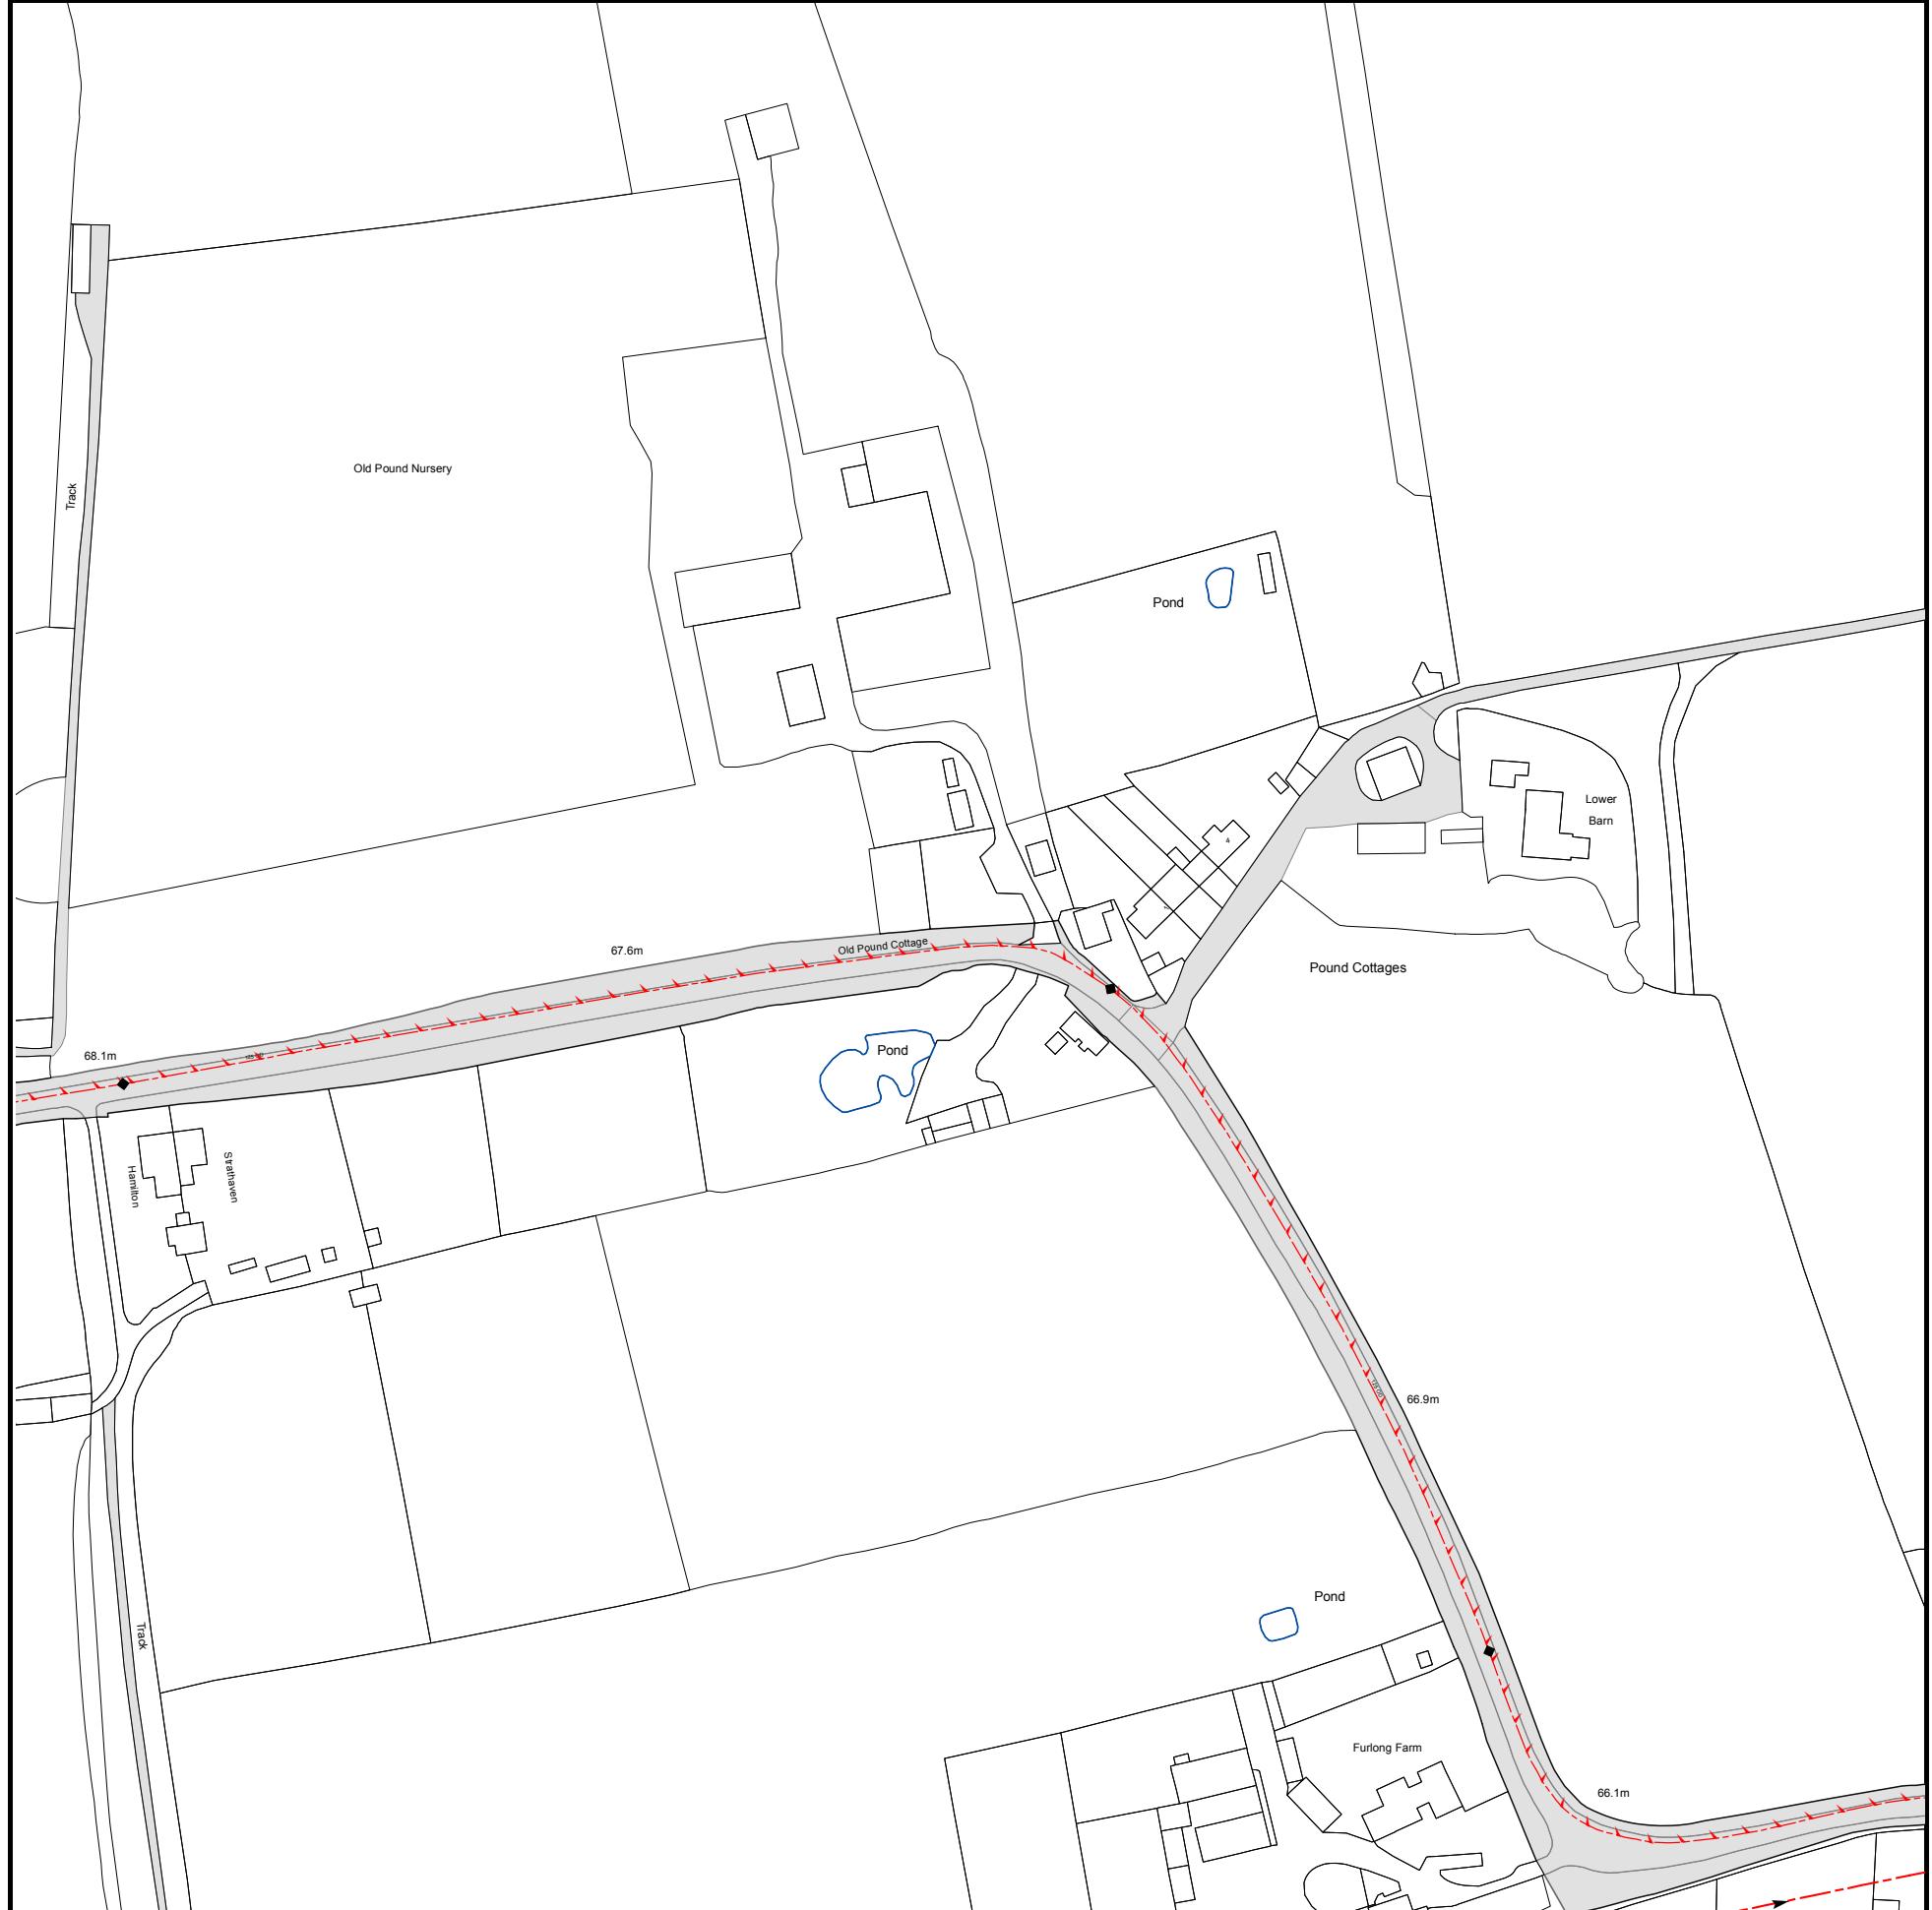


NB. Levels quoted in metres Ordnance Newlyn Datum. The value -9999.00 indicates that no survey information is available

| Manhole Reference | Manhole Cover Level | Manhole Invert Level |
|-------------------|---------------------|----------------------|
| n/a | n/a | n/a |

The position of the apparatus shown on this plan is given without obligation and warranty, and the accuracy cannot be guaranteed. Service pipes are not shown but their presence should be anticipated. No liability of any kind whatsoever is accepted by Thames Water for any error or omission. The actual position of mains and services must be verified and established on site before any works are undertaken.

Asset Location Search Sewer Map - ALS/ALS Non Chargeable/2023_4825611

TQ2436NW

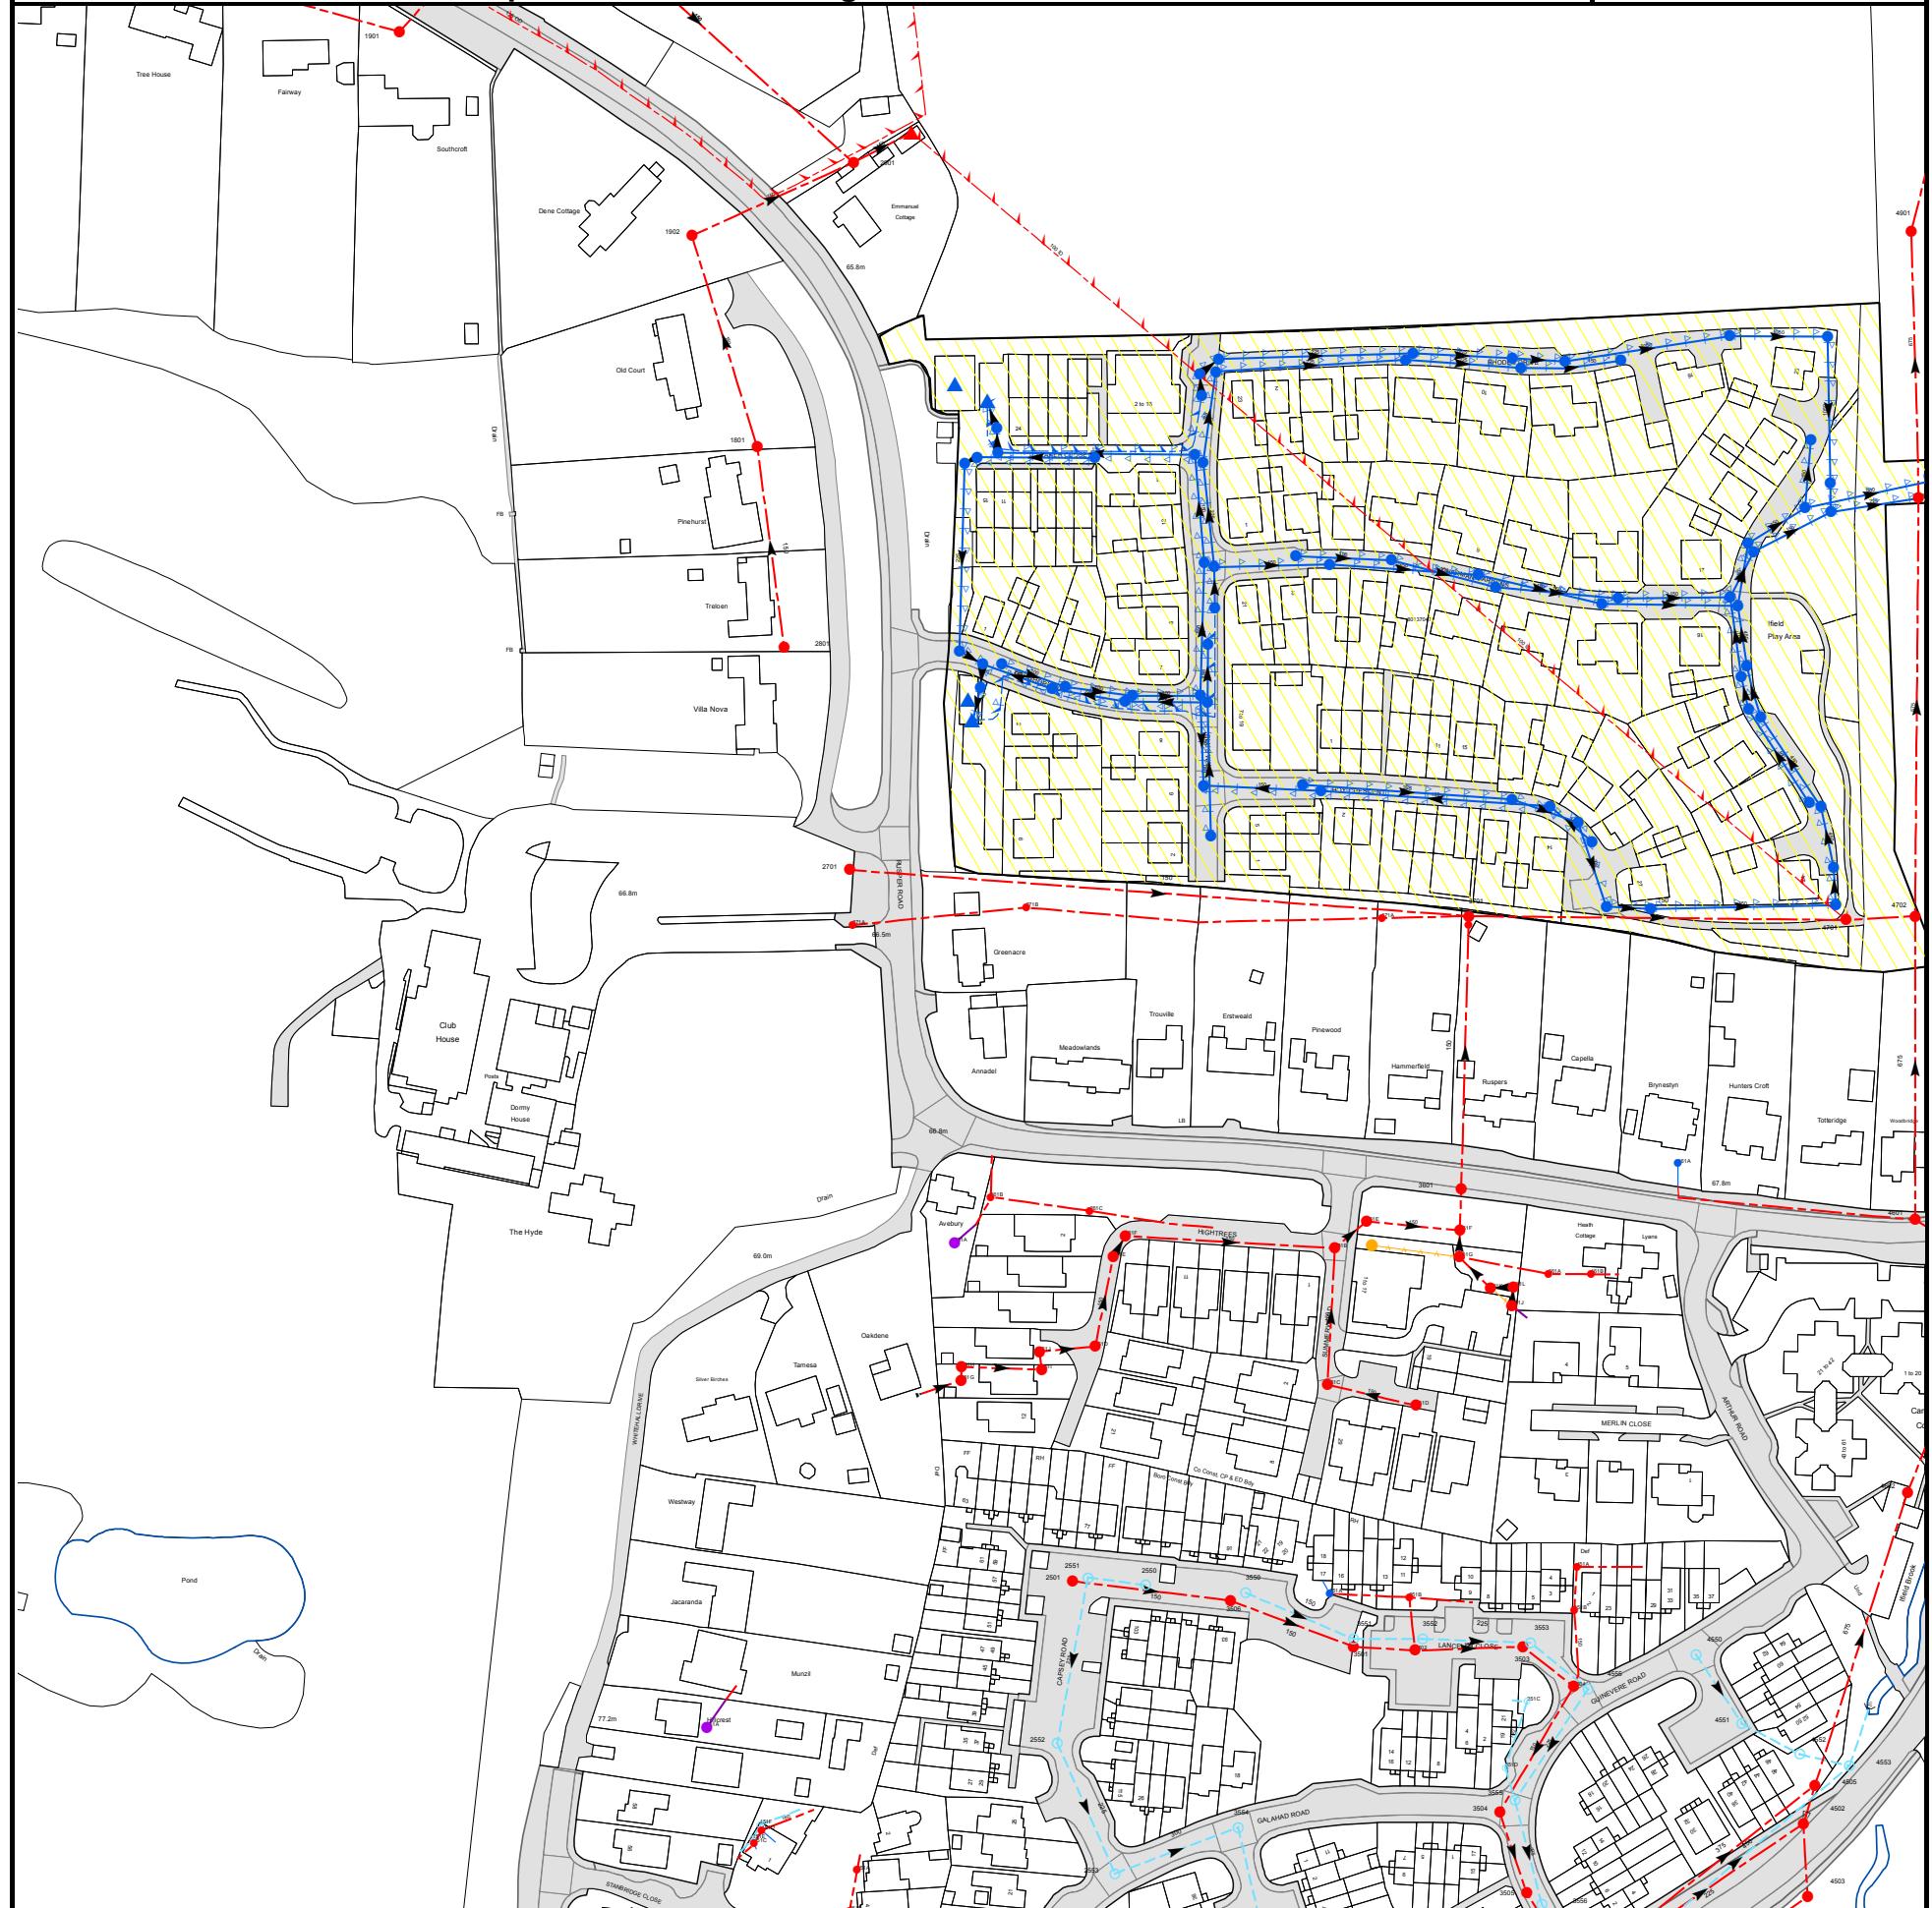

The width of the displayed area is 500m and the centre of the map is located at OS coordinates 524250,136750

The position of the apparatus shown on this plan is given without obligation and warranty, and the accuracy cannot be guaranteed. Service pipes are not shown but their presence should be anticipated. No liability of any kind whatsoever is accepted by Thames Water for any error or omission. The actual position of mains and services must be verified and established on site before any works are undertaken.

Based on the Ordnance Survey Map (2020) with the Sanction of the controller of H.M. Stationery Office, License no. 100019345 Crown Copyright Reserved.

NB. Levels quoted in metres Ordnance Newlyn Datum. The value -9999.00 indicates that no survey information is available

| Manhole Reference | Manhole Cover Level | Manhole Invert Level |
|-------------------|---------------------|----------------------|
| n/a | n/a | n/a |
| 1801 | 65.8 | 64.31 |
| n/a | n/a | n/a |
| 1902 | 65.53 | 63.85 |
| 2901 | 65.48 | 63.03 |
| n/a | n/a | n/a |
| 4901 | 66.74 | 62.79 |
| 4801 | 66.77 | 63.14 |
| n/a | n/a | n/a |
| 2801 | 66.11 | 64.71 |
| 2701 | n/a | n/a |
| n/a | n/a | n/a |
| 4702 | n/a | n/a |
| 3701 | 67.9 | 64.41 |
| n/a | n/a | n/a |
| 361J | n/a | n/a |
| 361K | n/a | n/a |
| 361L | n/a | n/a |
| 461B | n/a | n/a |
| 361A | n/a | n/a |
| 361G | 67.62 | 65.87 |
| 361F | n/a | 65.85 |
| 361E | 67.56 | 65.99 |
| 4601 | 66.96 | 63.81 |
| 3601 | 67.42 | 65.78 |
| 461A | n/a | n/a |
| 4701 | 68.03 | 64.01 |
| 371A | n/a | n/a |
| 3550 | 70.21 | 68.58 |
| 2550 | 71.13 | 69.31 |
| 2501 | 71.78 | 69.93 |
| 2551 | 71.56 | 69.04 |
| 361C | 68.11 | 66.35 |

| Manhole Reference | Manhole Cover Level | Manhole Invert Level |
|-------------------|---------------------|----------------------|
| 261G | n/a | n/a |
| 261I | n/a | 67.935 |
| 261H | n/a | n/a |
| 261J | n/a | 67.7 |
| 261D | 69.04 | 66.73 |
| 261E | 68.44 | 66.52 |
| 361B | 67.63 | 66.13 |
| 261A | n/a | n/a |
| 261F | 68.3 | 66.5 |
| 261C | n/a | n/a |
| 261B | n/a | n/a |
| 271A | n/a | n/a |
| 271B | n/a | n/a |
| n/a | n/a | n/a |
| 3551 | 70.21 | 67.97 |
| 3501 | 70.37 | 67.69 |
| 351B | n/a | n/a |
| 3502 | 69.58 | 67.33 |
| 361D | 68.08 | 66.74 |
| 3552 | 69.58 | 67.94 |
| 3503 | 69.23 | 66.92 |
| 351C | n/a | n/a |
| 3553 | 69.17 | 67.87 |
| 4504 | 68.94 | n/a |
| 451B | n/a | n/a |
| 451A | n/a | n/a |
| 4555 | 68.88 | 67.46 |
| 4550 | n/a | n/a |
| 4551 | 67.5 | 66.35 |
| 4552 | n/a | n/a |
| 4602 | 66.98 | 63.98 |
| 3504 | 69.18 | 66.11 |
| 351D | n/a | n/a |
| 3555 | 69.27 | 67.14 |
| 3505 | 68.57 | 65.84 |
| 3556 | n/a | n/a |
| 4502 | 67.51 | 64.06 |
| 4503 | 67.26 | 64.01 |
| 4505 | 67.72 | 64.06 |
| 4553 | 67.51 | 65.72 |
| 251B | n/a | n/a |
| 2553 | 72.3 | 68 |
| 251A | n/a | n/a |
| 151C | n/a | n/a |
| 151E | n/a | n/a |
| 151D | n/a | n/a |
| 3554 | 71.57 | 67.82 |
| 151F | n/a | n/a |
| 2552 | 72.84 | 68.56 |
| 151A | n/a | n/a |
| 3506 | 70.31 | 68.19 |
| 351A | n/a | n/a |
| 1901 | 65.41 | 63.81 |

The position of the apparatus shown on this plan is given without obligation and warranty, and the accuracy cannot be guaranteed. Service pipes are not shown but their presence should be anticipated. No liability of any kind whatsoever is accepted by Thames Water for any error or omission. The actual position of mains and services must be verified and established on site before any works are undertaken.

Asset Location Search Sewer Map - ALS/ALS Non Chargeable/2023_4825611

TQ2336SE



The width of the displayed area is 500m and the centre of the map is located at OS coordinates 523750,136250

The position of the apparatus shown on this plan is given without obligation and warranty, and the accuracy cannot be guaranteed. Service pipes are not shown but their presence should be anticipated. No liability of any kind whatsoever is accepted by Thames Water for any error or omission. The actual position of mains and services must be verified and established on site before any works are undertaken.

Based on the Ordnance Survey Map (2020) with the Sanction of the controller of H.M. Stationery Office, License no. 100019345 Crown Copyright Reserved.


NB. Levels quoted in metres Ordnance Newlyn Datum. The value -9999.00 indicates that no survey information is available

| Manhole Reference | Manhole Cover Level | Manhole Invert Level |
|-------------------|---------------------|----------------------|
| 9056 | 85.97 | 84.72 |
| 9005 | 86.11 | 84.07 |
| 9055 | 85.23 | 83.66 |
| 801D | n/a | n/a |
| 8101 | 82.4 | 80.05 |
| 9152 | 82.35 | 80.63 |
| 9155 | 83.73 | 81.77 |
| 9001 | 85.73 | 83.47 |
| 9050 | 85.75 | 83.95 |
| 9002 | 86.73 | 85.23 |
| 9254 | 78.68 | 77.66 |
| 9204 | 78.94 | 77 |
| 911B | n/a | n/a |
| 9101 | 79.91 | 77.42 |
| 9150 | 79.72 | n/a |
| 9102 | 80.43 | 78.61 |
| 911A | n/a | n/a |
| 9151 | 80.48 | 79.27 |
| 9054 | 86.02 | 84.59 |
| 9153 | 81.63 | 79.81 |
| 9003 | 86.03 | 83.78 |
| 9052 | 85.96 | 84.45 |
| 9154 | 83.95 | 81.91 |
| 9103 | 85.12 | 82.34 |
| 9053 | 85.74 | 84.39 |
| 9004 | 85.77 | 83.34 |
| 9051 | 85.29 | 83.19 |
| 8203 | 75.92 | 73.26 |
| 8251 | 75.79 | 73.25 |
| 8256 | 77.41 | 75.92 |
| 821D | n/a | n/a |
| 821B | n/a | n/a |
| 8202 | 75.73 | 72.16 |
| 8302 | 73.31 | 71.42 |
| 9301 | 73.57 | 71.08 |
| 9302 | n/a | n/a |
| 9256 | 74.8 | 73.73 |
| 921F | n/a | n/a |
| 9255 | 74.94 | 73.5 |
| 9253 | 77.34 | 75.84 |
| 9203 | 77.48 | 75.4 |
| 931A | n/a | n/a |
| 9205 | 75.29 | 73.22 |
| 921B | n/a | n/a |
| 921A | n/a | n/a |
| 921C | n/a | n/a |
| 921D | n/a | n/a |
| 9252 | 75.78 | 73.38 |
| 921E | n/a | n/a |
| 9202 | 75.78 | 72.98 |
| 9250 | 74.3 | 72.85 |
| 9303 | n/a | n/a |
| 9351 | n/a | n/a |
| 9251 | 75.11 | 73.19 |
| 9201 | 75.07 | 72.71 |
| 8050 | 87.55 | 86.28 |
| 8002 | 86.26 | 84.4 |
| 8051 | 86.33 | 84.89 |
| 8001 | 86.41 | 84.32 |
| 801I | n/a | n/a |
| 801J | n/a | n/a |
| 801K | n/a | n/a |
| 801M | n/a | n/a |
| 801F | n/a | n/a |
| 801E | n/a | n/a |
| 7152 | 86.3 | 84.39 |
| 7102 | 86.19 | 83.73 |
| 8106 | 85.59 | 83.21 |
| 8105 | 85.42 | 82.86 |
| 711A | n/a | n/a |
| 8104 | 83.39 | 80.73 |
| 8150 | 83.44 | 81.04 |
| 8151 | 83.07 | 80.91 |
| 8102 | 83.05 | 80.47 |
| 8103 | 82.37 | 80.56 |
| 7158 | n/a | n/a |
| 7159 | 81.7 | n/a |
| 7160 | n/a | n/a |
| 811A | n/a | n/a |
| 8257 | 78.77 | 77.16 |
| 8206 | 79.38 | 77.3 |
| 8255 | 79.3 | 77.46 |
| 7253 | 80.25 | 78.67 |
| 7252 | 79.09 | 77.89 |
| 7201 | 78.65 | 75.17 |
| 7351 | 78.35 | 76.53 |
| 721C | n/a | n/a |
| 721D | n/a | n/a |
| 7203 | 78.2 | 76.12 |
| 7251 | 78.16 | 76.61 |

| Manhole Reference | Manhole Cover Level | Manhole Invert Level |
|-------------------|---------------------|----------------------|
| 7202 | 77.7 | 74.69 |
| 7250 | 77.53 | 76.09 |
| 7204 | 78.27 | 76.37 |
| 7258 | 78.32 | 77.04 |
| 8250 | 75.86 | 74.56 |
| 8201 | 75.64 | 73.85 |
| 8205 | 77.57 | 75.44 |
| 8350 | 74.51 | 73.27 |
| 8254 | 77.56 | 75.66 |
| 821F | n/a | n/a |
| 821H | n/a | n/a |
| 821G | n/a | n/a |
| 821I | n/a | n/a |
| 821E | n/a | n/a |
| 8301 | 73.61 | 72.39 |
| 8207 | 76.07 | 73.46 |
| 8253 | 77.3 | 75.18 |
| 8252 | 75.86 | 74.13 |
| 8204 | 77.22 | 74.52 |
| 8052 | 86.98 | 84.8 |
| 801A | n/a | n/a |
| 801H | n/a | n/a |
| 801G | n/a | n/a |
| 7050 | 89.17 | 87.72 |
| 7051 | 88.67 | 87.28 |
| 7002 | 88.79 | 87.09 |
| 801B | n/a | n/a |
| 7001 | 88.27 | 86.49 |
| 801C | n/a | n/a |
| 6104 | 85.06 | 82.47 |
| 611A | n/a | n/a |
| 6205 | 82.43 | 80.38 |
| 6253 | 82.31 | 80.83 |
| 6109 | n/a | n/a |
| 7153 | 87.3 | 84.59 |
| 711C | n/a | n/a |
| 7255 | 82.05 | 80.67 |
| 7206 | 82.27 | 80.32 |
| 7107 | 84.73 | 83.07 |
| 7157 | 84.55 | 83.15 |
| 7256 | 81.98 | 80.54 |
| 7104 | 83.69 | 81.55 |
| 7151 | 83.56 | 82.04 |
| 7105 | 84.24 | 81.77 |
| 7155 | 84.33 | 82.25 |
| 7103 | 81.81 | 79.86 |
| 7106 | 84.65 | 82.49 |
| 7154 | 86.93 | 84.49 |
| 7150 | 81.67 | 80.22 |
| 7156 | 84.83 | 83.1 |
| 7205 | 81.22 | 79.57 |
| 7101 | 86.59 | 83.96 |
| 7257 | 81.17 | 79.67 |
| 711B | n/a | n/a |
| 7259 | n/a | n/a |
| 7161 | n/a | n/a |
| 501A | n/a | n/a |
| 501B | n/a | n/a |
| 6002 | 86.7 | 85.38 |
| 6155 | 84.88 | 83.43 |
| 6050 | 86.78 | 85.69 |
| 6108 | 86.31 | 85.09 |
| 6158 | 86.42 | 85.2 |
| 601A | n/a | n/a |
| 621A | n/a | n/a |
| 611B | n/a | n/a |
| 611D | n/a | n/a |
| 611C | n/a | n/a |
| 6157 | 84.05 | 82.47 |
| 6107 | 84.12 | 82.1 |
| 6156 | 83.72 | 81.41 |
| 6154 | 84.85 | 83.14 |
| 6106 | 83.72 | 81.21 |
| 6105 | 84.74 | 82.75 |
| 6151 | 83.65 | 81.33 |
| 6102 | 83.71 | 80.87 |
| 6152 | 84.21 | 82.23 |
| 6150 | 82.9 | 81.2 |
| 6252 | 82.6 | 81.06 |
| 6101 | 82.9 | 80.68 |
| 6204 | 82.6 | 80.64 |
| 6103 | 84.68 | 82.22 |
| 6153 | 84.98 | 82.91 |
| 5001 | 88.17 | 86.09 |
| 5050 | 88.21 | 86.33 |
| 501F | n/a | n/a |
| 601B | n/a | n/a |
| 501C | n/a | n/a |
| 501D | n/a | n/a |
| 501G | n/a | n/a |
| 601C | n/a | n/a |
| 6051 | 89.66 | 88.23 |
| 6001 | 89.54 | 87.59 |

| Manhole Reference | Manhole Cover Level | Manhole Invert Level |
|-------------------|---------------------|----------------------|
| 9352 | n/a | n/a |
| 6203 | 80.26 | 78.34 |
| 6251 | 80.2 | 78.98 |
| 6202 | 79.53 | 77.23 |
| 6250 | 79.57 | 77.88 |
| 6201 | 79.28 | 76.7 |
| 631A | n/a | n/a |
| 6301 | 78.7 | 76.13 |
| 631B | n/a | n/a |
| 7350 | 78.56 | 76.86 |
| 7254 | 79.32 | 77.64 |
| 721A | n/a | n/a |
| 721B | n/a | n/a |
| 731B | n/a | n/a |
| 731A | n/a | n/a |

The position of the apparatus shown on this plan is given without obligation and warranty, and the accuracy cannot be guaranteed. Service pipes are not shown but their presence should be anticipated. No liability of any kind whatsoever is accepted by Thames Water for any error or omission. The actual position of mains and services must be verified and established on site before any works are undertaken.

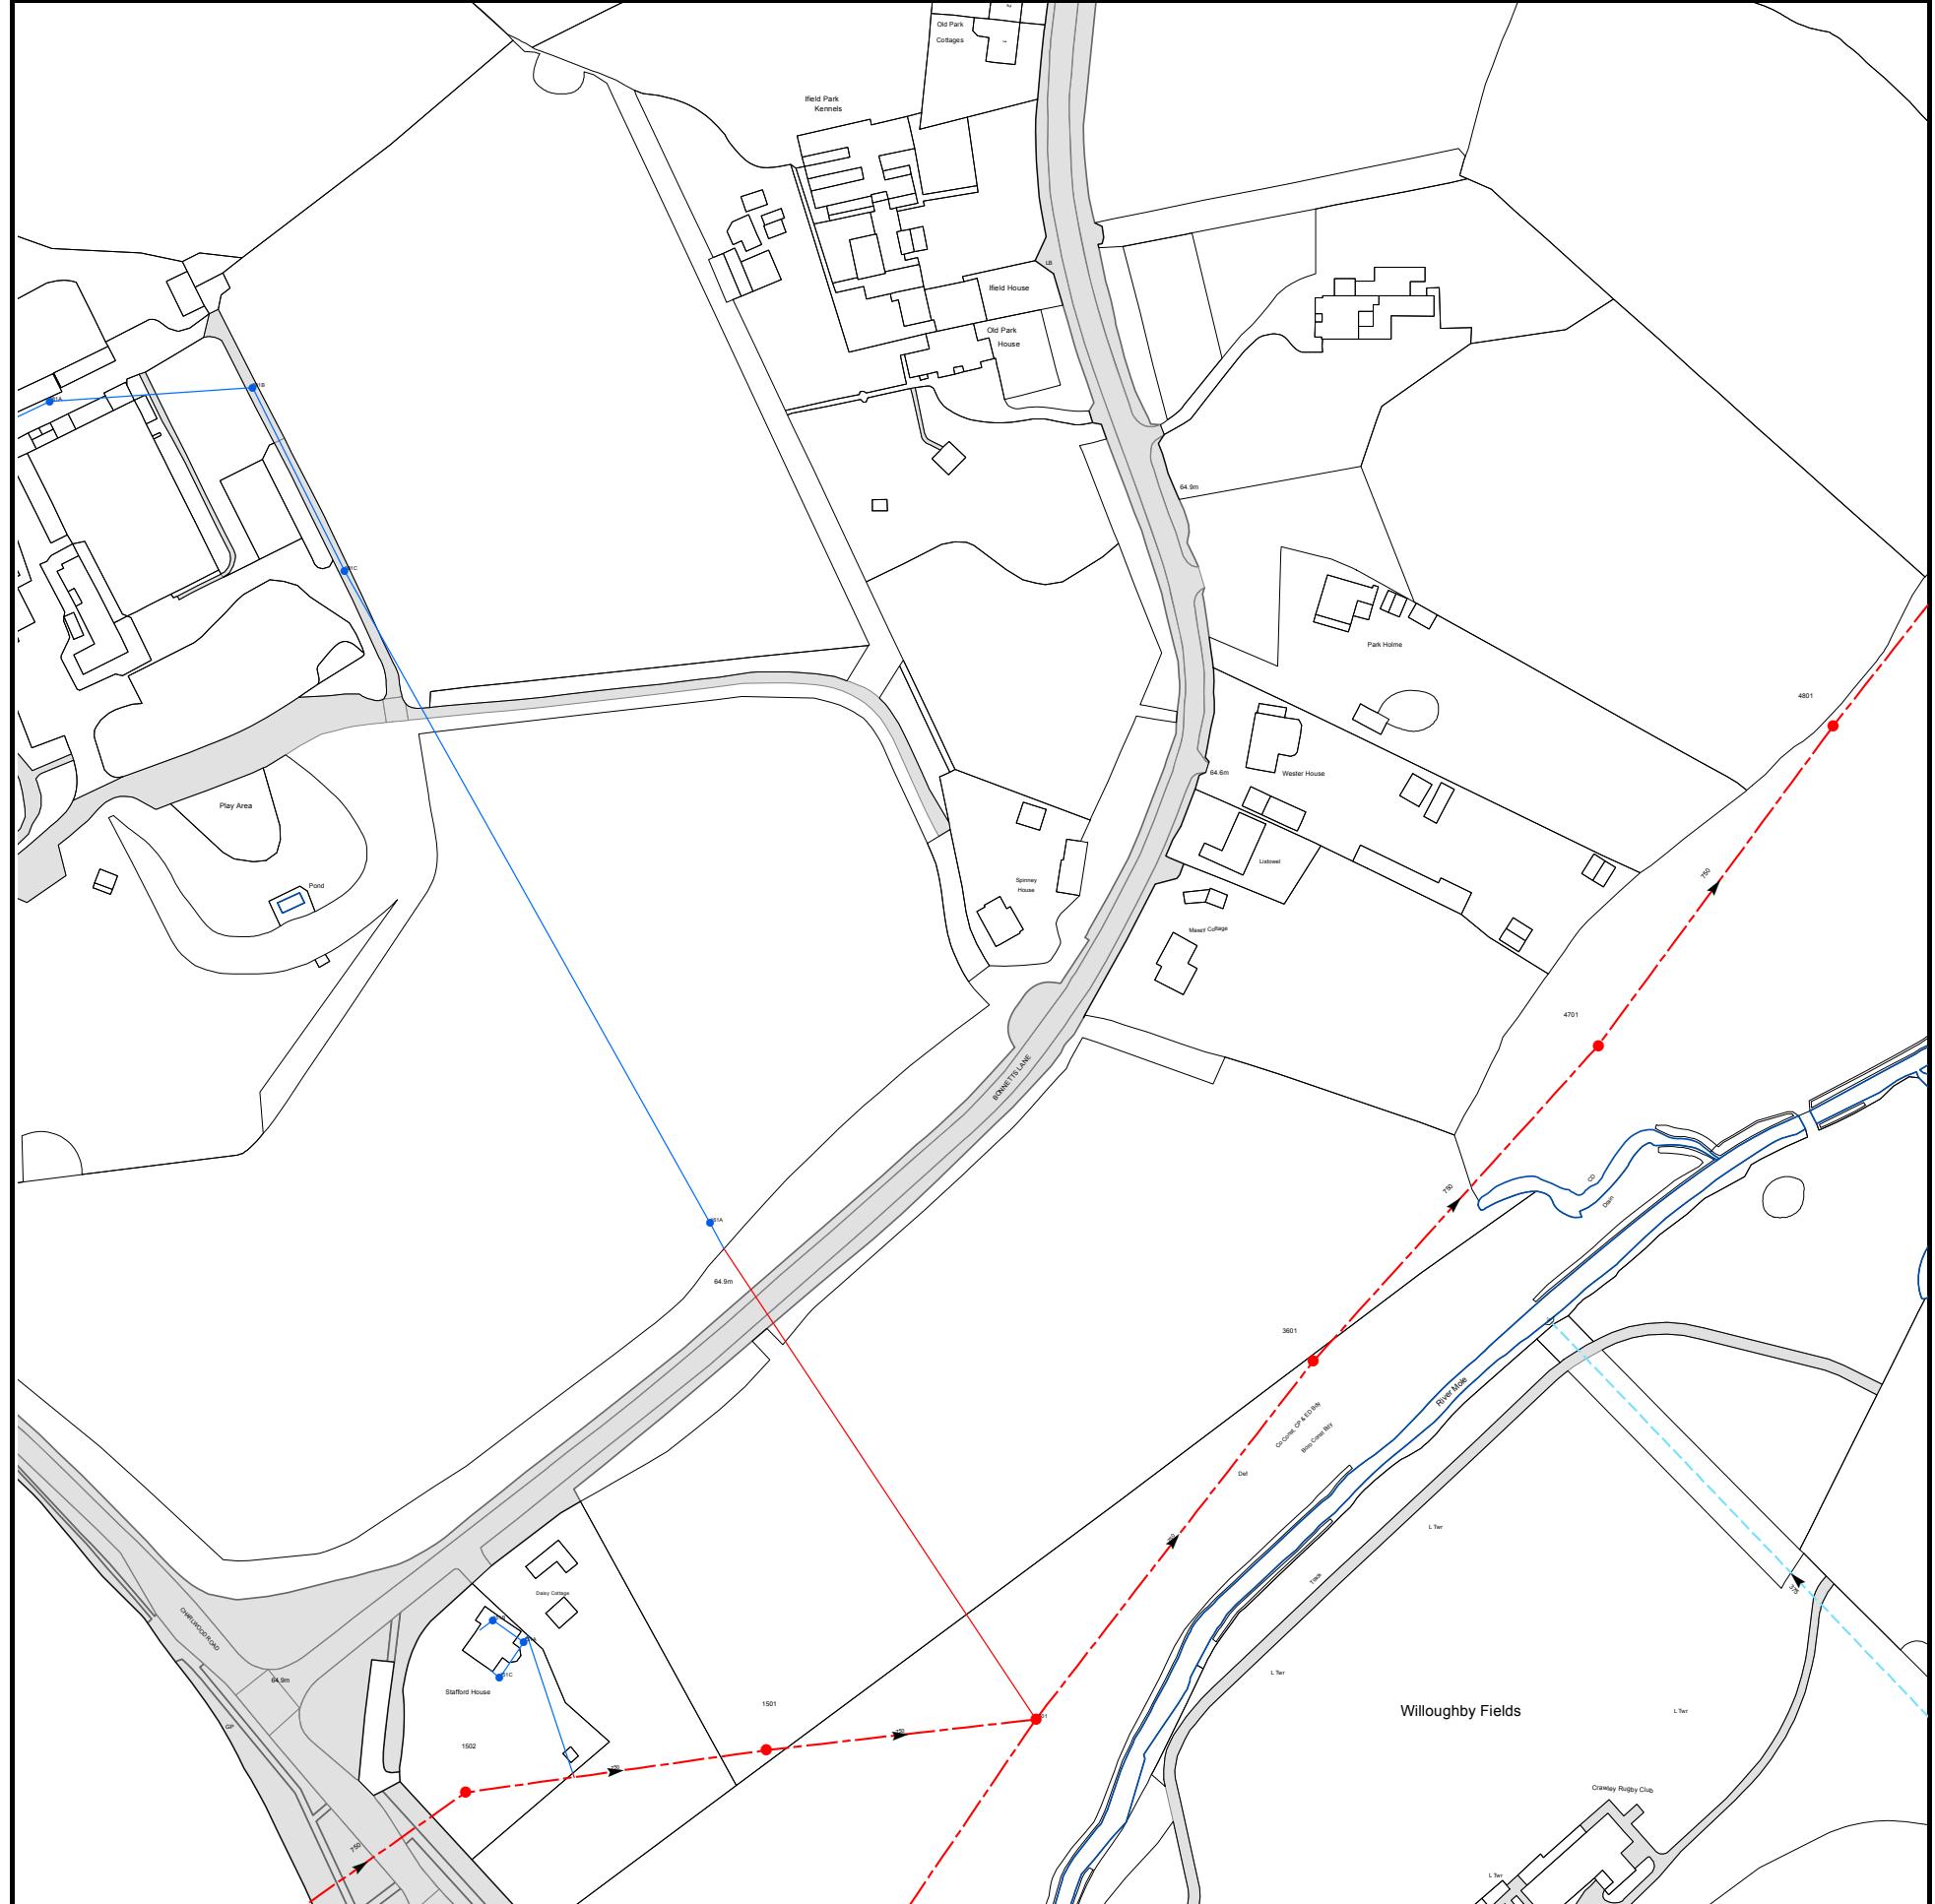

Based on the Ordnance Survey Map (2020) with the Sanction of the controller of H.M. Stationery Office, License no. 100019345 Crown Copyright Reserved.


NB. Levels quoted in metres Ordnance Newlyn Datum. The value -9999.00 indicates that no survey information is available

| Manhole Reference | Manhole Cover Level | Manhole Invert Level |
|-------------------|---------------------|----------------------|
| 4701 | 61.7 | 56.99 |
| 4801 | 61.58 | 56.76 |
| 081A | n/a | n/a |
| 081B | n/a | n/a |
| 081C | n/a | n/a |
| 1502 | 63.6 | 57.55 |
| 151B | n/a | n/a |
| 151C | n/a | n/a |
| 151A | n/a | n/a |
| 161A | n/a | n/a |
| 1501 | 62.76 | 57.46 |
| 2501 | 61.96 | 57.36 |
| 3601 | 61.45 | 57.2 |

The position of the apparatus shown on this plan is given without obligation and warranty, and the accuracy cannot be guaranteed. Service pipes are not shown but their presence should be anticipated. No liability of any kind whatsoever is accepted by Thames Water for any error or omission. The actual position of mains and services must be verified and established on site before any works are undertaken.

Asset Location Search Sewer Map - ALS/ALS Non Chargeable/2023_4825611

TQ2437SE

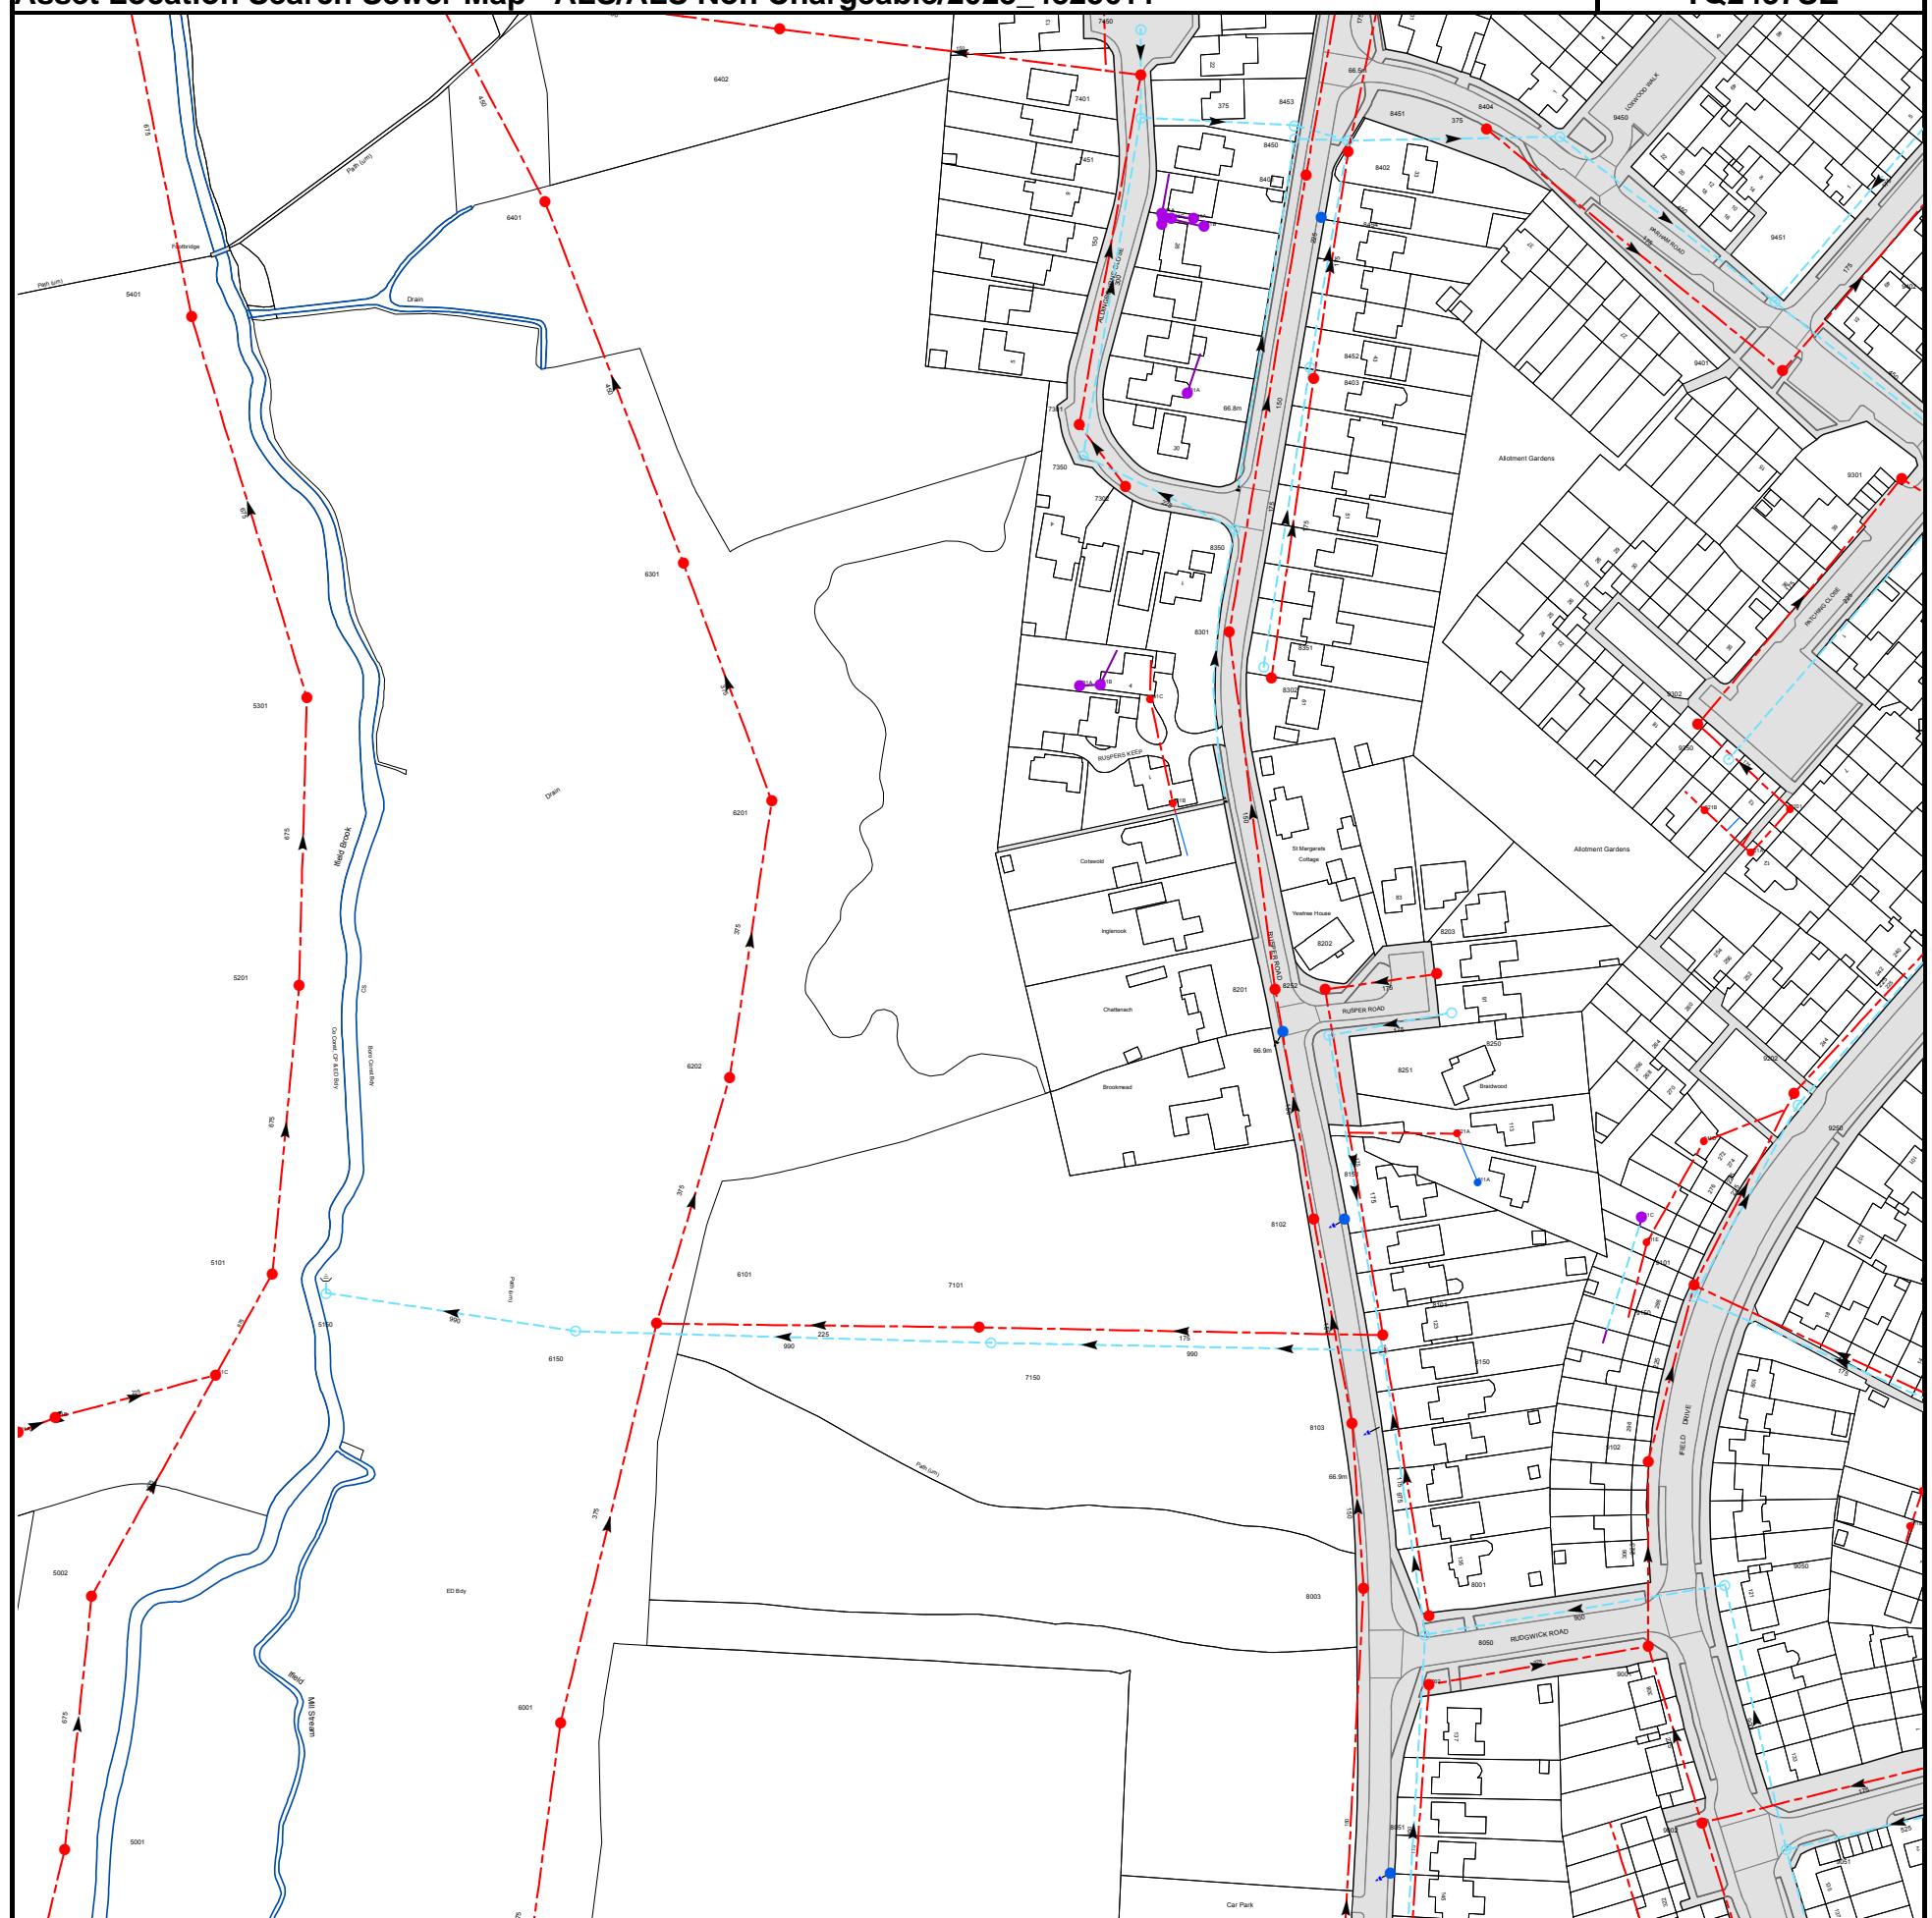

Based on the Ordnance Survey Map (2020) with the Sanction of the controller of H.M. Stationery Office, License no. 100019345 Crown Copyright Reserved.

NB. Levels quoted in metres Ordnance Newlyn Datum. The value -9999.00 indicates that no survey information is available

| Manhole Reference | Manhole Cover Level | Manhole Invert Level |
|-------------------|---------------------|----------------------|
| 9451 | 65.86 | 63.4 |
| 9401 | 66.01 | 64.11 |
| 9201 | 65.5 | 63.6 |
| 9301 | 65.39 | 62.92 |
| 9402 | 65.54 | 63.74 |
| 911E | n/a | n/a |
| 8151 | 67.06 | 66.1 |
| 911C | n/a | n/a |
| 811A | n/a | n/a |
| 911D | n/a | n/a |
| 821A | n/a | n/a |
| 8251 | 66.85 | 64.87 |
| 8250 | 66.79 | 65.18 |
| 8203 | 66.65 | 65.01 |
| 921A | n/a | n/a |
| 921B | n/a | n/a |
| 9350 | 65.66 | 63.81 |
| 9302 | 65.53 | 63.49 |
| 841B | n/a | n/a |
| 741C | n/a | n/a |
| 841C | n/a | n/a |
| 741B | n/a | n/a |
| 9202 | 65.81 | 63.49 |
| 9250 | 65.81 | 64.09 |
| 8051 | 67.04 | 66.4 |
| 9002 | 66.9 | 64.26 |
| 8002 | 66.79 | 64.31 |
| 9001 | 66.4 | 64.04 |
| 8050 | 66.65 | 64.17 |
| 8001 | 66.76 | 64.66 |
| 8003 | 67 | 66.31 |
| 9050 | 66.45 | 64.35 |
| 9102 | 66.25 | 63.83 |
| 8103 | 67.02 | 66.22 |
| 8150 | 66.93 | 63.75 |
| 8101 | 66.95 | 64 |
| 9150 | 65.97 | 64.13 |
| 9101 | 66.1 | 63.64 |
| 9051 | 66.77 | 64.99 |
| 911B | n/a | n/a |
| 911A | n/a | n/a |
| 8450 | n/a | n/a |
| 8401 | n/a | n/a |
| 8452 | 66.79 | 64.97 |
| 8403 | 66.8 | 65.31 |
| 8454 | n/a | n/a |
| 8451 | 66.66 | 64.44 |
| 8402 | 66.64 | 64.94 |
| 8404 | 66.11 | 64.81 |
| 9450 | 66.2 | 63.88 |
| 5401 | 65.22 | 61.22 |
| 6401 | n/a | n/a |
| 6402 | n/a | n/a |
| 7301 | 66.9 | 64.67 |
| 7350 | 66.99 | 65.42 |
| 7450 | 66.4 | 65.22 |
| 7451 | 66.49 | 64.84 |
| 7401 | 66.45 | 63.53 |
| 741A | n/a | n/a |
| 831A | n/a | n/a |
| 841A | n/a | n/a |
| 8453 | n/a | n/a |
| 6201 | 65.33 | 62.53 |
| 7101 | 67.25 | 63.3 |
| 7150 | 67.27 | 63.77 |
| 731A | n/a | n/a |
| 731B | n/a | n/a |
| 7302 | 66.99 | 64.86 |
| 731C | n/a | n/a |
| 821B | n/a | n/a |
| 8301 | n/a | n/a |
| 8350 | 66.87 | 65.83 |
| 8351 | 66.81 | 65.43 |
| 8302 | 66.79 | 65.76 |
| 8201 | 66.85 | 65.98 |
| 8252 | 66.83 | 65.24 |
| 8102 | 67.11 | n/a |
| 8202 | 66.96 | 64.64 |
| 511A | 66.75 | 62.89 |
| 511B | 66.7 | 62.83 |
| 5001 | 66.74 | 62.74 |
| 5002 | 66.09 | 62.41 |
| 511C | 66.46 | 62.44 |
| 5101 | 66.02 | 62.26 |
| 5201 | 65.75 | 61.95 |
| 5301 | 64.42 | 61.57 |
| 5150 | n/a | n/a |
| 6001 | 65.34 | 63.2 |
| 6150 | 65.27 | 63.67 |
| 6101 | 65.31 | 62.81 |

| Manhole Reference | Manhole Cover Level | Manhole Invert Level |
|-------------------|---------------------|----------------------|
| 6301 | 64.95 | 62.35 |
| 6202 | 65.16 | 62.77 |

The position of the apparatus shown on this plan is given without obligation and warranty, and the accuracy cannot be guaranteed. Service pipes are not shown but their presence should be anticipated. No liability of any kind whatsoever is accepted by Thames Water for any error or omission. The actual position of mains and services must be verified and established on site before any works are undertaken.




Based on the Ordnance Survey Map (2020) with the Sanction of the controller of H.M. Stationery Office, License no. 100019345 Crown Copyright Reserved.

NB. Levels quoted in metres Ordnance Newlyn Datum. The value -9999.00 indicates that no survey information is available

| Manhole Reference | Manhole Cover Level | Manhole Invert Level |
|-------------------|---------------------|----------------------|
| 981B | n/a | n/a |
| 981A | n/a | n/a |
| 981C | n/a | n/a |


The position of the apparatus shown on this plan is given without obligation and warranty, and the accuracy cannot be guaranteed. Service pipes are not shown but their presence should be anticipated. No liability of any kind whatsoever is accepted by Thames Water for any error or omission. The actual position of mains and services must be verified and established on site before any works are undertaken.

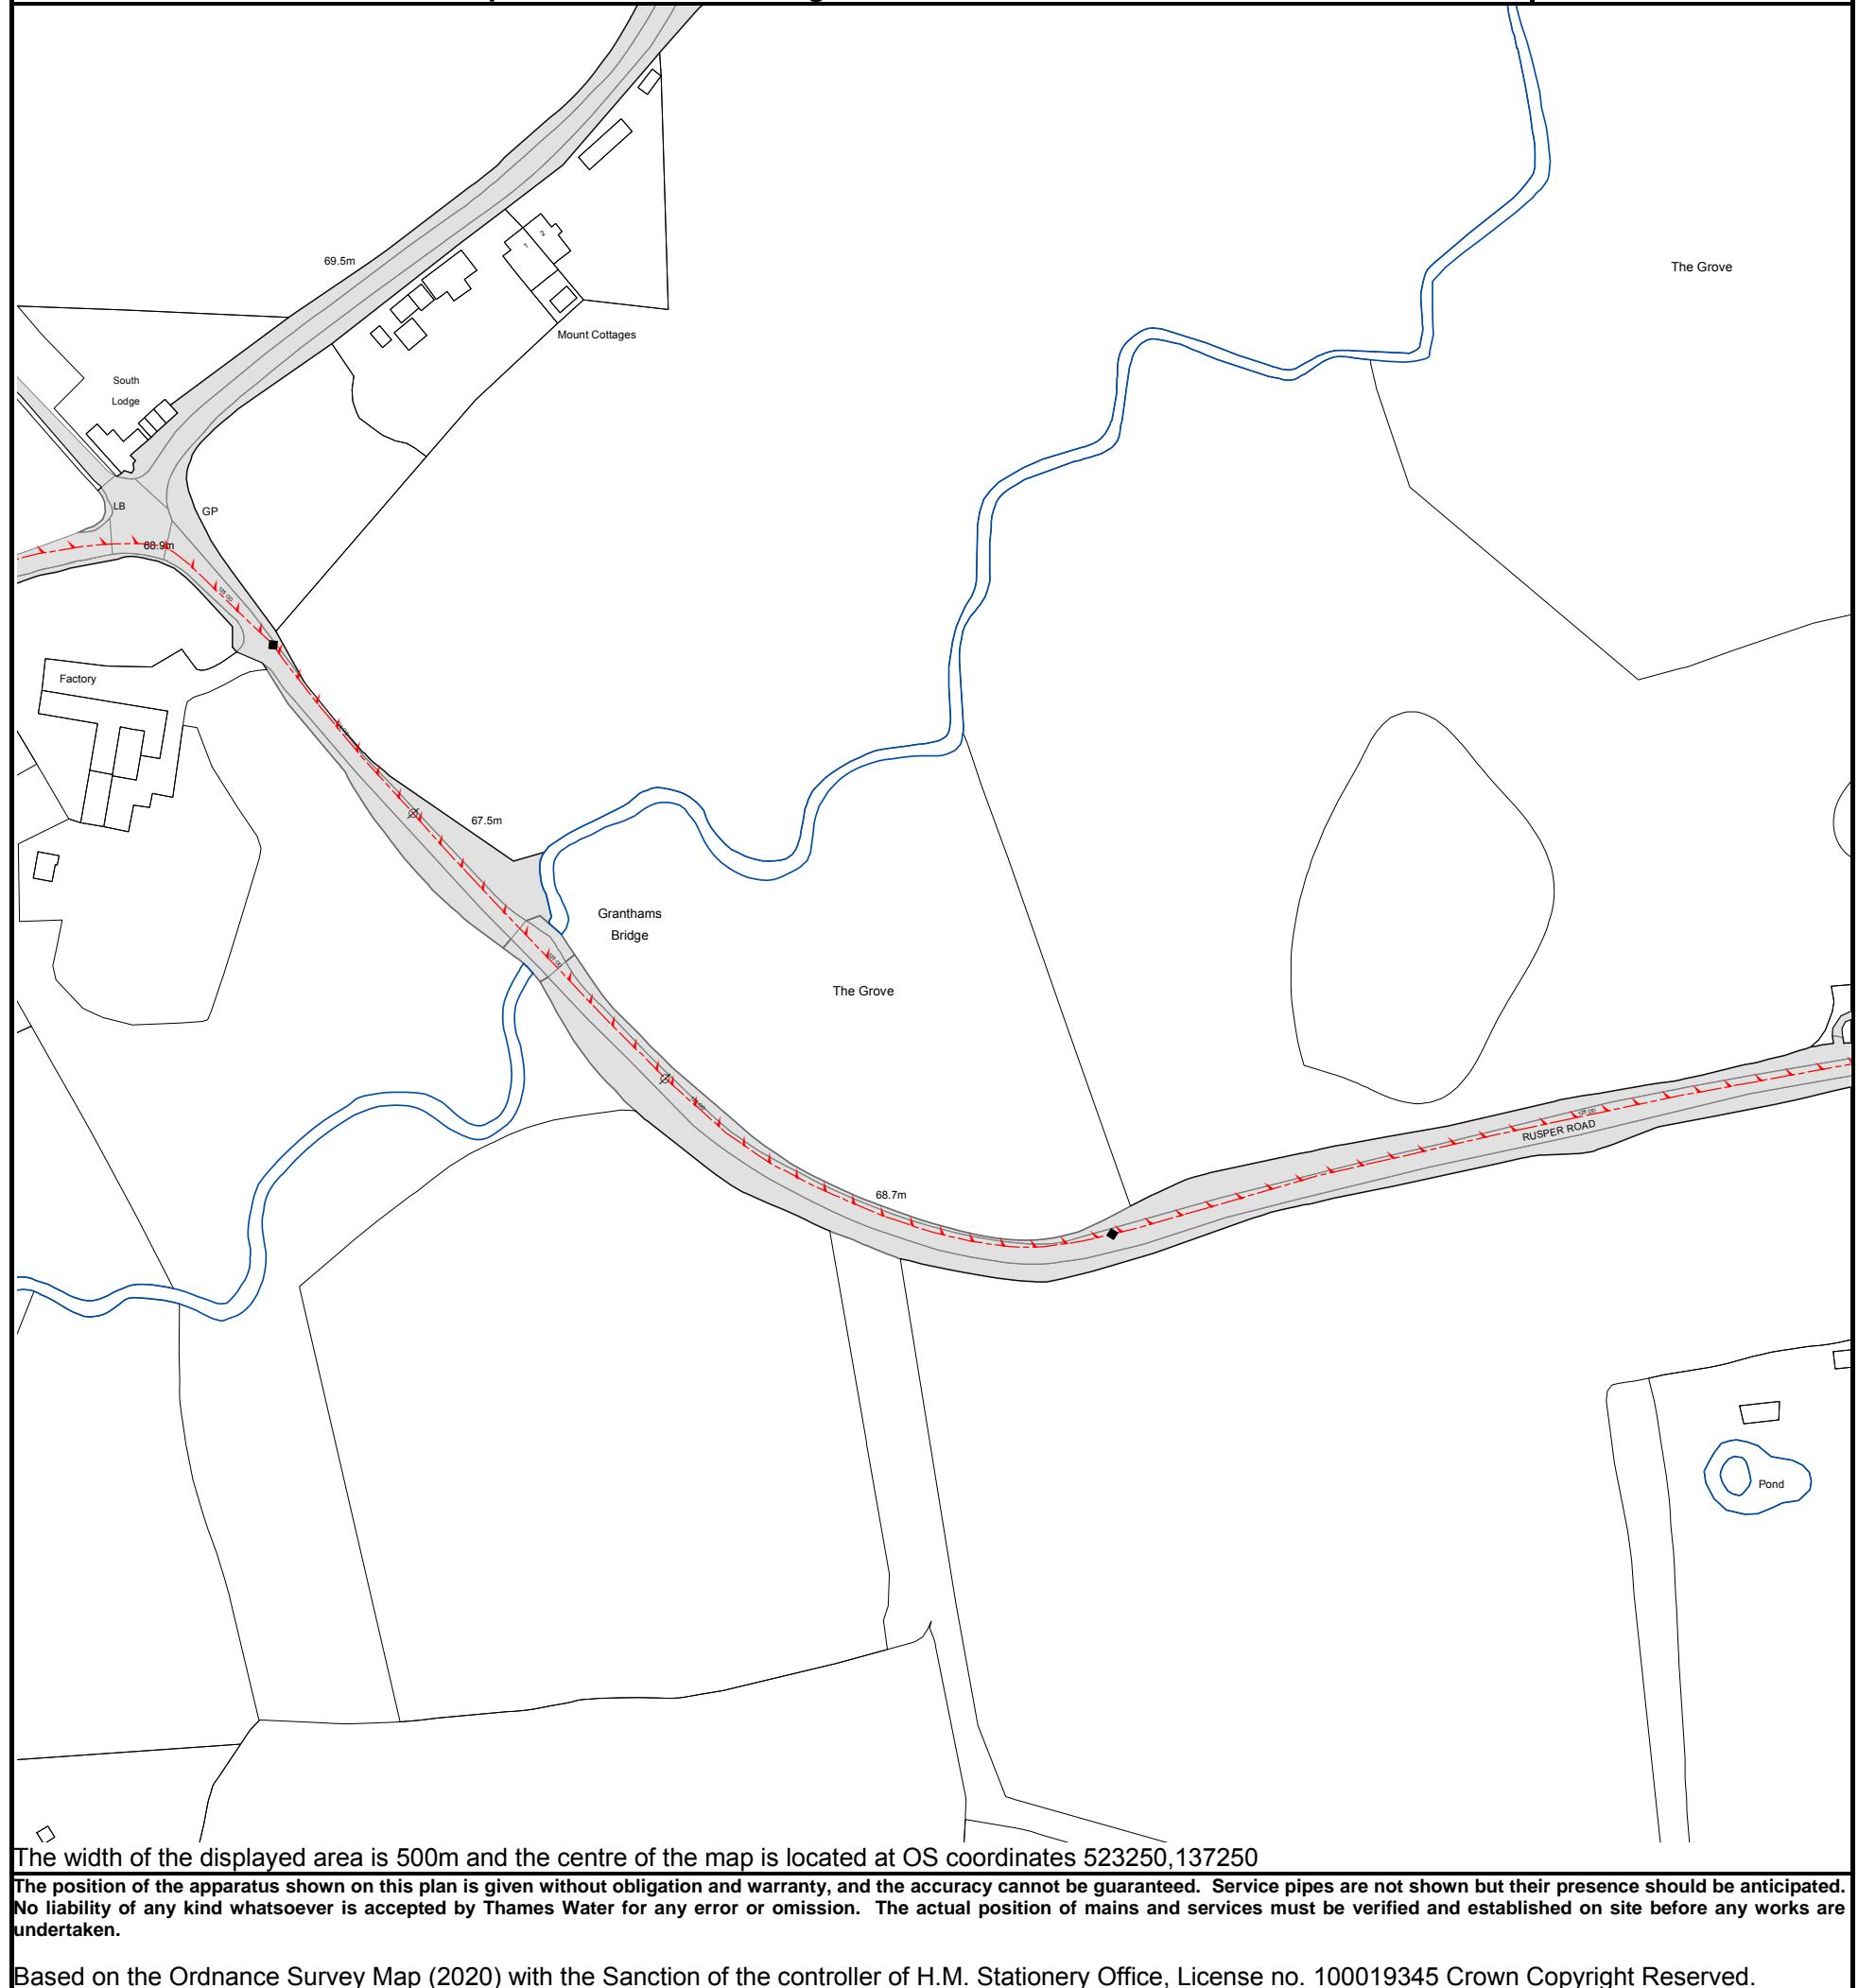

NB. Levels quoted in metres Ordnance Newlyn Datum. The value -9999.00 indicates that no survey information is available

| Manhole Reference | Manhole Cover Level | Manhole Invert Level |
|-------------------|---------------------|----------------------|
| n/a | n/a | n/a |

The position of the apparatus shown on this plan is given without obligation and warranty, and the accuracy cannot be guaranteed. Service pipes are not shown but their presence should be anticipated. No liability of any kind whatsoever is accepted by Thames Water for any error or omission. The actual position of mains and services must be verified and established on site before any works are undertaken.

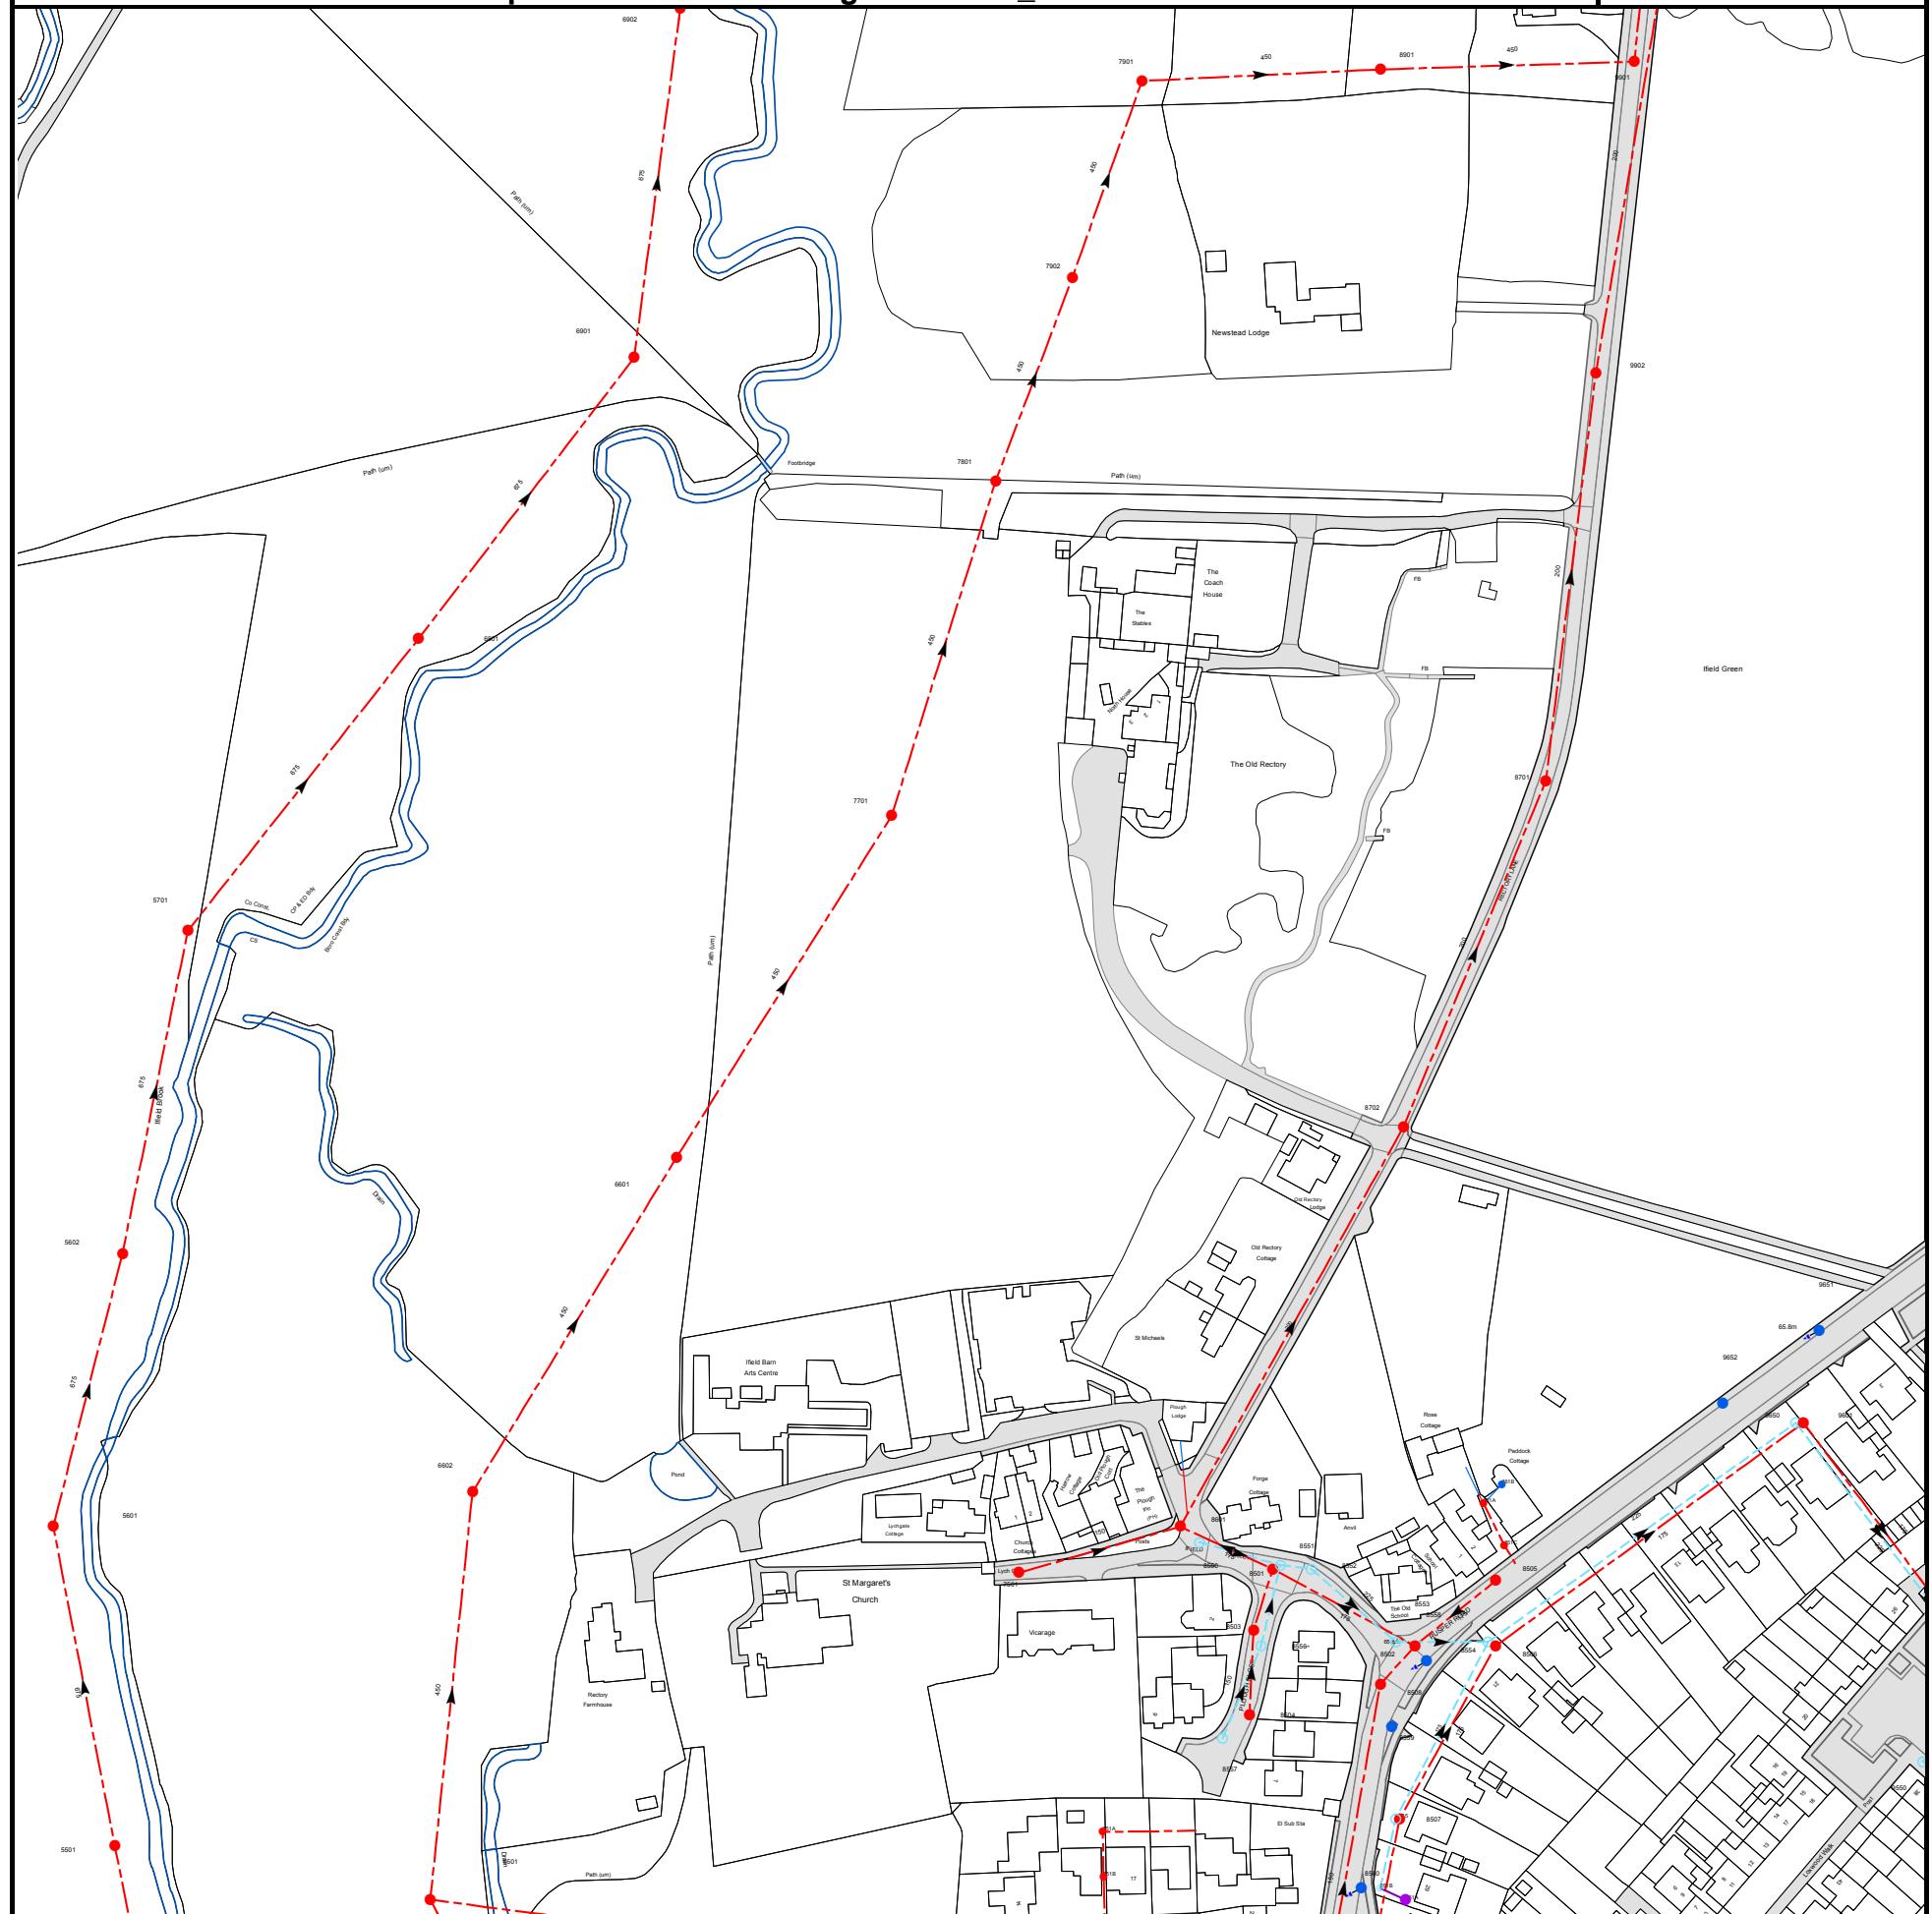


NB. Levels quoted in metres Ordnance Newlyn Datum. The value -9999.00 indicates that no survey information is available

| Manhole Reference | Manhole Cover Level | Manhole Invert Level |
|-------------------|---------------------|----------------------|
| 9650 | 65.99 | 63.98 |
| 9601 | 65.98 | 63.66 |
| 9651 | 66 | 65.15 |
| 9550 | 66.08 | 63.19 |
| 5602 | 64.1 | 60.32 |
| 6601 | 65.36 | 61.35 |
| 8702 | 65.77 | 63.75 |
| 5701 | 63.69 | 59.98 |
| 7701 | 64.9 | 61.18 |
| 8701 | n/a | n/a |
| 6801 | 63.5 | 59.7 |
| 7801 | 64.25 | 60.99 |
| 9902 | n/a | n/a |
| 6901 | 63.14 | 59.37 |
| 7902 | n/a | n/a |
| 7901 | 63.9 | 60.68 |
| 8901 | 64.13 | 60.56 |
| 9901 | 64.21 | 60.48 |
| 6902 | 63.1 | 59.09 |
| 8552 | 65.91 | 65.11 |
| 8560 | 66.38 | 65.53 |
| 851B | n/a | n/a |
| 8508 | n/a | n/a |
| 8559 | 66.06 | n/a |
| 8553 | 65.99 | 64.97 |
| 8555 | 66.38 | 65.1 |
| 8507 | 66.34 | 64.66 |
| 851A | n/a | n/a |
| 8502 | 66.06 | 64.71 |
| 8558 | 66.07 | 65.41 |
| 861A | n/a | n/a |
| 8554 | 66.19 | n/a |
| 8506 | 66.19 | 64.26 |
| 8505 | n/a | n/a |
| 861B | n/a | n/a |
| 851C | n/a | n/a |
| 9652 | n/a | n/a |
| 5601 | 64.36 | 60.49 |
| 5501 | 64.91 | 60.88 |
| 6501 | 64.18 | 62 |
| 6602 | 63.77 | 61.68 |
| 7501 | 65.95 | 64.65 |
| 751A | n/a | n/a |
| 751B | n/a | n/a |
| 8601 | 65.76 | n/a |
| 8550 | 65.81 | 65.31 |
| 8557 | 66.16 | 65.36 |
| 8504 | 66.17 | 64.89 |
| 8503 | 65.98 | 64.58 |
| 8556 | 66.04 | 65.21 |
| 8501 | 65.86 | 64.45 |
| 8551 | 65.9 | 65.03 |

The position of the apparatus shown on this plan is given without obligation and warranty, and the accuracy cannot be guaranteed. Service pipes are not shown but their presence should be anticipated. No liability of any kind whatsoever is accepted by Thames Water for any error or omission. The actual position of mains and services must be verified and established on site before any works are undertaken.

Asset Location Search Sewer Map - ALS/ALS Non Chargeable/2023_4825611

TQ2436SW

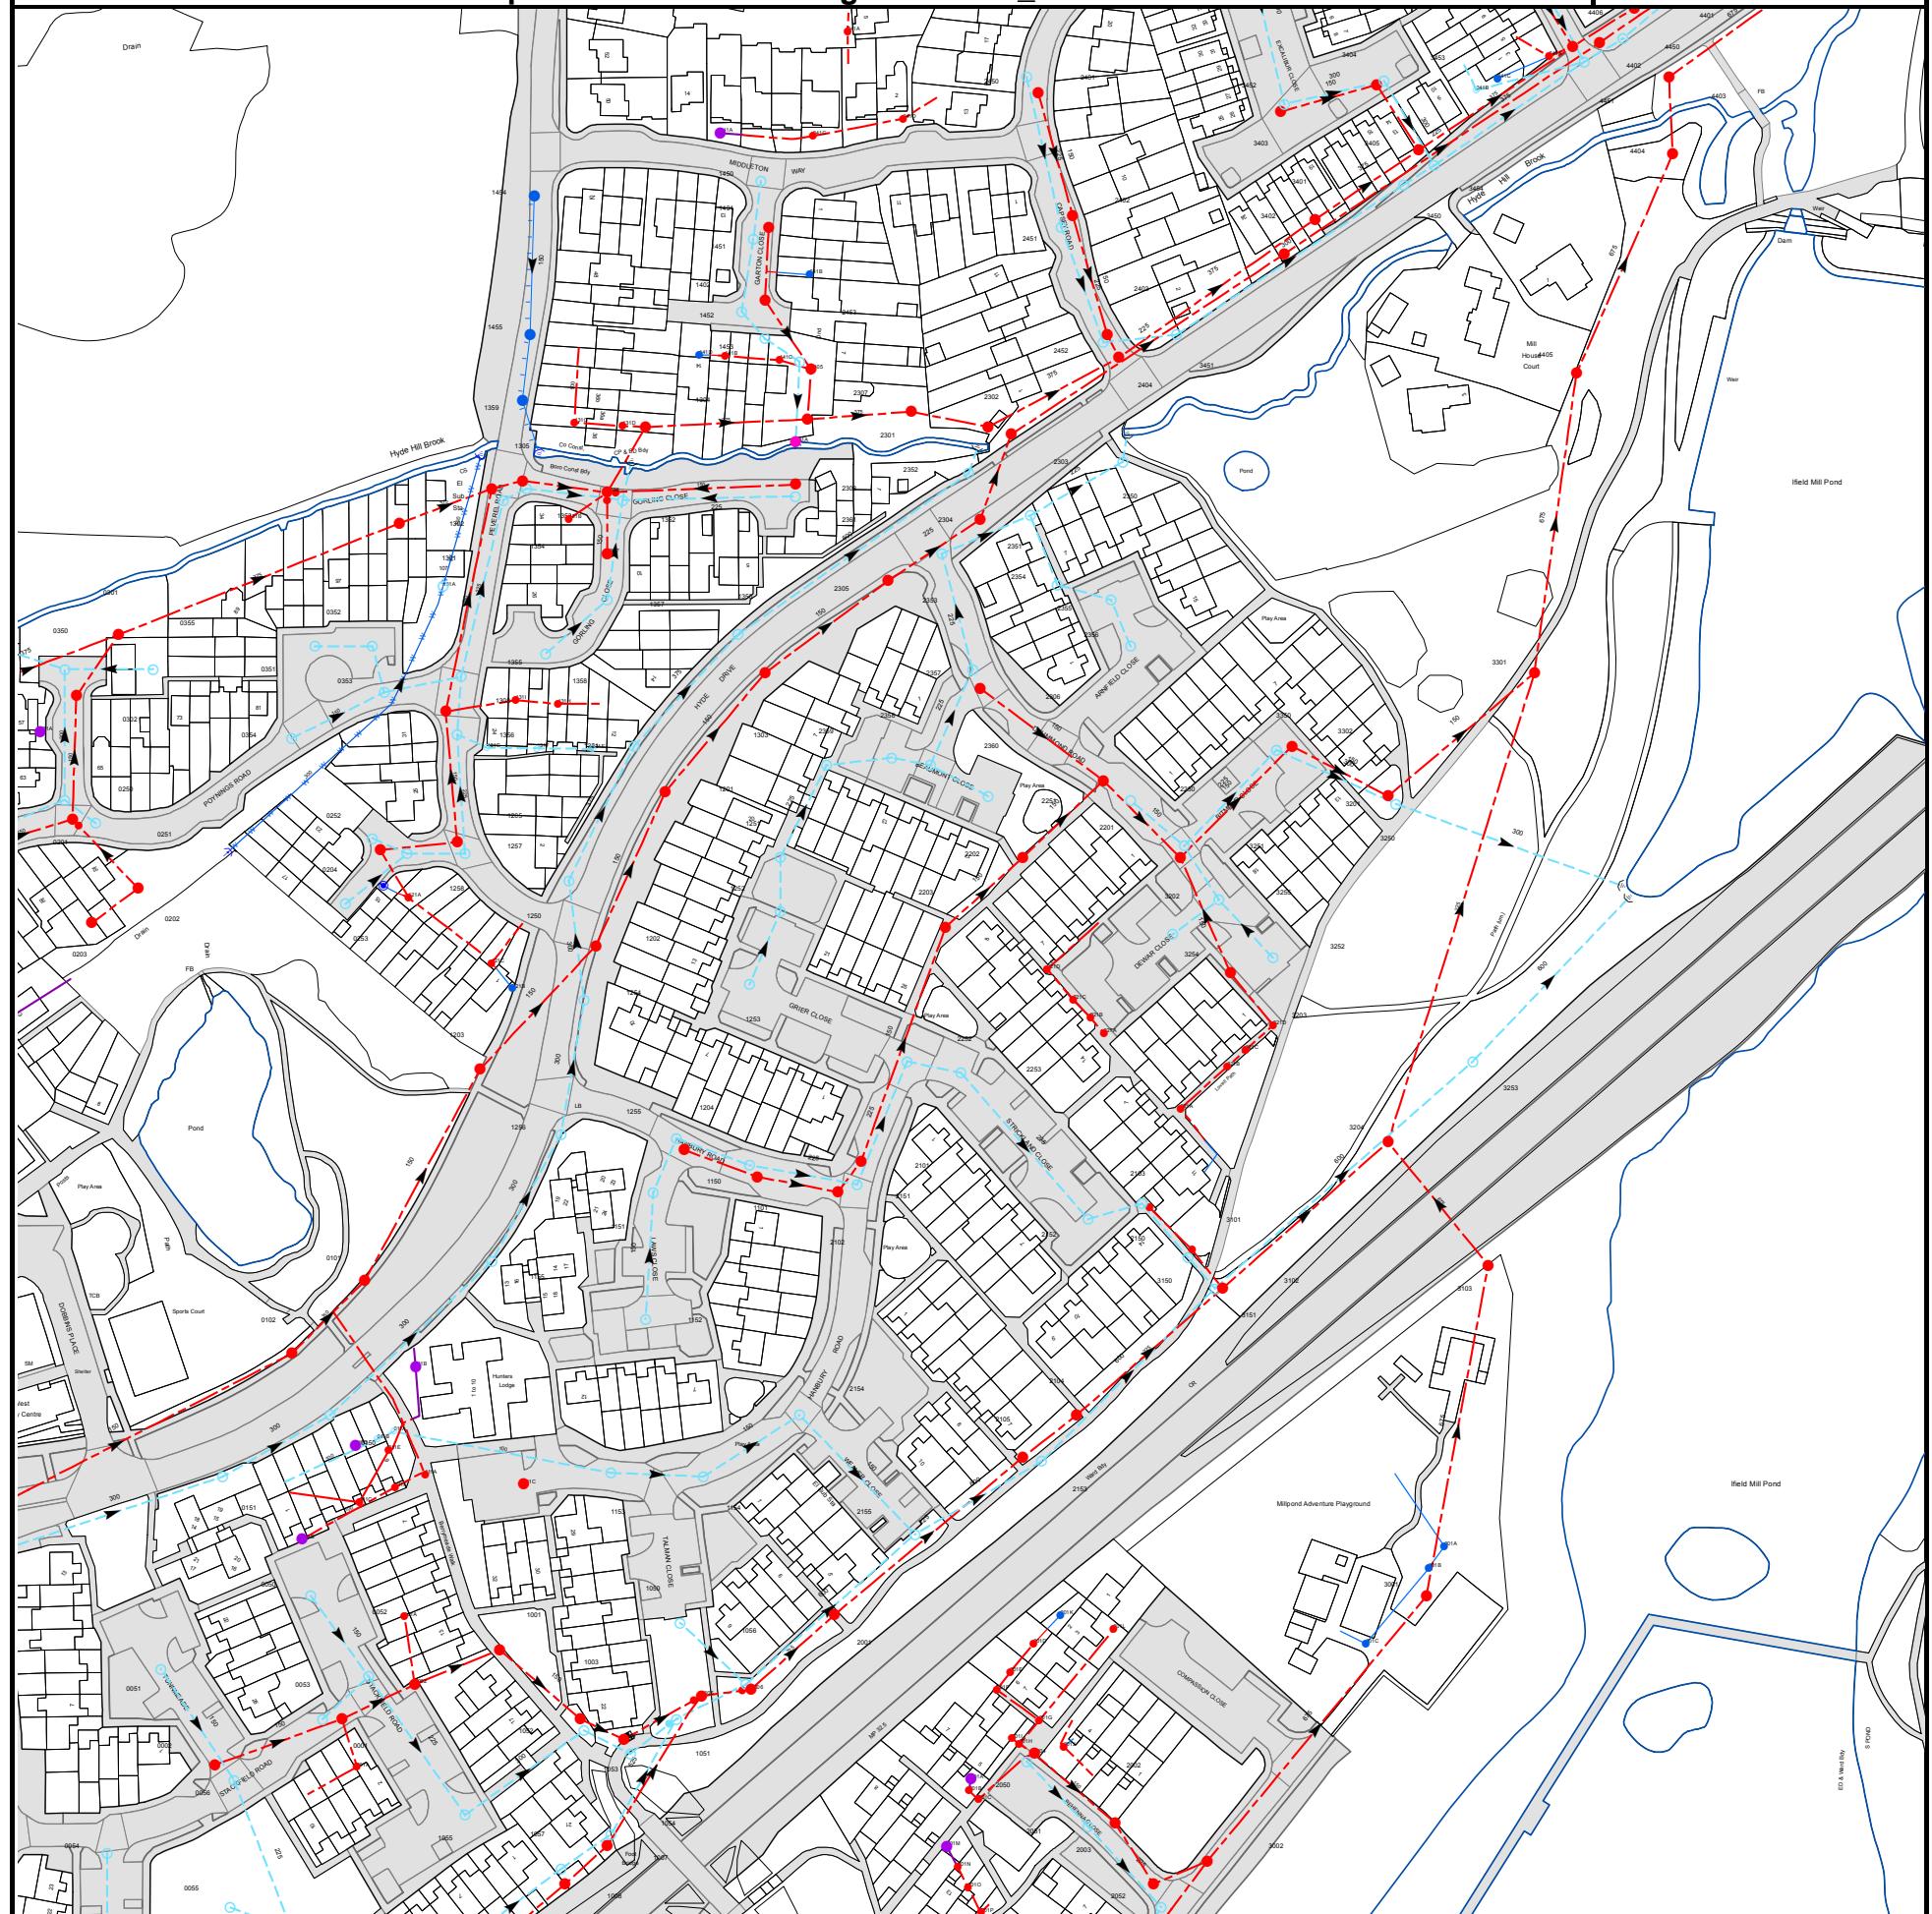

The width of the displayed area is 500m and the centre of the map is located at OS coordinates 524250,136250

The position of the apparatus shown on this plan is given without obligation and warranty, and the accuracy cannot be guaranteed. Service pipes are not shown but their presence should be anticipated. No liability of any kind whatsoever is accepted by Thames Water for any error or omission. The actual position of mains and services must be verified and established on site before any works are undertaken.

Based on the Ordnance Survey Map (2020) with the Sanction of the controller of H.M. Stationery Office. License no. 100019345 Crown Copyright Reserved.

NB. Levels quoted in metres Ordnance Newlyn Datum. The value -9999.00 indicates that no survey information is available

| Manhole Reference | Manhole Cover Level | Manhole Invert Level |
|-------------------|---------------------|----------------------|
| 3404 | 69.43 | 67.61 |
| 3453 | 69.42 | 67.18 |
| 341B | n/a | n/a |
| 341C | n/a | n/a |
| 341A | n/a | n/a |
| 4406 | 67.91 | 65.11 |
| 4451 | 67.73 | 66.37 |
| 4402 | 67.97 | 64.97 |
| 4450 | 67.88 | 66.25 |
| 4401 | 68.06 | 64.93 |
| 4403 | 67.46 | 64.12 |
| 2350 | n/a | n/a |
| 2356 | 71.61 | 70.2 |
| 2250 | 72.85 | 71.42 |
| 3254 | 73.31 | 72.06 |
| 3451 | 68.8 | 67.45 |
| 3202 | 73.07 | 70.09 |
| 3251 | 73.04 | 70.65 |
| 3255 | 72.98 | 70.98 |
| 321B | n/a | n/a |
| 3203 | 73.1 | 71.38 |
| 321C | n/a | n/a |
| 3252 | 72.72 | 71.22 |
| 321D | n/a | n/a |
| 3350 | 71.76 | 70.12 |
| 3402 | 68.57 | 65.88 |
| 3302 | 71.77 | 69.68 |
| 3401 | n/a | n/a |
| 3201 | 71.4 | 69.17 |
| 3250 | 71.47 | 69.91 |
| 3450 | 68.31 | 66.74 |
| 3405 | 69.23 | 65.48 |
| 3454 | 68.22 | 66.66 |
| 3253 | 71.64 | 69.84 |
| 3301 | 70.9 | 65.58 |
| 4405 | 70.47 | 64.77 |
| 4404 | 68.06 | 64.18 |
| 2052 | 72.14 | 71.21 |
| 2003 | 72.4 | 67.92 |
| 2104 | 75.13 | 72.43 |
| 2152 | 74.93 | 73.01 |
| 2051 | 73.11 | 72.01 |
| 201L | n/a | n/a |
| 2002 | 73.21 | 71.5 |
| 2150 | 74.55 | 72.8 |
| 2103 | 74.49 | 72.36 |
| 321A | n/a | n/a |
| 3150 | 74.17 | 72.38 |
| 3101 | 74.2 | 71.84 |
| 3002 | n/a | n/a |
| 3151 | 73.93 | 71.93 |
| 3102 | 73.86 | 71.26 |
| 301C | n/a | n/a |
| 3204 | 71.87 | n/a |
| 3001 | 72.13 | 66.75 |
| 301B | n/a | n/a |
| 301A | n/a | n/a |
| 3103 | n/a | n/a |
| 201A | n/a | n/a |
| 2050 | 73.96 | 72.79 |
| 2004 | 74.17 | 72.28 |
| 201J | n/a | n/a |
| 201H | n/a | n/a |
| 201I | n/a | n/a |
| 201G | n/a | n/a |
| 1005 | 78.32 | 74.1 |
| 1006 | 77.77 | 74.03 |
| 201F | n/a | n/a |
| 1056 | 77.88 | 74.72 |
| 201E | n/a | n/a |
| 201D | n/a | n/a |
| 1050 | 79.19 | 77.66 |
| 2001 | 77.38 | 73.92 |
| 201K | n/a | n/a |
| 2155 | 76.76 | 74.52 |
| 1154 | 79.66 | 77.97 |
| 2153 | n/a | n/a |
| 2105 | 75.66 | 72.86 |
| 2154 | 78.54 | 76.96 |
| 2102 | 77.18 | 75.31 |
| 2151 | 77.13 | 75.81 |
| 1101 | 77.86 | 76.11 |
| 1150 | 77.91 | 76.71 |
| 2101 | 76.83 | 75.03 |
| 1204 | 78.51 | 76.83 |
| 201P | n/a | n/a |
| 201O | n/a | n/a |
| 201N | n/a | n/a |
| 201M | n/a | n/a |
| 201C | n/a | n/a |

| Manhole Reference | Manhole Cover Level | Manhole Invert Level |
|-------------------|---------------------|----------------------|
| 201B | n/a | n/a |
| 1205 | 74.85 | 72.61 |
| 1356 | 73.22 | 71.9 |
| 1355 | 72.81 | 71.02 |
| 1257 | 74.95 | 73.27 |
| 1203 | 78.74 | 74.94 |
| 131G | n/a | n/a |
| 121C | n/a | n/a |
| 121B | n/a | n/a |
| 131I | n/a | n/a |
| 131F | n/a | n/a |
| 131H | n/a | n/a |
| 1250 | 75.64 | 73.58 |
| 1254 | 77.4 | 75.19 |
| 131E | n/a | n/a |
| 1202 | 76.38 | 72.91 |
| 1351 | 73.37 | n/a |
| 001A | n/a | n/a |
| 1053 | 79.45 | 77.65 |
| 1004 | 79.36 | 77.06 |
| 1052 | 79.61 | 78.32 |
| 1051 | 78.45 | 74.76 |
| 0001 | 82.36 | 80.46 |
| 1003 | n/a | n/a |
| 0053 | 82.37 | 80.43 |
| 1002 | 81.94 | 80.22 |
| 0052 | 82.22 | 80.01 |
| 1001 | 81.13 | 79.83 |
| 101A | n/a | n/a |
| 0050 | 83.26 | 81.62 |
| 001B | n/a | n/a |
| 011C | n/a | n/a |
| 011F | n/a | n/a |
| 111C | n/a | n/a |
| 111A | n/a | n/a |
| 1153 | 80.54 | 79.08 |
| 011E | n/a | n/a |
| 011D | n/a | n/a |
| 011B | n/a | n/a |
| 011A | n/a | n/a |
| 0150 | 82.98 | 81.08 |
| 111B | n/a | n/a |
| 0102 | 82.35 | 79.3 |
| 1152 | 79.85 | 78.56 |
| 0101 | 81.6 | 77.91 |
| 1155 | 80.96 | 78.79 |
| 1151 | 78.99 | 77.74 |
| 1255 | 78.55 | 77.3 |
| 1256 | 79.41 | 76.88 |
| 031A | n/a | n/a |
| 0350 | 72.54 | 71.2 |
| 0250 | 74.59 | 72.77 |
| 0201 | 74.68 | 72.31 |
| 0302 | 72.93 | 70.9 |
| 0203 | n/a | n/a |
| 0251 | 74.64 | n/a |
| 0202 | n/a | n/a |
| 0354 | 73.99 | 72.53 |
| 0253 | 75.97 | 74.44 |
| 0252 | 75.37 | 73.87 |
| 0204 | 75.42 | 73.42 |
| 0353 | 73.08 | 71.45 |
| 1258 | 75.26 | 73.69 |
| 121A | n/a | n/a |
| 1308 | 73.08 | 71.11 |
| 0054 | 83.61 | 81.97 |
| 0055 | 83.16 | 82.41 |
| 0056 | 82.88 | 81.69 |
| 1055 | 79.99 | 78.51 |
| 1057 | 78.77 | 74.87 |
| 1008 | 78.57 | 74.31 |
| 1007 | 78.44 | 74.19 |
| 1054 | n/a | n/a |
| 0051 | 84.23 | 83.15 |
| 0002 | 83.07 | 81.8 |
| 0151 | 83.97 | 82.03 |
| 2361 | 70.38 | 69.28 |
| 2308 | 70.34 | 68.77 |
| 2352 | 70.14 | 68.51 |
| 231A | n/a | n/a |
| 2303 | 69.75 | 66.66 |
| 2302 | 69.76 | 66.8 |
| 2307 | 70.4 | n/a |
| 2301 | n/a | n/a |
| 2405 | 70.35 | 68.11 |
| 2453 | 69.9 | 68.08 |
| 141C | n/a | n/a |
| 2404 | 69.22 | 66.35 |
| 141B | n/a | n/a |
| 141D | n/a | n/a |
| 2452 | 69.29 | 67.61 |
| 1453 | 70.9 | 69.12 |
| 2403 | 69.35 | 66.99 |

| Manhole Reference | Manhole Cover Level | Manhole Invert Level |
|-------------------|---------------------|----------------------|
| 1452 | 71.34 | 69.7 |
| 1402 | 71.63 | 69.56 |
| 241B | n/a | n/a |
| 1451 | 72.52 | 70.67 |
| 1401 | 72.75 | 70.54 |
| 2451 | 70.83 | 69.17 |
| 2402 | 70.9 | 68.87 |
| 1450 | 73.15 | 71.04 |
| 241C | n/a | n/a |
| 141A | n/a | n/a |
| 2253 | 75.78 | 74.27 |
| 2252 | 75.88 | 74.51 |
| 221A | n/a | n/a |
| 221B | n/a | n/a |
| 221C | n/a | n/a |
| 1253 | 75.98 | 74.74 |
| 221D | n/a | n/a |
| 2203 | 74.61 | 72.24 |
| 1252 | 75.13 | 73.76 |
| 2202 | 73.52 | 71.67 |
| 1251 | 74.06 | 72.86 |
| 2251 | 73.07 | 71.14 |
| 1201 | 73.58 | 71.3 |
| 2201 | 72.75 | 70.44 |
| 2360 | 72.96 | 70.69 |
| 2359 | 73.22 | 71.54 |
| 2358 | 72.91 | 71.04 |
| 2306 | 72.09 | 70.87 |
| 1303 | 72 | 70.4 |
| 2357 | 71.95 | 70.01 |
| 1350 | 72.01 | 69.95 |
| 2355 | 71.32 | 69.87 |
| 2354 | 71.3 | 69.46 |
| 2305 | 70.8 | 69.46 |
| 2353 | 70.42 | 69.08 |
| 2304 | 70.29 | 66.96 |
| 2351 | n/a | n/a |
| 241D | n/a | n/a |
| 3403 | 70 | 68.16 |
| 3452 | 69.99 | 67.43 |
| 2401 | 72.44 | 70.21 |
| 2450 | 72.78 | 71.05 |
| 241A | n/a | n/a |
| 0355 | 72.86 | 71.55 |
| 1358 | 72.01 | n/a |
| 0351 | 73.15 | 72.01 |
| 0352 | 72.89 | 71.83 |
| 0301 | 72.33 | 70.38 |
| 1357 | 71.11 | n/a |
| 131A | n/a | n/a |
| 1307 | 70.78 | 69.56 |
| 1301 | n/a | n/a |
| 131B | n/a | n/a |
| 1352 | 70.87 | 68.77 |
| 1354 | 71.34 | 69.46 |
| 1306 | 70.89 | 67.36 |
| 1302 | 71.32 | 68.66 |
| 1353 | 71.15 | 69.38 |
| 1305 | 71.19 | 68.23 |
| 1304 | 70.36 | 67.23 |
| 131D | n/a | n/a |
| 131C | n/a | n/a |
| 1359 | 71.32 | 69.66 |
| 1455 | 71.92 | 70.51 |
| 1454 | 73.96 | 72.37 |

The position of the apparatus shown on this plan is given without obligation and warranty, and the accuracy cannot be guaranteed. Service pipes are not shown but their presence should be anticipated. No liability of any kind whatsoever is accepted by Thames Water for any error or omission. The actual position of mains and services must be verified and established on site before any works are undertaken.

Asset Location Search Sewer Map - ALS/ALS Non Chargeable/2023_4825611

TQ2336NE



The width of the displayed area is 500m and the centre of the map is located at OS coordinates 523750,136750


The position of the apparatus shown on this plan is given without obligation and warranty, and the accuracy cannot be guaranteed. Service pipes are not shown but their presence should be anticipated. No liability of any kind whatsoever is accepted by Thames Water for any error or omission. The actual position of mains and services must be verified and established on site before any works are undertaken.

Based on the Ordnance Survey Map (2020) with the Sanction of the controller of H.M. Stationery Office. License no. 100019345 Crown Copyright Reserved.

NB. Levels quoted in metres Ordnance Newlyn Datum. The value -9999.00 indicates that no survey information is available

| Manhole Reference | Manhole Cover Level | Manhole Invert Level |
|-------------------|---------------------|----------------------|
| 9901 | n/a | n/a |

The position of the apparatus shown on this plan is given without obligation and warranty, and the accuracy cannot be guaranteed. Service pipes are not shown but their presence should be anticipated. No liability of any kind whatsoever is accepted by Thames Water for any error or omission. The actual position of mains and services must be verified and established on site before any works are undertaken.

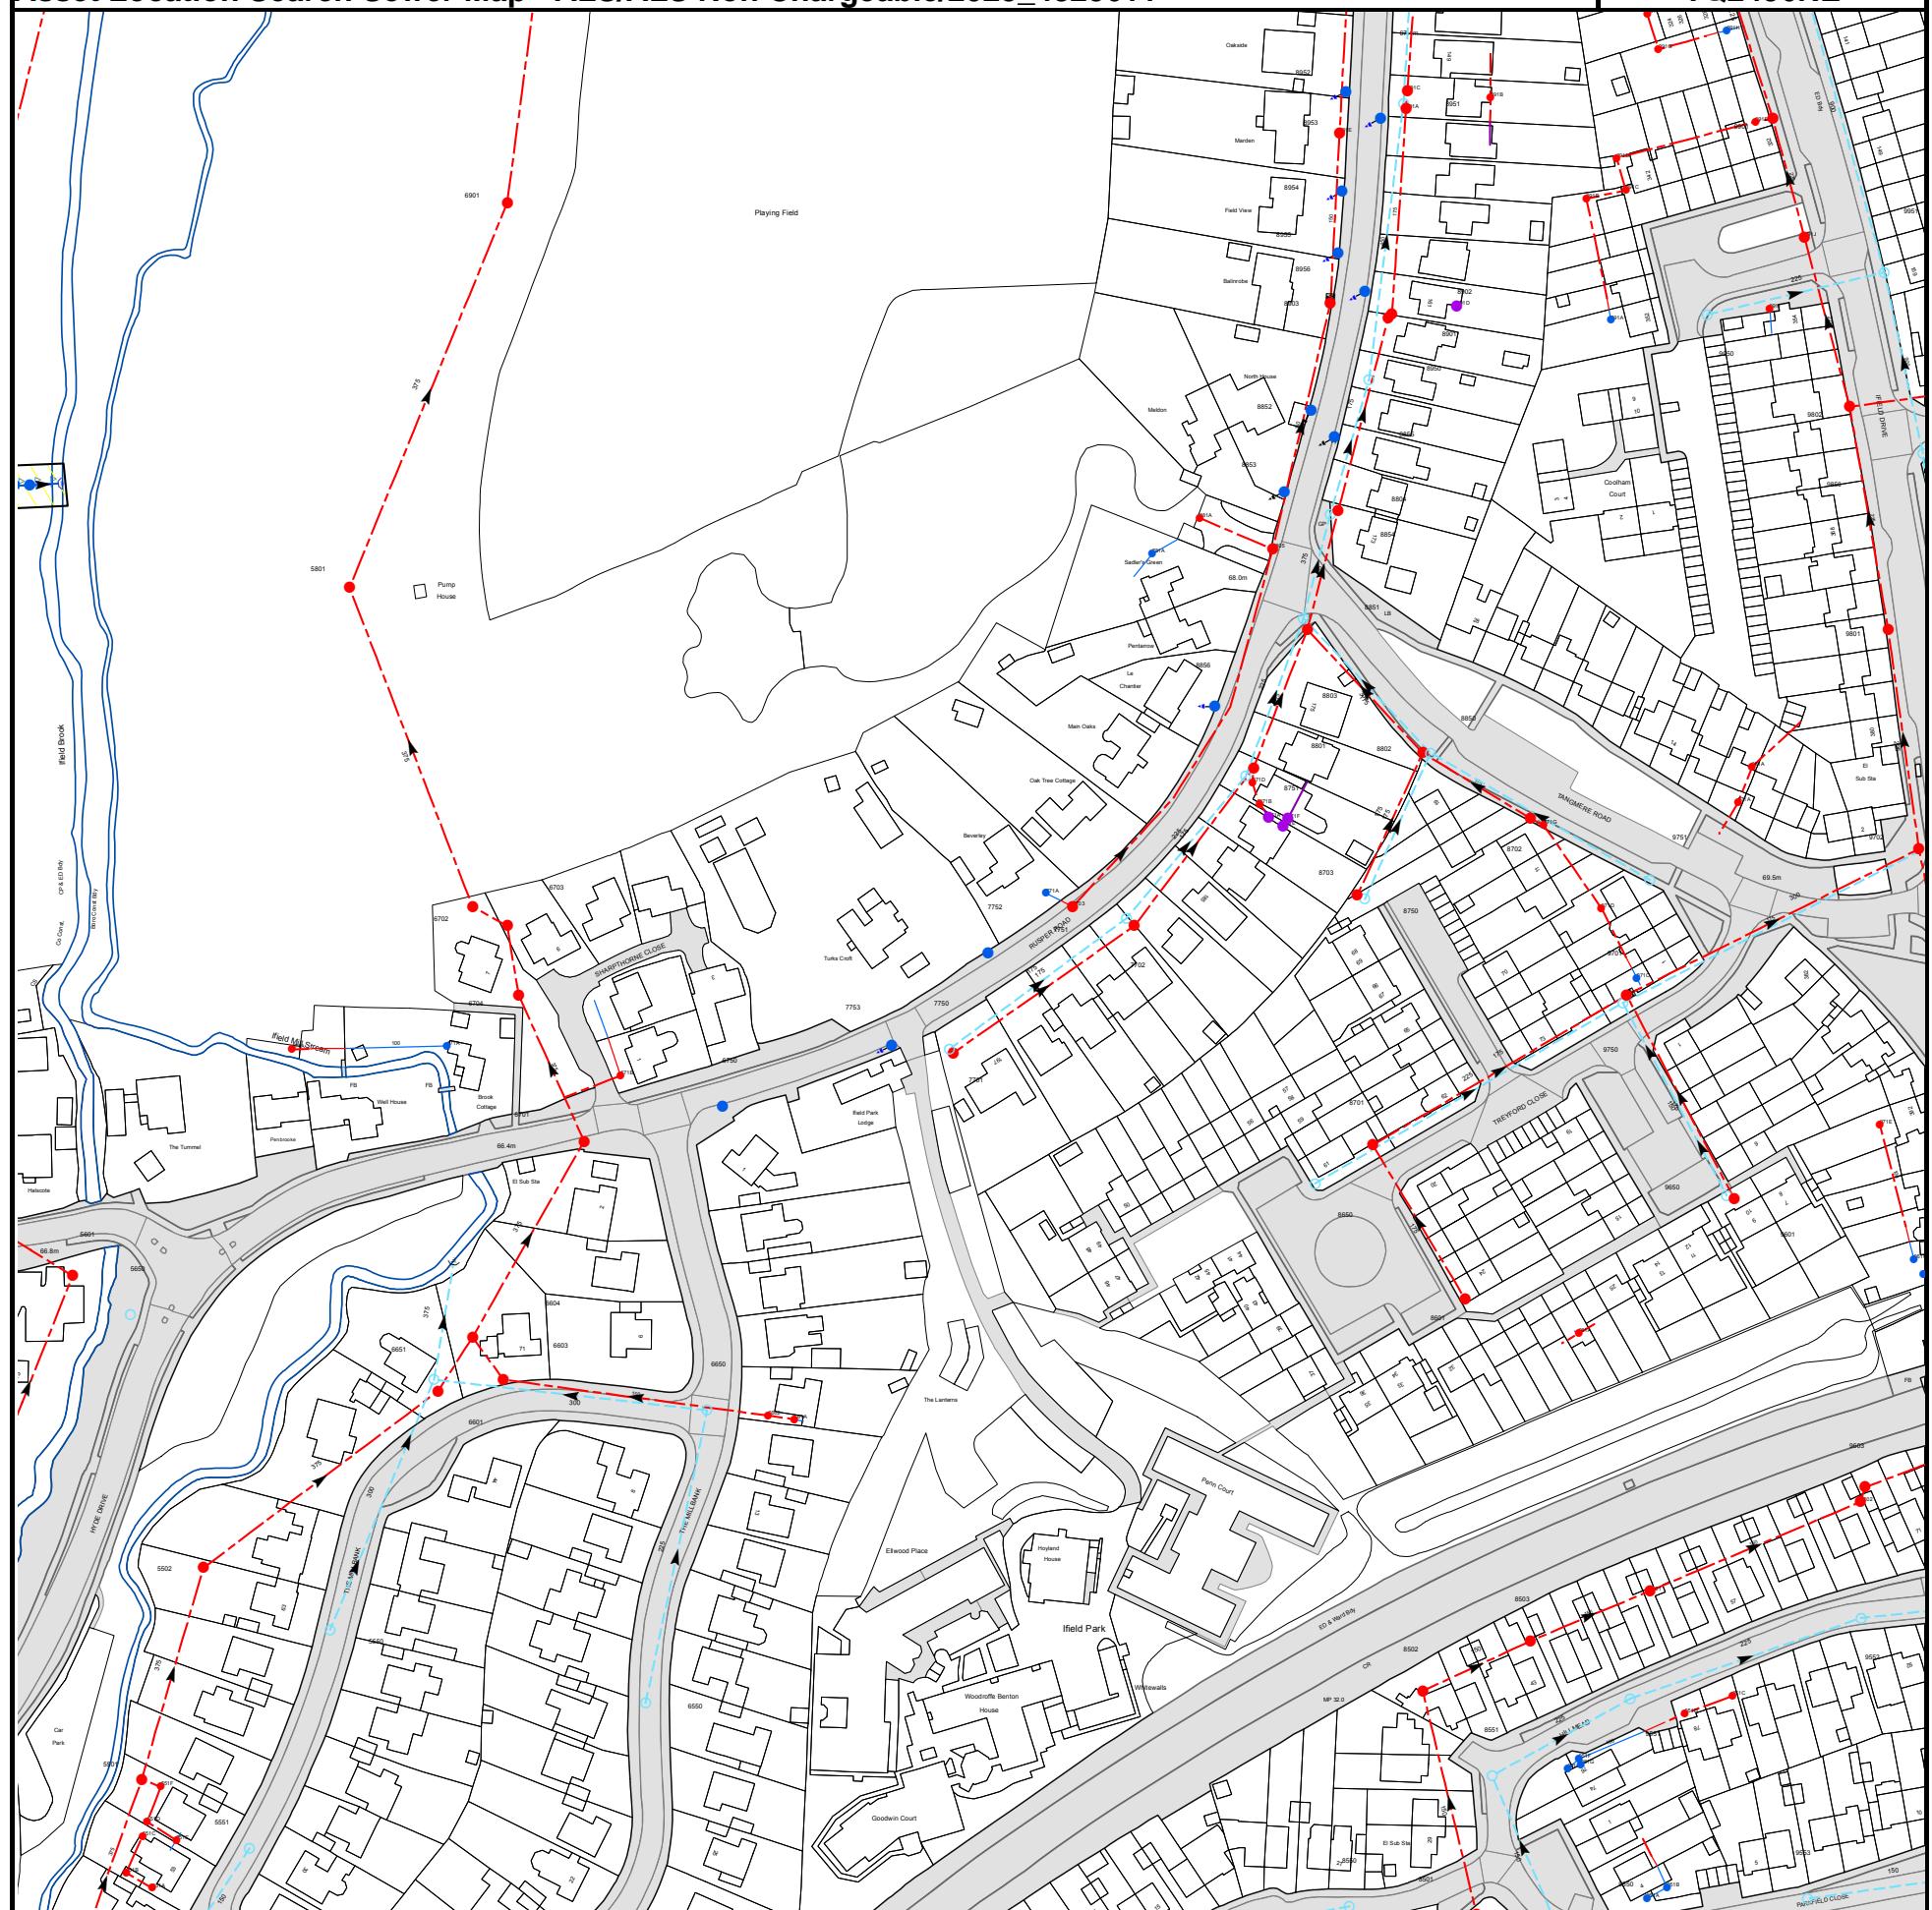

The width of the displayed area is 500m and the centre of the map is located at OS coordinates 524750, 136750

The position of the apparatus shown on this plan is given without obligation and warranty, and the accuracy cannot be guaranteed. Service pipes are not shown but their presence should be anticipated. No liability of any kind whatsoever is accepted by Thames Water for any error or omission. The actual position of mains and services must be verified and established on site before any works are undertaken.


Based on the Ordnance Survey Map (2020) with the Sanction of the controller of H.M. Stationery Office, License no. 100019345 Crown Copyright Reserved.

NB. Levels quoted in metres Ordnance Newlyn Datum. The value -9999.00 indicates that no survey information is available

| Manhole Reference | Manhole Cover Level | Manhole Invert Level |
|-------------------|---------------------|----------------------|
| 991F | n/a | n/a |
| 8955 | 67.47 | 66.81 |
| 8804 | 67.88 | 65.64 |
| 891E | n/a | n/a |
| 8954 | 67.36 | 66.86 |
| 8952 | 67.18 | 66.57 |
| 8956 | 67.45 | 66.78 |
| 8950 | n/a | n/a |
| 8953 | 67.14 | 66.61 |
| 8901 | n/a | n/a |
| 8902 | 67.08 | 64.89 |
| 8951 | 67.14 | 65.09 |
| 891A | n/a | n/a |
| 891C | n/a | n/a |
| 8802 | 67.99 | 66.09 |
| 8850 | 68.02 | 66.44 |
| 891D | n/a | n/a |
| 891B | n/a | n/a |
| 8702 | 68.28 | 66.48 |
| 871G | n/a | n/a |
| 991B | n/a | n/a |
| 991A | n/a | n/a |
| 991D | n/a | n/a |
| 991C | n/a | n/a |
| 991G | n/a | n/a |
| 9950 | 67.66 | 66.19 |
| 991H | n/a | n/a |
| 971A | n/a | n/a |
| 981A | n/a | n/a |
| 991E | n/a | n/a |
| 991I | n/a | n/a |
| 9901 | 67.45 | 65.83 |
| 991J | n/a | n/a |
| 9802 | 68.19 | 66.19 |
| 9951 | 68.11 | 65.21 |
| 9801 | 68.81 | 66.41 |
| 9702 | 69.72 | 66.62 |
| 9850 | 68.44 | 65.72 |
| 9602 | 76.78 | 74.23 |
| 9603 | n/a | n/a |
| 971E | n/a | n/a |
| 961C | n/a | n/a |
| 961B | n/a | n/a |
| 951C | n/a | n/a |
| 8502 | n/a | n/a |
| 8503 | 76.22 | 74.59 |
| 9501 | 76.38 | 74.39 |
| 961A | n/a | n/a |
| 8601 | 70.99 | 69.16 |
| 9601 | 71.18 | 69.42 |
| 9650 | 71.15 | 68.97 |
| 8650 | 69.69 | 68.11 |
| 8701 | 69.54 | 67.68 |
| 9750 | 69.41 | 67.5 |
| 9701 | 69.38 | 67.2 |
| 971C | n/a | n/a |
| 971D | n/a | n/a |
| 8750 | n/a | n/a |
| 8703 | n/a | n/a |
| 9751 | 69.07 | 67.17 |
| 8550 | 78.71 | 77.11 |
| 8501 | 79.6 | 77.45 |
| 8551 | 77.61 | 75.44 |
| 9550 | 79.35 | 77.75 |
| 951E | n/a | n/a |
| 951F | n/a | n/a |
| 951G | n/a | n/a |
| 9551 | 76.65 | 75.01 |
| 951A | n/a | n/a |
| 951B | n/a | n/a |
| 951D | n/a | n/a |
| 9553 | 79.64 | 78.19 |
| 9552 | 76.74 | 74.74 |
| n/a | n/a | n/a |
| 5801 | n/a | n/a |
| 6901 | n/a | n/a |
| 781A | n/a | n/a |
| 881A | n/a | n/a |
| 8856 | 68.4 | 67.66 |
| 8751 | 68.24 | 66.39 |
| 871D | n/a | n/a |
| 8801 | 68.23 | 66.09 |
| 871B | n/a | n/a |
| 871A | n/a | n/a |
| 8805 | 68.01 | 66.81 |
| 871E | n/a | n/a |
| 8853 | 68.07 | 67.1 |
| 871F | n/a | n/a |
| 8851 | 68.1 | 66.07 |
| 8803 | 68.05 | n/a |

| Manhole Reference | Manhole Cover Level | Manhole Invert Level |
|-------------------|---------------------|----------------------|
| 8852 | 67.81 | 66.81 |
| 8903 | 67.45 | 66.68 |
| 8854 | 67.89 | 65.81 |
| 8855 | 67.82 | 67.09 |
| 5650 | n/a | n/a |
| 5601 | 66.96 | 63.85 |
| 5502 | n/a | n/a |
| 5551 | 66.91 | 66.13 |
| 5550 | 66.58 | 65.75 |
| 6651 | 66.88 | 65.57 |
| 6601 | 66.89 | 64.29 |
| 671A | n/a | n/a |
| 6604 | 67.06 | 64.23 |
| 6702 | 66.68 | 64.34 |
| 6603 | 67.03 | 66.13 |
| 6703 | 70.07 | 66.39 |
| 6704 | 67.01 | 63.72 |
| 6701 | 66.9 | 64.04 |
| 671B | n/a | n/a |
| 6550 | 69.79 | 68.19 |
| 6650 | 67.88 | 66.5 |
| 6750 | 68.03 | n/a |
| 6602 | 68.36 | 67.46 |
| 761A | n/a | n/a |
| 7753 | 68.28 | 67.29 |
| 7750 | 68.83 | 67.03 |
| 7701 | 68.83 | 66.83 |
| 7752 | 68.52 | 67.8 |
| 771A | n/a | n/a |
| 7703 | n/a | n/a |
| 7751 | 68.81 | 66.86 |
| 7702 | 68.59 | 66.37 |
| 551B | n/a | n/a |
| 5501 | 67.25 | 64.87 |
| 551C | n/a | n/a |
| 551D | n/a | n/a |
| 551A | n/a | n/a |
| 551F | n/a | n/a |
| 551E | n/a | n/a |

The position of the apparatus shown on this plan is given without obligation and warranty, and the accuracy cannot be guaranteed. Service pipes are not shown but their presence should be anticipated. No liability of any kind whatsoever is accepted by Thames Water for any error or omission. The actual position of mains and services must be verified and established on site before any works are undertaken.

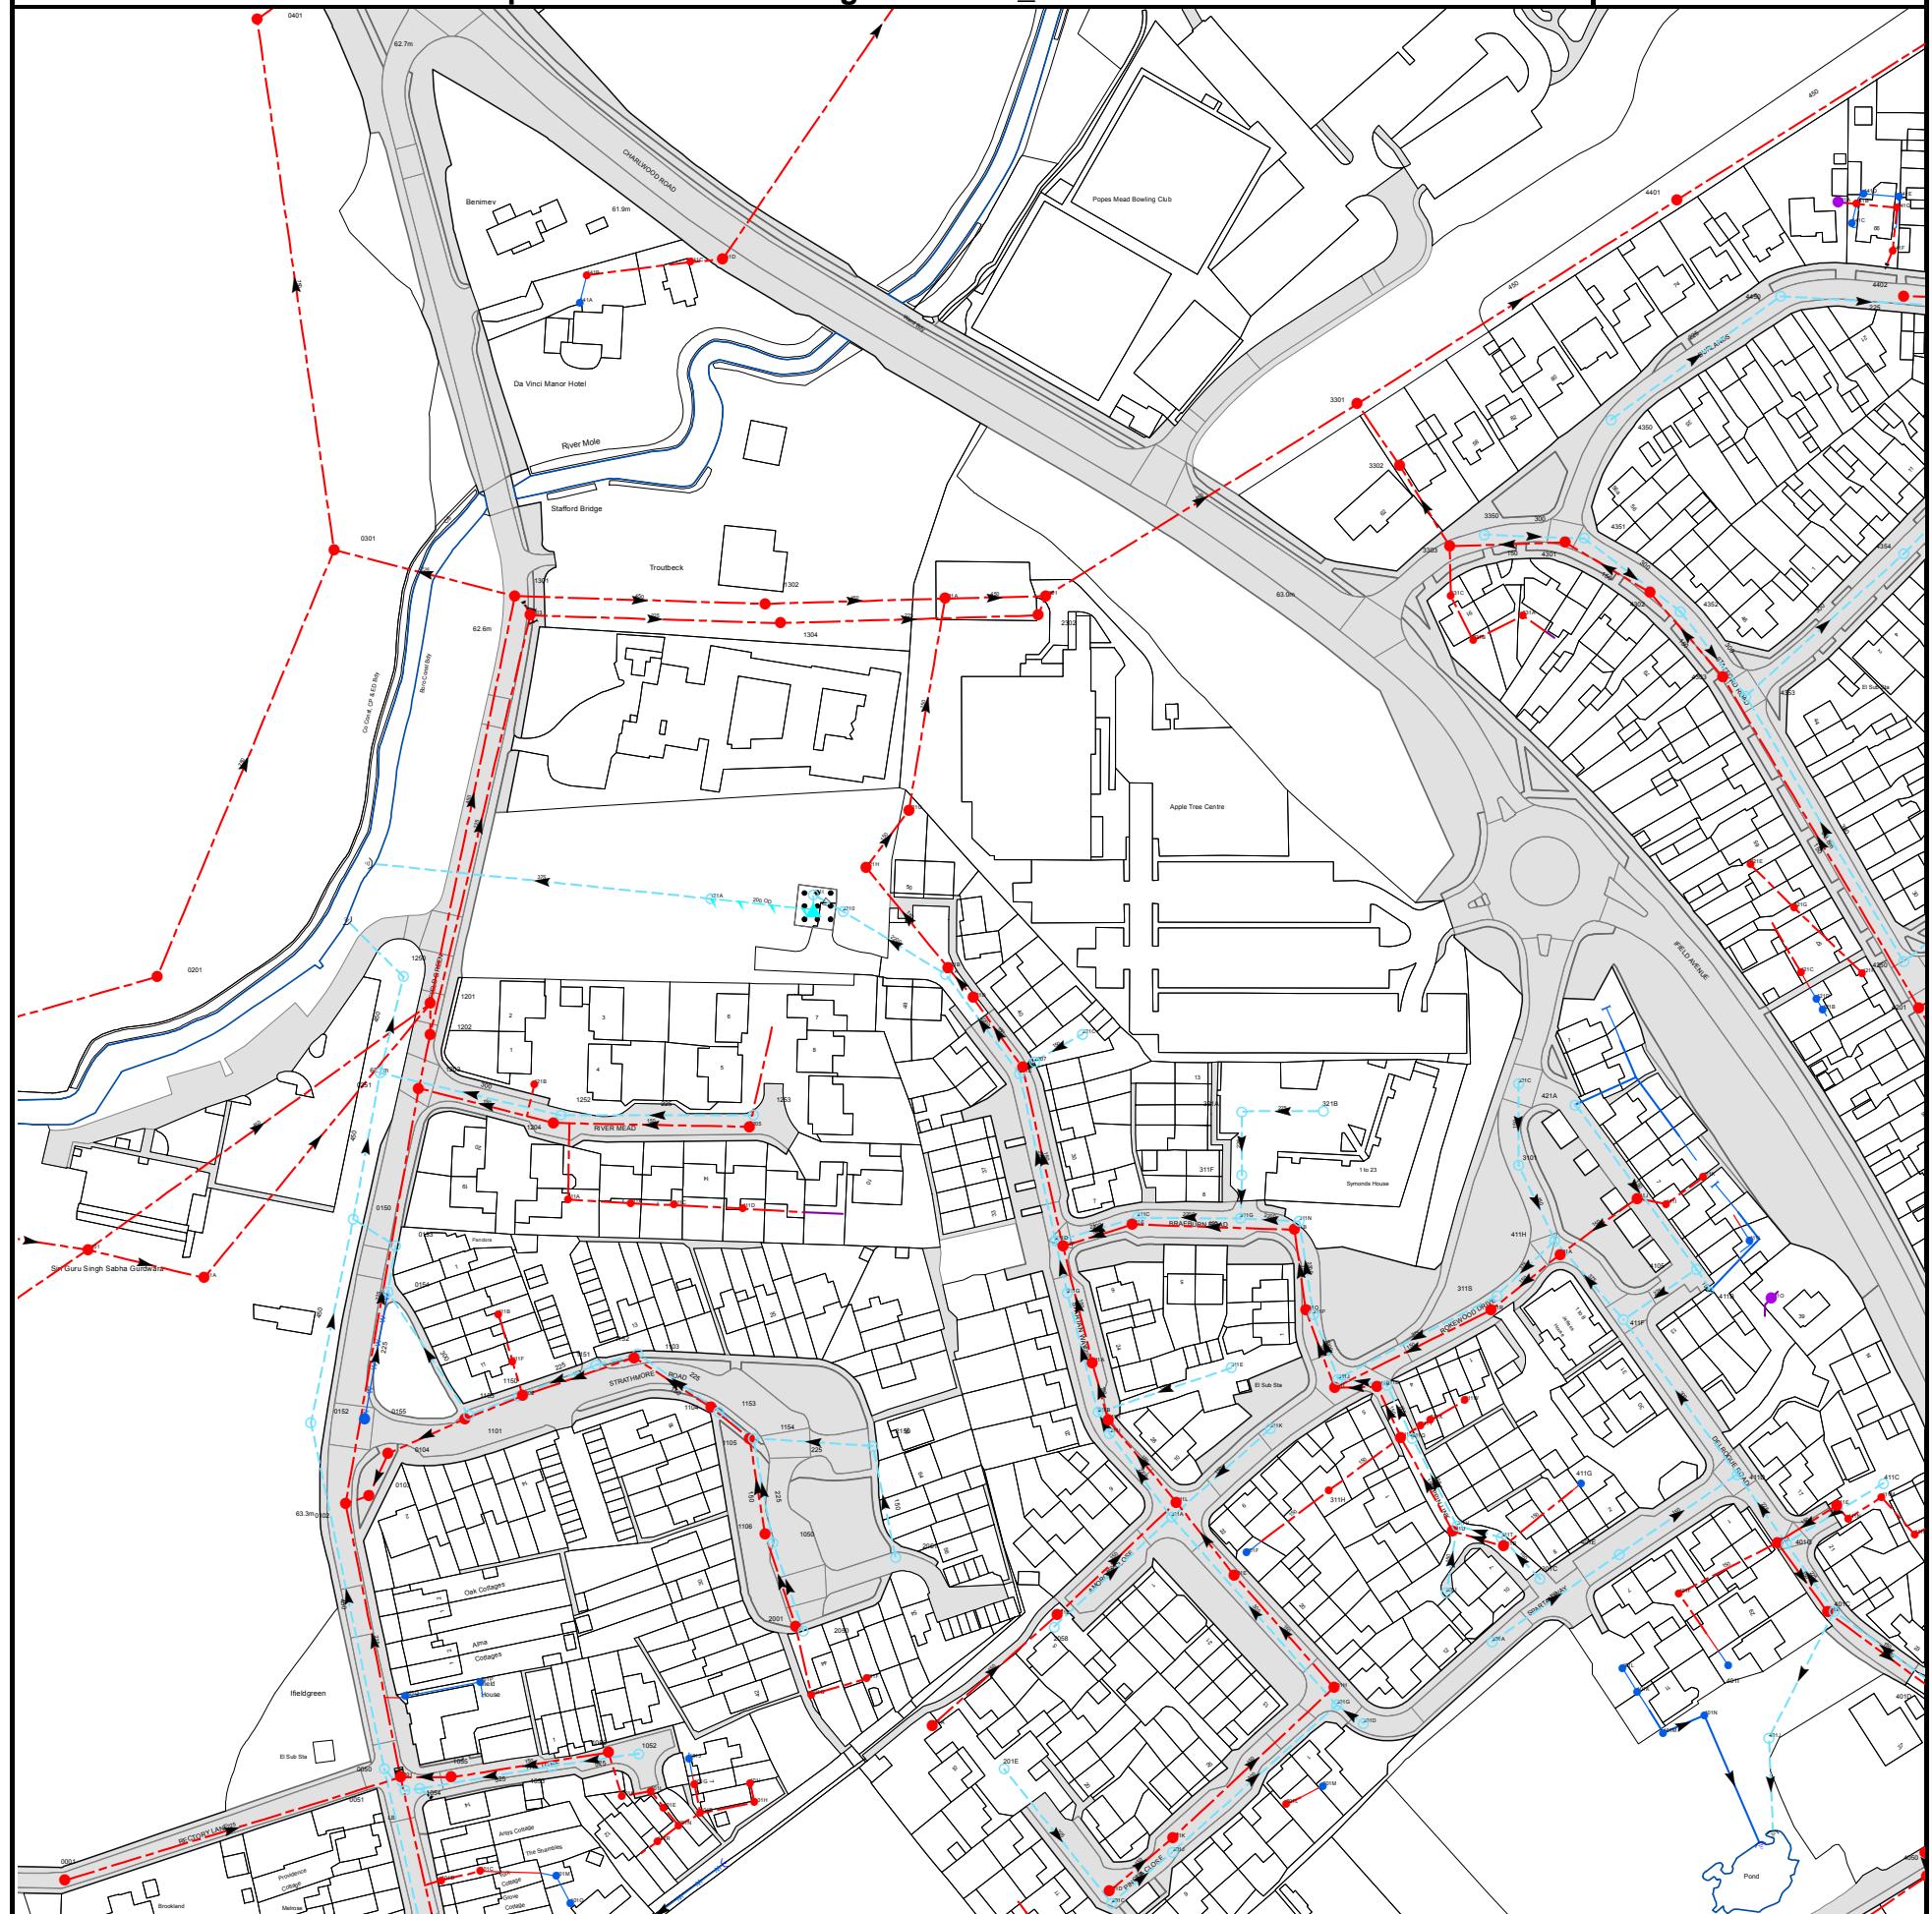

NB. Levels quoted in metres Ordnance Newlyn Datum. The value -9999.00 indicates that no survey information is available

| Manhole Reference | Manhole Cover Level | Manhole Invert Level |
|-------------------|---------------------|----------------------|
| 4450 | 62.78 | 61.38 |
| 441F | n/a | n/a |
| 441C | n/a | n/a |
| 441G | n/a | n/a |
| 441B | n/a | n/a |
| 441A | n/a | n/a |
| 4401 | n/a | n/a |
| 441E | n/a | n/a |
| 441D | n/a | n/a |
| 331A | n/a | n/a |
| 4352 | 63.28 | 61.49 |
| 331C | n/a | n/a |
| 4302 | 63.2 | 60.2 |
| 4354 | 63.42 | 61.17 |
| 3303 | 62.78 | 59.85 |
| 4301 | 62.94 | 60.09 |
| 4351 | 62.96 | 61.65 |
| 3350 | 62.8 | 61.75 |
| 3302 | 62.78 | 59.7 |
| 4350 | 62.67 | 61.43 |
| 4402 | 62.97 | 60.5 |
| 411I | 63.62 | 62.5 |
| 4105 | 63.83 | 61.71 |
| 411K | 63.57 | 62.65 |
| 411B | 63.35 | 62 |
| 4303 | 63.48 | 60.45 |
| 4353 | 63.53 | 61.33 |
| 411L | n/a | n/a |
| 421E | n/a | n/a |
| 411O | n/a | n/a |
| 421G | n/a | n/a |
| 421C | n/a | n/a |
| 421D | n/a | n/a |
| 421B | n/a | n/a |
| 421F | n/a | n/a |
| 4250 | 63.46 | 61.65 |
| 4201 | 63.38 | 61.2 |
| 221A | 62.93 | 58.53 |
| 221B | 62.93 | 60.47 |
| 221D | 63.02 | 60.55 |
| 221E | 63.12 | 58.6 |
| 221F | 63.09 | 60.7 |
| 2207 | 63.35 | 61.91 |
| 211D | 63.7 | 58.69 |
| 211F | 63.71 | 61.03 |
| 211G | 63.7 | 58.71 |
| 221C | 63.39 | 62.04 |
| 211E | 63.74 | 61.17 |
| 211C | 63.76 | 58.74 |
| 311G | 63.76 | 58.77 |
| 311F | 63.61 | 61.96 |
| 321A | 63.48 | 62.04 |
| 311B | 63.56 | 61.47 |
| 311N | 63.66 | 58.82 |
| 321B | 63.59 | 62.25 |
| 331B | n/a | n/a |
| 311R | 63.6 | 62.14 |
| 311S | 63.61 | 60.89 |
| 3101 | 63.38 | 61.56 |
| 321C | 63.43 | 62 |
| 411H | 63.41 | 60.97 |
| 411A | 63.42 | 62.33 |
| 421A | 63.64 | 62.28 |
| 411J | 63.64 | 62.39 |
| 311O | 63.53 | 61.63 |
| 311P | 63.53 | 61.64 |
| 301M | n/a | n/a |
| 311H | 63.94 | 62.62 |
| 301H | 64.49 | 62.36 |
| 311I | 63.86 | 61.76 |
| 301G | 64.48 | 62.42 |
| 311J | 63.87 | 58.92 |
| 301D | 64.31 | 62.6 |
| 311C | 63.9 | 61.86 |
| 311D | 63.91 | 61.41 |
| 311M | 63.73 | 61.95 |
| 311Q | 63.73 | 61.5 |
| 311Y | n/a | n/a |
| 311X | n/a | n/a |
| 301I | 63.74 | 62.57 |
| 311U | 63.66 | 62.16 |
| 311V | 63.68 | 61.76 |
| 311W | 63.86 | 62.51 |
| 301A | 63.79 | 62.44 |
| 311T | 63.62 | 61.95 |
| 301B | 63.65 | 62.27 |
| 301C | 63.66 | 62.1 |
| 411G | 63.7 | 62.52 |
| 401E | 63.62 | 62.07 |
| 401L | n/a | n/a |

| Manhole Reference | Manhole Cover Level | Manhole Invert Level |
|-------------------|---------------------|----------------------|
| 411F | 63.64 | 61.13 |
| 401K | n/a | n/a |
| 401M | n/a | n/a |
| 401F | 63.52 | 62.77 |
| 401N | n/a | n/a |
| 401I | n/a | n/a |
| 411D | 63.48 | 61.34 |
| 401J | n/a | n/a |
| 401A | 63.49 | 62.58 |
| 401G | 63.33 | 61.55 |
| 401B | 63.33 | 62.43 |
| 401C | 63.31 | 61.67 |
| 411E | n/a | n/a |
| 411N | n/a | n/a |
| 411M | n/a | n/a |
| 411C | 63.39 | 61.99 |
| 411P | n/a | n/a |
| 401D | 63.52 | 62.11 |
| 101M | n/a | n/a |
| 101O | n/a | n/a |
| 101R | n/a | n/a |
| 101E | n/a | n/a |
| 101N | n/a | n/a |
| 101F | n/a | n/a |
| 201D | 64.68 | 63.4 |
| 201C | 64.67 | 62.85 |
| 301J | 64.54 | 62.65 |
| 301K | 64.48 | 63.05 |
| 301L | n/a | n/a |
| 401O | 63.72 | 61.76 |
| 4001 | 63.62 | 61.63 |
| 4050 | 63.63 | 62.19 |
| 0401 | 63.15 | 57.68 |
| 0301 | 62.25 | 57.81 |
| 1301 | 62.6 | 59.65 |
| 1303 | 62.61 | 60.2 |
| 141A | n/a | n/a |
| 141B | n/a | n/a |
| 141C | n/a | n/a |
| 141D | n/a | n/a |
| 1302 | 62.52 | 59.51 |
| 231A | 62.02 | 59.72 |
| 2302 | n/a | n/a |
| 2301 | 62.29 | 59.31 |
| 3301 | 62.49 | 59.19 |
| 0101 | n/a | n/a |
| 0201 | 62.31 | 57.91 |
| 011A | n/a | n/a |
| 0150 | 62.53 | 61.16 |
| 0251 | n/a | n/a |
| 0154 | 62.85 | 61.61 |
| 0153 | 62.81 | 61.28 |
| 1250 | 62.16 | 60.8 |
| 1203 | 62.66 | n/a |
| 1202 | 62.63 | 60.68 |
| 1201 | 62.8 | 60.26 |
| 121B | n/a | n/a |
| 1204 | 62.91 | 61.28 |
| 1252 | 62.9 | 61.69 |
| 111A | n/a | n/a |
| 111E | n/a | n/a |
| 111C | n/a | n/a |
| 121A | 62.65 | 61.15 |
| 111D | n/a | n/a |
| 1205 | 63.16 | 61.81 |
| 1253 | 63.16 | 62.21 |
| 1304 | 62.6 | 60.06 |
| 221I | 62.76 | 58.37 |
| 2210 | 62.71 | 58.47 |
| 221H | 62.72 | 60.25 |
| 221G | 62.73 | 60.12 |
| 0152 | 62.99 | 61.43 |
| 0102 | 63.22 | 61 |
| 0155 | n/a | n/a |
| 0103 | 63.39 | 61.14 |
| 0050 | 63.97 | 62 |
| 0104 | 63.25 | 61.17 |
| 1001 | 63.92 | 61.32 |
| 0051 | 63.96 | 62.26 |
| 101Q | n/a | n/a |
| 1054 | 63.91 | 62.29 |
| 1055 | 63.73 | 61.48 |
| 1101 | 63.24 | 61.38 |
| 1155 | 63.22 | n/a |
| 101P | n/a | n/a |
| 111B | n/a | n/a |
| 111F | n/a | n/a |
| 1150 | 63.43 | 61.8 |
| 1102 | 63.43 | 61.51 |
| 1053 | 63.62 | 62.38 |
| 1151 | 63.62 | 61.86 |
| 1056 | 63.7 | 61.77 |
| 101K | n/a | n/a |

| Manhole Reference | Manhole Cover Level | Manhole Invert Level |
|-------------------|---------------------|----------------------|
| 1103 | 63.94 | 61.65 |
| 1152 | 63.94 | 61.96 |
| 1052 | 63.74 | 62.47 |
| 101L | n/a | n/a |
| 101J | n/a | n/a |
| 101G | n/a | n/a |
| 1104 | 63.94 | 61.78 |
| 1153 | 63.94 | 62.09 |
| 1105 | 63.93 | 61.94 |
| 101I | n/a | n/a |
| 1154 | 63.92 | 62.34 |
| 101H | n/a | n/a |
| 1106 | 63.95 | 62.13 |
| 1050 | 63.96 | 62.38 |
| 2001 | 64.13 | 62.29 |
| 2050 | 64.23 | 62.61 |
| 201G | n/a | n/a |
| 201F | n/a | n/a |
| 2150 | 63.61 | 62.39 |
| 2051 | n/a | n/a |
| 201A | 64.18 | 63.24 |
| 201E | 64.35 | 63.11 |
| 2058 | 64.15 | 62.73 |
| 201B | 64.13 | 62.53 |
| 211A | 63.83 | 61.33 |
| 211B | 63.82 | 58.78 |
| 211H | 63.79 | 61.46 |
| 211I | 63.83 | 58.8 |
| 311A | 64.17 | 58.85 |
| 311L | 64.17 | 61.65 |
| 311E | 63.99 | 62.59 |
| 301E | 64.21 | 62.34 |
| 301F | 64.31 | 62.96 |
| 311K | 63.86 | 62.53 |
| 0001 | n/a | n/a |
| 101D | n/a | n/a |
| 101C | n/a | n/a |

The position of the apparatus shown on this plan is given without obligation and warranty, and the accuracy cannot be guaranteed. Service pipes are not shown but their presence should be anticipated. No liability of any kind whatsoever is accepted by Thames Water for any error or omission. The actual position of mains and services must be verified and established on site before any works are undertaken.



Asset Location Search - Sewer Key

Public Sewer Types (Operated and maintained by Thames Water)

| | |
|--|---|
| | Foul Sewer: A sewer designed to convey waste water from domestic and industrial sources to a treatment works. |
| | Surface Water Sewer: A sewer designed to convey surface water (e.g. rain water from roofs, yards and car parks) to rivers or watercourses. |
| | Combined Sewer: A sewer designed to convey both waste water and surface water from domestic and industrial sources to a treatment works. |
| | Storm Sewer |
| | Sludge Sewer |
| | Foul Trunk Sewer |
| | Surface Trunk Sewer |
| | Combined Trunk Sewer |
| | Foul Rising Main |
| | Surface Water Rising Main |
| | Combined Rising Main |
| | Vacuum |
| | Thames Water Proposed |
| | Vent Pipe |
| | Gallery |

Other Sewer Types (Not operated and maintained by Thames Water)

| | | | |
|--|--|--|--|
| | Sewer | | Culverted Watercourse |
| | Proposed | | Decommissioned Sewer |
| | Content of this drainage network is currently unknown | | Ownership of this drainage network is currently unknown |

Notes:

- 1) All levels associated with the plans are to Ordnance Datum Newlyn.
- 2) All measurements on the plan are metric.
- 3) Arrows (on gravity fed sewers) or flecks (on rising mains) indicate the direction of flow.
- 4) Most private pipes are not shown on our plans, as in the past, this information has not been recorded.

Sewer Fittings

A feature in a sewer that does not affect the flow in the pipe. Example: a vent is a fitting as the function of a vent is to release excess gas.

| | | | |
|----------------|------------------|--|--------------|
| | Air Valve | | Meter |
| | Dam Chase | | Vent |
| Fitting | | | |

Operational Controls

A feature in a sewer that changes or diverts the flow in the sewer. Example: A hydrobrake limits the flow passing downstream.

| | | | |
|--|----------------------|--|------------------|
| | Ancillary | | Drop Pipe |
| | Control Valve | | Weir |

End Items

End symbols appear at the start or end of a sewer pipe. Examples: an Undefined End at the start of a sewer indicates that Thames Water has no knowledge of the position of the sewer upstream of that symbol. Outfall on a surface water sewer indicates that the pipe discharges into a stream or river.

| | | | |
|--|----------------------|--|----------------|
| | Inlet | | Outfall |
| | Undefined End | | |

Other Symbols

Symbols used on maps which do not fall under other general categories.

| | | | |
|--|---|--|---|
| | Change of Characteristic Indicator | | Public / Private Pumping Station |
| | Invert Level | | Summit |

Areas

Lines denoting areas of underground surveys, etc.

| | |
|--|-------------------------|
| | Agreement |
| | Chamber |
| | Operational Site |

Ducts or Crossings

| | | |
|--|-----------------------|--|
| | Casement | Ducts may contain high voltage cables. Please check with Thames Water. |
| | Conduit Bridge | |
| | Subway | |
| | Tunnel | |

Payment Terms and Conditions

All sales are made in accordance with Thames Water Utilities Limited (TWUL) standard terms and conditions unless previously agreed in writing.

1. All goods remain in the property of Thames Water Utilities Ltd until full payment is received.
2. Provision of service will be in accordance with all legal requirements and published TWUL policies.
3. All invoices are strictly due for payment within 14 days of the date of the invoice. Any other terms must be accepted/agreed in writing prior to provision of goods or service or will be held to be invalid.
4. Penalty interest may be invoked by TWUL in the event of unjustifiable payment delay. Interest charges will be in line with UK Statute Law 'The Late Payment of Commercial Debts (Interest) Act 1998'.
5. Interest will be charged in line with current Court Interest Charges, if legal action is taken.
6. A charge may be made at the discretion of the company for increased administration costs.

A copy of Thames Water's standard terms and conditions are available from the Commercial Billing Team (cashoperations@thameswater.co.uk).

We publish several Codes of Practice including a guaranteed standards scheme. You can obtain copies of these leaflets by calling us on 0800 316 9800.

If you are unhappy with our service, you can speak to your original goods or customer service provider. If you are still not satisfied with the outcome provided, we will refer the matter to a Senior Manager for resolution who will provide you with a response.

If you are still dissatisfied with our final response, and in certain circumstances such as you are buying a residential property or commercial property within certain parameters, The Property Ombudsman will investigate your case and give an independent view. The Ombudsman can award compensation of up to £25,000 to you if he finds that you have suffered actual financial loss and/or aggravation, distress, or inconvenience because of your search not keeping to the Code. Further information can be obtained by visiting www.tpos.co.uk or by sending an email to admin@tpos.co.uk.

If the Goods or Services covered by this invoice falls under the regulation of the 1991 Water Industry Act, and you remain dissatisfied you can refer your complaint to Consumer Council for Water on 0300 034 2222 or write to them at Consumer Council for Water, 1st Floor, Victoria Square House, Victoria Square, Birmingham, B2 4AJ.

Ways to pay your bill

| Credit Card | BACS Payment | Telephone Banking |
|--|--|--|
| Please Call 0800 009 4540 quoting your invoice number starting CBA or ADS | Account number 90478703 Sort code 60-00-01 A remittance advice must be sent to: Thames Water Utilities Ltd., PO Box 3189, Slough SL1 4WW. or email <u>ps.billing@thameswater.co.uk</u> | By calling your bank and quoting: Account number 90478703 Sort code 60-00-01 and your invoice number |

Thames Water Utilities Ltd Registered in England & Wales No. 2366661 Registered Office Clearwater Court, Vastern Rd, Reading, Berks, RG1 8DB.

Asset location search



Property Searches

Amin Asil
Arcadis Consulting UK Ltd
Arcadis Cymru House
St Mellons Business Park
CARDIFF
CF3 0EY

Search address supplied 524195 137583
Rusper Road
The Maples
The Maples
Rusper, Horsham, West Sussex
RH11 0GE

Your reference N/A

Our reference ALS/ALS Non Chargeable/2023_4827726

Search date 17 May 2023

Notification of Price Changes

From 1st April 2023 Thames water Property Searches will be increasing the prices of its CON29DW, CommercialDW Drainage & Water Enquiries and Asset Location Searches. Historically costs would rise in line with RPI but as this currently sits at 14.2%, we are capping it at 10%.

Customers will be emailed with the new prices by January 1st 2023.

Any orders received with a higher payment prior to the 1st April 2023 will be non-refundable. For further details on the price increase please visit our website at www.thameswater-propertysearches.co.uk



Thames Water Utilities Ltd
Property Searches, PO Box 3189, Slough SL1 4WW



searches@thameswater.co.uk
www.thameswater-propertysearches.co.uk



0800 009 4540

Asset location search



Property Searches

Search address supplied: 524195 137583, Rusper Road, The Maples, The Maples, Rusper, Horsham, West Sussex, RH11 0GE

Dear Sir / Madam

An Asset Location Search is recommended when undertaking a site development. It is essential to obtain information on the size and location of clean water and sewerage assets to safeguard against expensive damage and allow cost-effective service design.

The following records were searched in compiling this report: - the map of public sewers & the map of waterworks. Thames Water Utilities Ltd (TWUL) holds all of these.

This search provides maps showing the position, size of Thames Water assets close to the proposed development and also manhole cover and invert levels, where available.

Please note that none of the charges made for this report relate to the provision of Ordnance Survey mapping information. The replies contained in this letter are given following inspection of the public service records available to this company. No responsibility can be accepted for any error or omission in the replies.

You should be aware that the information contained on these plans is current only on the day that the plans are issued. The plans should only be used for the duration of the work that is being carried out at the present time. Under no circumstances should this data be copied or transmitted to parties other than those for whom the current work is being carried out.

Thames Water do update these service plans on a regular basis and failure to observe the above conditions could lead to damage arising to new or diverted services at a later date.

Contact Us

If you have any further queries regarding this enquiry please feel free to contact a member of the team on 0800 009 4540, or use the address below:

Thames Water Utilities Ltd
Property Searches
PO Box 3189
Slough
SL1 4WW

Email: searches@thameswater.co.uk

Web: www.thameswater-propertysearches.co.uk

Asset location search



Property Searches

Waste Water Services

Please provide a copy extract from the public sewer map.

The following quartiles have been printed as they fall within Thames' sewerage area:

TQ2437SE
TQ2437SW
TQ2436NW
TQ2436NE

Enclosed is a map showing the approximate lines of our sewers. Our plans do not show sewer connections from individual properties or any sewers not owned by Thames Water unless specifically annotated otherwise. Records such as "private" pipework are in some cases available from the Building Control Department of the relevant Local Authority.

Where the Local Authority does not hold such plans it might be advisable to consult the property deeds for the site or contact neighbouring landowners.

This report relates only to sewerage apparatus of Thames Water Utilities Ltd, it does not disclose details of cables and or communications equipment that may be running through or around such apparatus.

The sewer level information contained in this response represents all of the level data available in our existing records. Should you require any further Information, please refer to the relevant section within the 'Further Contacts' page found later in this document.

For your guidance:

- The Company is not generally responsible for rivers, watercourses, ponds, culverts or highway drains. If any of these are shown on the copy extract they are shown for information only.
- Any private sewers or lateral drains which are indicated on the extract of the public sewer map as being subject to an agreement under Section 104 of the Water Industry Act 1991 are not an 'as constructed' record. It is recommended these details be checked with the developer.

Clean Water Services

Please provide a copy extract from the public water main map.

Following examination of our statutory maps, Thames Water has been unable to find

Asset location search



Property Searches

any plans of water mains within this area. If you require a connection to the public water supply system, please write to:

New Connections / Diversions
Thames Water
Network Services Business Centre
Brentford
Middlesex
TW8 0EE

Tel: 0845 850 2777
Fax: 0207 713 3858
Email: developer.services@thameswater.co.uk

The following quartiles have not been printed as they are out of Thames' water catchment area. For details of the assets requested please contact the water company indicated below:

TQ2437SE Southern
TQ2437SW Southern
TQ2436NW Southern
TQ2436NE Southern

Southern Water
Southern House
Yeoman Road
Worthing
West Sussex
BN13 3NX

Tel: 01903 264 444
Fax: 01903 691 435
Website: www.southernwater.co.uk.

For your guidance:

- Assets other than vested water mains may be shown on the plan, for information only.
- If an extract of the public water main record is enclosed, this will show known public water mains in the vicinity of the property. It should be possible to estimate the likely length and route of any private water supply pipe connecting the property to the public water network.

Payment for this Search

There is no fee associated with this enquiry, and thus no payment is required.

Asset location search



Property Searches

Further contacts:

Waste Water queries

Should you require verification of the invert levels of public sewers, by site measurement, you will need to approach the relevant Thames Water Area Network Office for permission to lift the appropriate covers. This permission will usually involve you completing a TWOSA form. For further information please contact our Customer Centre on Tel: 0845 920 0800. Alternatively, a survey can be arranged, for a fee, through our Customer Centre on the above number.

If you have any questions regarding sewer connections, budget estimates, diversions, building over issues or any other questions regarding operational issues please direct them to our service desk. Which can be contacted by writing to:

Developer Services (Waste Water)
Thames Water
Clearwater Court
Vastern Road
Reading
RG1 8DB

Tel: 0800 009 3921
Email: developer.services@thameswater.co.uk

Clean Water queries


Should you require any advice concerning clean water operational issues or clean water connections, please contact:

Developer Services (Clean Water)
Thames Water
Clearwater Court
Vastern Road
Reading
RG1 8DB

Tel: 0800 009 3921
Email: developer.services@thameswater.co.uk

Asset Location Search Sewer Map - ALS/ALS Non Chargeable/2023_4827726

TQ2437SE

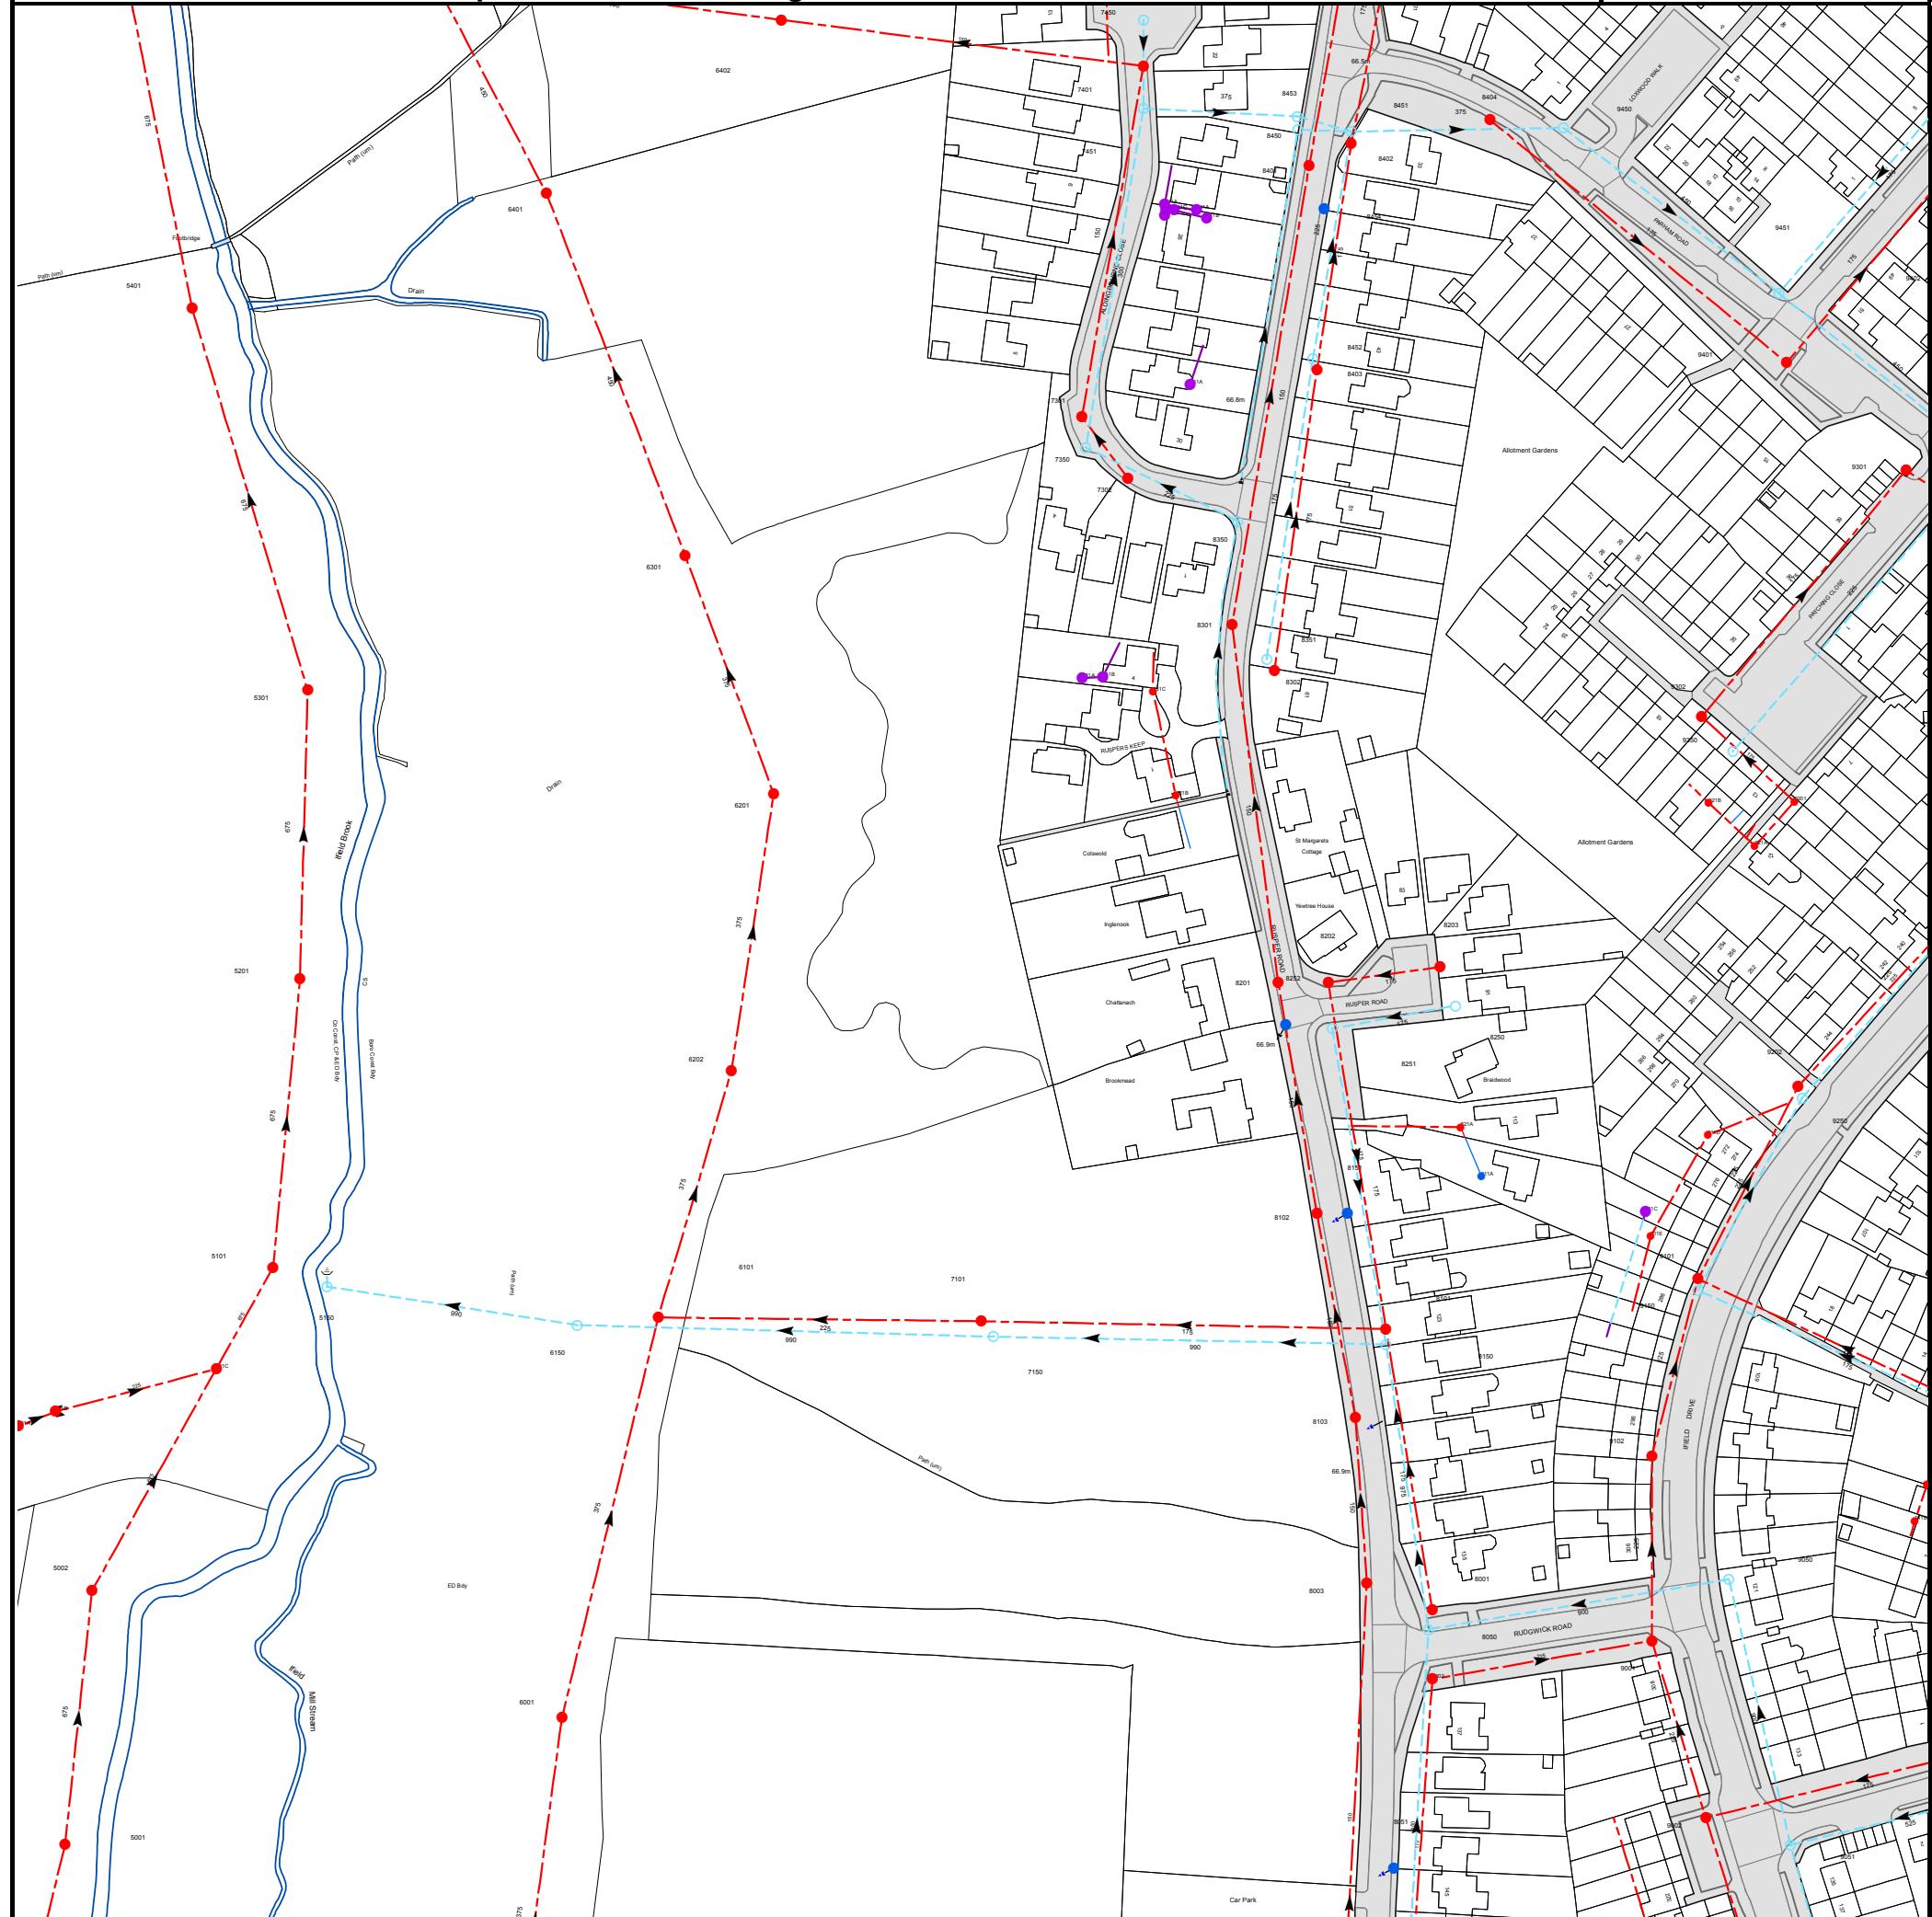

The width of the displayed area is 500m and the centre of the map is located at OS coordinates 524750,137250

The position of the apparatus shown on this plan is given without obligation and warranty, and the accuracy cannot be guaranteed. Service pipes are not shown but their presence should be anticipated. No liability of any kind whatsoever is accepted by Thames Water for any error or omission. The actual position of mains and services must be verified and established on site before any works are undertaken.


Based on the Ordnance Survey Map (2020) with the Sanction of the controller of H.M. Stationery Office, License no. 100019345 Crown Copyright Reserved.

NB. Levels quoted in metres Ordnance Newlyn Datum. The value -9999.00 indicates that no survey information is available

| Manhole Reference | Manhole Cover Level | Manhole Invert Level |
|-------------------|---------------------|----------------------|
| 9451 | 65.86 | 63.4 |
| 9401 | 66.01 | 64.11 |
| 9201 | 65.5 | 63.6 |
| 9301 | 65.39 | 62.92 |
| 9402 | 65.54 | 63.74 |
| 911E | n/a | n/a |
| 8151 | 67.06 | 66.1 |
| 911C | n/a | n/a |
| 811A | n/a | n/a |
| 911D | n/a | n/a |
| 821A | n/a | n/a |
| 8251 | 66.85 | 64.87 |
| 8250 | 66.79 | 65.18 |
| 8203 | 66.65 | 65.01 |
| 921A | n/a | n/a |
| 921B | n/a | n/a |
| 9350 | 65.66 | 63.81 |
| 9302 | 65.53 | 63.49 |
| 841B | n/a | n/a |
| 741C | n/a | n/a |
| 841C | n/a | n/a |
| 741B | n/a | n/a |
| 9202 | 65.81 | 63.49 |
| 9250 | 65.81 | 64.09 |
| 8051 | 67.04 | 66.4 |
| 9002 | 66.9 | 64.26 |
| 8002 | 66.79 | 64.31 |
| 9001 | 66.4 | 64.04 |
| 8050 | 66.65 | 64.17 |
| 8001 | 66.76 | 64.66 |
| 8003 | 67 | 66.31 |
| 9050 | 66.45 | 64.35 |
| 9102 | 66.25 | 63.83 |
| 8103 | 67.02 | 66.22 |
| 8150 | 66.93 | 63.75 |
| 8101 | 66.95 | 64 |
| 9150 | 65.97 | 64.13 |
| 9101 | 66.1 | 63.64 |
| 9051 | 66.77 | 64.99 |
| 911B | n/a | n/a |
| 911A | n/a | n/a |
| 8450 | n/a | n/a |
| 8401 | n/a | n/a |
| 8452 | 66.79 | 64.97 |
| 8403 | 66.8 | 65.31 |
| 8454 | n/a | n/a |
| 8451 | 66.66 | 64.44 |
| 8402 | 66.64 | 64.94 |
| 8404 | 66.11 | 64.81 |
| 9450 | 66.2 | 63.88 |
| 5401 | 65.22 | 61.22 |
| 6401 | n/a | n/a |
| 6402 | n/a | n/a |
| 7301 | 66.9 | 64.67 |
| 7350 | 66.99 | 65.42 |
| 7450 | 66.4 | 65.22 |
| 7451 | 66.49 | 64.84 |
| 7401 | 66.45 | 63.53 |
| 741A | n/a | n/a |
| 831A | n/a | n/a |
| 841A | n/a | n/a |
| 8453 | n/a | n/a |
| 6201 | 65.33 | 62.53 |
| 7101 | 67.25 | 63.3 |
| 7150 | 67.27 | 63.77 |
| 731A | n/a | n/a |
| 731B | n/a | n/a |
| 7302 | 66.99 | 64.86 |
| 731C | n/a | n/a |
| 821B | n/a | n/a |
| 8301 | n/a | n/a |
| 8350 | 66.87 | 65.83 |
| 8351 | 66.81 | 65.43 |
| 8302 | 66.79 | 65.76 |
| 8201 | 66.85 | 65.98 |
| 8252 | 66.83 | 65.24 |
| 8102 | 67.11 | n/a |
| 8202 | 66.96 | 64.64 |
| 511A | 66.75 | 62.89 |
| 511B | 66.7 | 62.83 |
| 5001 | 66.74 | 62.74 |
| 5002 | 66.09 | 62.41 |
| 511C | 66.46 | 62.44 |
| 5101 | 66.02 | 62.26 |
| 5201 | 65.75 | 61.95 |
| 5301 | 64.42 | 61.57 |
| 5150 | n/a | n/a |
| 6001 | 65.34 | 63.2 |
| 6150 | 65.27 | 63.67 |
| 6101 | 65.31 | 62.81 |
| 6301 | 64.95 | 62.35 |

| Manhole Reference | Manhole Cover Level | Manhole Invert Level |
|-------------------|---------------------|----------------------|
| 6202 | 65.16 | 62.77 |


The position of the apparatus shown on this plan is given without obligation and warranty, and the accuracy cannot be guaranteed. Service pipes are not shown but their presence should be anticipated. No liability of any kind whatsoever is accepted by Thames Water for any error or omission. The actual position of mains and services must be verified and established on site before any works are undertaken.

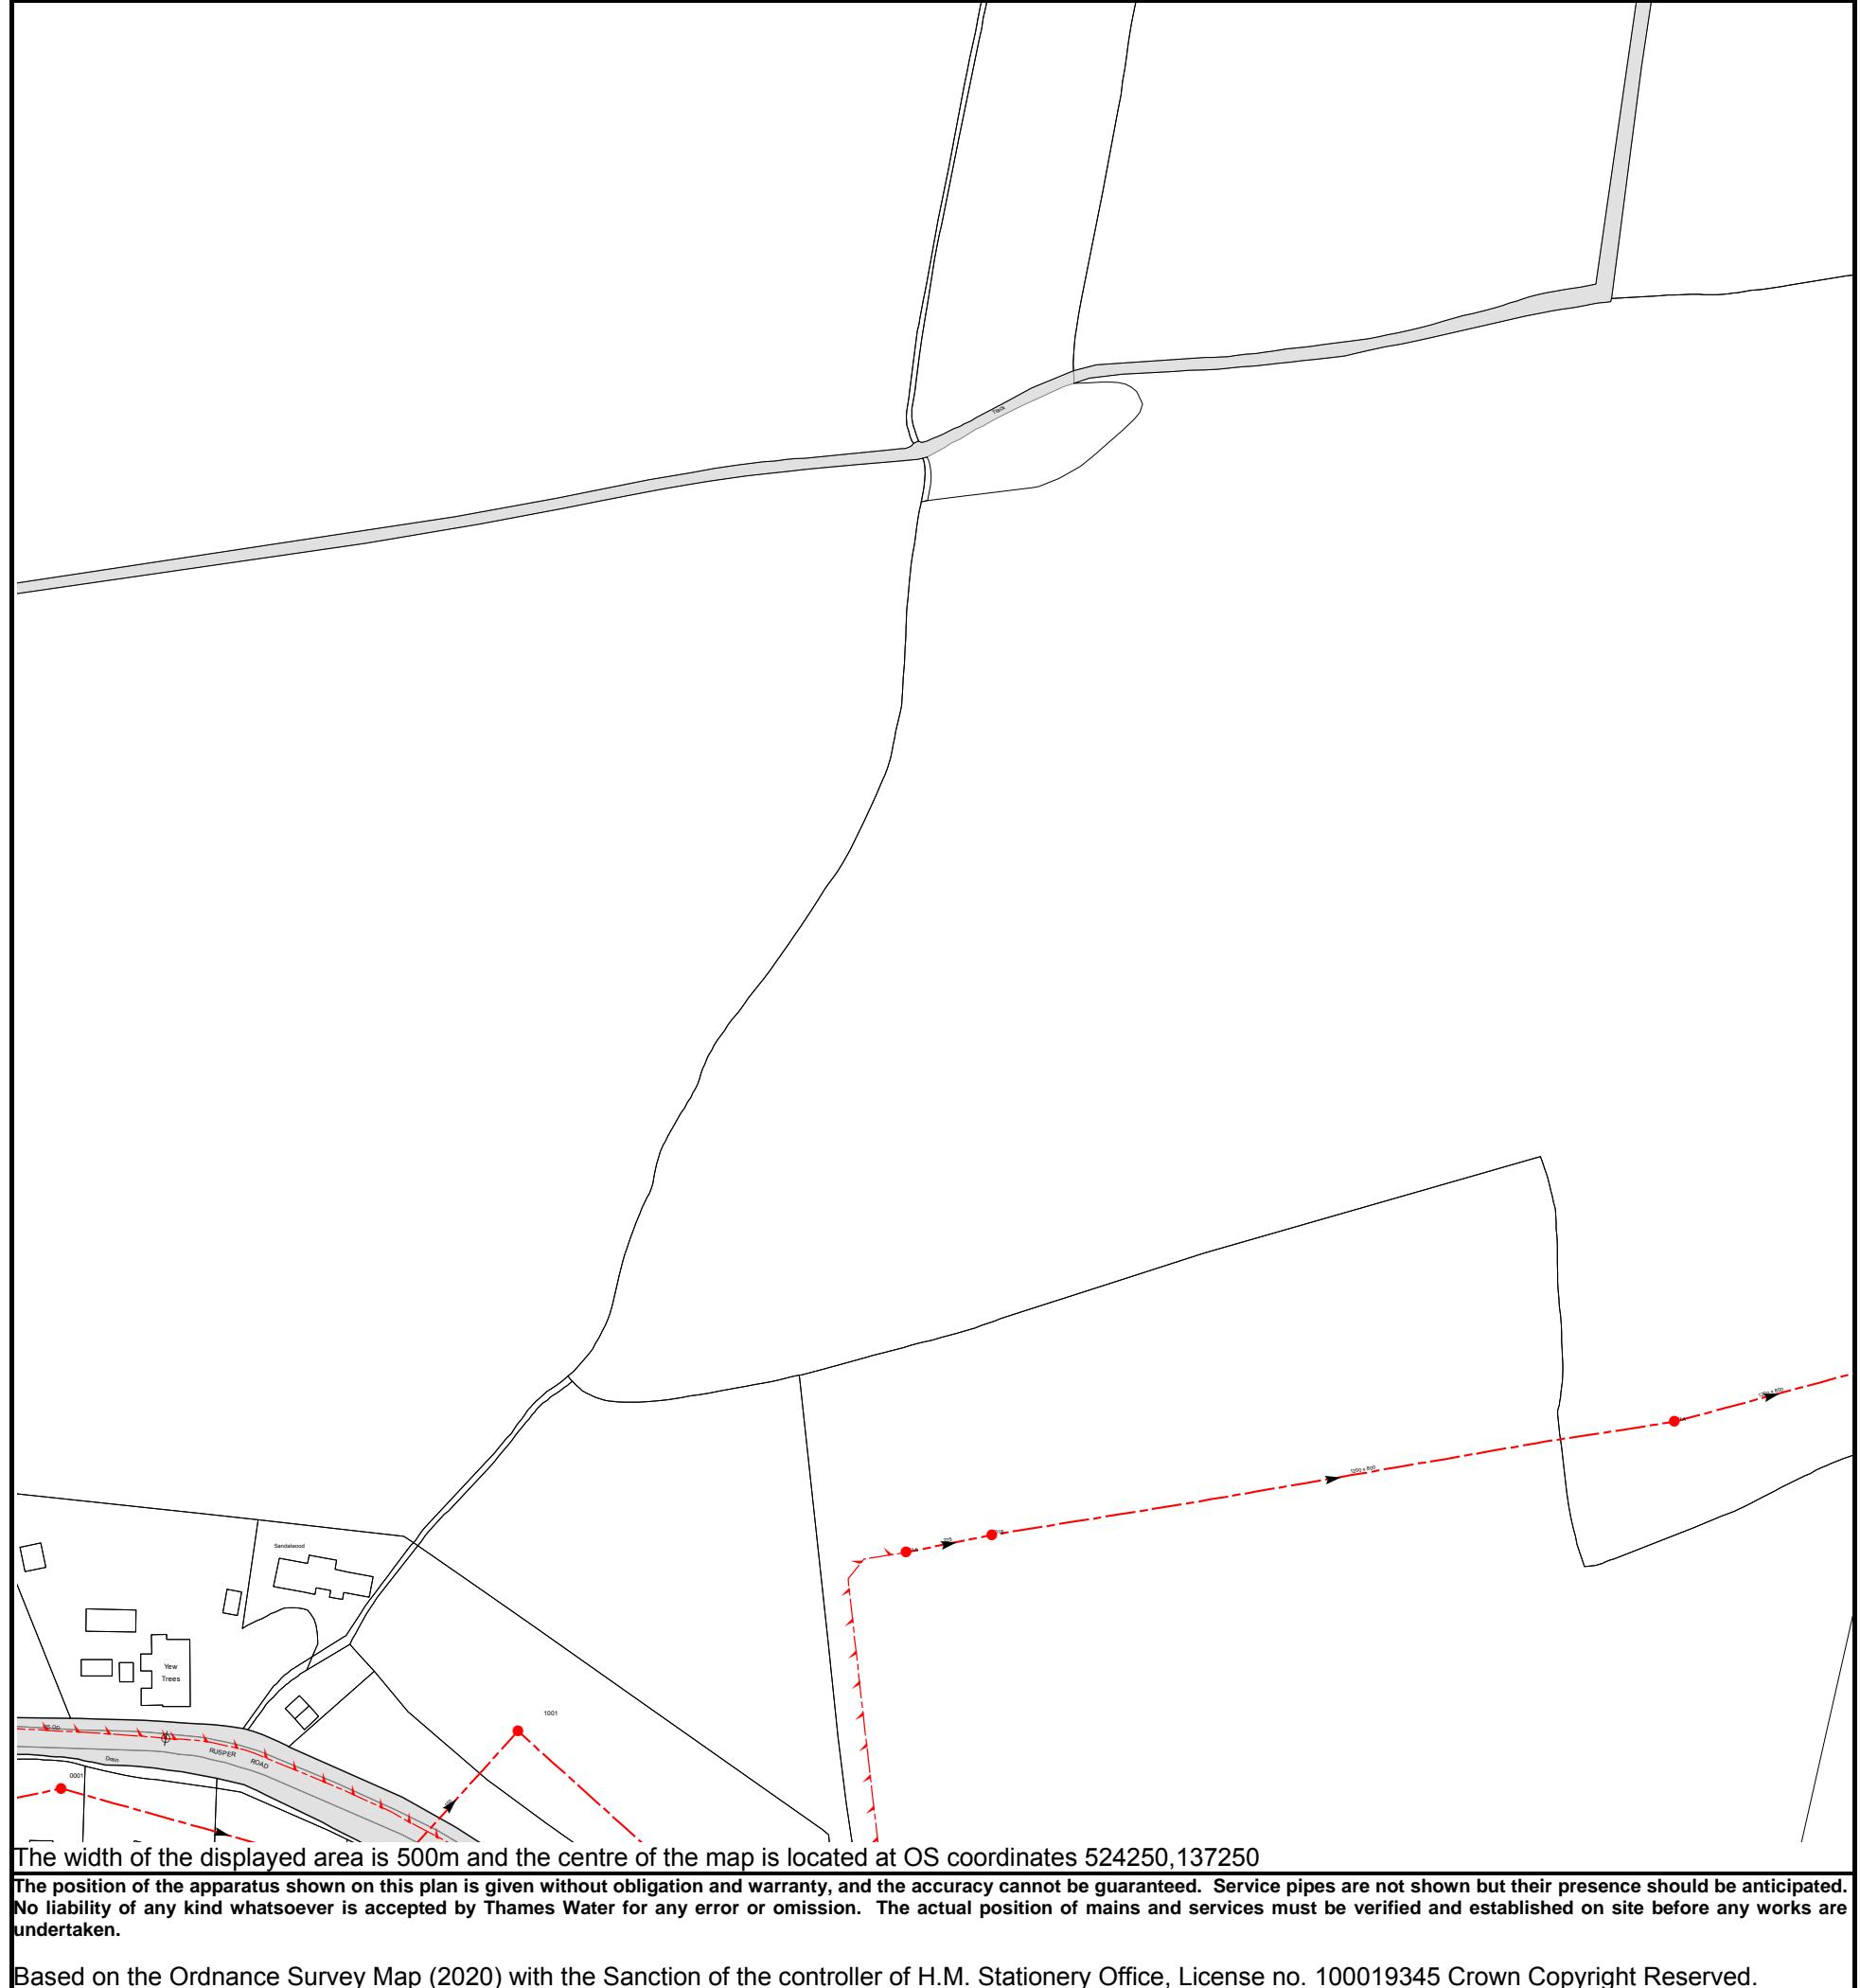

NB. Levels quoted in metres Ordnance Newlyn Datum. The value -9999.00 indicates that no survey information is available

| Manhole Reference | Manhole Cover Level | Manhole Invert Level |
|-------------------|---------------------|----------------------|
| 411A | 66.95 | 63.11 |
| 201A | 65.89 | 64.61 |
| 201B | 66.34 | 63.86 |
| 1001 | 65.08 | 63.35 |
| 0001 | n/a | n/a |

The position of the apparatus shown on this plan is given without obligation and warranty, and the accuracy cannot be guaranteed. Service pipes are not shown but their presence should be anticipated. No liability of any kind whatsoever is accepted by Thames Water for any error or omission. The actual position of mains and services must be verified and established on site before any works are undertaken.

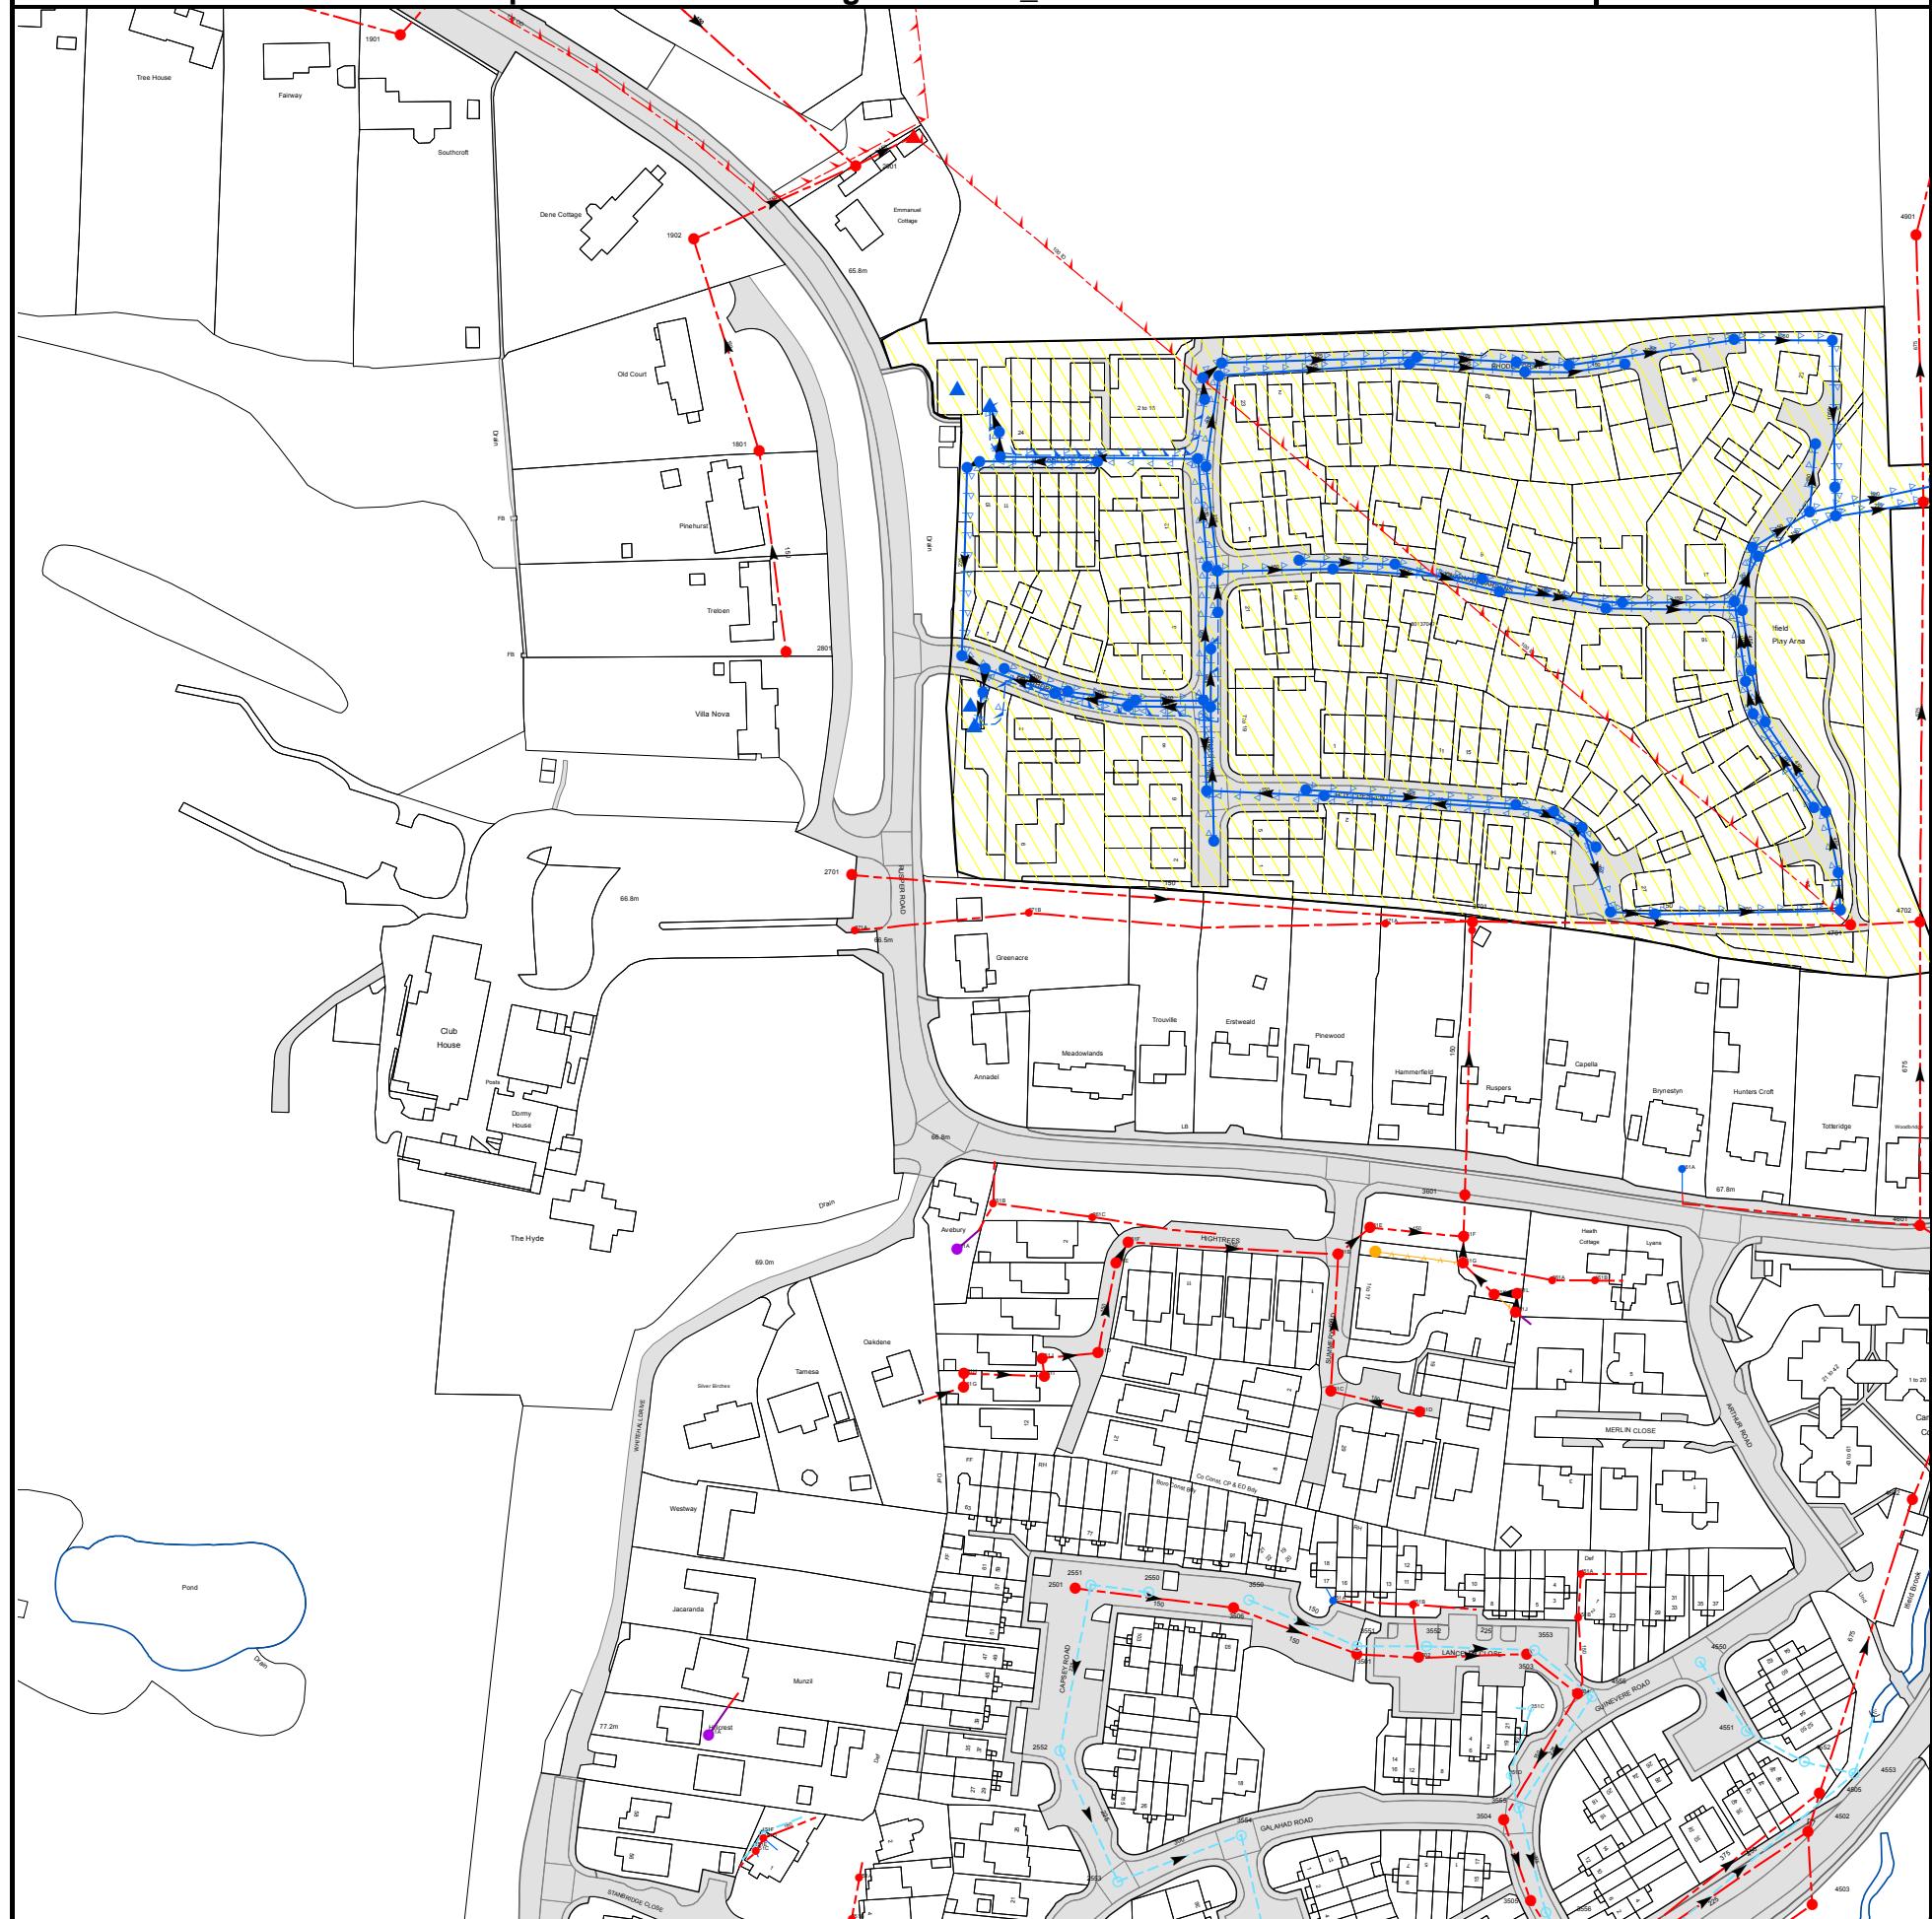

The width of the displayed area is 500m and the centre of the map is located at OS coordinates 524250,136750

The position of the apparatus shown on this plan is given without obligation and warranty, and the accuracy cannot be guaranteed. Service pipes are not shown but their presence should be anticipated. No liability of any kind whatsoever is accepted by Thames Water for any error or omission. The actual position of mains and services must be verified and established on site before any works are undertaken.

Based on the Ordnance Survey Map (2020) with the Sanction of the controller of H.M. Stationery Office, License no. 100019345 Crown Copyright Reserved.

NB. Levels quoted in metres Ordnance Newlyn Datum. The value -9999.00 indicates that no survey information is available


| Manhole Reference | Manhole Cover Level | Manhole Invert Level |
|-------------------|---------------------|----------------------|
| n/a | n/a | n/a |
| 1801 | 65.8 | 64.31 |
| n/a | n/a | n/a |
| 1902 | 65.53 | 63.85 |
| 2901 | 65.48 | 63.03 |
| n/a | n/a | n/a |
| 4901 | 66.74 | 62.79 |
| 4801 | 66.77 | 63.14 |
| n/a | n/a | n/a |
| 2801 | 66.11 | 64.71 |
| 2701 | n/a | n/a |
| n/a | n/a | n/a |
| 4702 | n/a | n/a |
| 3701 | 67.9 | 64.41 |
| n/a | n/a | n/a |
| 361J | n/a | n/a |
| 361K | n/a | n/a |
| 361L | n/a | n/a |
| 461B | n/a | n/a |
| 361A | n/a | n/a |
| 361G | 67.62 | 65.87 |
| 361F | n/a | 65.85 |
| 361E | 67.56 | 65.99 |
| 4601 | 66.96 | 63.81 |
| 3601 | 67.42 | 65.78 |
| 461A | n/a | n/a |
| 4701 | 68.03 | 64.01 |
| 371A | n/a | n/a |
| 3550 | 70.21 | 68.58 |
| 2550 | 71.13 | 69.31 |
| 2501 | 71.78 | 69.93 |
| 2551 | 71.56 | 69.04 |
| 361C | 68.11 | 66.35 |

| Manhole Reference | Manhole Cover Level | Manhole Invert Level |
|-------------------|---------------------|----------------------|
| 261G | n/a | n/a |
| 261I | n/a | 67.935 |
| 261H | n/a | n/a |
| 261J | n/a | 67.7 |
| 261D | 69.04 | 66.73 |
| 261E | 68.44 | 66.52 |
| 361B | 67.63 | 66.13 |
| 261A | n/a | n/a |
| 261F | 68.3 | 66.5 |
| 261C | n/a | n/a |
| 261B | n/a | n/a |
| 271A | n/a | n/a |
| 271B | n/a | n/a |
| n/a | n/a | n/a |
| 3551 | 70.21 | 67.97 |
| 3501 | 70.37 | 67.69 |
| 351B | n/a | n/a |
| 3502 | 69.58 | 67.33 |
| 361D | 68.08 | 66.74 |
| 3552 | 69.58 | 67.94 |
| 3503 | 69.23 | 66.92 |
| 351C | n/a | n/a |
| 3553 | 69.17 | 67.87 |
| 4504 | 68.94 | n/a |
| 451B | n/a | n/a |
| 451A | n/a | n/a |
| 4555 | 68.88 | 67.46 |
| 4550 | n/a | n/a |
| 4551 | 67.5 | 66.35 |
| 4552 | n/a | n/a |
| 4602 | 66.98 | 63.98 |
| 3504 | 69.18 | 66.11 |
| 351D | n/a | n/a |
| 3555 | 69.27 | 67.14 |
| 3505 | 68.57 | 65.84 |
| 3556 | n/a | n/a |
| 4502 | 67.51 | 64.06 |
| 4503 | 67.26 | 64.01 |
| 4505 | 67.72 | 64.06 |
| 4553 | 67.51 | 65.72 |
| 251B | n/a | n/a |
| 2553 | 72.3 | 68 |
| 251A | n/a | n/a |
| 151C | n/a | n/a |
| 151E | n/a | n/a |
| 151D | n/a | n/a |
| 3554 | 71.57 | 67.82 |
| 151F | n/a | n/a |
| 2552 | 72.84 | 68.56 |
| 151A | n/a | n/a |
| 3506 | 70.31 | 68.19 |
| 351A | n/a | n/a |
| 1901 | 65.41 | 63.81 |

The position of the apparatus shown on this plan is given without obligation and warranty, and the accuracy cannot be guaranteed. Service pipes are not shown but their presence should be anticipated. No liability of any kind whatsoever is accepted by Thames Water for any error or omission. The actual position of mains and services must be verified and established on site before any works are undertaken.

Asset Location Search Sewer Map - ALS/ALS Non Chargeable/2023_4827726

TQ2436NE

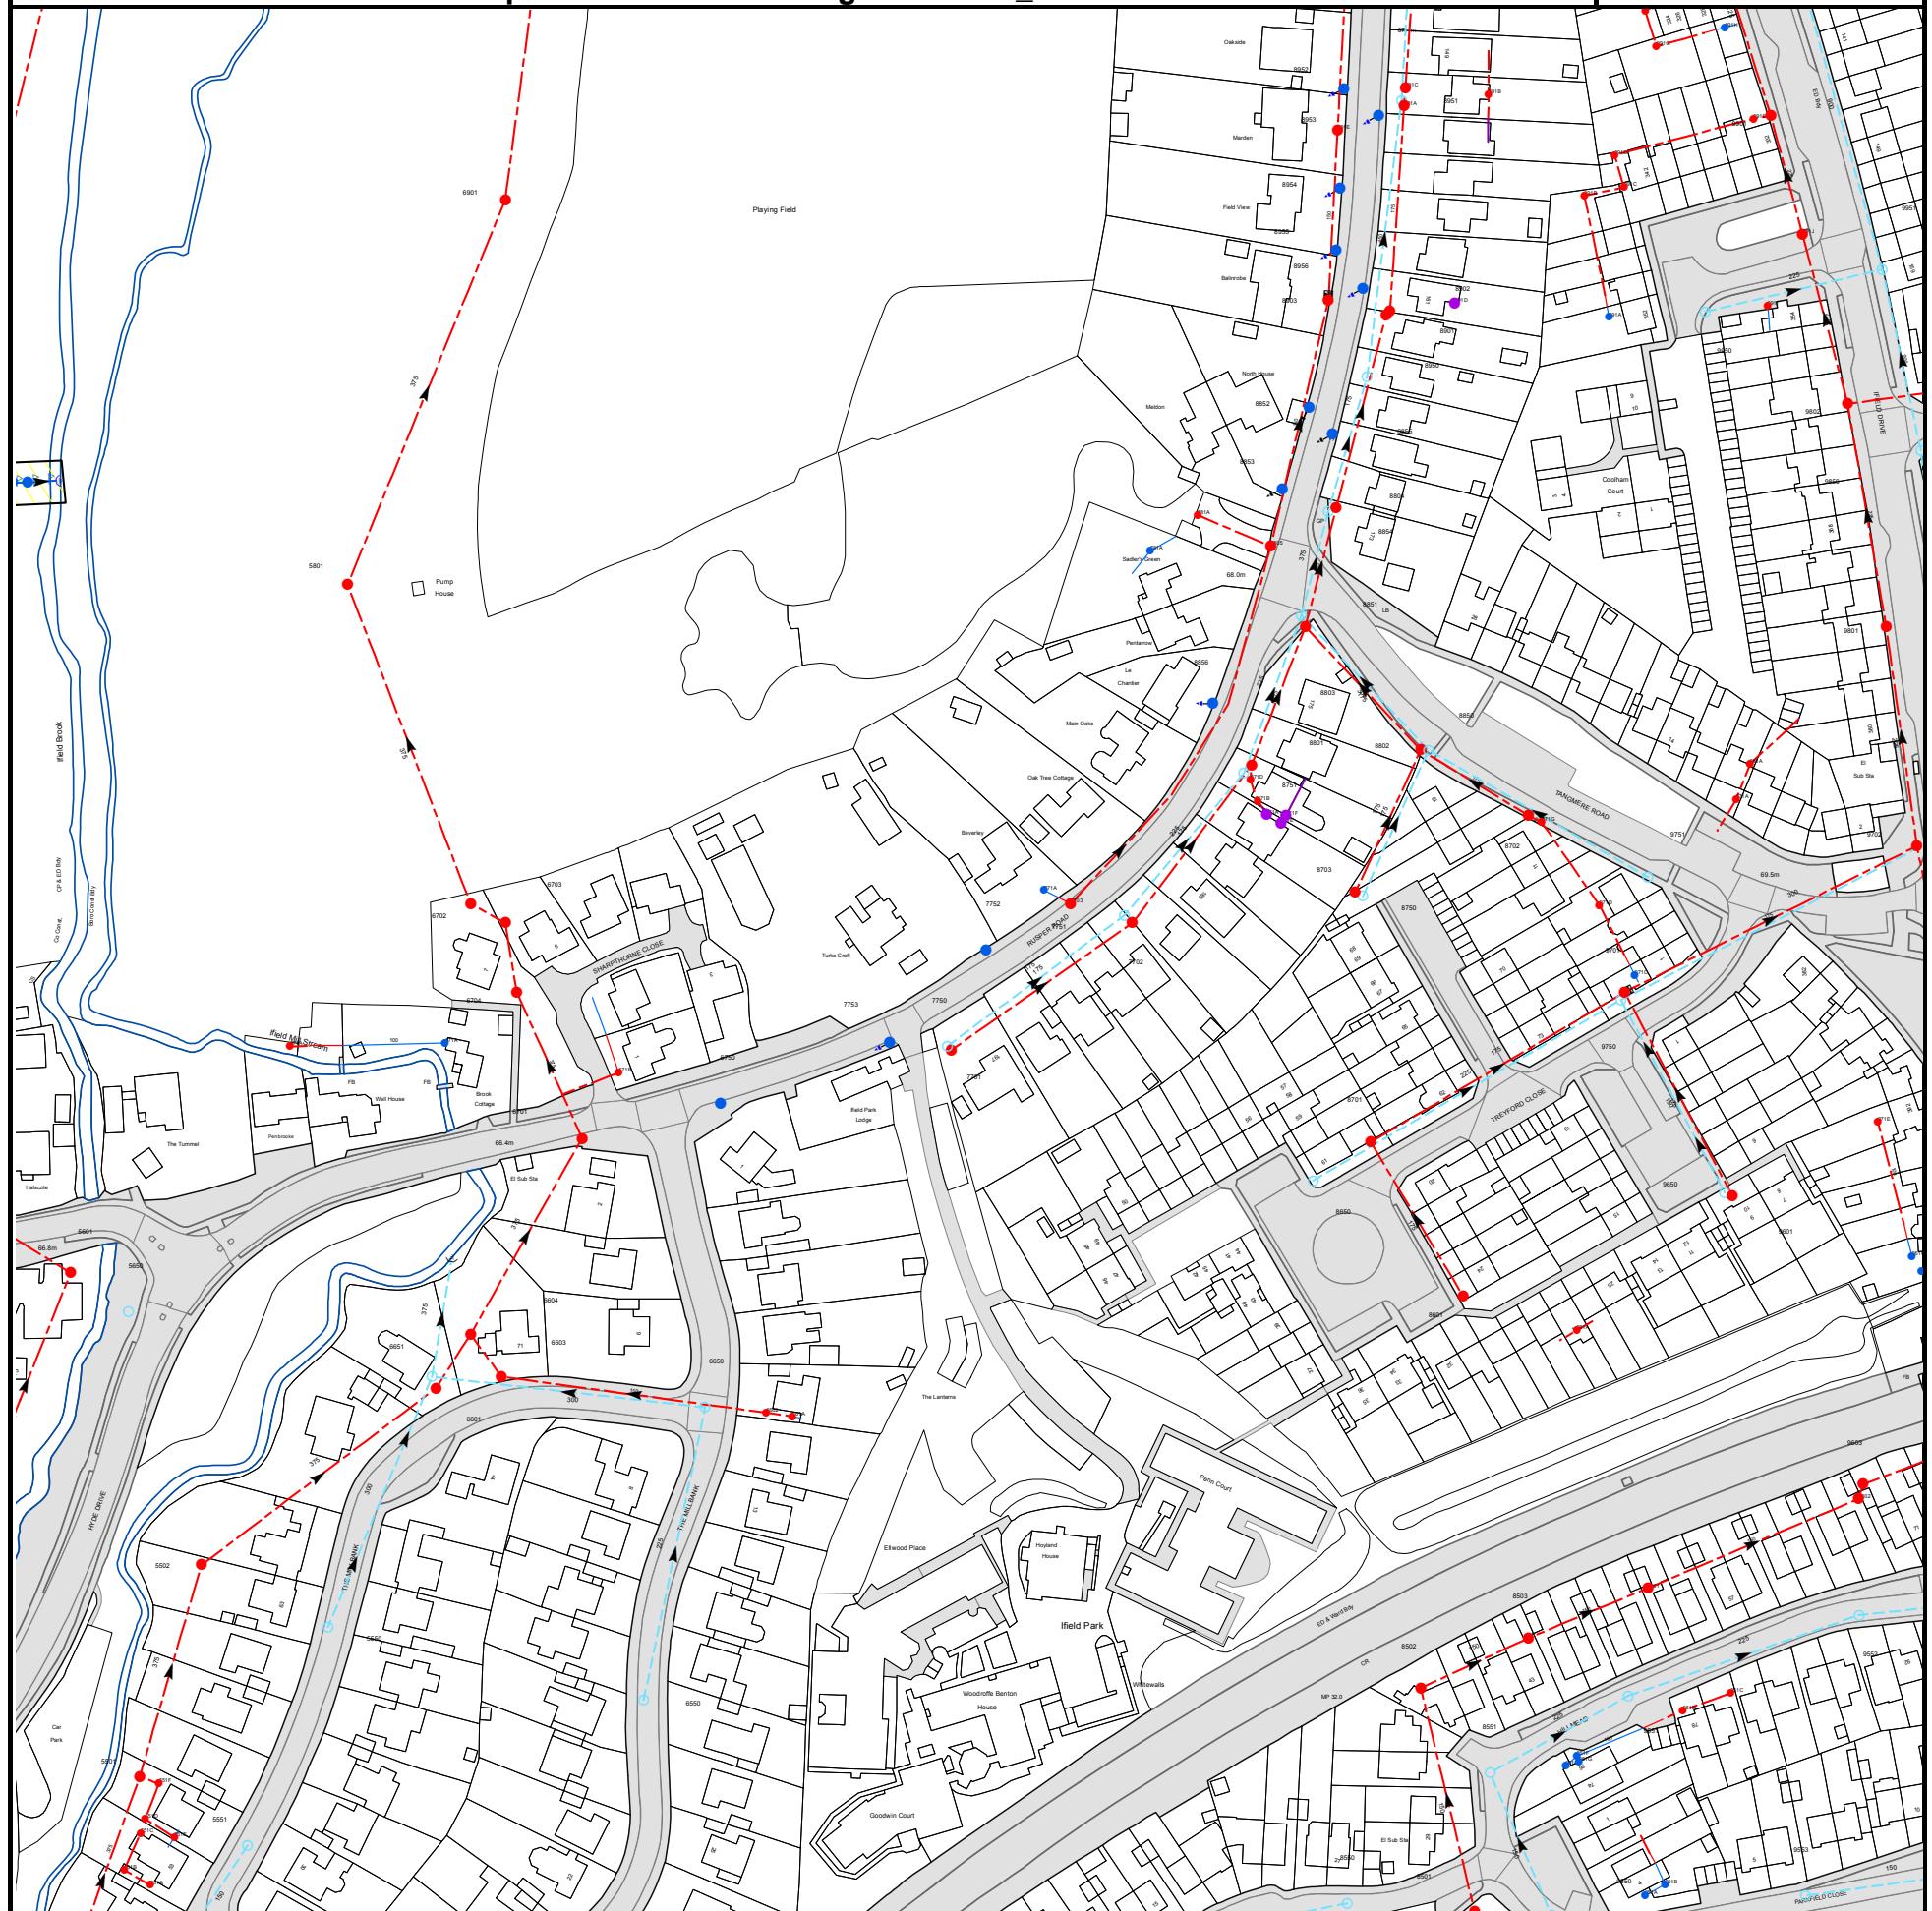

The width of the displayed area is 500m and the centre of the map is located at OS coordinates 524750,136750

The position of the apparatus shown on this plan is given without obligation and warranty, and the accuracy cannot be guaranteed. Service pipes are not shown but their presence should be anticipated. No liability of any kind whatsoever is accepted by Thames Water for any error or omission. The actual position of mains and services must be verified and established on site before any works are undertaken.

Based on the Ordnance Survey Map (2020) with the Sanction of the controller of H.M. Stationery Office. License no. 100019345 Crown Copyright Reserved.

NB. Levels quoted in metres Ordnance Newlyn Datum. The value -9999.00 indicates that no survey information is available

| Manhole Reference | Manhole Cover Level | Manhole Invert Level |
|-------------------|---------------------|----------------------|
| 991F | n/a | n/a |
| 8955 | 67.47 | 66.81 |
| 8804 | 67.88 | 65.64 |
| 891E | n/a | n/a |
| 8954 | 67.36 | 66.86 |
| 8952 | 67.18 | 66.57 |
| 8956 | 67.45 | 66.78 |
| 8950 | n/a | n/a |
| 8953 | 67.14 | 66.61 |
| 8901 | n/a | n/a |
| 8902 | 67.08 | 64.89 |
| 8951 | 67.14 | 65.09 |
| 891A | n/a | n/a |
| 891C | n/a | n/a |
| 8802 | 67.99 | 66.09 |
| 8850 | 68.02 | 66.44 |
| 891D | n/a | n/a |
| 891B | n/a | n/a |
| 8702 | 68.28 | 66.48 |
| 871G | n/a | n/a |
| 991B | n/a | n/a |
| 991A | n/a | n/a |
| 991D | n/a | n/a |
| 991C | n/a | n/a |
| 991G | n/a | n/a |
| 9950 | 67.66 | 66.19 |
| 991H | n/a | n/a |
| 971A | n/a | n/a |
| 981A | n/a | n/a |
| 991E | n/a | n/a |
| 991I | n/a | n/a |
| 9901 | 67.45 | 65.83 |
| 991J | n/a | n/a |
| 9802 | 68.19 | 66.19 |
| 9951 | 68.11 | 65.21 |
| 9801 | 68.81 | 66.41 |
| 9702 | 69.72 | 66.62 |
| 9850 | 68.44 | 65.72 |
| 9602 | 76.78 | 74.23 |
| 9603 | n/a | n/a |
| 971E | n/a | n/a |
| 961C | n/a | n/a |
| 961B | n/a | n/a |
| 951C | n/a | n/a |
| 8502 | n/a | n/a |
| 8503 | 76.22 | 74.59 |
| 9501 | 76.38 | 74.39 |
| 961A | n/a | n/a |
| 8601 | 70.99 | 69.16 |
| 9601 | 71.18 | 69.42 |
| 9650 | 71.15 | 68.97 |
| 8650 | 69.69 | 68.11 |
| 8701 | 69.54 | 67.68 |
| 9750 | 69.41 | 67.5 |
| 9701 | 69.38 | 67.2 |
| 971C | n/a | n/a |
| 971D | n/a | n/a |
| 8750 | n/a | n/a |
| 8703 | n/a | n/a |
| 9751 | 69.07 | 67.17 |
| 8550 | 78.71 | 77.11 |
| 8501 | 79.6 | 77.45 |
| 8551 | 77.61 | 75.44 |
| 9550 | 79.35 | 77.75 |
| 951E | n/a | n/a |
| 951F | n/a | n/a |
| 951G | n/a | n/a |
| 9551 | 76.65 | 75.01 |
| 951A | n/a | n/a |
| 951B | n/a | n/a |
| 951D | n/a | n/a |
| 9553 | 79.64 | 78.19 |
| 9552 | 76.74 | 74.74 |
| n/a | n/a | n/a |
| 5801 | n/a | n/a |
| 6901 | n/a | n/a |
| 781A | n/a | n/a |
| 881A | n/a | n/a |
| 8856 | 68.4 | 67.66 |
| 8751 | 68.24 | 66.39 |
| 871D | n/a | n/a |
| 8801 | 68.23 | 66.09 |
| 871B | n/a | n/a |
| 871A | n/a | n/a |
| 8805 | 68.01 | 66.81 |
| 871E | n/a | n/a |
| 8853 | 68.07 | 67.1 |
| 871F | n/a | n/a |
| 8851 | 68.1 | 66.07 |
| 8803 | 68.05 | n/a |

| Manhole Reference | Manhole Cover Level | Manhole Invert Level |
|-------------------|---------------------|----------------------|
| 8852 | 67.81 | 66.81 |
| 8903 | 67.45 | 66.68 |
| 8854 | 67.89 | 65.81 |
| 8855 | 67.82 | 67.09 |
| 5650 | n/a | n/a |
| 5601 | 66.96 | 63.85 |
| 5502 | n/a | n/a |
| 5551 | 66.91 | 66.13 |
| 5550 | 66.58 | 65.75 |
| 6651 | 66.88 | 65.57 |
| 6601 | 66.89 | 64.29 |
| 671A | n/a | n/a |
| 6604 | 67.06 | 64.23 |
| 6702 | 66.68 | 64.34 |
| 6603 | 67.03 | 66.13 |
| 6703 | 70.07 | 66.39 |
| 6704 | 67.01 | 63.72 |
| 6701 | 66.9 | 64.04 |
| 671B | n/a | n/a |
| 6550 | 69.79 | 68.19 |
| 6650 | 67.88 | 66.5 |
| 6750 | 68.03 | n/a |
| 6602 | 68.36 | 67.46 |
| 761A | n/a | n/a |
| 7753 | 68.28 | 67.29 |
| 7750 | 68.83 | 67.03 |
| 7701 | 68.83 | 66.83 |
| 7752 | 68.52 | 67.8 |
| 771A | n/a | n/a |
| 7703 | n/a | n/a |
| 7751 | 68.81 | 66.86 |
| 7702 | 68.59 | 66.37 |
| 551B | n/a | n/a |
| 5501 | 67.25 | 64.87 |
| 551C | n/a | n/a |
| 551D | n/a | n/a |
| 551A | n/a | n/a |
| 551F | n/a | n/a |
| 551E | n/a | n/a |

The position of the apparatus shown on this plan is given without obligation and warranty, and the accuracy cannot be guaranteed. Service pipes are not shown but their presence should be anticipated. No liability of any kind whatsoever is accepted by Thames Water for any error or omission. The actual position of mains and services must be verified and established on site before any works are undertaken.



Asset Location Search - Sewer Key

Public Sewer Types (Operated and maintained by Thames Water)

| | |
|--|---|
| | Foul Sewer: A sewer designed to convey waste water from domestic and industrial sources to a treatment works. |
| | Surface Water Sewer: A sewer designed to convey surface water (e.g. rain water from roofs, yards and car parks) to rivers or watercourses. |
| | Combined Sewer: A sewer designed to convey both waste water and surface water from domestic and industrial sources to a treatment works. |
| | Storm Sewer |
| | Sludge Sewer |
| | Foul Trunk Sewer |
| | Surface Trunk Sewer |
| | Combined Trunk Sewer |
| | Foul Rising Main |
| | Surface Water Rising Main |
| | Combined Rising Main |
| | Vacuum |
| | Thames Water Proposed |
| | Vent Pipe |
| | Gallery |

Other Sewer Types (Not operated and maintained by Thames Water)

| | | | |
|--|--|--|--|
| | Sewer | | Culverted Watercourse |
| | Proposed | | Decommissioned Sewer |
| | Content of this drainage network is currently unknown | | Ownership of this drainage network is currently unknown |

Notes:

- 1) All levels associated with the plans are to Ordnance Datum Newlyn.
- 2) All measurements on the plan are metric.
- 3) Arrows (on gravity fed sewers) or flecks (on rising mains) indicate the direction of flow.
- 4) Most private pipes are not shown on our plans, as in the past, this information has not been recorded.

Sewer Fittings

A feature in a sewer that does not affect the flow in the pipe. Example: a vent is a fitting as the function of a vent is to release excess gas.

| | | | |
|----------------|------------------|--|--------------|
| | Air Valve | | Meter |
| | Dam Chase | | Vent |
| Fitting | | | |

Operational Controls

A feature in a sewer that changes or diverts the flow in the sewer. Example: A hydrobrake limits the flow passing downstream.

| | | | |
|--|----------------------|--|------------------|
| | Ancillary | | Drop Pipe |
| | Control Valve | | Weir |

End Items

End symbols appear at the start or end of a sewer pipe. Examples: an Undefined End at the start of a sewer indicates that Thames Water has no knowledge of the position of the sewer upstream of that symbol. Outfall on a surface water sewer indicates that the pipe discharges into a stream or river.

| | | | |
|--|----------------------|--|----------------|
| | Inlet | | Outfall |
| | Undefined End | | |

Other Symbols

Symbols used on maps which do not fall under other general categories.

| | | | |
|--|---|--|---|
| | Change of Characteristic Indicator | | Public / Private Pumping Station |
| | Invert Level | | Summit |

Areas

Lines denoting areas of underground surveys, etc.

| | |
|--|-------------------------|
| | Agreement |
| | Chamber |
| | Operational Site |

Ducts or Crossings

| | | |
|--|-----------------------|--|
| | Casement | Ducts may contain high voltage cables. Please check with Thames Water. |
| | Conduit Bridge | |
| | Subway | |
| | Tunnel | |

Payment Terms and Conditions

All sales are made in accordance with Thames Water Utilities Limited (TWUL) standard terms and conditions unless previously agreed in writing.

1. All goods remain in the property of Thames Water Utilities Ltd until full payment is received.
2. Provision of service will be in accordance with all legal requirements and published TWUL policies.
3. All invoices are strictly due for payment within 14 days of the date of the invoice. Any other terms must be accepted/agreed in writing prior to provision of goods or service or will be held to be invalid.
4. Penalty interest may be invoked by TWUL in the event of unjustifiable payment delay. Interest charges will be in line with UK Statute Law 'The Late Payment of Commercial Debts (Interest) Act 1998'.
5. Interest will be charged in line with current Court Interest Charges, if legal action is taken.
6. A charge may be made at the discretion of the company for increased administration costs.

A copy of Thames Water's standard terms and conditions are available from the Commercial Billing Team (cashoperations@thameswater.co.uk).

We publish several Codes of Practice including a guaranteed standards scheme. You can obtain copies of these leaflets by calling us on 0800 316 9800.

If you are unhappy with our service, you can speak to your original goods or customer service provider. If you are still not satisfied with the outcome provided, we will refer the matter to a Senior Manager for resolution who will provide you with a response.


If you are still dissatisfied with our final response, and in certain circumstances such as you are buying a residential property or commercial property within certain parameters, The Property Ombudsman will investigate your case and give an independent view. The Ombudsman can award compensation of up to £25,000 to you if he finds that you have suffered actual financial loss and/or aggravation, distress, or inconvenience because of your search not keeping to the Code. Further information can be obtained by visiting www.tpos.co.uk or by sending an email to admin@tpos.co.uk.

If the Goods or Services covered by this invoice falls under the regulation of the 1991 Water Industry Act, and you remain dissatisfied you can refer your complaint to Consumer Council for Water on 0300 034 2222 or write to them at Consumer Council for Water, 1st Floor, Victoria Square House, Victoria Square, Birmingham, B2 4AJ.

Ways to pay your bill

| Credit Card | BACS Payment | Telephone Banking |
|--|---|--|
| Please Call 0800 009 4540 quoting your invoice number starting CBA or ADS | Account number 90478703 Sort code 60-00-01 A remittance advice must be sent to: Thames Water Utilities Ltd., PO Box 3189, Slough SL1 4WW. or email ps.billing@thameswater.co.uk | By calling your bank and quoting: Account number 90478703 Sort code 60-00-01 and your invoice number |

Thames Water Utilities Ltd Registered in England & Wales No. 2366661 Registered Office Clearwater Court, Vastern Rd, Reading, Berks, RG1 8DB.

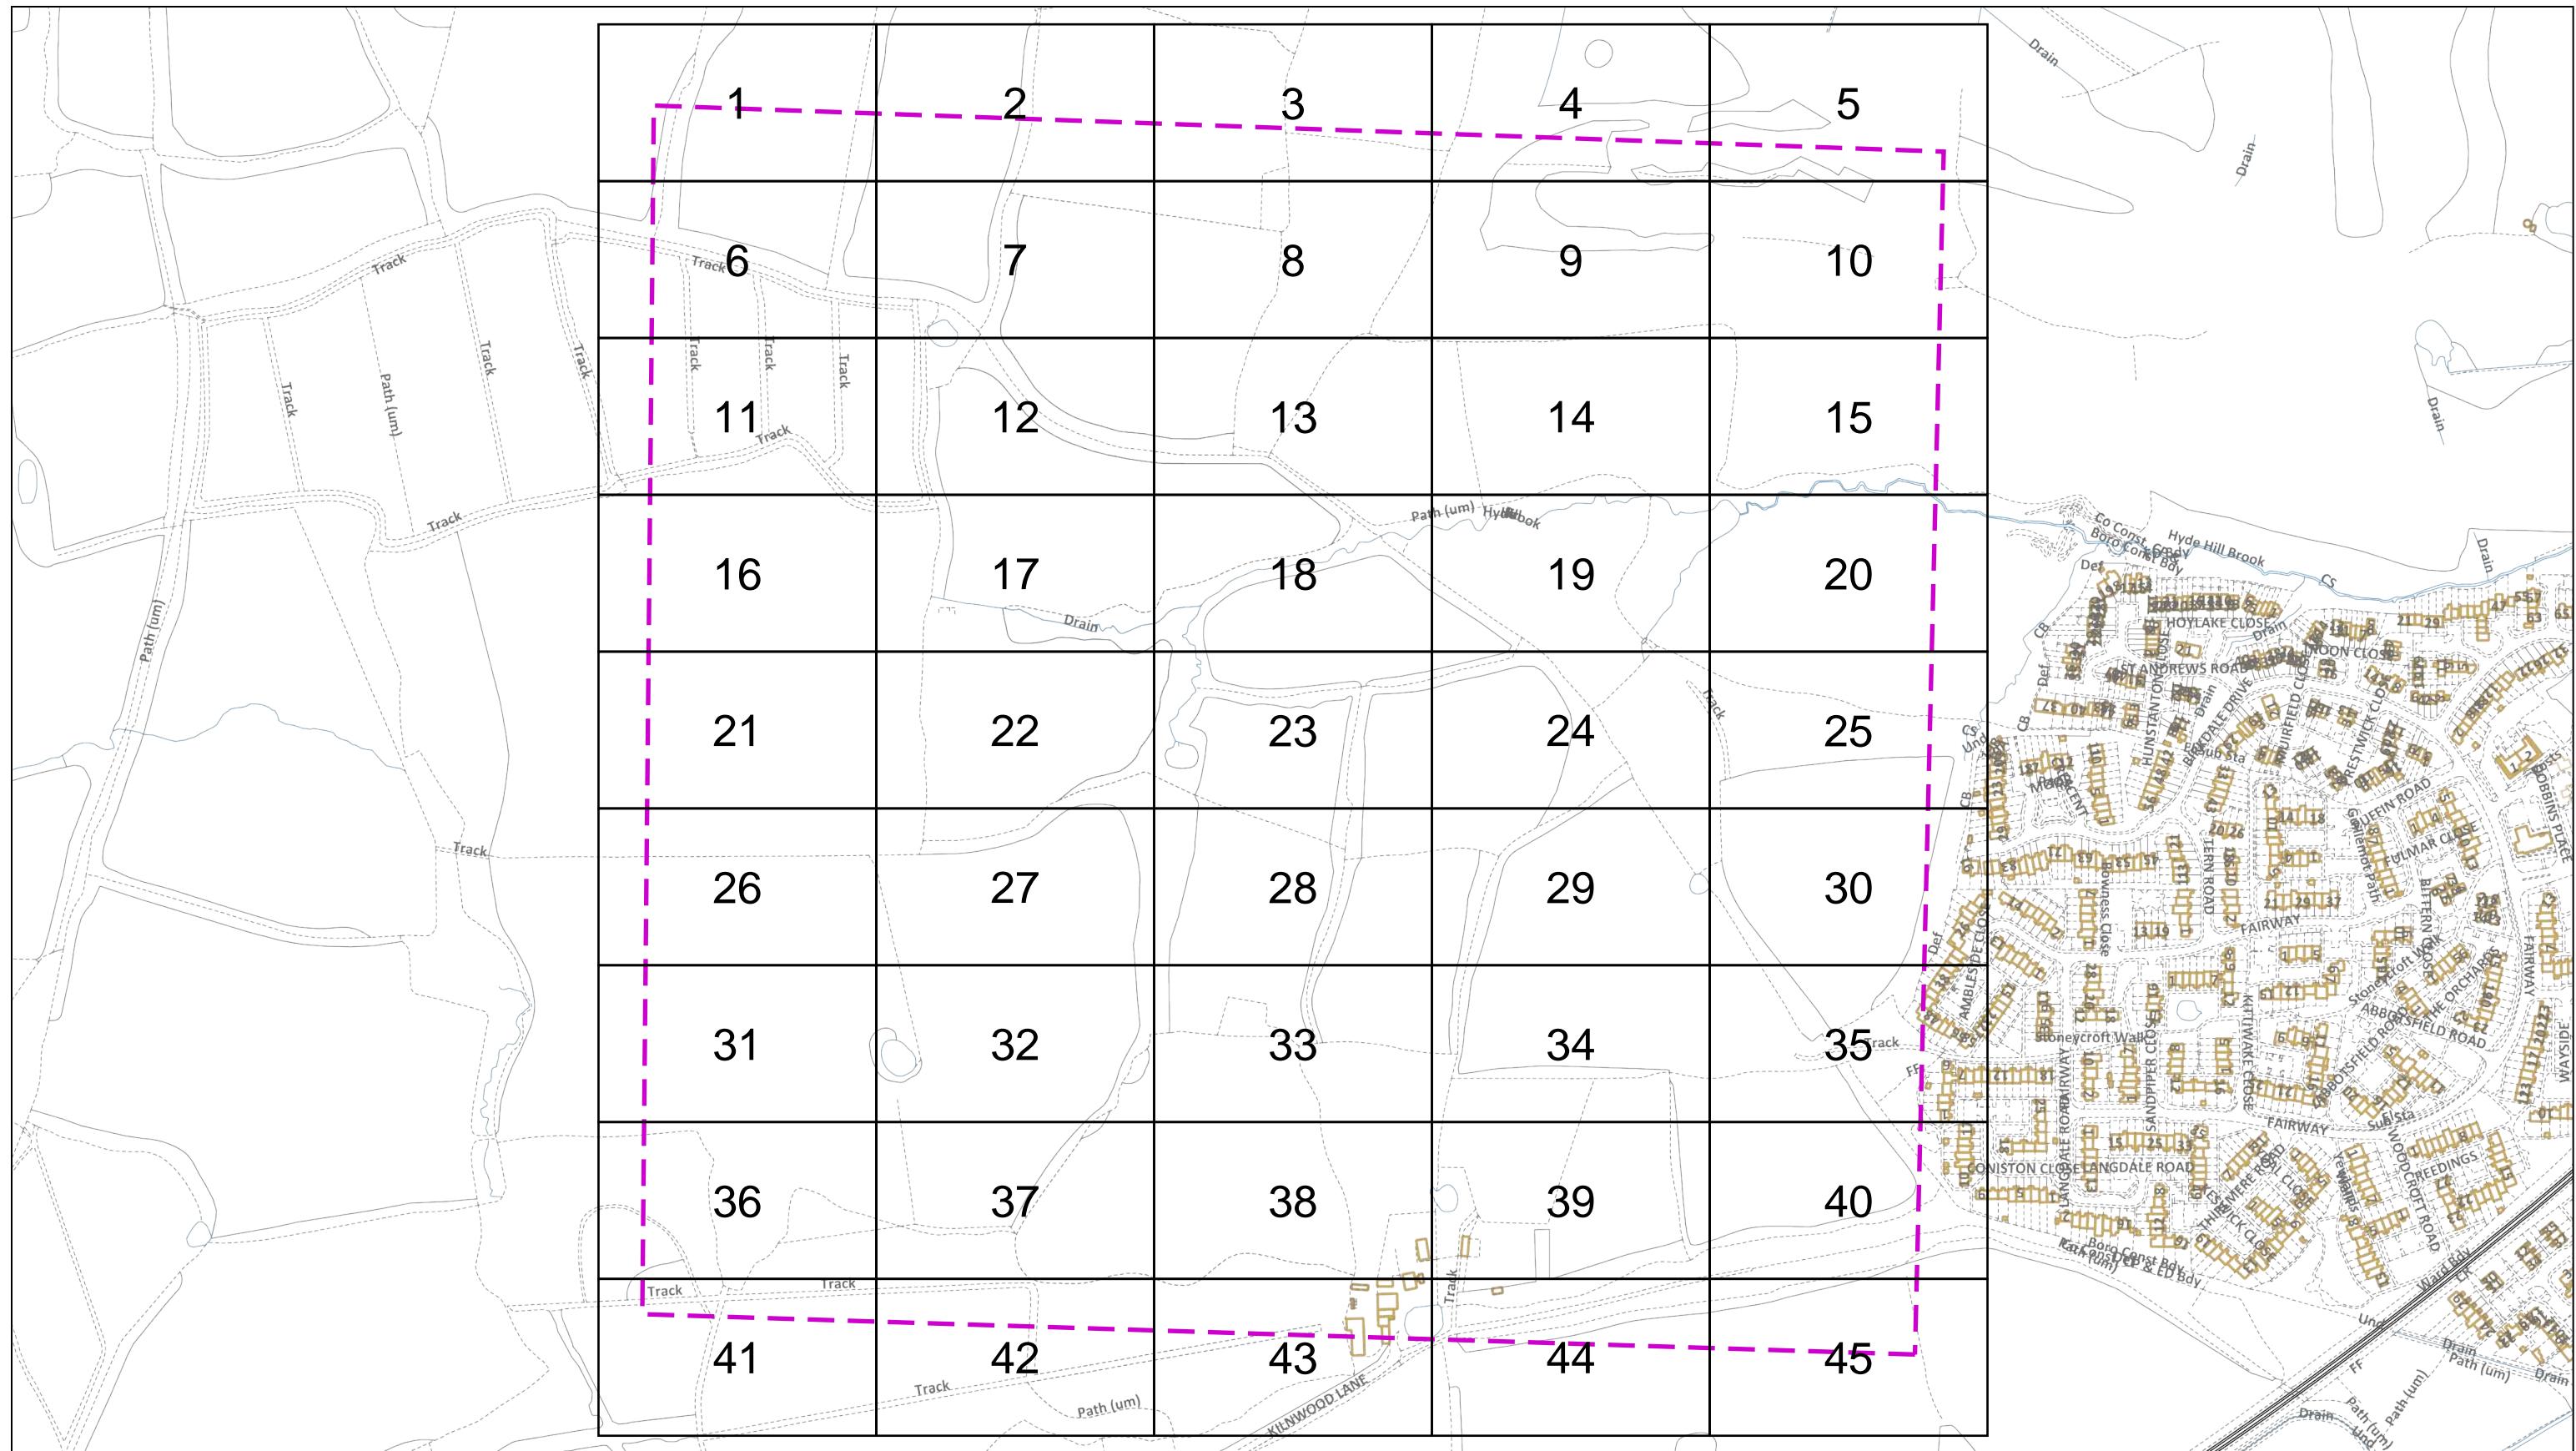

Dig Sites Area: Line:

The quality and accuracy of any print will depend on your printer, your computer and its print settings. Measurements scaled from this plan may not match measurements between the same points on the ground.

This plan must be used with the attached 'Symbols' document.

Date Requested: 12/12/2018
 Job Reference: 14403097
 Site Location: 522190 135538
 Requested by:
 Mr Gareth Adam
 Your Scheme/Reference: West of Ifield - 4 of 13
 Scale: 1:4613 (When plotted at A3)

- The position of the apparatus shown on this drawing is believed to be correct but the original landmarks may have been altered since the apparatus was installed.
- The exact position of the apparatus should be verified - use approved cable avoidance tools prior to excavation using suitable hand tools.
- It is essential that trial holes are carefully made avoiding the use of mechanical tools or picks until the exact location of all the cables have been determined.
- It must be assumed that there is a service cable into each property, lamp column and street sign, etc.
- All cables must be treated as being live unless proved otherwise by UK Power Networks.
- The information proved must be given to all people working near UK Power Networks plant and equipment. Do not use plans more than 3 months after the issue date for excavation purposes.
- Please be aware that electric cables/lines belonging to other owners of licensed electricity distribution systems may be present and it is your responsibility to identify their location.

- UK Power Networks does not warrant that the information provided to you is correct. You rely upon it at your own risk.
- UK Power Networks does not exclude or limit its liability if it causes the death of any persons or causes personal injury to a person.
- Subject to paragraph 2 UK Power Networks has no liability to you in contract, in tort (including negligence), for breach of statutory duty or otherwise for any loss, damage, cost, claims, demands, or expenses that you or any third party may suffer or incur as a result of using the information provided whether for physical damage to property or for any economic loss (including without limitation loss of profit, loss of opportunity, loss of savings, loss of goodwill, loss of business, loss of use) or any special or consequential loss or damage whatsoever.
- This plan has been provided to you on the basis of the terms of use set out in the covering letter that accompanies this plan. If you do not accept and/or do not understand the terms of use set out in the covering letter you must not use the plan and must return it to the sender of the letter.
- You are responsible for the security of the information provided to you. It must not be given, sold or made available upon payment of a fee to a third party.




IF IN DOUBT - ASK!
 PHONE 0800 056 5866
 EMERGENCY - If you
 damage a cable or line
 Phone 0800 783 8838
 (24hrs) URGENTLY



ALWAYS LOOK UP
 BEFORE
 YOU START WORK
 Refer to HSE
 Guidance note GS6

Maps produced at 1:2500 scale are Geo-Schematics which show LV mains cables and overhead lines (in some cases all voltages). Prior to carrying out excavations you must refer to the 1:500 records to determine the location of all known underground plant and equipment.

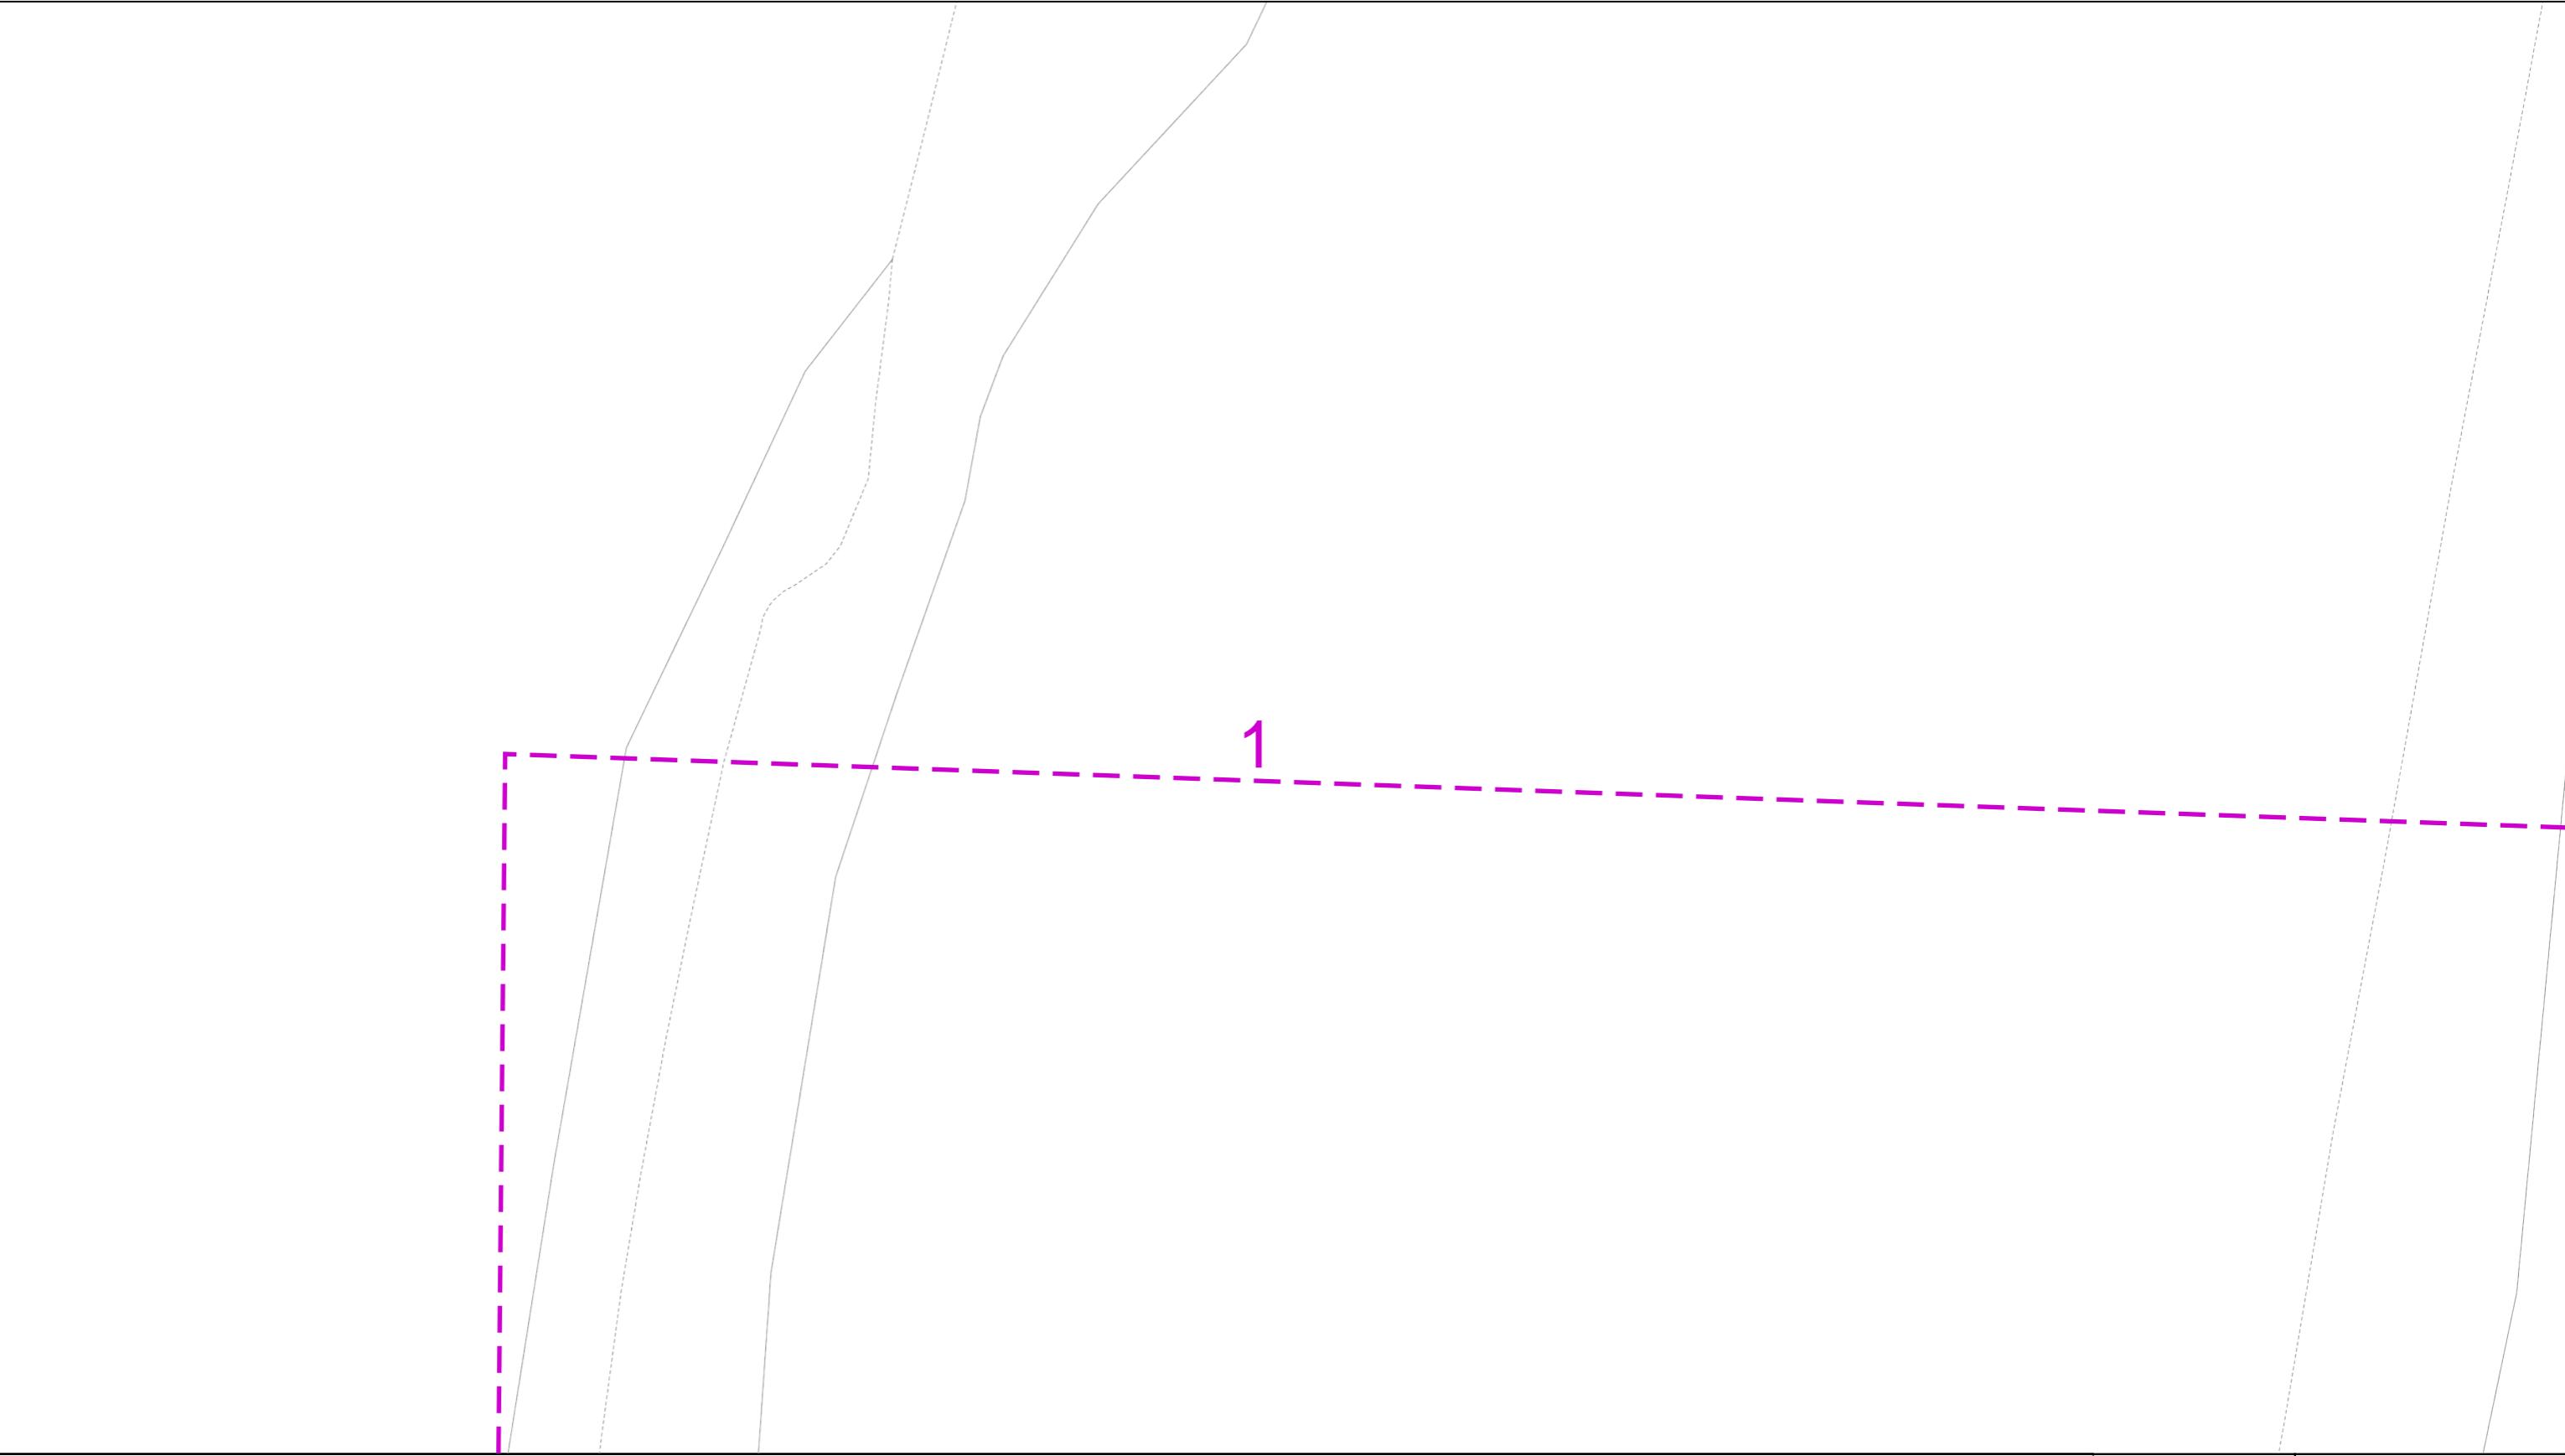

0 25 50
metres

Dig Sites Area:  Line: 

The quality and accuracy of any print will depend on your printer, your computer and its print settings. Measurements scaled from this plan may not match measurements between the same points on the ground.

This plan must be used with the attached 'Symbols' document.

Date Requested: 12/12/2018
Job Reference: 14403097
Site Location: 522190 135538
Requested by:
Mr Gareth Adam
Your Scheme/Reference: West of Ifield - 4 of 13

Scale: 1:500 (When plotted at A3)
Reproduced by permission of Ordnance Survey on behalf of HMSO. © Crown copyright and database rights 2018. All rights reserved. Ordnance Survey Licence numbers 100019626, 100019826 and 100019450. Data has been added to the Ordnance Survey base map; all proprietary rights in such additional data are and shall remain the exclusive property of © London Power Networks plc or Eastern Power Networks plc or South Eastern Power Networks plc each being a distribution licensee under section 6(1)(c) of the Electricity Act 1989 for the relevant distribution services area as that term is defined in such licensee's distribution licence. All rights in such data reserved.

Plans generated by DigSAFE Pro™ software provided by LinesearchbeforeUdig.

1. The position of the apparatus shown on this drawing is believed to be correct but the original landmarks may have been altered since the apparatus was installed.
2. The exact position of the apparatus should be verified - use approved cable avoidance tools prior to excavation using suitable hand tools.
3. It is essential that trial holes are carefully made avoiding the use of mechanical tools or picks until the exact location of all the cables have been determined.
4. It must be assumed that there is a service cable into each property, lamp column and street sign, etc.
5. All cables must be treated as being live unless proved otherwise by UK Power Networks.
6. The information proved must be given to all people working near UK Power Networks plant and equipment. Do not use plans more than 3 months after the issue date for excavation purposes.
7. Please be aware that electric cables/lines belonging to other owners of licensed electricity distribution systems may be present and it is your responsibility to identify their location.
1. UK Power Networks does not warrant that the information provided to you is correct. You rely upon it at your own risk.
2. UK Power Networks does not exclude or limit its liability if it causes the death of any persons or causes personal injury to a person.
3. Subject to paragraph 2 UK Power Networks has no liability to you in contract, in tort (including negligence), for breach of statutory duty or otherwise for any loss, damage, cost, claims, demands, or expenses that you or any third party may suffer or incur as a result of using the information provided whether for physical damage to property or for any economic loss (including without limitation loss of profit, loss of opportunity, loss of savings, loss of goodwill, loss of business, loss of use) or any special or consequential loss or damage whatsoever.
4. This plan has been provided to you on the basis of the terms of use set out in the covering letter that accompanies this plan. If you do not accept and/or do not understand the terms of use set out in the covering letter you must not use the plan and must return it to the sender of the letter.
5. You are responsible for the security of the information provided to you. It must not be given, sold or made available upon payment of a fee to a third party.

 



IF IN DOUBT - ASK!
PHONE 0800 056 5866
EMERGENCY - If you
damage a cable or line
Phone 0800 783 8838
(24hrs) URGENTLY



ALWAYS LOOK UP
BEFORE
YOU START WORK
Refer to HSE
Guidance note GS6


Maps produced at 1:2500 scale are Geo-Schematics which show LV mains cables and overhead lines (in some cases all voltages). Prior to carrying out excavations you must refer to the 1:500 records to determine the location of all known underground plant and equipment.


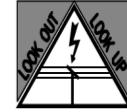
| 0 25 50 | | | Dig Sites | Area:  Line:  | The quality and accuracy of any print will depend on your printer, your computer and its print settings. Measurements scaled from this plan may not match measurements between the same points on the ground. | |  |  | | | | |
|--|---|--|-----------|---|---|--|---|---|--|--|--|--|
| This plan must be used with the attached 'Symbols' document. | 1. The position of the apparatus shown on this drawing is believed to be correct but the original landmarks may have been altered since the apparatus was installed. 2. The exact position of the apparatus should be verified - use approved cable avoidance tools prior to excavation using suitable hand tools. 3. It is essential that trial holes are carefully made avoiding the use of mechanical tools or picks until the exact location of all the cables have been determined. 4. It must be assumed that there is a service cable into each property, lamp column and street sign, etc. 5. All cables must be treated as being live unless proved otherwise by UK Power Networks. 6. The information proved must be given to all people working near UK Power Networks plant and equipment. Do not use plans more than 3 months after the issue date for excavation purposes. 7. Please be aware that electric cables/lines belonging to other owners of licensed electricity distribution systems may be present and it is your responsibility to identify their location. | | | | | | | | | | | |
| Date Requested: 12/12/2018 Job Reference: 14403097 Site Location: 522190 135538 Requested by: Mr Gareth Adam Your Scheme/Reference: West of Ifield - 4 of 13 Scale: 1:500 (When plotted at A3) | 1. UK Power Networks does not warrant that the information provided to you is correct. You rely upon it at your own risk. 2. UK Power Networks does not exclude or limit its liability if it causes the death of any persons or causes personal injury to a person. 3. Subject to paragraph 2 UK Power Networks has no liability to you in contract, in tort (including negligence), for breach of statutory duty or otherwise for any loss, damage, cost, claims, demands, or expenses that you or any third party may suffer or incur as a result of using the information provided whether for physical damage to property or for any economic loss (including without limitation loss of profit, loss of opportunity, loss of savings, loss of goodwill, loss of business, loss of use) or any special or consequential loss or damage whatsoever. 4. This plan has been provided to you on the basis of the terms of use set out in the covering letter that accompanies this plan. If you do not accept and/or do not understand the terms of use set out in the covering letter you must not use the plan and must return it to the sender of the letter. 5. You are responsible for the security of the information provided to you. It must not be given, sold or made available upon payment of a fee to a third party. | | | | | | | | | | | |
| | IF IN DOUBT - ASK! PHONE 0800 056 5866 EMERGENCY - If you damage a cable or line Phone 0800 783 8838 (24hrs) URGENTLY | | | | | | | | | | | |
| |  Maps produced at 1:2500 scale are Geo-Schematics which show LV mains cables and overhead lines (in some cases all voltages). Prior to carrying out excavations you must refer to the 1:500 records to determine the location of all known underground plant and equipment. | | | | | | | | | | | |

3

0 25 50
metres

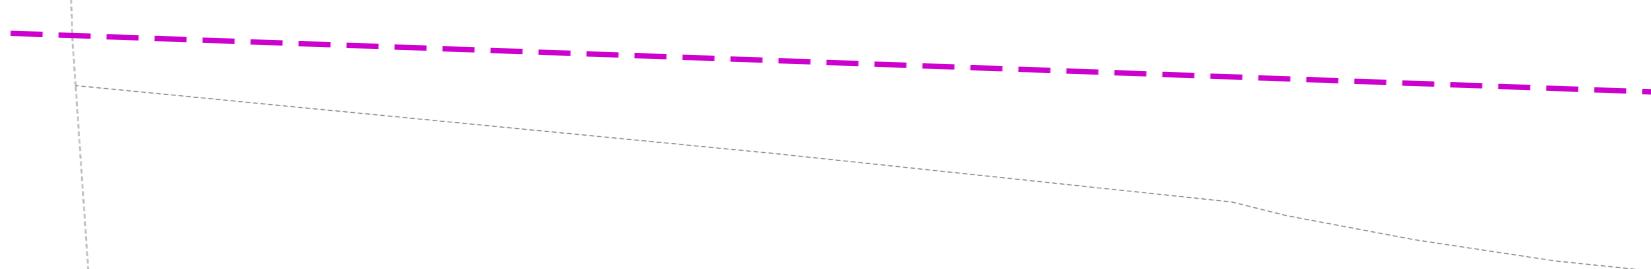Dig Sites Area:  Line: 

The quality and accuracy of any print will depend on your printer, your computer and its print settings. Measurements scaled from this plan may not match measurements between the same points on the ground.

This plan must be used with the attached 'Symbols' document.

1. The position of the apparatus shown on this drawing is believed to be correct but the original landmarks may have been altered since the apparatus was installed.
2. The exact position of the apparatus should be verified - use approved cable avoidance tools prior to excavation using suitable hand tools.
3. It is essential that trial holes are carefully made avoiding the use of mechanical tools or picks until the exact location of all the cables have been determined.
4. It must be assumed that there is a service cable into each property, lamp column and street sign, etc.
5. All cables must be treated as being live unless proved otherwise by UK Power Networks.
6. The information proved must be given to all people working near UK Power Networks plant and equipment. Do not use plans more than 3 months after the issue date for excavation purposes.
7. Please be aware that electric cables/lines belonging to other owners of licensed electricity distribution systems may be present and it is your responsibility to identify their location.

Date Requested: 12/12/2018
Job Reference: 14403097
Site Location: 522190 135538
Requested by:
Mr Gareth Adam
Your Scheme/Reference: West of Ifield - 4 of 13

Scale: 1:500 (When plotted at A3)

1. UK Power Networks does not warrant that the information provided to you is correct. You rely upon it at your own risk.
2. UK Power Networks does not exclude or limit its liability if it causes the death of any persons or causes personal injury to a person.
3. Subject to paragraph 2 UK Power Networks has no liability to you in contract, in tort (including negligence), for breach of statutory duty or otherwise for any loss, damage, cost, claims, demands, or expenses that you or any third party may suffer or incur as a result of using the information provided whether for physical damage to property or for any economic loss (including without limitation loss of profit, loss of opportunity, loss of savings, loss of goodwill, loss of business, loss of use) or any special or consequential loss or damage whatsoever.
4. This plan has been provided to you on the basis of the terms of use set out in the covering letter that accompanies this plan. If you do not accept and/or do not understand the terms of use set out in the covering letter you must not use the plan and must return it to the sender of the letter.
5. You are responsible for the security of the information provided to you. It must not be given, sold or made available upon payment of a fee to a third party.



IF IN DOUBT - ASK!
PHONE 0800 056 5866
EMERGENCY - If you
damage a cable or line
Phone 0800 783 8838
(24hrs) URGENTLY



ALWAYS LOOK UP
BEFORE
YOU START WORK
Refer to HSE
Guidance note GS6

Maps produced at 1:2500 scale are Geo-Schematics which show LV mains cables and overhead lines (in some cases all voltages). Prior to carrying out excavations you must refer to the 1:500 records to determine the location of all known underground plant and equipment.

This plan must be used with the attached 'Symbols' document.


Requested: 12/12/2018
Reference: 14403097
Location: 522190 135538
Requested by:

Gareth Adam
Scheme/Reference: West of
- 4 of 13
• 1:500 (When plotted at A2)

duced by permission of Ordnance Survey on behalf of HMSO. © Crown copyright and database rights 2018. All rights reserved. Ordnance Survey Licence numbers 100019626, 100019826 and 100019450. Data has been added to the Ordnance Survey base map; all proprietary rights in such additional data are and shall remain the exclusive property of © London Power Networks plc or Eastern Power Networks plc or South Eastern Power Networks plc each being a distribution licensee under section 6(1)(c) of the Electricity Act 1989 for the relevant distribution services area as that term is defined in such licensee's distribution licence. All rights in such data reserved.

Plans generated by DigSAFE Pro™ software provided by LinesearchbeforeUdig.

5

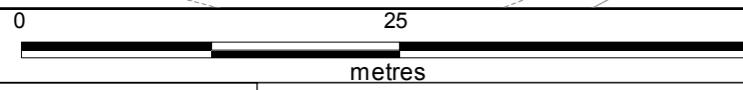

Dig Sites Area:  Line: 

The quality and accuracy of any print will depend on your printer, your computer and its print settings. Measurements scaled from this plan may not match measurements between the same points on the ground.

This plan must be used with the attached 'Symbols' document.

Date Requested: 12/12/2018
Job Reference: 14403097
Site Location: 522190 135538
Requested by:
Mr Gareth Adam
Your Scheme/Reference: West of Ifield - 4 of 13
Scale: 1:500 (When plotted at A3)

1. The position of the apparatus shown on this drawing is believed to be correct but the original landmarks may have been altered since the apparatus was installed.
2. The exact position of the apparatus should be verified - use approved cable avoidance tools prior to excavation using suitable hand tools.
3. It is essential that trial holes are carefully made avoiding the use of mechanical tools or picks until the exact location of all the cables have been determined.
4. It must be assumed that there is a service cable into each property, lamp column and street sign, etc.
5. All cables must be treated as being live unless proved otherwise by UK Power Networks.
6. The information proved must be given to all people working near UK Power Networks plant and equipment. Do not use plans more than 3 months after the issue date for excavation purposes.
7. Please be aware that electric cables/lines belonging to other owners of licensed electricity distribution systems may be present and it is your responsibility to identify their location.

1. UK Power Networks does not warrant that the information provided to you is correct. You rely upon it at your own risk.
2. UK Power Networks does not exclude or limit its liability if it causes the death of any persons or causes personal injury to a person.
3. Subject to paragraph 2 UK Power Networks has no liability to you in contract, in tort (including negligence), for breach of statutory duty or otherwise for any loss, damage, cost, claims, demands, or expenses that you or any third party may suffer or incur as a result of using the information provided whether for physical damage to property or for any economic loss (including without limitation loss of profit, loss of opportunity, loss of savings, loss of goodwill, loss of business, loss of use) or any special or consequential loss or damage whatsoever.
4. This plan has been provided to you on the basis of the terms of use set out in the covering letter that accompanies this plan. If you do not accept and/or do not understand the terms of use set out in the covering letter you must not use the plan and must return it to the sender of the letter.
5. You are responsible for the security of the information provided to you. It must not be given, sold or made available upon payment of a fee to a third party.




IF IN DOUBT - ASK!
PHONE 0800 056 5866
EMERGENCY - If you
damage a cable or line
Phone 0800 783 8838
(24hrs) URGENTLY



ALWAYS LOOK UP
BEFORE
YOU START WORK
Refer to HSE
Guidance note GS6

Maps produced at 1:2500 scale are Geo-Schematics which show LV mains cables and overhead lines (in some cases all voltages). Prior to carrying out excavations you must refer to the 1:500 records to determine the location of all known underground plant and equipment.

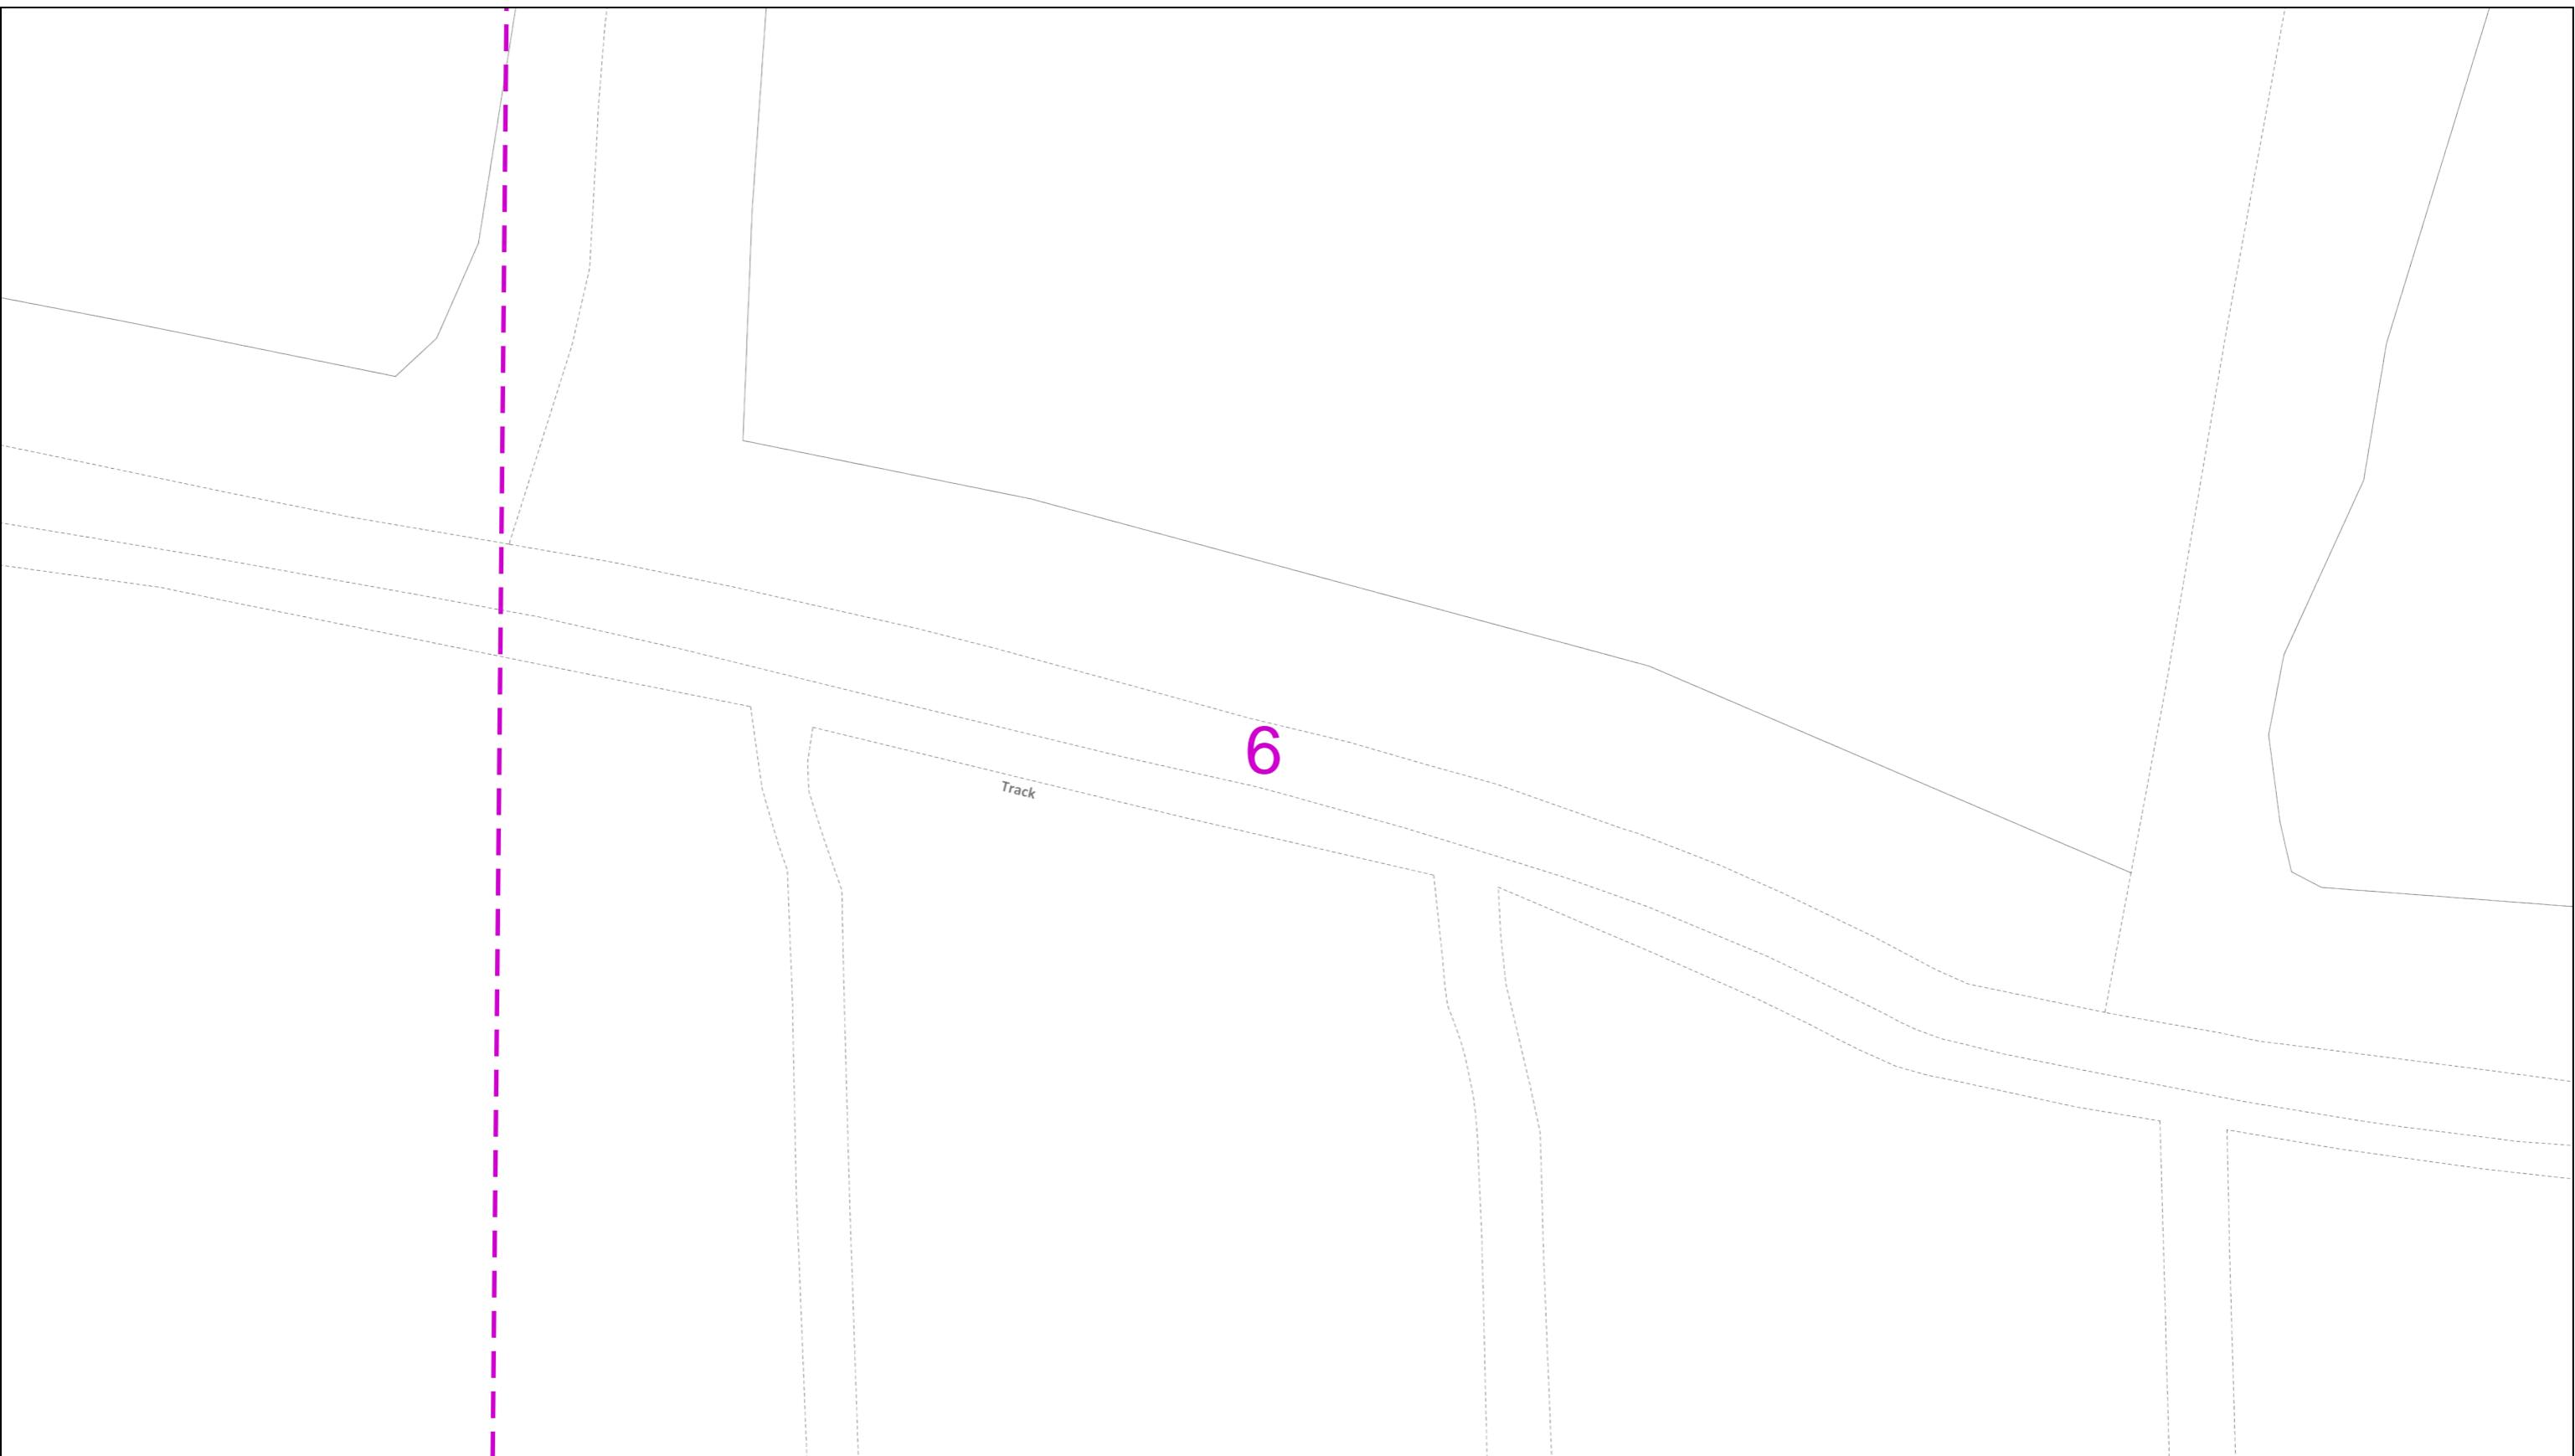

0 25 50
metres

Dig Sites Area: Line:

The quality and accuracy of any print will depend on your printer, your computer and its print settings. Measurements scaled from this plan may not match measurements between the same points on the ground.

This plan must be used with the attached 'Symbols' document.

Date Requested: 12/12/2018
Job Reference: 14403097
Site Location: 522190 135538
Requested by:
Mr Gareth Adam
Your Scheme/Reference: West of Ifield - 4 of 13
Scale: 1:500 (When plotted at A3)

1. The position of the apparatus shown on this drawing is believed to be correct but the original landmarks may have been altered since the apparatus was installed.
2. The exact position of the apparatus should be verified - use approved cable avoidance tools prior to excavation using suitable hand tools.
3. It is essential that trial holes are carefully made avoiding the use of mechanical tools or picks until the exact location of all the cables have been determined.
4. It must be assumed that there is a service cable into each property, lamp column and street sign, etc.
5. All cables must be treated as being live unless proved otherwise by UK Power Networks.
6. The information proved must be given to all people working near UK Power Networks plant and equipment. Do not use plans more than 3 months after the issue date for excavation purposes.
7. Please be aware that electric cables/lines belonging to other owners of licensed electricity distribution systems may be present and it is your responsibility to identify their location.

1. UK Power Networks does not warrant that the information provided to you is correct. You rely upon it at your own risk.
2. UK Power Networks does not exclude or limit its liability if it causes the death of any persons or causes personal injury to a person.
3. Subject to paragraph 2 UK Power Networks has no liability to you in contract, in tort (including negligence), for breach of statutory duty or otherwise for any loss, damage, cost, claims, demands, or expenses that you or any third party may suffer or incur as a result of using the information provided whether for physical damage to property or for any economic loss (including without limitation loss of profit, loss of opportunity, loss of savings, loss of goodwill, loss of business, loss of use) or any special or consequential loss or damage whatsoever.
4. This plan has been provided to you on the basis of the terms of use set out in the covering letter that accompanies this plan. If you do not accept and/or do not understand the terms of use set out in the covering letter you must not use the plan and must return it to the sender of the letter.
5. You are responsible for the security of the information provided to you. It must not be given, sold or made available upon payment of a fee to a third party.




IF IN DOUBT - ASK!
PHONE 0800 056 5866
EMERGENCY - If you
damage a cable or line
Phone 0800 783 8838
(24hrs) URGENTLY




ALWAYS LOOK UP
BEFORE
YOU START WORK
Refer to HSE
Guidance note GS6

Maps produced at 1:2500 scale are Geo-Schematics which show LV mains cables and overhead lines (in some cases all voltages). Prior to carrying out excavations you must refer to the 1:500 records to determine the location of all known underground plant and equipment.

7

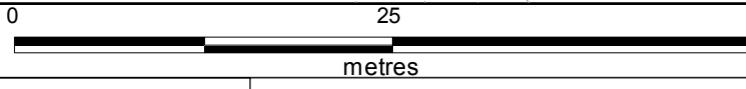

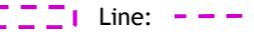Dig Sites Area:  Line: 

The quality and accuracy of any print will depend on your printer, your computer and its print settings. Measurements scaled from this plan may not match measurements between the same points on the ground.

This plan must be used with the attached 'Symbols' document.

1. The position of the apparatus shown on this drawing is believed to be correct but the original landmarks may have been altered since the apparatus was installed.
2. The exact position of the apparatus should be verified - use approved cable avoidance tools prior to excavation using suitable hand tools.
3. It is essential that trial holes are carefully made avoiding the use of mechanical tools or picks until the exact location of all the cables have been determined.
4. It must be assumed that there is a service cable into each property, lamp column and street sign, etc.
5. All cables must be treated as being live unless proved otherwise by UK Power Networks.
6. The information proved must be given to all people working near UK Power Networks plant and equipment. Do not use plans more than 3 months after the issue date for excavation purposes.
7. Please be aware that electric cables/lines belonging to other owners of licensed electricity distribution systems may be present and it is your responsibility to identify their location.

Date Requested: 12/12/2018
Job Reference: 14403097
Site Location: 522190 135538
Requested by:
Mr Gareth Adam
Your Scheme/Reference: West of Ifield - 4 of 13

Scale: 1:500 (When plotted at A3)

1. UK Power Networks does not warrant that the information provided to you is correct. You rely upon it at your own risk.
2. UK Power Networks does not exclude or limit its liability if it causes the death of any persons or causes personal injury to a person.
3. Subject to paragraph 2 UK Power Networks has no liability to you in contract, in tort (including negligence), for breach of statutory duty or otherwise for any loss, damage, cost, claims, demands, or expenses that you or any third party may suffer or incur as a result of using the information provided whether for physical damage to property or for any economic loss (including without limitation loss of profit, loss of opportunity, loss of savings, loss of goodwill, loss of business, loss of use) or any special or consequential loss or damage whatsoever.
4. This plan has been provided to you on the basis of the terms of use set out in the covering letter that accompanies this plan. If you do not accept and/or do not understand the terms of use set out in the covering letter you must not use the plan and must return it to the sender of the letter.
5. You are responsible for the security of the information provided to you. It must not be given, sold or made available upon payment of a fee to a third party.





IF IN DOUBT - ASK!
PHONE 0800 056 5866
EMERGENCY - If you
damage a cable or line
Phone 0800 783 8838
(24hrs) URGENTLY



ALWAYS LOOK UP
BEFORE
YOU START WORK
Refer to HSE
Guidance note GS6

Maps produced at 1:2500 scale are Geo-Schematics which show LV mains cables and overhead lines (in some cases all voltages). Prior to carrying out excavations you must refer to the 1:500 records to determine the location of all known underground plant and equipment.

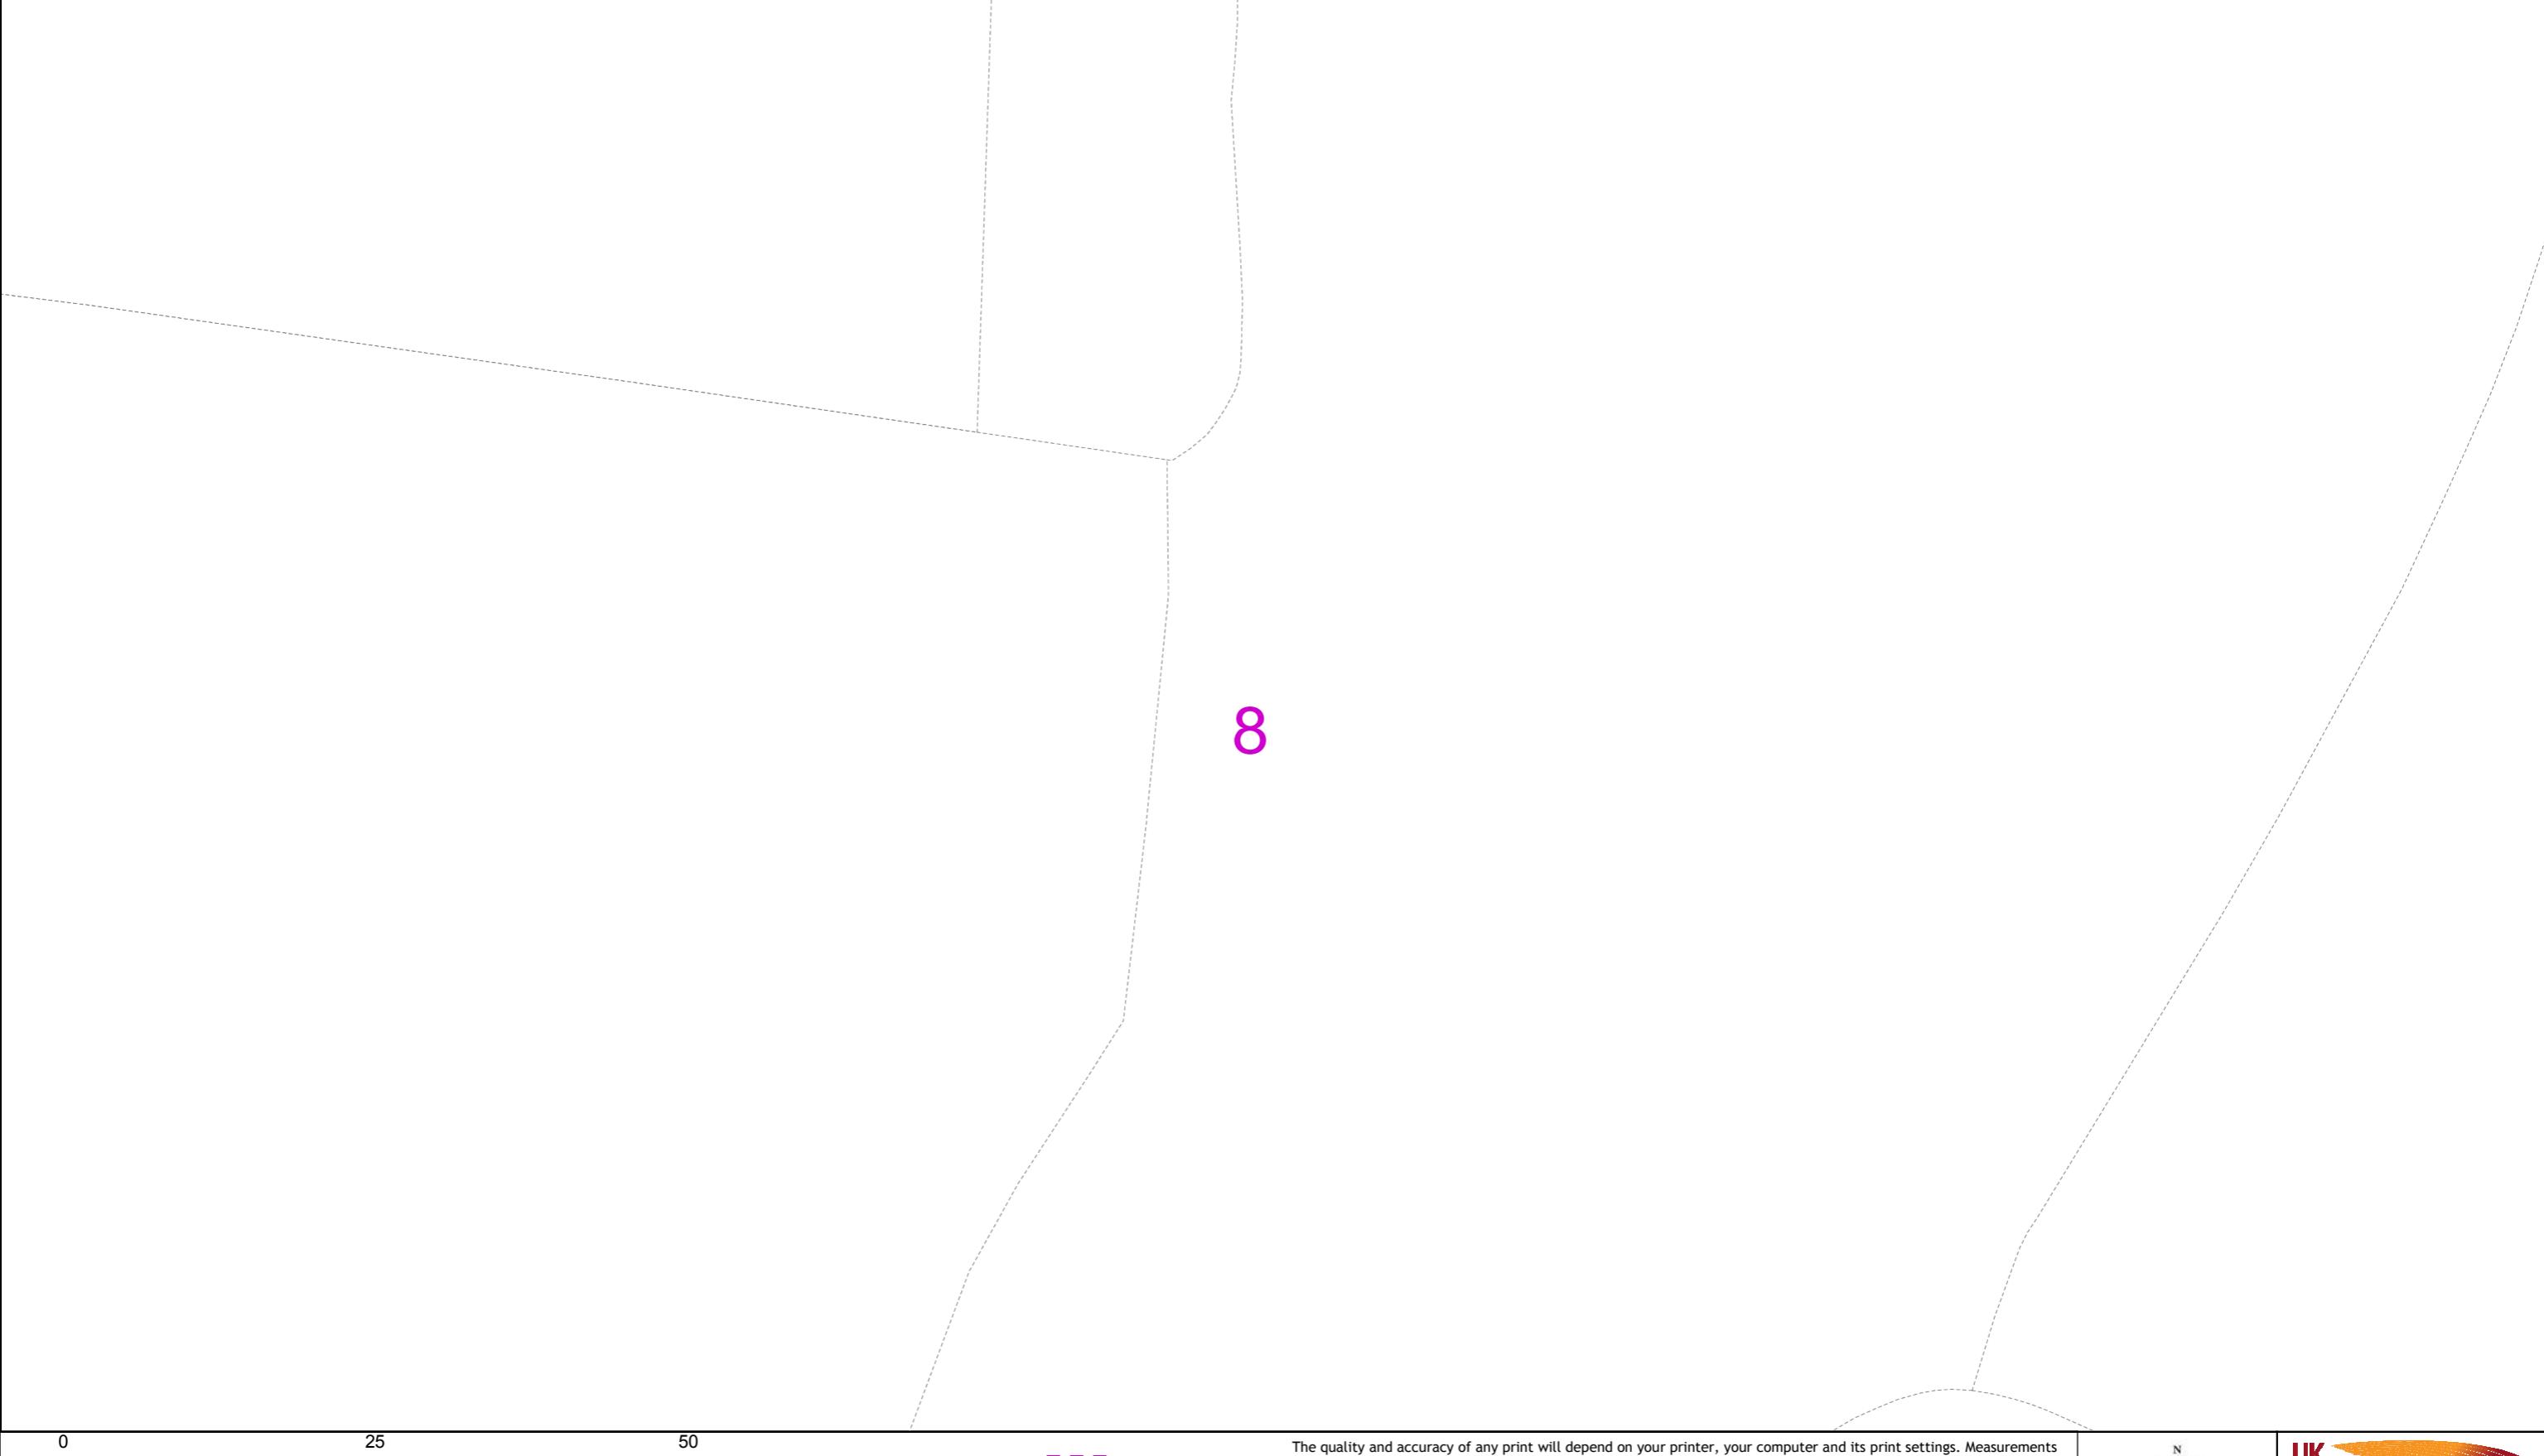

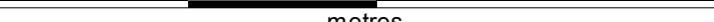0 25 50
 metres

Dig Sites Area:  Line: 

The quality and accuracy of any print will depend on your printer, your computer and its print settings. Measurements scaled from this plan may not match measurements between the same points on the ground.

This plan must be used with the attached 'Symbols' document.

1. The position of the apparatus shown on this drawing is believed to be correct but the original landmarks may have been altered since the apparatus was installed.
 2. The exact position of the apparatus should be verified - use approved cable avoidance tools prior to excavation using suitable hand tools.
 3. It is essential that trial holes are carefully made avoiding the use of mechanical tools or picks until the exact location of all the cables have been determined.
 4. It must be assumed that there is a service cable into each property, lamp column and street sign, etc.
 5. All cables must be treated as being live unless proved otherwise by UK Power Networks.
 6. The information proved must be given to all people working near UK Power Networks plant and equipment. Do not use plans more than 3 months after the issue date for excavation purposes.
 7. Please be aware that electric cables/lines belonging to other owners of licensed electricity distribution systems may be present and it is your responsibility to identify their location.

Date Requested: 12/12/2018
 Job Reference: 14403097
 Site Location: 522190 135538
 Requested by:
 Mr Gareth Adam
 Your Scheme/Reference: West of Ifield - 4 of 13

Scale: 1:500 (When plotted at A3)

1. UK Power Networks does not warrant that the information provided to you is correct. You rely upon it at your own risk.
 2. UK Power Networks does not exclude or limit its liability if it causes the death of any persons or causes personal injury to a person.
 3. Subject to paragraph 2 UK Power Networks has no liability to you in contract, in tort (including negligence), for breach of statutory duty or otherwise for any loss, damage, cost, claims, demands, or expenses that you or any third party may suffer or incur as a result of using the information provided whether for physical damage to property or for any economic loss (including without limitation loss of profit, loss of opportunity, loss of savings, loss of goodwill, loss of business, loss of use) or any special or consequential loss or damage whatsoever.
 4. This plan has been provided to you on the basis of the terms of use set out in the covering letter that accompanies this plan. If you do not accept and/or do not understand the terms of use set out in the covering letter you must not use the plan and must return it to the sender of the letter.
 5. You are responsible for the security of the information provided to you. It must not be given, sold or made available upon payment of a fee to a third party.



IF IN DOUBT - ASK!
 PHONE 0800 056 5866
 EMERGENCY - If you
 damage a cable or line
 Phone 0800 783 8838
 (24hrs) URGENTLY



ALWAYS LOOK UP
 BEFORE
 YOU START WORK
 Refer to HSE
 Guidance note GS6

Maps produced at 1:2500 scale are Geo-Schematics which show LV mains cables and overhead lines (in some cases all voltages). Prior to carrying out excavations you must refer to the 1:500 records to determine the location of all known underground plant and equipment.

9

Dig Sites Area: Line:

The quality and accuracy of any print will depend on your printer, your computer and its print settings. Measurements scaled from this plan may not match measurements between the same points on the ground.

A compass rose with four main points: North (N), South (S), East (E), and West (W). The North point is at the top, with South at the bottom, East on the right, and West on the left. The rose is divided into eight equal sectors by faint lines.



UK
Power
Networks

This plan must be used with the attached 'Symbols' document.

1. The position of the apparatus shown on this drawing is believed to be correct but the original landmarks may have been altered since the apparatus was installed.
2. The exact position of the apparatus should be verified - use approved cable avoidance tools prior to excavation using suitable hand tools.
3. It is essential that trial holes are carefully made avoiding the use of mechanical tools or picks until the exact location of all the cables have been determined.
4. It must be assumed that there is a service cable into each property, lamp column and street sign, etc.
5. All cables must be treated as being live unless proved otherwise by UK Power Networks.
6. The information proved must be given to all people working near UK Power Networks plant and equipment. Do not use plans more than 3 months after the issue date for excavation purposes.
7. Please be aware that electric cables/lines belonging to other owners of licensed electricity distribution systems may be present and it is your responsibility to identify their location.

1. UK Power Networks does not warrant that the information provided to you is correct. You rely upon it at your own risk.
2. UK Power Networks does not exclude or limit its liability if it causes the death of any persons or causes personal injury to a person.
3. Subject to paragraph 2 UK Power Networks has no liability to you in contract, in tort (including negligence), for breach of statutory duty or otherwise for any loss, damage, cost, claims, demands, or expenses that you or any third party may suffer or incur as a result of using the information provided whether for physical damage to property or for any economic loss (including without limitation loss of profit, loss of opportunity, loss of savings, loss of goodwill, loss of business, loss of use) or any special or consequential loss or damage whatsoever.
4. This plan has been provided to you on the basis of the terms of use set out in the covering letter that accompanies this plan. If you do not accept and/or do not understand the terms of use set out in the covering letter you must not use the plan and must return it to the sender of the letter.
5. You are responsible for the security of the information provided to you. It must not be given, sold or made available upon payment of a fee to a third party.

IF IN DOUBT - ASK!
PHONE 0800 056 5866
EMERGENCY - If you
damage a cable or line
Phone 0800 783 8838

ALWAYS LOOK UP
BEFORE
YOU START WORK
Refer to HSE

Maps produced at 1:2500 scale are Geo-Schematics which show LV mains cables and overhead lines (in some cases all voltages). Prior to carrying out excavations you must refer to the 1:500 records to determine the location of all known underground plant and equipment.

0 25 50
metres

Dig Sites Area:  Line: 

The quality and accuracy of any print will depend on your printer, your computer and its print settings. Measurements scaled from this plan may not match measurements between the same points on the ground.

This plan must be used with the attached 'Symbols' document.

1. The position of the apparatus shown on this drawing is believed to be correct but the original landmarks may have been altered since the apparatus was installed.
2. The exact position of the apparatus should be verified - use approved cable avoidance tools prior to excavation using suitable hand tools.
3. It is essential that trial holes are carefully made avoiding the use of mechanical tools or picks until the exact location of all the cables have been determined.
4. It must be assumed that there is a service cable into each property, lamp column and street sign, etc.
5. All cables must be treated as being live unless proved otherwise by UK Power Networks.
6. The information proved must be given to all people working near UK Power Networks plant and equipment. Do not use plans more than 3 months after the issue date for excavation purposes.
7. Please be aware that electric cables/lines belonging to other owners of licensed electricity distribution systems may be present and it is your responsibility to identify their location.

Date Requested: 12/12/2018
Job Reference: 14403097
Site Location: 522190 135538
Requested by:
Mr Gareth Adam
Your Scheme/Reference: West of Ifield - 4 of 13

Scale: 1:500 (When plotted at A3)

1. UK Power Networks does not warrant that the information provided to you is correct. You rely upon it at your own risk.
2. UK Power Networks does not exclude or limit its liability if it causes the death of any persons or causes personal injury to a person.
3. Subject to paragraph 2 UK Power Networks has no liability to you in contract, in tort (including negligence), for breach of statutory duty or otherwise for any loss, damage, cost, claims, demands, or expenses that you or any third party may suffer or incur as a result of using the information provided whether for physical damage to property or for any economic loss (including without limitation loss of profit, loss of opportunity, loss of savings, loss of goodwill, loss of business, loss of use) or any special or consequential loss or damage whatsoever.
4. This plan has been provided to you on the basis of the terms of use set out in the covering letter that accompanies this plan. If you do not accept and/or do not understand the terms of use set out in the covering letter you must not use the plan and must return it to the sender of the letter.
5. You are responsible for the security of the information provided to you. It must not be given, sold or made available upon payment of a fee to a third party.




IF IN DOUBT - ASK!
PHONE 0800 056 5866
EMERGENCY - If you
damage a cable or line
Phone 0800 783 8838
(24hrs) URGENTLY



ALWAYS LOOK UP
BEFORE
YOU START WORK
Refer to HSE
Guidance note GS6

Maps produced at 1:2500 scale are Geo-Schematics which show LV mains cables and overhead lines (in some cases all voltages). Prior to carrying out excavations you must refer to the 1:500 records to determine the location of all known underground plant and equipment.

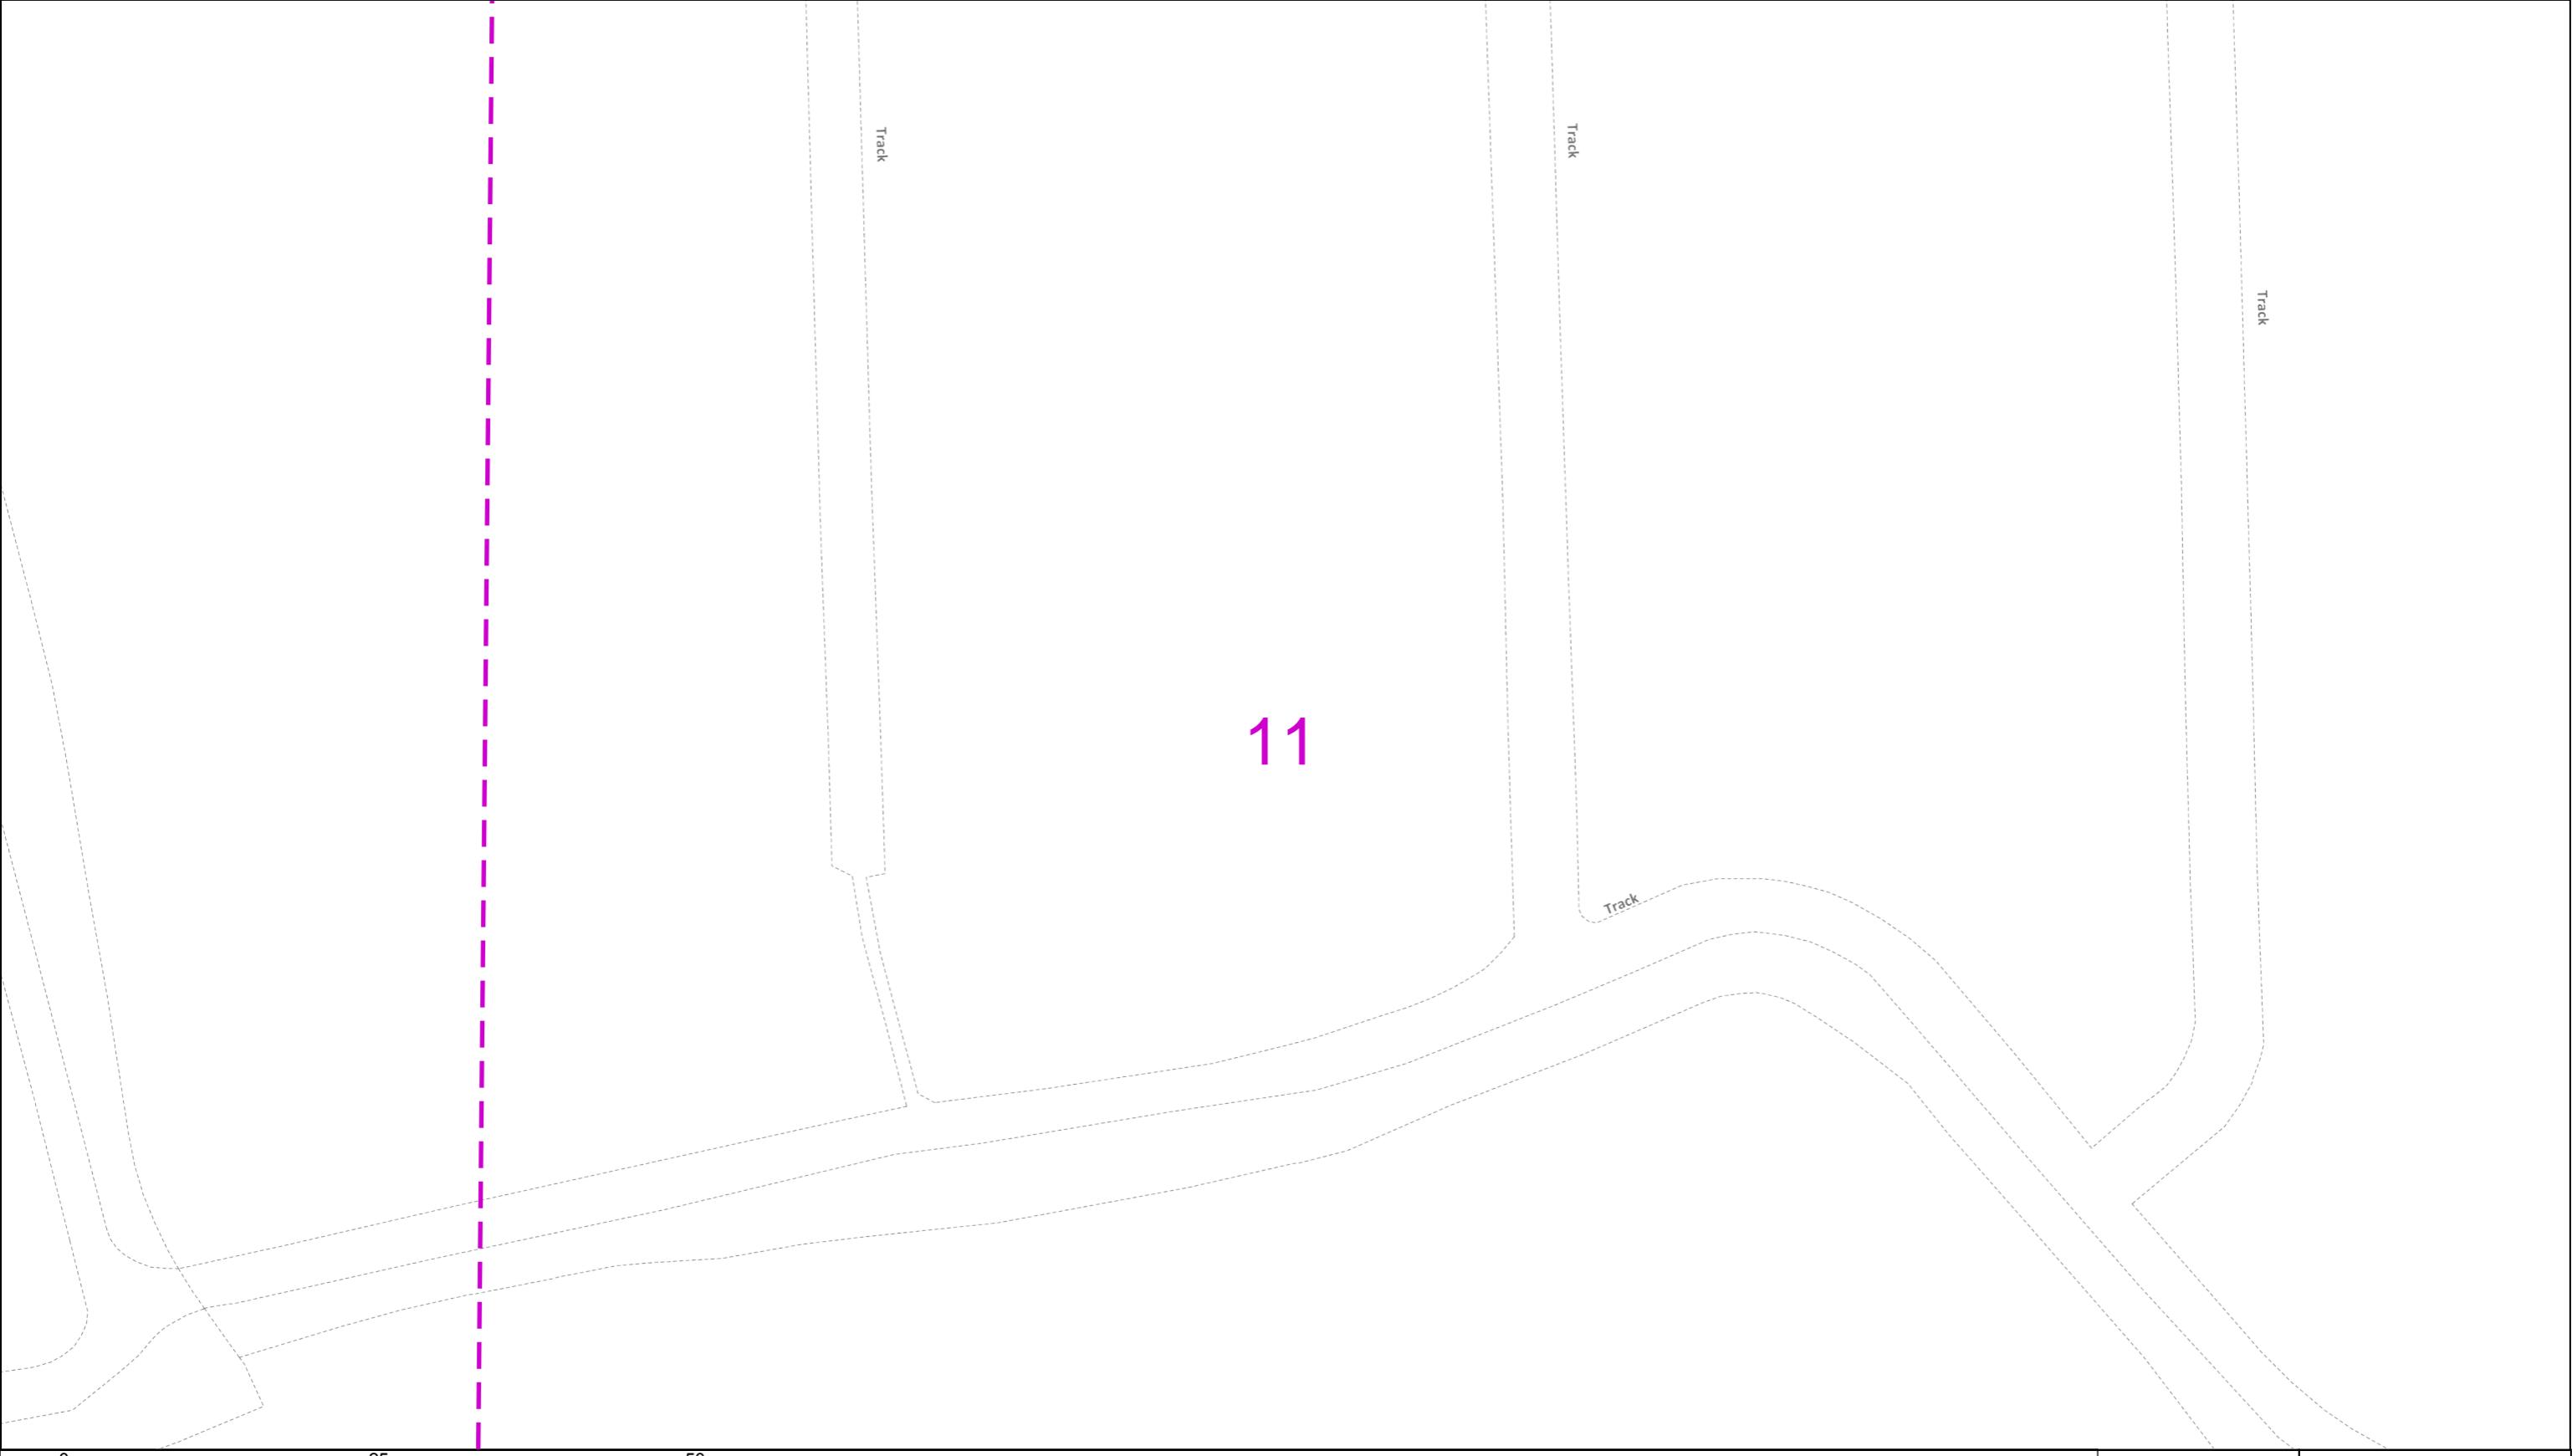

0 25 50
metres

Dig Sites Area:  Line: 

The quality and accuracy of any print will depend on your printer, your computer and its print settings. Measurements scaled from this plan may not match measurements between the same points on the ground.

This plan must be used with the attached 'Symbols' document.

Date Requested: 12/12/2018
Job Reference: 14403097
Site Location: 522190 135538
Requested by:
Mr Gareth Adam
Your Scheme/Reference: West of Ifield - 4 of 13
Scale: 1:500 (When plotted at A3)

1. The position of the apparatus shown on this drawing is believed to be correct but the original landmarks may have been altered since the apparatus was installed.
2. The exact position of the apparatus should be verified - use approved cable avoidance tools prior to excavation using suitable hand tools.
3. It is essential that trial holes are carefully made avoiding the use of mechanical tools or picks until the exact location of all the cables have been determined.
4. It must be assumed that there is a service cable into each property, lamp column and street sign, etc.
5. All cables must be treated as being live unless proved otherwise by UK Power Networks.
6. The information proved must be given to all people working near UK Power Networks plant and equipment. Do not use plans more than 3 months after the issue date for excavation purposes.
7. Please be aware that electric cables/lines belonging to other owners of licensed electricity distribution systems may be present and it is your responsibility to identify their location.

1. UK Power Networks does not warrant that the information provided to you is correct. You rely upon it at your own risk.
2. UK Power Networks does not exclude or limit its liability if it causes the death of any persons or causes personal injury to a person.
3. Subject to paragraph 2 UK Power Networks has no liability to you in contract, in tort (including negligence), for breach of statutory duty or otherwise for any loss, damage, cost, claims, demands, or expenses that you or any third party may suffer or incur as a result of using the information provided whether for physical damage to property or for any economic loss (including without limitation loss of profit, loss of opportunity, loss of savings, loss of goodwill, loss of business, loss of use) or any special or consequential loss or damage whatsoever.
4. This plan has been provided to you on the basis of the terms of use set out in the covering letter that accompanies this plan. If you do not accept and/or do not understand the terms of use set out in the covering letter you must not use the plan and must return it to the sender of the letter.
5. You are responsible for the security of the information provided to you. It must not be given, sold or made available upon payment of a fee to a third party.



IF IN DOUBT - ASK!
PHONE 0800 056 5866
EMERGENCY - If you
damage a cable or line
Phone 0800 783 8838
(24hrs) URGENTLY



ALWAYS LOOK UP
BEFORE
YOU START WORK
Refer to HSE
Guidance note GS6

Maps produced at 1:2500 scale are Geo-Schematics which show LV mains cables and overhead lines (in some cases all voltages). Prior to carrying out excavations you must refer to the 1:500 records to determine the location of all known underground plant and equipment.

12

0 25 50
metres

Dig Sites Area:  Line: 

The quality and accuracy of any print will depend on your printer, your computer and its print settings. Measurements scaled from this plan may not match measurements between the same points on the ground.

This plan must be used with the attached 'Symbols' document.

1. The position of the apparatus shown on this drawing is believed to be correct but the original landmarks may have been altered since the apparatus was installed.
2. The exact position of the apparatus should be verified - use approved cable avoidance tools prior to excavation using suitable hand tools.
3. It is essential that trial holes are carefully made avoiding the use of mechanical tools or picks until the exact location of all the cables have been determined.
4. It must be assumed that there is a service cable into each property, lamp column and street sign, etc.
5. All cables must be treated as being live unless proved otherwise by UK Power Networks.
6. The information proved must be given to all people working near UK Power Networks plant and equipment. Do not use plans more than 3 months after the issue date for excavation purposes.
7. Please be aware that electric cables/lines belonging to other owners of licensed electricity distribution systems may be present and it is your responsibility to identify their location.


Date Requested: 12/12/2018
Job Reference: 14403097
Site Location: 522190 135538
Requested by:
Mr Gareth Adam
Your Scheme/Reference: West of Ifield - 4 of 13

Scale: 1:500 (When plotted at A3)

1. UK Power Networks does not warrant that the information provided to you is correct. You rely upon it at your own risk.
2. UK Power Networks does not exclude or limit its liability if it causes the death of any persons or causes personal injury to a person.
3. Subject to paragraph 2 UK Power Networks has no liability to you in contract, in tort (including negligence), for breach of statutory duty or otherwise for any loss, damage, cost, claims, demands, or expenses that you or any third party may suffer or incur as a result of using the information provided whether for physical damage to property or for any economic loss (including without limitation loss of profit, loss of opportunity, loss of savings, loss of goodwill, loss of business, loss of use) or any special or consequential loss or damage whatsoever.
4. This plan has been provided to you on the basis of the terms of use set out in the covering letter that accompanies this plan. If you do not accept and/or do not understand the terms of use set out in the covering letter you must not use the plan and must return it to the sender of the letter.
5. You are responsible for the security of the information provided to you. It must not be given, sold or made available upon payment of a fee to a third party.



IF IN DOUBT - ASK!
PHONE 0800 056 5866
EMERGENCY - If you
damage a cable or line
Phone 0800 783 8838
(24hrs) URGENTLY

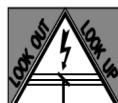


ALWAYS LOOK UP
BEFORE
YOU START WORK
Refer to HSE
Guidance note GS6

Maps produced at 1:2500 scale are Geo-Schematics which show LV mains cables and overhead lines (in some cases all voltages). Prior to carrying out excavations you must refer to the 1:500 records to determine the location of all known underground plant and equipment.

13

0 25 50
metres

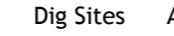Dig Sites Area:  Line: 

The quality and accuracy of any print will depend on your printer, your computer and its print settings. Measurements scaled from this plan may not match measurements between the same points on the ground.

This plan must be used with the attached 'Symbols' document.

Date Requested: 12/12/2018
Job Reference: 14403097
Site Location: 522190 135538
Requested by:
Mr Gareth Adam

Your Scheme/Reference: West of Ifield - 4 of 13
Scale: 1:500 (When plotted at A3)

1. The position of the apparatus shown on this drawing is believed to be correct but the original landmarks may have been altered since the apparatus was installed.
2. The exact position of the apparatus should be verified - use approved cable avoidance tools prior to excavation using suitable hand tools.
3. It is essential that trial holes are carefully made avoiding the use of mechanical tools or picks until the exact location of all the cables have been determined.
4. It must be assumed that there is a service cable into each property, lamp column and street sign, etc.
5. All cables must be treated as being live unless proved otherwise by UK Power Networks.
6. The information proved must be given to all people working near UK Power Networks plant and equipment. Do not use plans more than 3 months after the issue date for excavation purposes.
7. Please be aware that electric cables/lines belonging to other owners of licensed electricity distribution systems may be present and it is your responsibility to identify their location.

1. UK Power Networks does not warrant that the information provided to you is correct. You rely upon it at your own risk.
2. UK Power Networks does not exclude or limit its liability if it causes the death of any persons or causes personal injury to a person.
3. Subject to paragraph 2 UK Power Networks has no liability to you in contract, in tort (including negligence), for breach of statutory duty or otherwise for any loss, damage, cost, claims, demands, or expenses that you or any third party may suffer or incur as a result of using the information provided whether for physical damage to property or for any economic loss (including without limitation loss of profit, loss of opportunity, loss of savings, loss of goodwill, loss of business, loss of use) or any special or consequential loss or damage whatsoever.
4. This plan has been provided to you on the basis of the terms of use set out in the covering letter that accompanies this plan. If you do not accept and/or do not understand the terms of use set out in the covering letter you must not use the plan and must return it to the sender of the letter.
5. You are responsible for the security of the information provided to you. It must not be given, sold or made available upon payment of a fee to a third party.






IF IN DOUBT - ASK!
PHONE 0800 056 5866
EMERGENCY - If you
damage a cable or line
Phone 0800 783 8838
(24hrs) URGENTLY




ALWAYS LOOK UP
BEFORE
YOU START WORK
Refer to HSE
Guidance note GS6

Maps produced at 1:2500 scale are Geo-Schematics which show LV mains cables and overhead lines (in some cases all voltages). Prior to carrying out excavations you must refer to the 1:500 records to determine the location of all known underground plant and equipment.
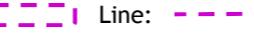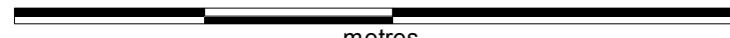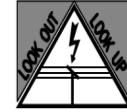
| | | | | | | | |
|--|----|----|---|---|---|---|--|
| 0 | 25 | 50 | Dig Sites | Area:  Line:  | The quality and accuracy of any print will depend on your printer, your computer and its print settings. Measurements scaled from this plan may not match measurements between the same points on the ground. |  |  |
|  metres | | | This plan must be used with the attached 'Symbols' document. 1. The position of the apparatus shown on this drawing is believed to be correct but the original landmarks may have been altered since the apparatus was installed. 2. The exact position of the apparatus should be verified - use approved cable avoidance tools prior to excavation using suitable hand tools. 3. It is essential that trial holes are carefully made avoiding the use of mechanical tools or picks until the exact location of all the cables have been determined. 4. It must be assumed that there is a service cable into each property, lamp column and street sign, etc. 5. All cables must be treated as being live unless proved otherwise by UK Power Networks. 6. The information proved must be given to all people working near UK Power Networks plant and equipment. Do not use plans more than 3 months after the issue date for excavation purposes. 7. Please be aware that electric cables/lines belonging to other owners of licensed electricity distribution systems may be present and it is your responsibility to identify their location. | | | | |
| Date Requested: 12/12/2018 Job Reference: 14403097 Site Location: 522190 135538 Requested by: Mr Gareth Adam Your Scheme/Reference: West of Ifield - 4 of 13 Scale: 1:500 (When plotted at A3) | | | 1. UK Power Networks does not warrant that the information provided to you is correct. You rely upon it at your own risk. 2. UK Power Networks does not exclude or limit its liability if it causes the death of any persons or causes personal injury to a person. 3. Subject to paragraph 2 UK Power Networks has no liability to you in contract, in tort (including negligence), for breach of statutory duty or otherwise for any loss, damage, cost, claims, demands, or expenses that you or any third party may suffer or incur as a result of using the information provided whether for physical damage to property or for any economic loss (including without limitation loss of profit, loss of opportunity, loss of savings, loss of goodwill, loss of business, loss of use) or any special or consequential loss or damage whatsoever. 4. This plan has been provided to you on the basis of the terms of use set out in the covering letter that accompanies this plan. If you do not accept and/or do not understand the terms of use set out in the covering letter you must not use the plan and must return it to the sender of the letter. 5. You are responsible for the security of the information provided to you. It must not be given, sold or made available upon payment of a fee to a third party. | | | | |
| Reproduced by permission of Ordnance Survey on behalf of HMSO. © Crown copyright and database rights 2018. All rights reserved. Ordnance Survey Licence numbers 100019626, 100019826 and 100019450. Data has been added to the Ordnance Survey base map; all proprietary rights in such additional data are and shall remain the exclusive property of © London Power Networks plc or Eastern Power Networks plc or South Eastern Power Networks plc each being a distribution licensee under section 6(1)(c) of the Electricity Act 1989 for the relevant distribution services area as that term is defined in such licensee's distribution licence. All rights in such data reserved. Plans generated by DigSAFE Pro™ software provided by LinesearchbeforeUdig. | | | | | | IF IN DOUBT - ASK! PHONE 0800 056 5866 EMERGENCY - If you damage a cable or line Phone 0800 783 8838 (24hrs) URGENTLY |  ALWAYS LOOK UP BEFORE YOU START WORK Refer to HSE Guidance note GS6 |

15

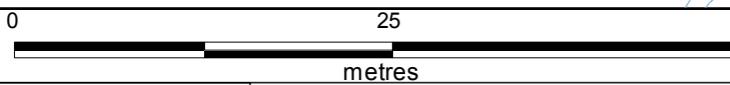

Dig Sites

Area:  Line: 

The quality and accuracy of any print will depend on your printer, your computer and its print settings. Measurements scaled from this plan may not match measurements between the same points on the ground.

This plan must be used with the attached 'Symbols' document.

Date Requested: 12/12/2018
Job Reference: 14403097
Site Location: 522190 135538
Requested by:
Mr Gareth Adam
Your Scheme/Reference: West of Ifield - 4 of 13
Scale: 1:500 (When plotted at A3)

1. The position of the apparatus shown on this drawing is believed to be correct but the original landmarks may have been altered since the apparatus was installed.
2. The exact position of the apparatus should be verified - use approved cable avoidance tools prior to excavation using suitable hand tools.
3. It is essential that trial holes are carefully made avoiding the use of mechanical tools or picks until the exact location of all the cables have been determined.
4. It must be assumed that there is a service cable into each property, lamp column and street sign, etc.
5. All cables must be treated as being live unless proved otherwise by UK Power Networks.
6. The information proved must be given to all people working near UK Power Networks plant and equipment. Do not use plans more than 3 months after the issue date for excavation purposes.
7. Please be aware that electric cables/lines belonging to other owners of licensed electricity distribution systems may be present and it is your responsibility to identify their location.

1. UK Power Networks does not warrant that the information provided to you is correct. You rely upon it at your own risk.
2. UK Power Networks does not exclude or limit its liability if it causes the death of any persons or causes personal injury to a person.
3. Subject to paragraph 2 UK Power Networks has no liability to you in contract, in tort (including negligence), for breach of statutory duty or otherwise for any loss, damage, cost, claims, demands, or expenses that you or any third party may suffer or incur as a result of using the information provided whether for physical damage to property or for any economic loss (including without limitation loss of profit, loss of opportunity, loss of savings, loss of goodwill, loss of business, loss of use) or any special or consequential loss or damage whatsoever.
4. This plan has been provided to you on the basis of the terms of use set out in the covering letter that accompanies this plan. If you do not accept and/or do not understand the terms of use set out in the covering letter you must not use the plan and must return it to the sender of the letter.
5. You are responsible for the security of the information provided to you. It must not be given, sold or made available upon payment of a fee to a third party.






IF IN DOUBT - ASK!
PHONE 0800 056 5866
EMERGENCY - If you
damage a cable or line
Phone 0800 783 8838
(24hrs) URGENTLY



ALWAYS LOOK UP
BEFORE
YOU START WORK
Refer to HSE
Guidance note GS6

Maps produced at 1:2500 scale are Geo-Schematics which show LV mains cables and overhead lines (in some cases all voltages). Prior to carrying out excavations you must refer to the 1:500 records to determine the location of all known underground plant and equipment.
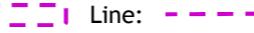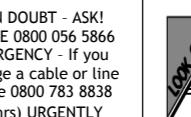
| | | | | | | | |
|--|--|---|---|---|---|---|---|
| 0 | 25 | 50 | Dig Sites | Area:  Line:  | The quality and accuracy of any print will depend on your printer, your computer and its print settings. Measurements scaled from this plan may not match measurements between the same points on the ground. |  |  |
| This plan must be used with the attached 'Symbols' document. | 1. The position of the apparatus shown on this drawing is believed to be correct but the original landmarks may have been altered since the apparatus was installed. 2. The exact position of the apparatus should be verified - use approved cable avoidance tools prior to excavation using suitable hand tools. 3. It is essential that trial holes are carefully made avoiding the use of mechanical tools or picks until the exact location of all the cables have been determined. 4. It must be assumed that there is a service cable into each property, lamp column and street sign, etc. 5. All cables must be treated as being live unless proved otherwise by UK Power Networks. 6. The information proved must be given to all people working near UK Power Networks plant and equipment. Do not use plans more than 3 months after the issue date for excavation purposes. 7. Please be aware that electric cables/lines belonging to other owners of licensed electricity distribution systems may be present and it is your responsibility to identify their location. | 1. UK Power Networks does not warrant that the information provided to you is correct. You rely upon it at your own risk. 2. UK Power Networks does not exclude or limit its liability if it causes the death of any persons or causes personal injury to a person. 3. Subject to paragraph 2 UK Power Networks has no liability to you in contract, in tort (including negligence), for breach of statutory duty or otherwise for any loss, damage, cost, claims, demands, or expenses that you or any third party may suffer or incur as a result of using the information provided whether for physical damage to property or for any economic loss (including without limitation loss of profit, loss of opportunity, loss of savings, loss of goodwill, loss of business, loss of use) or any special or consequential loss or damage whatsoever. 4. This plan has been provided to you on the basis of the terms of use set out in the covering letter that accompanies this plan. If you do not accept and/or do not understand the terms of use set out in the covering letter you must not use the plan and must return it to the sender of the letter. 5. You are responsible for the security of the information provided to you. It must not be given, sold or made available upon payment of a fee to a third party. |  Maps produced at 1:2500 scale are Geo-Schematics which show LV mains cables and overhead lines (in some cases all voltages). Prior to carrying out excavations you must refer to the 1:500 records to determine the location of all known underground plant and equipment. | ALWAYS LOOK UP BEFORE YOU START WORK Refer to HSE Guidance note GS6 | | | |
| Date Requested: 12/12/2018 Job Reference: 14403097 Site Location: 522190 135538 Requested by: Mr Gareth Adam Your Scheme/Reference: West of Ifield - 4 of 13 Scale: 1:500 (When plotted at A3) | | | | | | | |

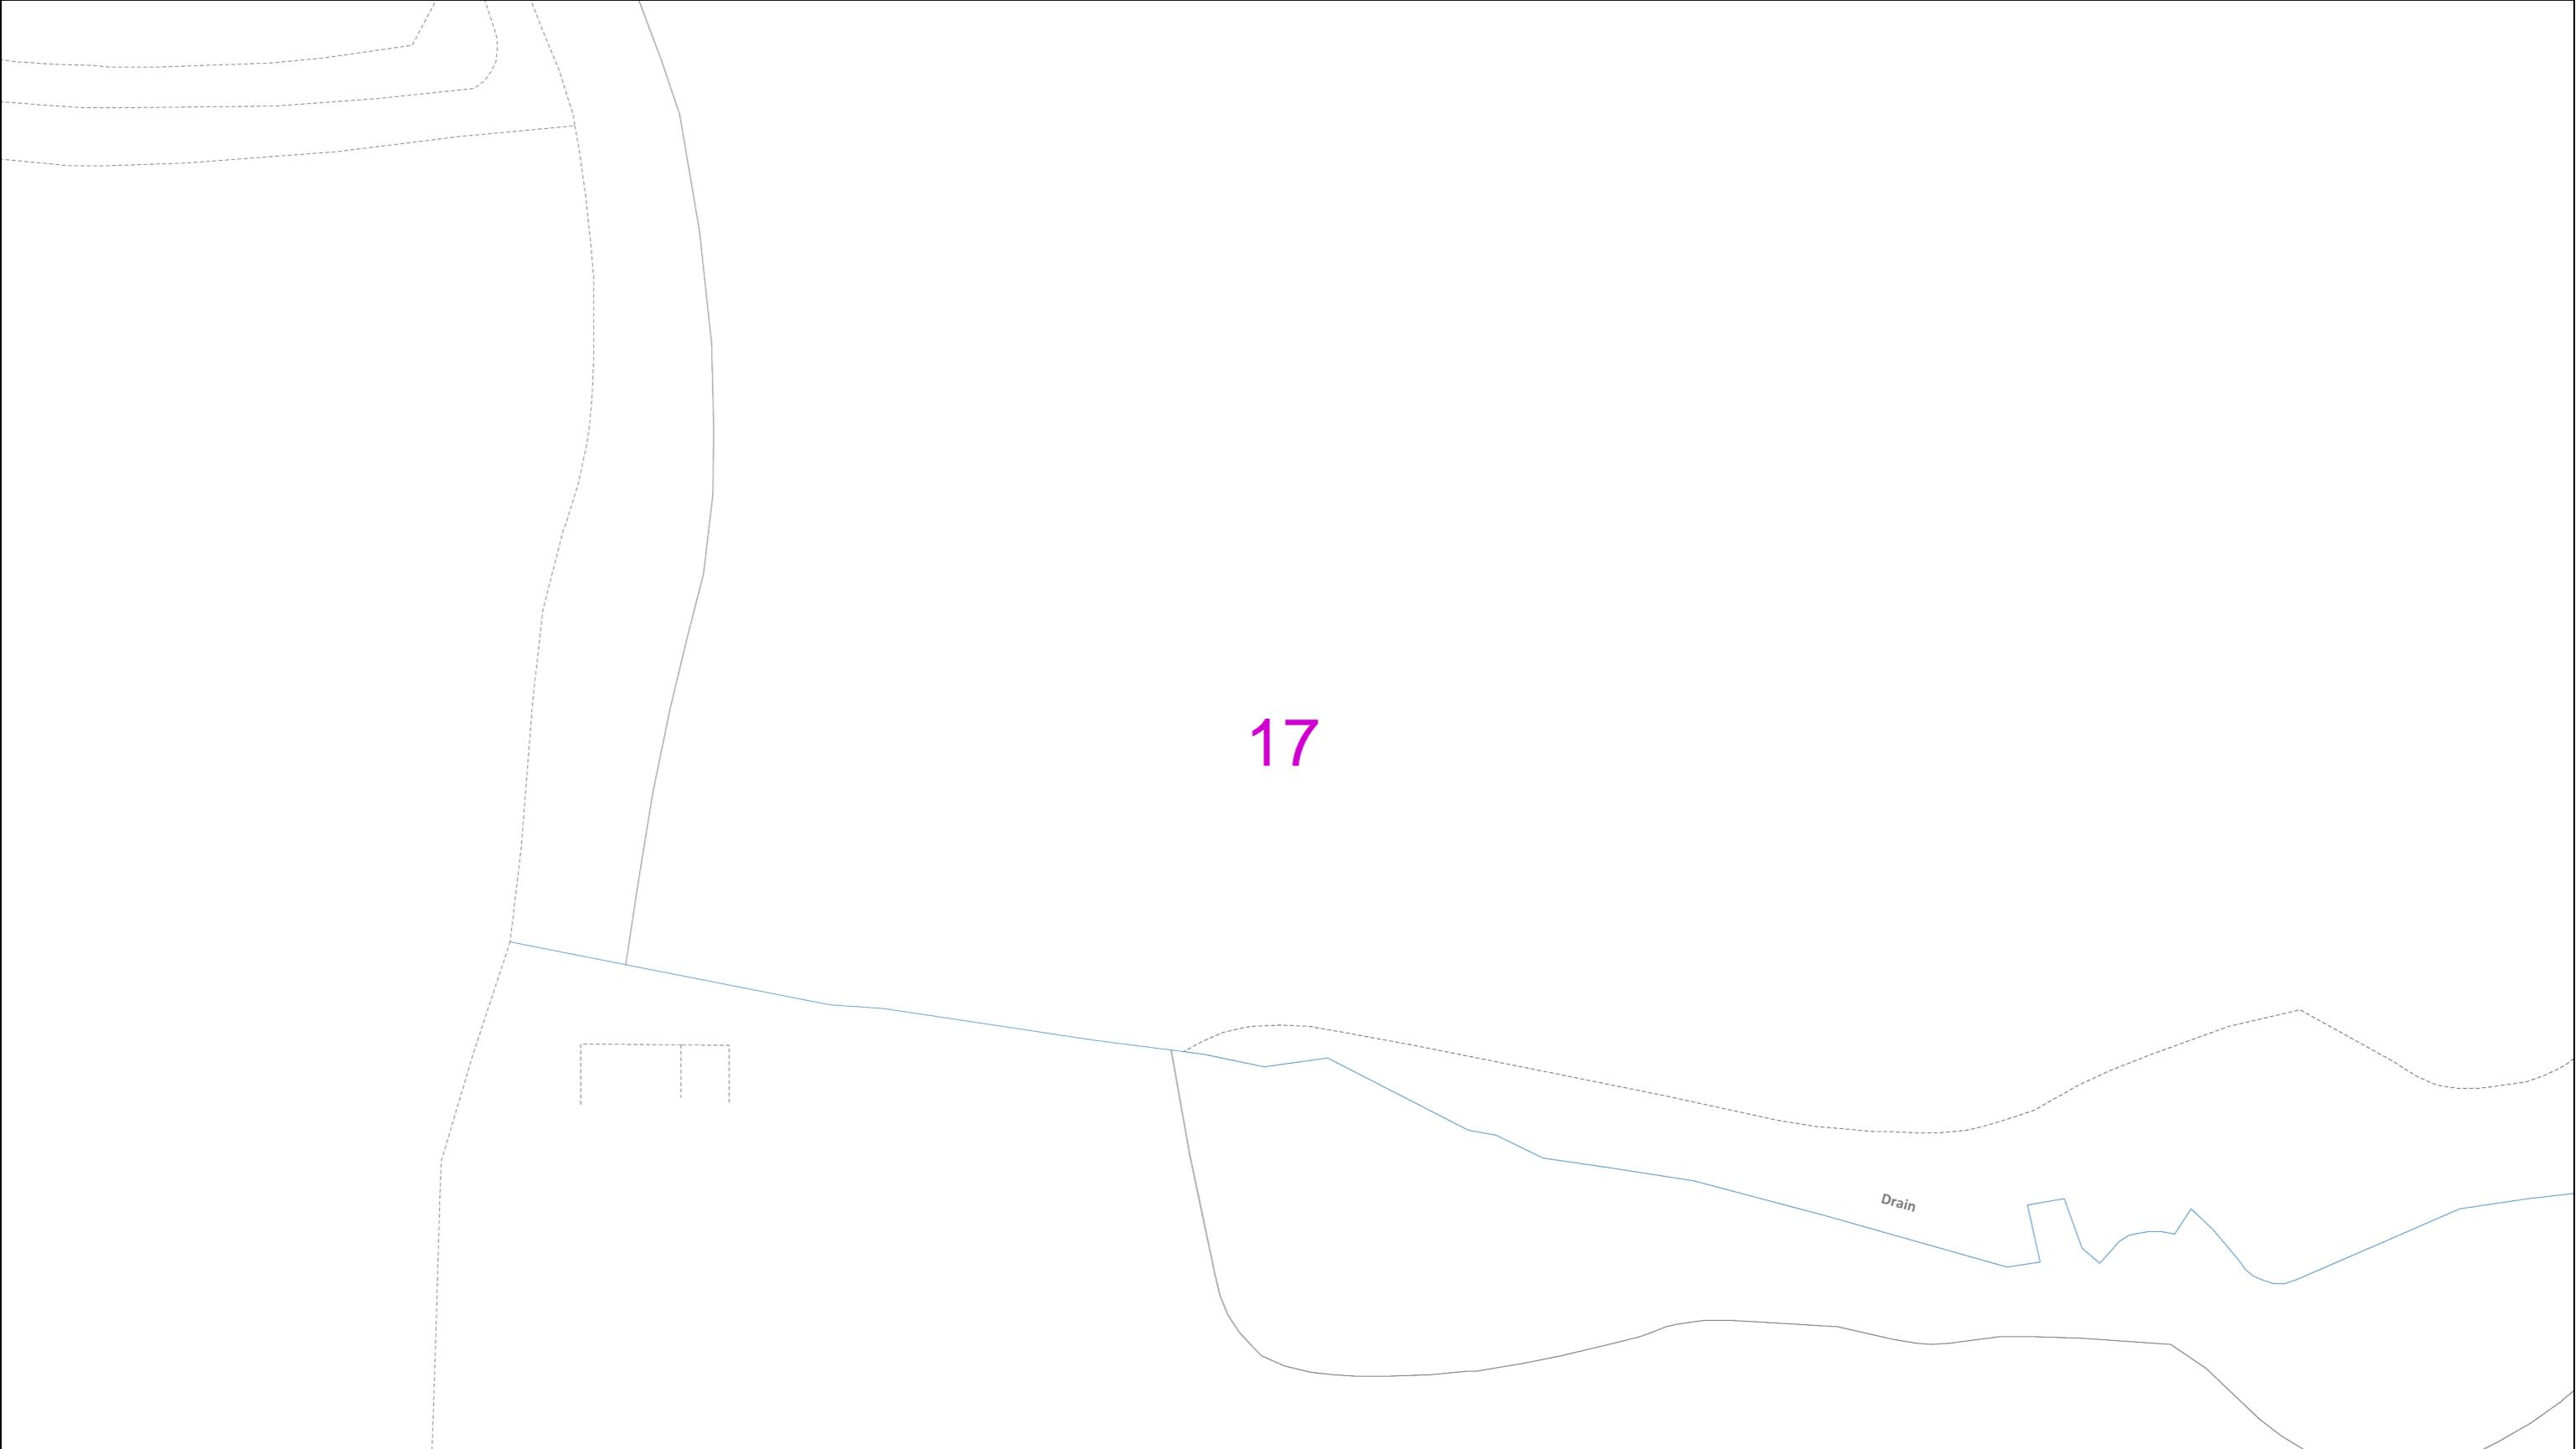

0 25 50
metres

This plan must be used with the attached 'Symbols' document.

Date Requested: 12/12/2018
Job Reference: 14403097
Site Location: 522190 135538
Requested by:
Mr Gareth Adam

Your Scheme/Reference: West of Ifield - 4 of 13
Scale: 1:500 (When plotted at A3)

Dig Sites

Area: [dashed purple border] Line: [dashed purple line]

The quality and accuracy of any print will depend on your printer, your computer and its print settings. Measurements scaled from this plan may not match measurements between the same points on the ground.

1. The position of the apparatus shown on this drawing is believed to be correct but the original landmarks may have been altered since the apparatus was installed.
2. The exact position of the apparatus should be verified - use approved cable avoidance tools prior to excavation using suitable hand tools.
3. It is essential that trial holes are carefully made avoiding the use of mechanical tools or picks until the exact location of all the cables have been determined.
4. It must be assumed that there is a service cable into each property, lamp column and street sign, etc.
5. All cables must be treated as being live unless proved otherwise by UK Power Networks.
6. The information proved must be given to all people working near UK Power Networks plant and equipment. Do not use plans more than 3 months after the issue date for excavation purposes.
7. Please be aware that electric cables/lines belonging to other owners of licensed electricity distribution systems may be present and it is your responsibility to identify their location.
1. UK Power Networks does not warrant that the information provided to you is correct. You rely upon it at your own risk.
2. UK Power Networks does not exclude or limit its liability if it causes the death of any persons or causes personal injury to a person.
3. Subject to paragraph 2 UK Power Networks has no liability to you in contract, in tort (including negligence), for breach of statutory duty or otherwise for any loss, damage, cost, claims, demands, or expenses that you or any third party may suffer or incur as a result of using the information provided whether for physical damage to property or for any economic loss (including without limitation loss of profit, loss of opportunity, loss of savings, loss of goodwill, loss of business, loss of use) or any special or consequential loss or damage whatsoever.
4. This plan has been provided to you on the basis of the terms of use set out in the covering letter that accompanies this plan. If you do not accept and/or do not understand the terms of use set out in the covering letter you must not use the plan and must return it to the sender of the letter.
5. You are responsible for the security of the information provided to you. It must not be given, sold or made available upon payment of a fee to a third party.



IF IN DOUBT - ASK!
PHONE 0800 056 5866
EMERGENCY - If you
damage a cable or line
Phone 0800 783 8838
(24hrs) URGENTLY



ALWAYS LOOK UP
BEFORE
YOU START WORK
Refer to HSE
Guidance note GS6

Maps produced at 1:2500 scale are Geo-Schematics which show LV mains cables and overhead lines (in some cases all voltages). Prior to carrying out excavations you must refer to the 1:500 records to determine the location of all known underground plant and equipment.

18

0 25 50
metres

Dig Sites Area:  Line: 

The quality and accuracy of any print will depend on your printer, your computer and its print settings. Measurements scaled from this plan may not match measurements between the same points on the ground.

This plan must be used with the attached 'Symbols' document.

1. The position of the apparatus shown on this drawing is believed to be correct but the original landmarks may have been altered since the apparatus was installed.
2. The exact position of the apparatus should be verified - use approved cable avoidance tools prior to excavation using suitable hand tools.
3. It is essential that trial holes are carefully made avoiding the use of mechanical tools or picks until the exact location of all the cables have been determined.
4. It must be assumed that there is a service cable into each property, lamp column and street sign, etc.
5. All cables must be treated as being live unless proved otherwise by UK Power Networks.
6. The information proved must be given to all people working near UK Power Networks plant and equipment. Do not use plans more than 3 months after the issue date for excavation purposes.
7. Please be aware that electric cables/lines belonging to other owners of licensed electricity distribution systems may be present and it is your responsibility to identify their location.

Date Requested: 12/12/2018
Job Reference: 14403097
Site Location: 522190 135538
Requested by:
Mr Gareth Adam
Your Scheme/Reference: West of Ifield - 4 of 13

Scale: 1:500 (When plotted at A3)

1. UK Power Networks does not warrant that the information provided to you is correct. You rely upon it at your own risk.
2. UK Power Networks does not exclude or limit its liability if it causes the death of any persons or causes personal injury to a person.
3. Subject to paragraph 2 UK Power Networks has no liability to you in contract, in tort (including negligence), for breach of statutory duty or otherwise for any loss, damage, cost, claims, demands, or expenses that you or any third party may suffer or incur as a result of using the information provided whether for physical damage to property or for any economic loss (including without limitation loss of profit, loss of opportunity, loss of savings, loss of goodwill, loss of business, loss of use) or any special or consequential loss or damage whatsoever.
4. This plan has been provided to you on the basis of the terms of use set out in the covering letter that accompanies this plan. If you do not accept and/or do not understand the terms of use set out in the covering letter you must not use the plan and must return it to the sender of the letter.
5. You are responsible for the security of the information provided to you. It must not be given, sold or made available upon payment of a fee to a third party.

 


IF IN DOUBT - ASK!
PHONE 0800 056 5866
EMERGENCY - If you
damage a cable or line
Phone 0800 783 8838
(24hrs) URGENTLY




ALWAYS LOOK UP
BEFORE
YOU START WORK
Refer to HSE
Guidance note GS6

Maps produced at 1:2500 scale are Geo-Schematics which show LV mains cables and overhead lines (in some cases all voltages). Prior to carrying out excavations you must refer to the 1:500 records to determine the location of all known underground plant and equipment.



0 25 50
metres

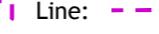Dig Sites Area:  Line: 

The quality and accuracy of any print will depend on your printer, your computer and its print settings. Measurements scaled from this plan may not match measurements between the same points on the ground.

This plan must be used with the attached 'Symbols' document.

1. The position of the apparatus shown on this drawing is believed to be correct but the original landmarks may have been altered since the apparatus was installed.
2. The exact position of the apparatus should be verified - use approved cable avoidance tools prior to excavation using suitable hand tools.
3. It is essential that trial holes are carefully made avoiding the use of mechanical tools or picks until the exact location of all the cables have been determined.
4. It must be assumed that there is a service cable into each property, lamp column and street sign, etc.
5. All cables must be treated as being live unless proved otherwise by UK Power Networks.
6. The information proved must be given to all people working near UK Power Networks plant and equipment. Do not use plans more than 3 months after the issue date for excavation purposes.
7. Please be aware that electric cables/lines belonging to other owners of licensed electricity distribution systems may be present and it is your responsibility to identify their location.

Date Requested: 12/12/2018
Job Reference: 14403097
Site Location: 522190 135538
Requested by:
Mr Gareth Adam

Your Scheme/Reference: West of Ifield - 4 of 13
Scale: 1:500 (When plotted at A3)

1. UK Power Networks does not warrant that the information provided to you is correct. You rely upon it at your own risk.
2. UK Power Networks does not exclude or limit its liability if it causes the death of any persons or causes personal injury to a person.
3. Subject to paragraph 2 UK Power Networks has no liability to you in contract, in tort (including negligence), for breach of statutory duty or otherwise for any loss, damage, cost, claims, demands, or expenses that you or any third party may suffer or incur as a result of using the information provided whether for physical damage to property or for any economic loss (including without limitation loss of profit, loss of opportunity, loss of savings, loss of goodwill, loss of business, loss of use) or any special or consequential loss or damage whatsoever.
4. This plan has been provided to you on the basis of the terms of use set out in the covering letter that accompanies this plan. If you do not accept and/or do not understand the terms of use set out in the covering letter you must not use the plan and must return it to the sender of the letter.
5. You are responsible for the security of the information provided to you. It must not be given, sold or made available upon payment of a fee to a third party.

 


IF IN DOUBT - ASK!
PHONE 0800 056 5866
EMERGENCY - If you
damage a cable or line
Phone 0800 783 8838
(24hrs) URGENTLY



ALWAYS LOOK UP
BEFORE
YOU START WORK
Refer to HSE
Guidance note GS6

Maps produced at 1:2500 scale are Geo-Schematics which show LV mains cables and overhead lines (in some cases all voltages). Prior to carrying out excavations you must refer to the 1:500 records to determine the location of all known underground plant and equipment.



0 25 50
metres

This plan must be used with the attached 'Symbols' document.

Date Requested: 12/12/2018
Job Reference: 14403097
Site Location: 522190 135538
Requested by:
Mr Gareth Adam

Your Scheme/Reference: West of Ifield - 4 of 13
Scale: 1:500 (When plotted at A3)

Dig Sites

Area: Line:

The quality and accuracy of any print will depend on your printer, your computer and its print settings. Measurements scaled from this plan may not match measurements between the same points on the ground.

1. The position of the apparatus shown on this drawing is believed to be correct but the original landmarks may have been altered since the apparatus was installed.
2. The exact position of the apparatus should be verified - use approved cable avoidance tools prior to excavation using suitable hand tools.
3. It is essential that trial holes are carefully made avoiding the use of mechanical tools or picks until the exact location of all the cables have been determined.
4. It must be assumed that there is a service cable into each property, lamp column and street sign, etc.
5. All cables must be treated as being live unless proved otherwise by UK Power Networks.
6. The information proved must be given to all people working near UK Power Networks plant and equipment. Do not use plans more than 3 months after the issue date for excavation purposes.
7. Please be aware that electric cables/lines belonging to other owners of licensed electricity distribution systems may be present and it is your responsibility to identify their location.
1. UK Power Networks does not warrant that the information provided to you is correct. You rely upon it at your own risk.
2. UK Power Networks does not exclude or limit its liability if it causes the death of any persons or causes personal injury to a person.
3. Subject to paragraph 2 UK Power Networks has no liability to you in contract, in tort (including negligence), for breach of statutory duty or otherwise for any loss, damage, cost, claims, demands, or expenses that you or any third party may suffer or incur as a result of using the information provided whether for physical damage to property or for any economic loss (including without limitation loss of profit, loss of opportunity, loss of savings, loss of goodwill, loss of business, loss of use) or any special or consequential loss or damage whatsoever.
4. This plan has been provided to you on the basis of the terms of use set out in the covering letter that accompanies this plan. If you do not accept and/or do not understand the terms of use set out in the covering letter you must not use the plan and must return it to the sender of the letter.
5. You are responsible for the security of the information provided to you. It must not be given, sold or made available upon payment of a fee to a third party.








IF IN DOUBT - ASK!
PHONE 0800 056 5866
EMERGENCY - If you
damage a cable or line
Phone 0800 783 8838
(24hrs) URGENTLY




ALWAYS LOOK UP
BEFORE
YOU START WORK
Refer to HSE
Guidance note GS6

Maps produced at 1:2500 scale are Geo-Schematics which show LV mains cables and overhead lines (in some cases all voltages). Prior to carrying out excavations you must refer to the 1:500 records to determine the location of all known underground plant and equipment.
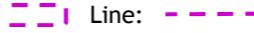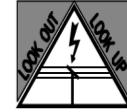
| | | | | | | | | |
|--|----|----|--|---|---|--|---|--|
| 0 | 25 | 50 | Dig Sites | Area:  Line:  | The quality and accuracy of any print will depend on your printer, your computer and its print settings. Measurements scaled from this plan may not match measurements between the same points on the ground. | |  |  |
|  metres | | | | | | | | |
| This plan must be used with the attached 'Symbols' document. Date Requested: 12/12/2018 Job Reference: 14403097 Site Location: 522190 135538 Requested by: Mr Gareth Adam Your Scheme/Reference: West of Ifield - 4 of 13 Scale: 1:500 (When plotted at A3) | | | 1. The position of the apparatus shown on this drawing is believed to be correct but the original landmarks may have been altered since the apparatus was installed. 2. The exact position of the apparatus should be verified - use approved cable avoidance tools prior to excavation using suitable hand tools. 3. It is essential that trial holes are carefully made avoiding the use of mechanical tools or picks until the exact location of all the cables have been determined. 4. It must be assumed that there is a service cable into each property, lamp column and street sign, etc. 5. All cables must be treated as being live unless proved otherwise by UK Power Networks. 6. The information proved must be given to all people working near UK Power Networks plant and equipment. Do not use plans more than 3 months after the issue date for excavation purposes. 7. Please be aware that electric cables/lines belonging to other owners of licensed electricity distribution systems may be present and it is your responsibility to identify their location. | | | | 1. UK Power Networks does not warrant that the information provided to you is correct. You rely upon it at your own risk. 2. UK Power Networks does not exclude or limit its liability if it causes the death of any persons or causes personal injury to a person. 3. Subject to paragraph 2 UK Power Networks has no liability to you in contract, in tort (including negligence), for breach of statutory duty or otherwise for any loss, damage, cost, claims, demands, or expenses that you or any third party may suffer or incur as a result of using the information provided whether for physical damage to property or for any economic loss (including without limitation loss of profit, loss of opportunity, loss of savings, loss of goodwill, loss of business, loss of use) or any special or consequential loss or damage whatsoever. 4. This plan has been provided to you on the basis of the terms of use set out in the covering letter that accompanies this plan. If you do not accept and/or do not understand the terms of use set out in the covering letter you must not use the plan and must return it to the sender of the letter. 5. You are responsible for the security of the information provided to you. It must not be given, sold or made available upon payment of a fee to a third party. | |
| | | | | | | | IF IN DOUBT - ASK! PHONE 0800 056 5866 EMERGENCY - If you damage a cable or line Phone 0800 783 8838 (24hrs) URGENTLY | ALWAYS LOOK UP BEFORE YOU START WORK  Refer to HSE Guidance note GS6 |
| Maps produced at 1:2500 scale are Geo-Schematics which show LV mains cables and overhead lines (in some cases all voltages). Prior to carrying out excavations you must refer to the 1:500 records to determine the location of all known underground plant and equipment. | | | | | | | | |
| Reproduced by permission of Ordnance Survey on behalf of HMSO. © Crown copyright and database rights 2018. All rights reserved. Ordnance Survey Licence numbers 100019626, 100019826 and 100019450. Data has been added to the Ordnance Survey base map; all proprietary rights in such additional data are and shall remain the exclusive property of © London Power Networks plc or Eastern Power Networks plc or South Eastern Power Networks plc each being a distribution licensee under section 6(1)(c) of the Electricity Act 1989 for the relevant distribution services area as that term is defined in such licensee's distribution licence. All rights in such data reserved. Plans generated by DigSAFE Pro™ software provided by LinesearchbeforeUdig. | | | | | | | | |
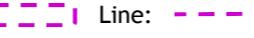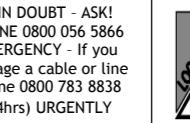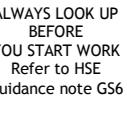
| | | | | | | | | |
|---|----|----|-----------|---|--|--|---|---|
| 0 | 25 | 50 | Dig Sites | Area:  Line:  | The quality and accuracy of any print will depend on your printer, your computer and its print settings. Measurements scaled from this plan may not match measurements between the same points on the ground. | |  |  |
| <p>This plan must be used with the attached 'Symbols' document.</p> <p>Date Requested: 12/12/2018 Job Reference: 14403097 Site Location: 522190 135538 Requested by: Mr Gareth Adam Your Scheme/Reference: West of Ifield - 4 of 13 Scale: 1:500 (When plotted at A3)</p> | | | | | <p>1. The position of the apparatus shown on this drawing is believed to be correct but the original landmarks may have been altered since the apparatus was installed. 2. The exact position of the apparatus should be verified - use approved cable avoidance tools prior to excavation using suitable hand tools. 3. It is essential that trial holes are carefully made avoiding the use of mechanical tools or picks until the exact location of all the cables have been determined. 4. It must be assumed that there is a service cable into each property, lamp column and street sign, etc. 5. All cables must be treated as being live unless proved otherwise by UK Power Networks. 6. The information proved must be given to all people working near UK Power Networks plant and equipment. Do not use plans more than 3 months after the issue date for excavation purposes. 7. Please be aware that electric cables/lines belonging to other owners of licensed electricity distribution systems may be present and it is your responsibility to identify their location.</p> <p>1. UK Power Networks does not warrant that the information provided to you is correct. You rely upon it at your own risk. 2. UK Power Networks does not exclude or limit its liability if it causes the death of any persons or causes personal injury to a person. 3. Subject to paragraph 2 UK Power Networks has no liability to you in contract, in tort (including negligence), for breach of statutory duty or otherwise for any loss, damage, cost, claims, demands, or expenses that you or any third party may suffer or incur as a result of using the information provided whether for physical damage to property or for any economic loss (including without limitation loss of profit, loss of opportunity, loss of savings, loss of goodwill, loss of business, loss of use) or any special or consequential loss or damage whatsoever. 4. This plan has been provided to you on the basis of the terms of use set out in the covering letter that accompanies this plan. If you do not accept and/or do not understand the terms of use set out in the covering letter you must not use the plan and must return it to the sender of the letter. 5. You are responsible for the security of the information provided to you. It must not be given, sold or made available upon payment of a fee to a third party.</p> | |  |  |
| <p>Maps produced at 1:2500 scale are Geo-Schematics which show LV mains cables and overhead lines (in some cases all voltages). Prior to carrying out excavations you must refer to the 1:500 records to determine the location of all known underground plant and equipment.</p> | | | | | | | | |
| <p>Reproduced by permission of Ordnance Survey on behalf of HMSO. © Crown copyright and database rights 2018. All rights reserved. Ordnance Survey Licence numbers 100019626, 100019826 and 100019450. Data has been added to the Ordnance Survey base map; all proprietary rights in such additional data are and shall remain the exclusive property of © London Power Networks plc or Eastern Power Networks plc or South Eastern Power Networks plc each being a distribution licensee under section 6(1)(c) of the Electricity Act 1989 for the relevant distribution services area as that term is defined in such licensee's distribution licence. All rights in such data reserved.</p> | | | | | | | | |
| <p>Plans generated by DigSAFE Pro™ software provided by LinesearchbeforeUdig.</p> | | | | | | | | |

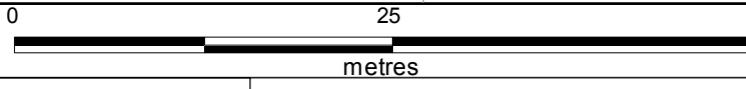

Dig Sites Area: Line:

The quality and accuracy of any print will depend on your printer, your computer and its print settings. Measurements scaled from this plan may not match measurements between the same points on the ground.

This plan must be used with the attached 'Symbols' document.

1. The position of the apparatus shown on this drawing is believed to be correct but the original landmarks may have been altered since the apparatus was installed.
 2. The exact position of the apparatus should be verified - use approved cable avoidance tools prior to excavation using suitable hand tools.
 3. It is essential that trial holes are carefully made avoiding the use of mechanical tools or picks until the exact location of all the cables have been determined.
 4. It must be assumed that there is a service cable into each property, lamp column and street sign, etc.
 5. All cables must be treated as being live unless proved otherwise by UK Power Networks.
 6. The information proved must be given to all people working near UK Power Networks plant and equipment. Do not use plans more than 3 months after the issue date for excavation purposes.
 7. Please be aware that electric cables/lines belonging to other owners of licensed electricity distribution systems may be present and it is your responsibility to identify their location.

Date Requested: 12/12/2018
 Job Reference: 14403097
 Site Location: 522190 135538
 Requested by:
 Mr Gareth Adam
 Your Scheme/Reference: West of Ifield - 4 of 13

Scale: 1:500 (When plotted at A3)

1. UK Power Networks does not warrant that the information provided to you is correct. You rely upon it at your own risk.
 2. UK Power Networks does not exclude or limit its liability if it causes the death of any persons or causes personal injury to a person.
 3. Subject to paragraph 2 UK Power Networks has no liability to you in contract, in tort (including negligence), for breach of statutory duty or otherwise for any loss, damage, cost, claims, demands, or expenses that you or any third party may suffer or incur as a result of using the information provided whether for physical damage to property or for any economic loss (including without limitation loss of profit, loss of opportunity, loss of savings, loss of goodwill, loss of business, loss of use) or any special or consequential loss or damage whatsoever.
 4. This plan has been provided to you on the basis of the terms of use set out in the covering letter that accompanies this plan. If you do not accept and/or do not understand the terms of use set out in the covering letter you must not use the plan and must return it to the sender of the letter.
 5. You are responsible for the security of the information provided to you. It must not be given, sold or made available upon payment of a fee to a third party.



IF IN DOUBT - ASK!
 PHONE 0800 056 5866
 EMERGENCY - If you
 damage a cable or line
 Phone 0800 783 8838
 (24hrs) URGENTLY



ALWAYS LOOK UP
 BEFORE
 YOU START WORK
 Refer to HSE
 Guidance note GS6

Maps produced at 1:2500 scale are Geo-Schematics which show LV mains cables and overhead lines (in some cases all voltages). Prior to carrying out excavations you must refer to the 1:500 records to determine the location of all known underground plant and equipment.

24

0 25 50
metres

Dig Sites Area:  Line: 

The quality and accuracy of any print will depend on your printer, your computer and its print settings. Measurements scaled from this plan may not match measurements between the same points on the ground.

This plan must be used with the attached 'Symbols' document.

Date Requested: 12/12/2018
Job Reference: 14403097
Site Location: 522190 135538
Requested by:
Mr Gareth Adam

Your Scheme/Reference: West of Ifield - 4 of 13
Scale: 1:500 (When plotted at A3)

1. The position of the apparatus shown on this drawing is believed to be correct but the original landmarks may have been altered since the apparatus was installed.
2. The exact position of the apparatus should be verified - use approved cable avoidance tools prior to excavation using suitable hand tools.
3. It is essential that trial holes are carefully made avoiding the use of mechanical tools or picks until the exact location of all the cables have been determined.
4. It must be assumed that there is a service cable into each property, lamp column and street sign, etc.
5. All cables must be treated as being live unless proved otherwise by UK Power Networks.
6. The information proved must be given to all people working near UK Power Networks plant and equipment. Do not use plans more than 3 months after the issue date for excavation purposes.
7. Please be aware that electric cables/lines belonging to other owners of licensed electricity distribution systems may be present and it is your responsibility to identify their location.

1. UK Power Networks does not warrant that the information provided to you is correct. You rely upon it at your own risk.
2. UK Power Networks does not exclude or limit its liability if it causes the death of any persons or causes personal injury to a person.
3. Subject to paragraph 2 UK Power Networks has no liability to you in contract, in tort (including negligence), for breach of statutory duty or otherwise for any loss, damage, cost, claims, demands, or expenses that you or any third party may suffer or incur as a result of using the information provided whether for physical damage to property or for any economic loss (including without limitation loss of profit, loss of opportunity, loss of savings, loss of goodwill, loss of business, loss of use) or any special or consequential loss or damage whatsoever.
4. This plan has been provided to you on the basis of the terms of use set out in the covering letter that accompanies this plan. If you do not accept and/or do not understand the terms of use set out in the covering letter you must not use the plan and must return it to the sender of the letter.
5. You are responsible for the security of the information provided to you. It must not be given, sold or made available upon payment of a fee to a third party.




IF IN DOUBT - ASK!
PHONE 0800 056 5866
EMERGENCY - If you
damage a cable or line
Phone 0800 783 8838
(24hrs) URGENTLY





ALWAYS LOOK UP
BEFORE
YOU START WORK
Refer to HSE
Guidance note GS6



Maps produced at 1:2500 scale are Geo-Schematics which show LV mains cables and overhead lines (in some cases all voltages). Prior to carrying out excavations you must refer to the 1:500 records to determine the location of all known underground plant and equipment.


25

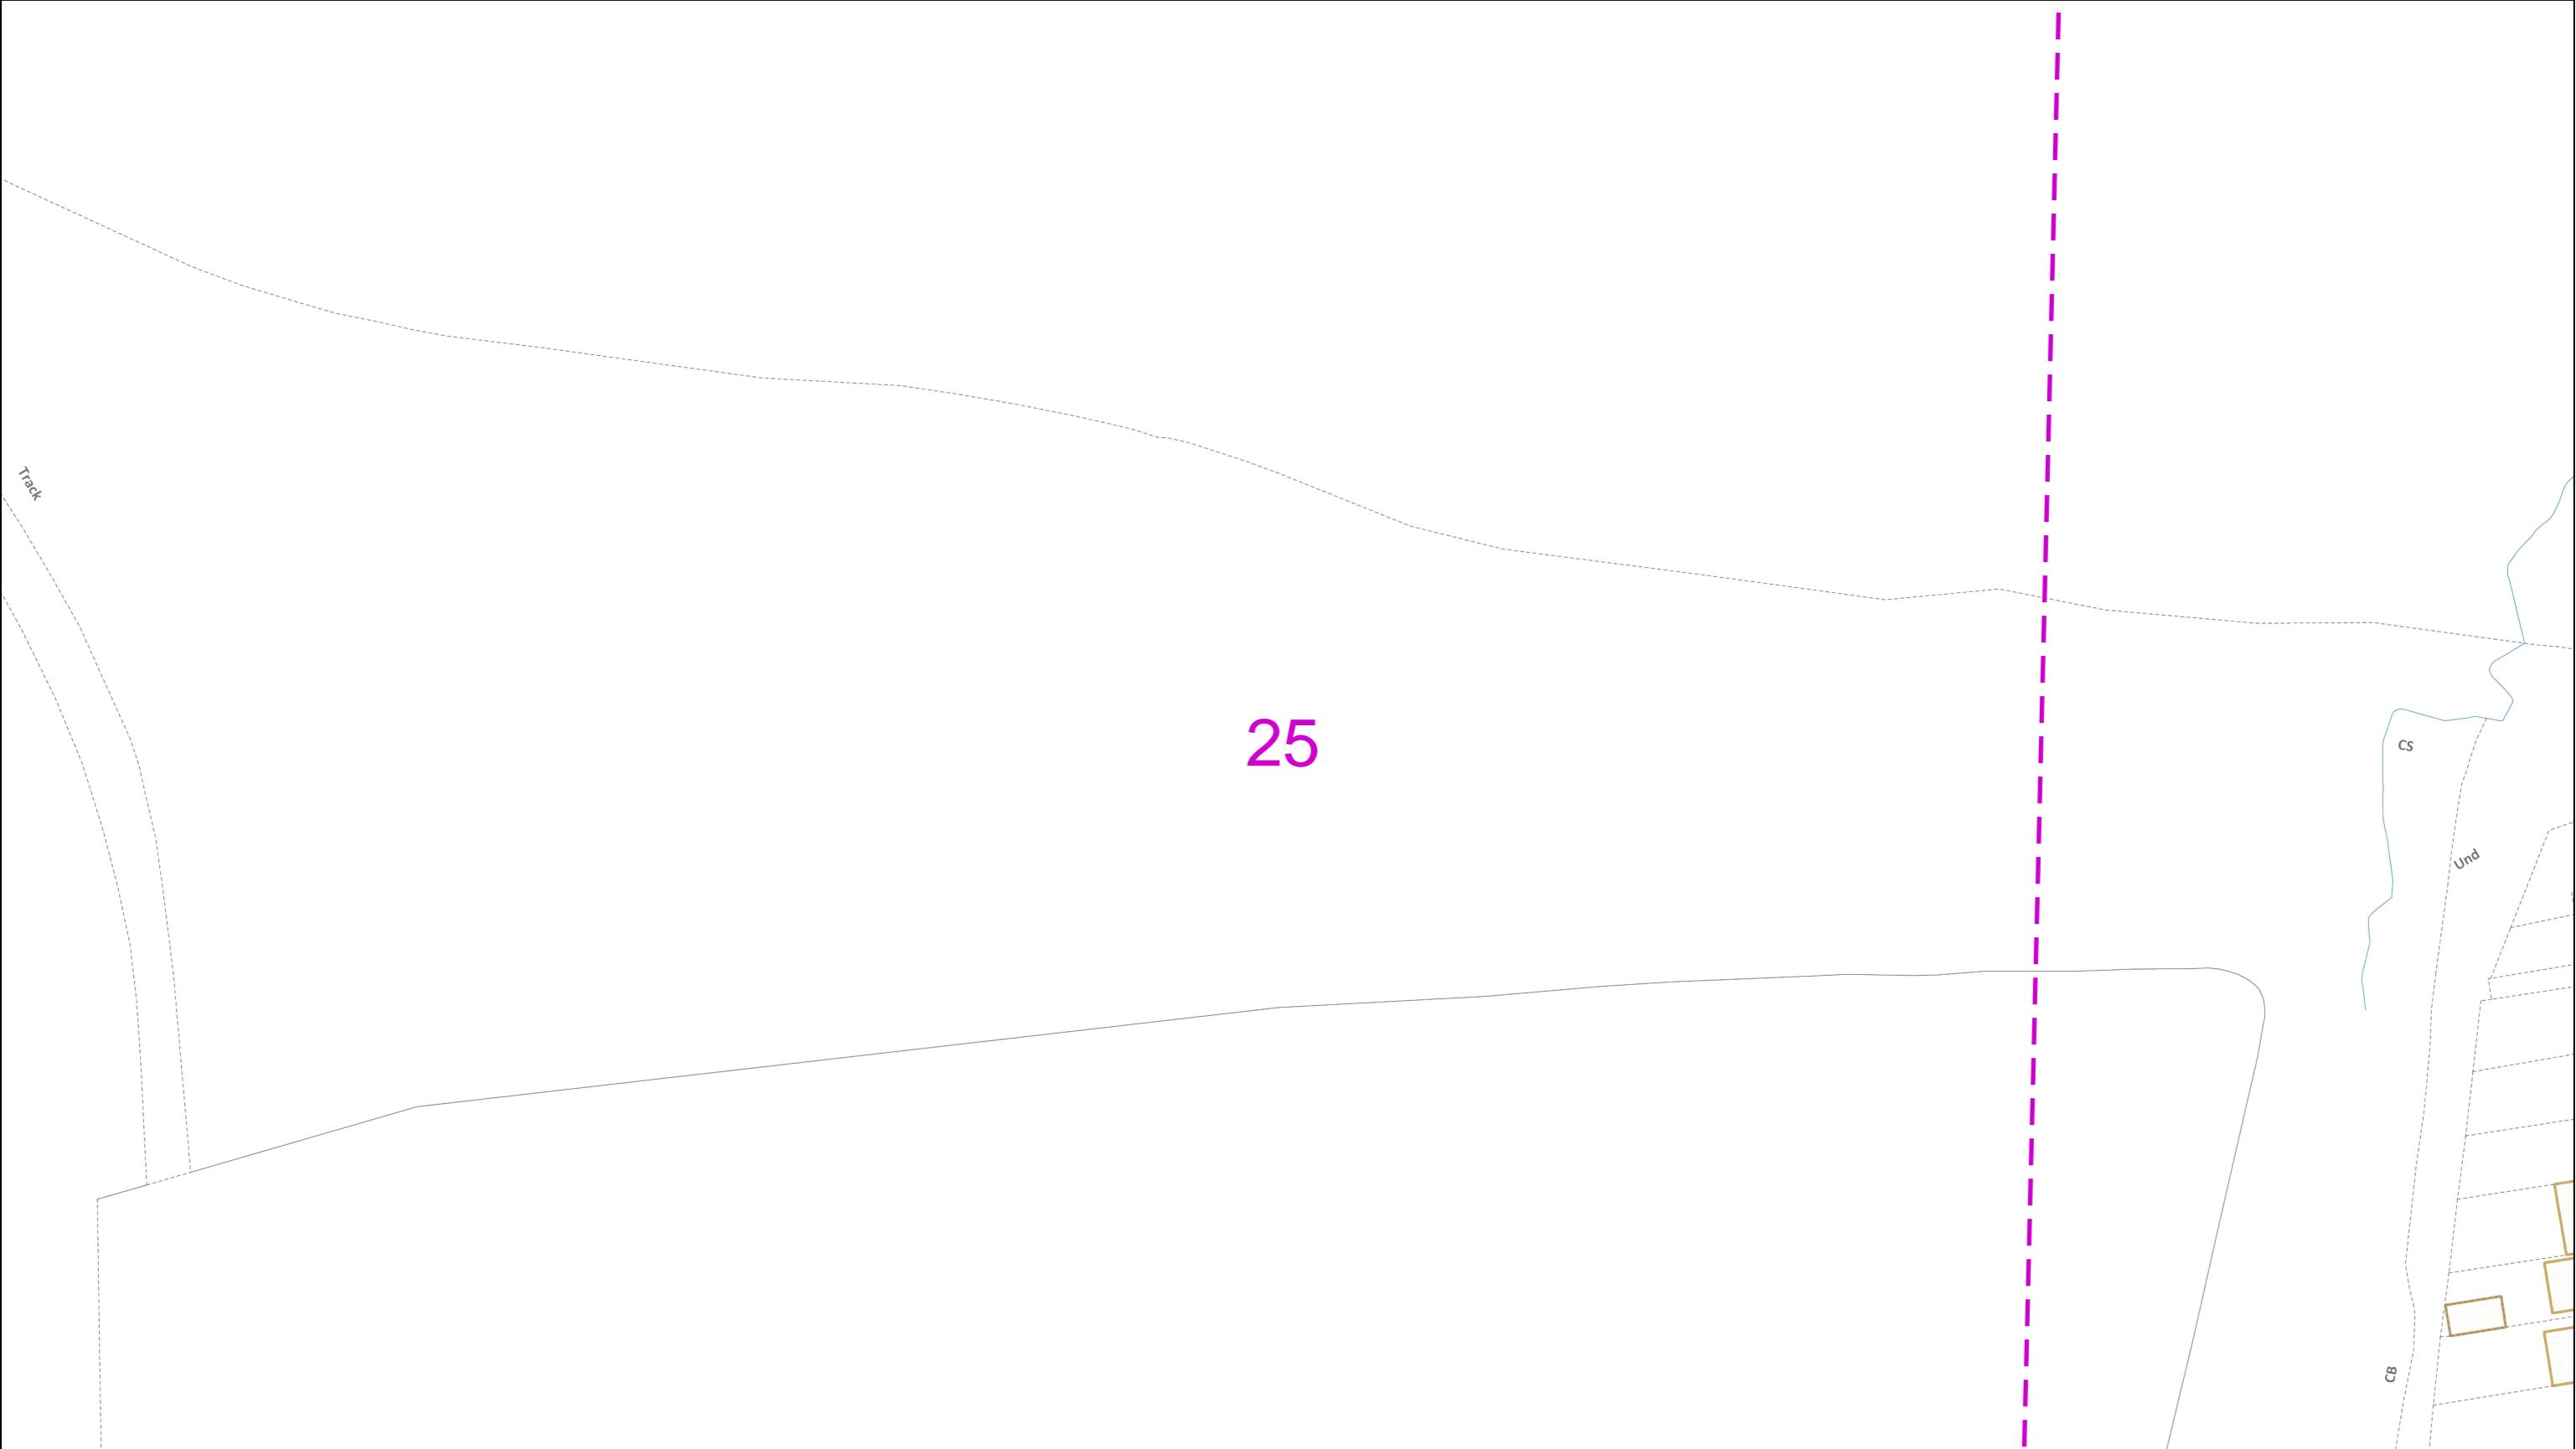

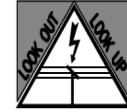
| 0 25 50 | | Dig Sites | Area:  Line:  | The quality and accuracy of any print will depend on your printer, your computer and its print settings. Measurements scaled from this plan may not match measurements between the same points on the ground. | |
|--|--|---|---|--|---|
| This plan must be used with the attached 'Symbols' document. | 1. The position of the apparatus shown on this drawing is believed to be correct but the original landmarks may have been altered since the apparatus was installed. 2. The exact position of the apparatus should be verified - use approved cable avoidance tools prior to excavation using suitable hand tools. 3. It is essential that trial holes are carefully made avoiding the use of mechanical tools or picks until the exact location of all the cables have been determined. 4. It must be assumed that there is a service cable into each property, lamp column and street sign, etc. 5. All cables must be treated as being live unless proved otherwise by UK Power Networks. 6. The information proved must be given to all people working near UK Power Networks plant and equipment. Do not use plans more than 3 months after the issue date for excavation purposes. 7. Please be aware that electric cables/lines belonging to other owners of licensed electricity distribution systems may be present and it is your responsibility to identify their location. | 1. UK Power Networks does not warrant that the information provided to you is correct. You rely upon it at your own risk. 2. UK Power Networks does not exclude or limit its liability if it causes the death of any persons or causes personal injury to a person. 3. Subject to paragraph 2 UK Power Networks has no liability to you in contract, in tort (including negligence), for breach of statutory duty or otherwise for any loss, damage, cost, claims, demands, or expenses that you or any third party may suffer or incur as a result of using the information provided whether for physical damage to property or for any economic loss (including without limitation loss of profit, loss of opportunity, loss of savings, loss of goodwill, loss of business, loss of use) or any special or consequential loss or damage whatsoever. 4. This plan has been provided to you on the basis of the terms of use set out in the covering letter that accompanies this plan. If you do not accept and/or do not understand the terms of use set out in the covering letter you must not use the plan and must return it to the sender of the letter. 5. You are responsible for the security of the information provided to you. It must not be given, sold or made available upon payment of a fee to a third party. |  |  | IF IN DOUBT - ASK! PHONE 0800 056 5866 EMERGENCY - If you damage a cable or line Phone 0800 783 8838 (24hrs) URGENTLY |
| Date Requested: 12/12/2018 Job Reference: 14403097 Site Location: 522190 135538 Requested by: Mr Gareth Adam Your Scheme/Reference: West of Ifield - 4 of 13 Scale: 1:500 (When plotted at A3) |  | | ALWAYS LOOK UP BEFORE YOU START WORK Refer to HSE Guidance note GS6 | Maps produced at 1:2500 scale are Geo-Schematics which show LV mains cables and overhead lines (in some cases all voltages). Prior to carrying out excavations you must refer to the 1:500 records to determine the location of all known underground plant and equipment. | |
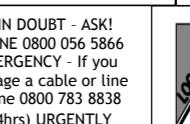
| | | | | | | | |
|--|--|---|---|---|---|---|---|
| 0 | 25 | 50 | Dig Sites | Area:  Line:  | The quality and accuracy of any print will depend on your printer, your computer and its print settings. Measurements scaled from this plan may not match measurements between the same points on the ground. |  |  |
| This plan must be used with the attached 'Symbols' document. | 1. The position of the apparatus shown on this drawing is believed to be correct but the original landmarks may have been altered since the apparatus was installed. 2. The exact position of the apparatus should be verified - use approved cable avoidance tools prior to excavation using suitable hand tools. 3. It is essential that trial holes are carefully made avoiding the use of mechanical tools or picks until the exact location of all the cables have been determined. 4. It must be assumed that there is a service cable into each property, lamp column and street sign, etc. 5. All cables must be treated as being live unless proved otherwise by UK Power Networks. 6. The information proved must be given to all people working near UK Power Networks plant and equipment. Do not use plans more than 3 months after the issue date for excavation purposes. 7. Please be aware that electric cables/lines belonging to other owners of licensed electricity distribution systems may be present and it is your responsibility to identify their location. | 1. UK Power Networks does not warrant that the information provided to you is correct. You rely upon it at your own risk. 2. UK Power Networks does not exclude or limit its liability if it causes the death of any persons or causes personal injury to a person. 3. Subject to paragraph 2 UK Power Networks has no liability to you in contract, in tort (including negligence), for breach of statutory duty or otherwise for any loss, damage, cost, claims, demands, or expenses that you or any third party may suffer or incur as a result of using the information provided whether for physical damage to property or for any economic loss (including without limitation loss of profit, loss of opportunity, loss of savings, loss of goodwill, loss of business, loss of use) or any special or consequential loss or damage whatsoever. 4. This plan has been provided to you on the basis of the terms of use set out in the covering letter that accompanies this plan. If you do not accept and/or do not understand the terms of use set out in the covering letter you must not use the plan and must return it to the sender of the letter. 5. You are responsible for the security of the information provided to you. It must not be given, sold or made available upon payment of a fee to a third party. |  Maps produced at 1:2500 scale are Geo-Schematics which show LV mains cables and overhead lines (in some cases all voltages). Prior to carrying out excavations you must refer to the 1:500 records to determine the location of all known underground plant and equipment. | ALWAYS LOOK UP BEFORE YOU START WORK Refer to HSE Guidance note GS6 | | | |
| Date Requested: 12/12/2018 Job Reference: 14403097 Site Location: 522190 135538 Requested by: Mr Gareth Adam Your Scheme/Reference: West of Ifield - 4 of 13 Scale: 1:500 (When plotted at A3) | | | | | | | |
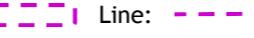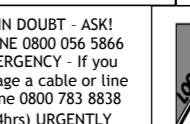
| | | | | | | | |
|--|--|---|---|---|---|---|---|
| 0 | 25 | 50 | Dig Sites | Area:  Line:  | The quality and accuracy of any print will depend on your printer, your computer and its print settings. Measurements scaled from this plan may not match measurements between the same points on the ground. |  |  |
| This plan must be used with the attached 'Symbols' document. | 1. The position of the apparatus shown on this drawing is believed to be correct but the original landmarks may have been altered since the apparatus was installed. 2. The exact position of the apparatus should be verified - use approved cable avoidance tools prior to excavation using suitable hand tools. 3. It is essential that trial holes are carefully made avoiding the use of mechanical tools or picks until the exact location of all the cables have been determined. 4. It must be assumed that there is a service cable into each property, lamp column and street sign, etc. 5. All cables must be treated as being live unless proved otherwise by UK Power Networks. 6. The information proved must be given to all people working near UK Power Networks plant and equipment. Do not use plans more than 3 months after the issue date for excavation purposes. 7. Please be aware that electric cables/lines belonging to other owners of licensed electricity distribution systems may be present and it is your responsibility to identify their location. | 1. UK Power Networks does not warrant that the information provided to you is correct. You rely upon it at your own risk. 2. UK Power Networks does not exclude or limit its liability if it causes the death of any persons or causes personal injury to a person. 3. Subject to paragraph 2 UK Power Networks has no liability to you in contract, in tort (including negligence), for breach of statutory duty or otherwise for any loss, damage, cost, claims, demands, or expenses that you or any third party may suffer or incur as a result of using the information provided whether for physical damage to property or for any economic loss (including without limitation loss of profit, loss of opportunity, loss of savings, loss of goodwill, loss of business, loss of use) or any special or consequential loss or damage whatsoever. 4. This plan has been provided to you on the basis of the terms of use set out in the covering letter that accompanies this plan. If you do not accept and/or do not understand the terms of use set out in the covering letter you must not use the plan and must return it to the sender of the letter. 5. You are responsible for the security of the information provided to you. It must not be given, sold or made available upon payment of a fee to a third party. |  Maps produced at 1:2500 scale are Geo-Schematics which show LV mains cables and overhead lines (in some cases all voltages). Prior to carrying out excavations you must refer to the 1:500 records to determine the location of all known underground plant and equipment. | ALWAYS LOOK UP BEFORE YOU START WORK Refer to HSE Guidance note GS6 | | | |
| Date Requested: 12/12/2018 Job Reference: 14403097 Site Location: 522190 135538 Requested by: Mr Gareth Adam Your Scheme/Reference: West of Ifield - 4 of 13 Scale: 1:500 (When plotted at A3) | | | | | | | |
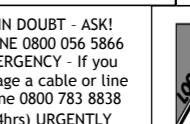
| | | | | | | | |
|--|--|---|---|---|---|---|--|
| 0 | 25 | 50 | Dig Sites | Area:  Line:  | The quality and accuracy of any print will depend on your printer, your computer and its print settings. Measurements scaled from this plan may not match measurements between the same points on the ground. |  |  |
| This plan must be used with the attached 'Symbols' document. | 1. The position of the apparatus shown on this drawing is believed to be correct but the original landmarks may have been altered since the apparatus was installed. 2. The exact position of the apparatus should be verified - use approved cable avoidance tools prior to excavation using suitable hand tools. 3. It is essential that trial holes are carefully made avoiding the use of mechanical tools or picks until the exact location of all the cables have been determined. 4. It must be assumed that there is a service cable into each property, lamp column and street sign, etc. 5. All cables must be treated as being live unless proved otherwise by UK Power Networks. 6. The information proved must be given to all people working near UK Power Networks plant and equipment. Do not use plans more than 3 months after the issue date for excavation purposes. 7. Please be aware that electric cables/lines belonging to other owners of licensed electricity distribution systems may be present and it is your responsibility to identify their location. | 1. UK Power Networks does not warrant that the information provided to you is correct. You rely upon it at your own risk. 2. UK Power Networks does not exclude or limit its liability if it causes the death of any persons or causes personal injury to a person. 3. Subject to paragraph 2 UK Power Networks has no liability to you in contract, in tort (including negligence), for breach of statutory duty or otherwise for any loss, damage, cost, claims, demands, or expenses that you or any third party may suffer or incur as a result of using the information provided whether for physical damage to property or for any economic loss (including without limitation loss of profit, loss of opportunity, loss of savings, loss of goodwill, loss of business, loss of use) or any special or consequential loss or damage whatsoever. 4. This plan has been provided to you on the basis of the terms of use set out in the covering letter that accompanies this plan. If you do not accept and/or do not understand the terms of use set out in the covering letter you must not use the plan and must return it to the sender of the letter. 5. You are responsible for the security of the information provided to you. It must not be given, sold or made available upon payment of a fee to a third party. |  | ALWAYS LOOK UP BEFORE YOU START WORK Refer to HSE Guidance note GS6 | | | |
| Date Requested: 12/12/2018 Job Reference: 14403097 Site Location: 522190 135538 Requested by: Mr Gareth Adam Your Scheme/Reference: West of Ifield - 4 of 13 Scale: 1:500 (When plotted at A3) | | | | | | | Maps produced at 1:2500 scale are Geo-Schematics which show LV mains cables and overhead lines (in some cases all voltages). Prior to carrying out excavations you must refer to the 1:500 records to determine the location of all known underground plant and equipment. |

 



0 25 50
metres

This plan must be used with the attached 'Symbols' document.

Date Requested: 12/12/2018
Job Reference: 14403097
Site Location: 522190 135538
Requested by:
Mr Gareth Adam

Your Scheme/Reference: West of Ifield - 4 of 13
Scale: 1:500 (When plotted at A3)

Dig Sites

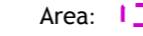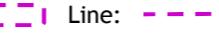Area:  Line: 

The quality and accuracy of any print will depend on your printer, your computer and its print settings. Measurements scaled from this plan may not match measurements between the same points on the ground.

1. The position of the apparatus shown on this drawing is believed to be correct but the original landmarks may have been altered since the apparatus was installed.
2. The exact position of the apparatus should be verified - use approved cable avoidance tools prior to excavation using suitable hand tools.
3. It is essential that trial holes are carefully made avoiding the use of mechanical tools or picks until the exact location of all the cables have been determined.
4. It must be assumed that there is a service cable into each property, lamp column and street sign, etc.
5. All cables must be treated as being live unless proved otherwise by UK Power Networks.
6. The information proved must be given to all people working near UK Power Networks plant and equipment. Do not use plans more than 3 months after the issue date for excavation purposes.
7. Please be aware that electric cables/lines belonging to other owners of licensed electricity distribution systems may be present and it is your responsibility to identify their location.
1. UK Power Networks does not warrant that the information provided to you is correct. You rely upon it at your own risk.
2. UK Power Networks does not exclude or limit its liability if it causes the death of any persons or causes personal injury to a person.
3. Subject to paragraph 2 UK Power Networks has no liability to you in contract, in tort (including negligence), for breach of statutory duty or otherwise for any loss, damage, cost, claims, demands, or expenses that you or any third party may suffer or incur as a result of using the information provided whether for physical damage to property or for any economic loss (including without limitation loss of profit, loss of opportunity, loss of savings, loss of goodwill, loss of business, loss of use) or any special or consequential loss or damage whatsoever.
4. This plan has been provided to you on the basis of the terms of use set out in the covering letter that accompanies this plan. If you do not accept and/or do not understand the terms of use set out in the covering letter you must not use the plan and must return it to the sender of the letter.
5. You are responsible for the security of the information provided to you. It must not be given, sold or made available upon payment of a fee to a third party.



IF IN DOUBT - ASK!
PHONE 0800 056 5866
EMERGENCY - If you
damage a cable or line
Phone 0800 783 8838
(24hrs) URGENTLY



ALWAYS LOOK UP
BEFORE
YOU START WORK
Refer to HSE
Guidance note GS6

Maps produced at 1:2500 scale are Geo-Schematics which show LV mains cables and overhead lines (in some cases all voltages). Prior to carrying out excavations you must refer to the 1:500 records to determine the location of all known underground plant and equipment.