



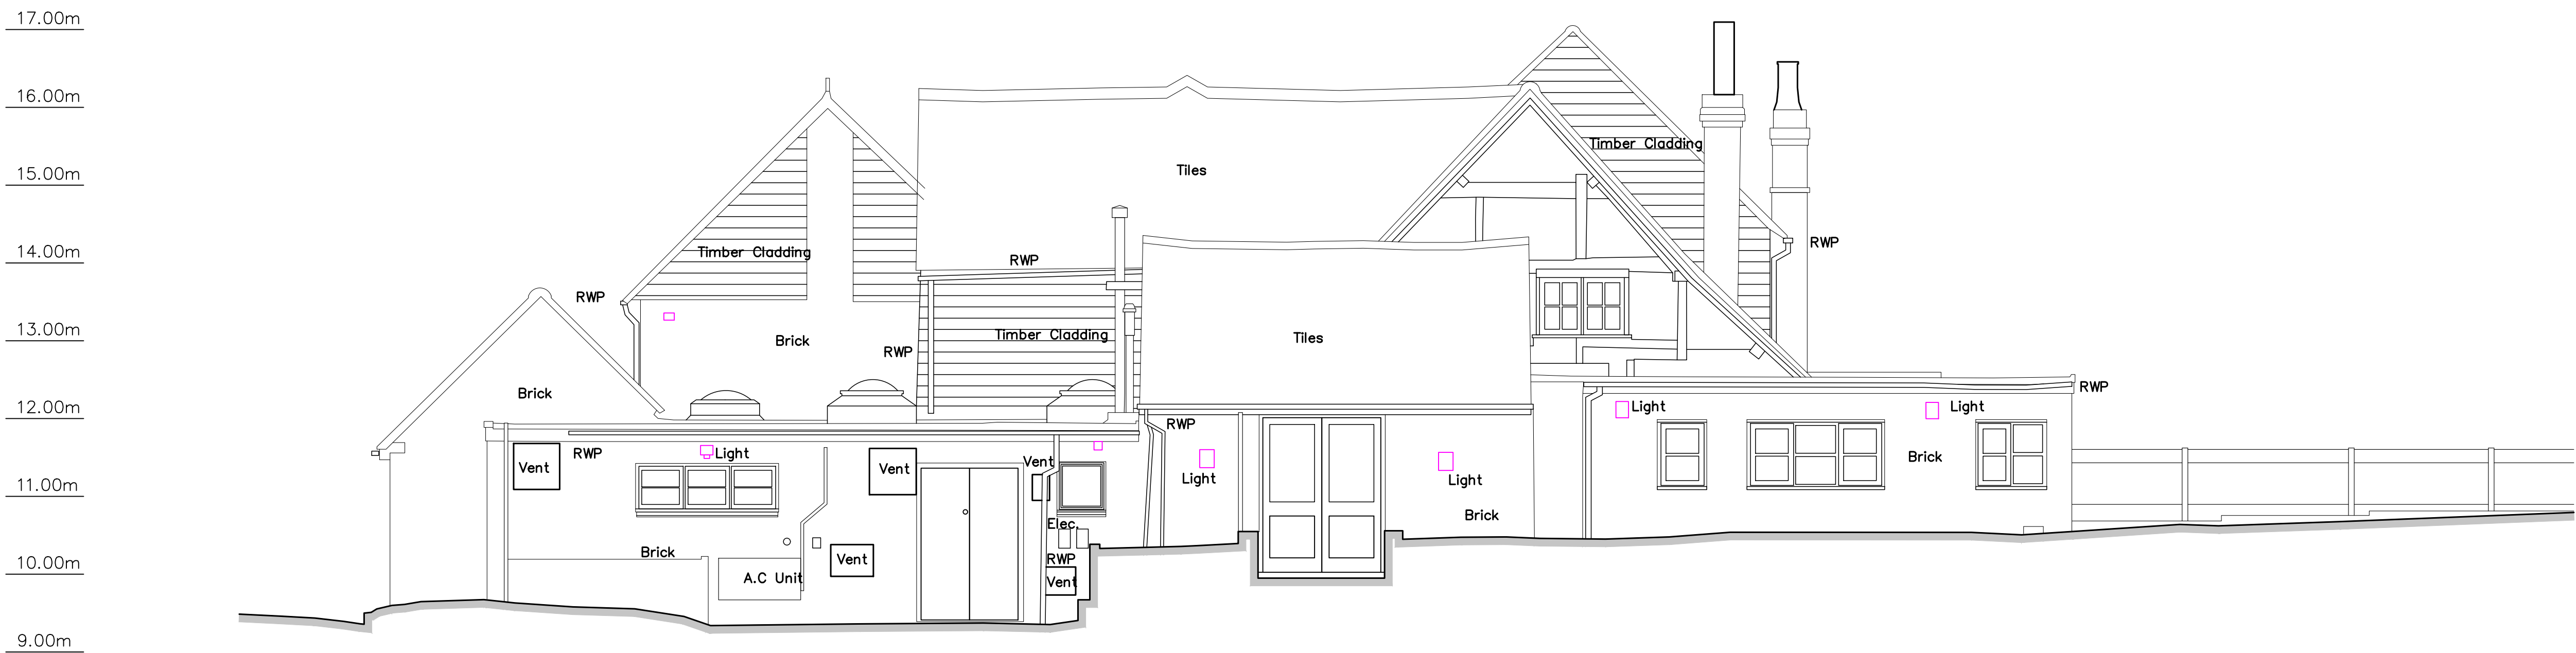


EXISTING AS BUILT WEST ELEVATION

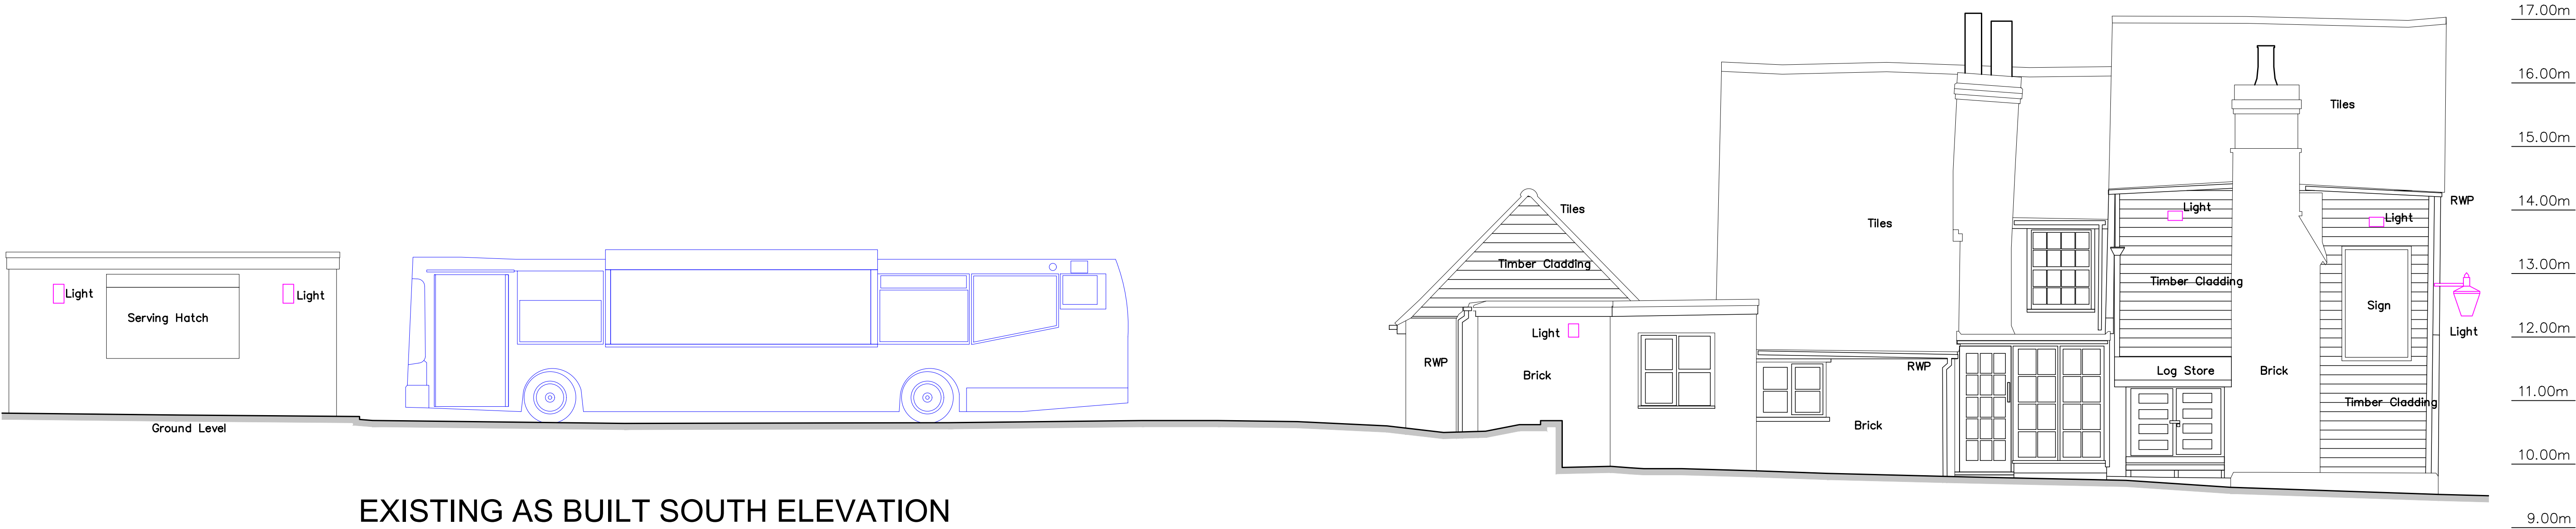

EXISTING AS BUILT SOUTH ELEVATION

Note:
All levels and dimensions are to be checked on site.
This drawing is to be read in conjunction with all relevant
consultants' requirements, drawings and specifications.
Any discrepancies between consultants' drawings to be reported
to the Contract Administrator before any relevant work
commences.

Copyright: 2022 Eye For Detail Architects ©

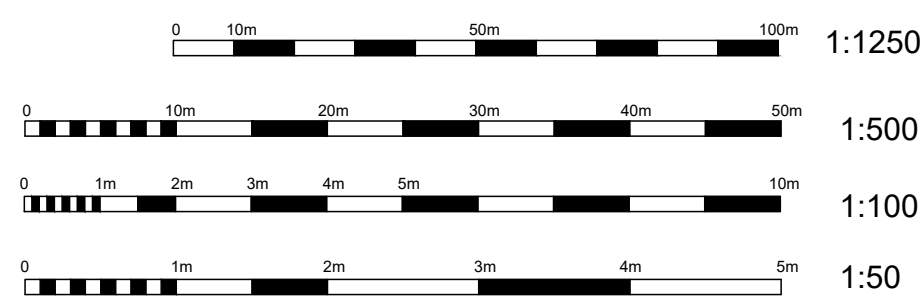

SURVEY EXISTING AS BUILT

Andrew Keeley
The Tipsy Pub Co LTD,
Worthing Road, Southwater, RH13 9H
EN/21/0093 Correct The Unauthorised Planning Breach
For A Listed Building
Existing As Built West & South Elevations

Scale 1:50, 1:500 Job 4080 Dwg AD07 Rev A

Eye For Detail

ARCHITECTS

Oakwood House
North Heath Lane
Horsham
W. Sussex
RH12 5PJ

T: 01403 211868
Mob: 07540787365
info@elfdarchitects.co.uk
info@elfdarchitects.com
www.elfdarchitects.co.uk

RIBA arb