


9.00m



SURVEY EXISTING AS BUILT

Copyright: 2022 Eye For Detail Architects ©

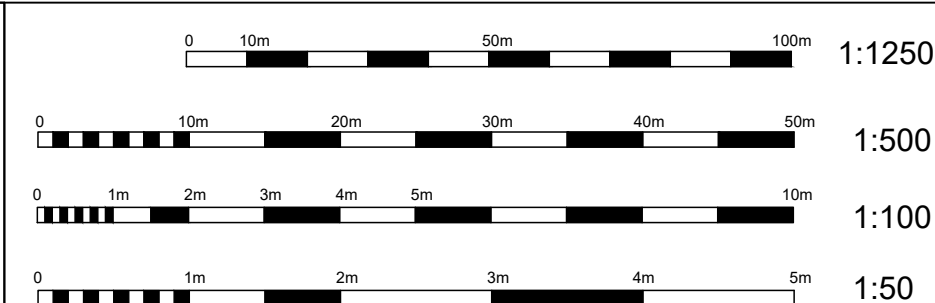

Scale 1:50	Job 4080	Dwg AD08
---------------	-------------	-------------

ARCHITECTS
Oakwood House
North Heath Lane
Horsham
W. Sussex
RH12 5PJ

T: 01403 211868
Mob: 07540787365
info@efdarchitects.co.uk
www.efdashitects.com
www.efdashitects.co.uk