



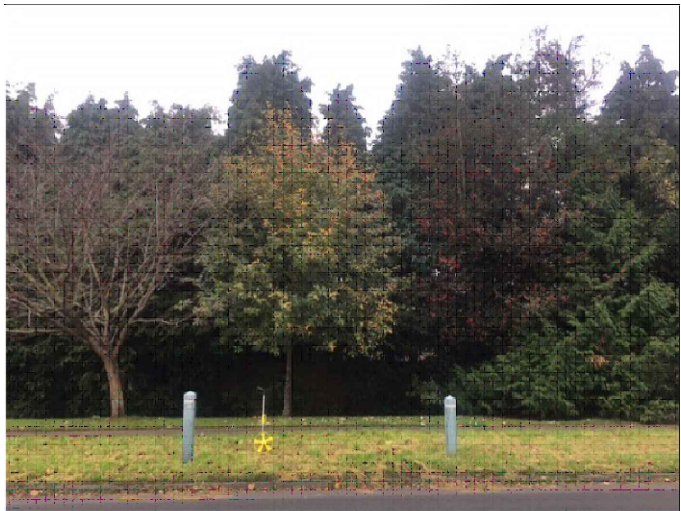


Reproduced by permission of Ordnance Survey on behalf of the Controller of Her Majesty's Stationery Office
All rights reserved. © Crown Copyright licence no. 100022432

SITE AREA PLAN


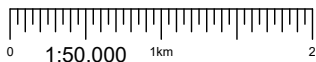


SITE PHOTOGRAPH

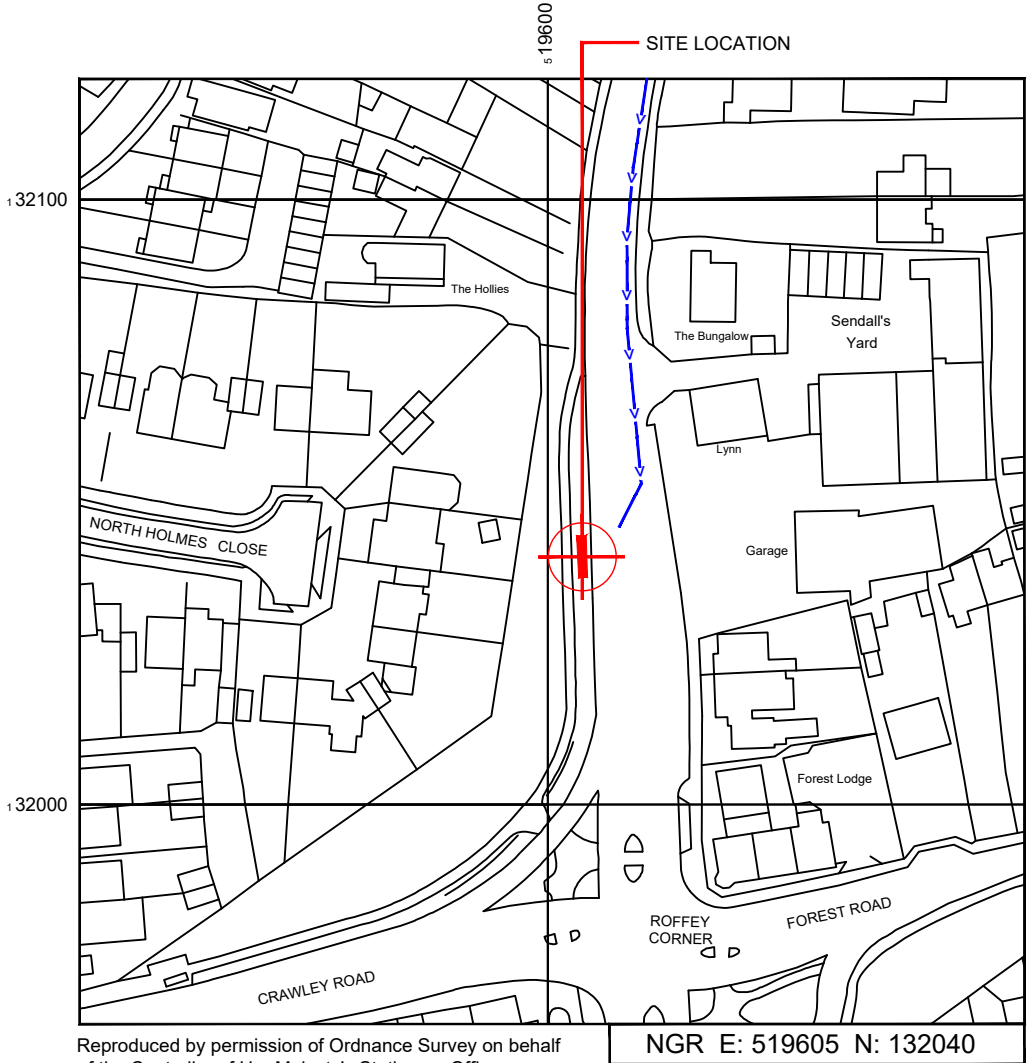

Reproduced by permission of Ordnance Survey on behalf of the Controller of Her Majesty's Stationery Office
All rights reserved. © Crown Copyright licence no. 100022432

SITE LOCATION PLAN

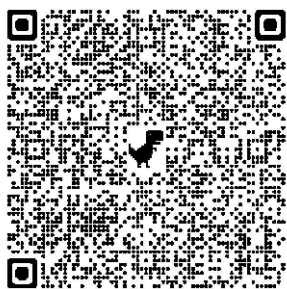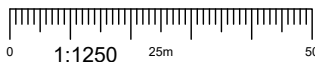

GOOGLE MAPS QR CODE

GOOGLE MAPS - <https://goo.gl/maps/hupsCz6grn1gqbn66>

GOOGLE STREETVIEW - <https://goo.gl/maps/wWZVN6hKAPAMYsty5>

NOTES:

DIRECTIONS TO SITE:
EXIT M25 AT J7 TAKE THE M23(S) EXIT TO BRIGHTON/GATWICK
ARPT, MERGE ONTO M23 AT J11 TAKE THE A264 EXIT TO
HORSHAM/PEASE POTTAGE SERVICES, AT PEASE POTTAGE
INTERCHANGE TAKE THE 3rd EXIT ONTO A264 AT THE 5th
ROUNDBOUT TAKE THE 1st EXIT ONTO CRAWLEY RD/B2195 THE
SITE IS ON THE RIGHT BEFORE THE FOREST RD JUNCTION

Site Provider's
Property Boundary:



Access Route To Site:



Access Route:



Master:	MBNL / EE / H3G:	Project:	Purpose of Issue:	Issue:
M001	H3G	DENSIFICATION SW	AS BUILT	AB
Date:	11/04/2024	Revision / Upgrade Description:		
Drawn:	J.Kalushu	First Issue		
Checked:	S.Gondal			
Approved:	S.Gondal			



Hutchison 3G UK Limited
Green Park, 450 Longwater Avenue
Reading, RG30 3UR
Tel: 01628 765 000
Fax: 01628 765 001

H3G Base Station Information line:
0845 6043000
Available 8am-8pm Monday to Friday

Design Consultant & Principal Contractor:



Unit E, Madison Place, Northampton Road,
Manchester, M40 5AG
Tel: 0161 785 4500 Fax: 0161 785 4501
Web: www.clarke-telecom.com

Site Name:	CRAWLEY ROAD STREETWORKS		
Site ID:	HSM26499_B35		
Address:	B2195 CRAWLEY ROAD HORSHAM RH12 4HG		
Title:	002 SITE LOCATION PLAN		
Project:	H3G DENSIFICATION STREETWORKS		
Purpose of Issue:	AS BUILT		
EE Cell ID:	89615	MBNL Cell ID:	HSM116
3UK Cell ID:	RH1259		
Master Drawing No:	HSM26499_89615_HSM116_RH1259_M001_H3G_DNSW_AB		
Issue:	AB		