


SITE LOCATION




Reproduced by permission of Ordnance Survey on behalf of the Controller of Her Majesty's Stationery Office
All rights reserved. © Crown Copyright licence no. 100062043

SITE AREA PLAN

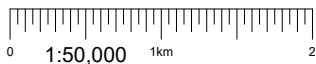


SITE PHOTOGRAPH

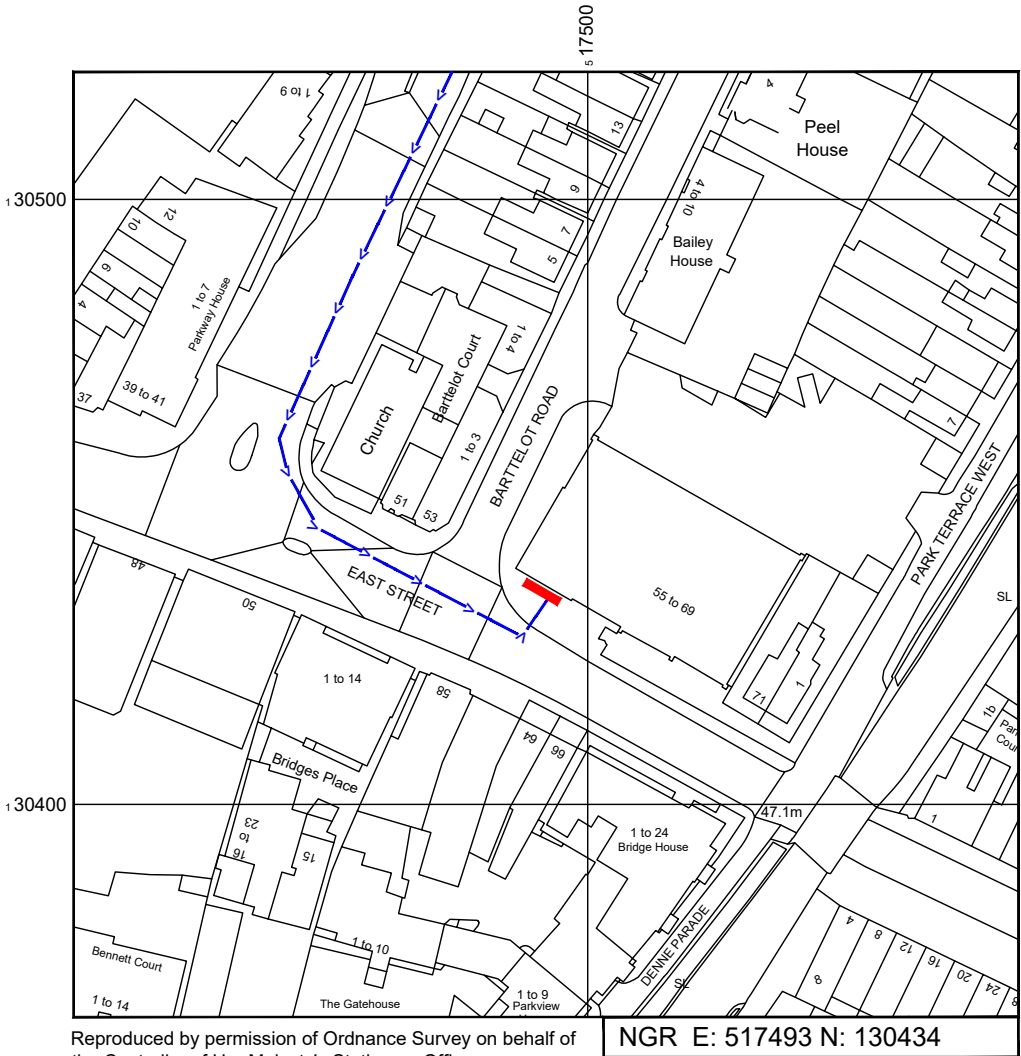

Reproduced by permission of Ordnance Survey on behalf of the Controller of Her Majesty's Stationery Office
All rights reserved. © Crown Copyright licence no. 100062043

NGR E: 517493 N: 130434

SITE LOCATION PLAN

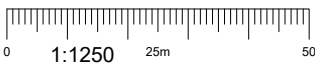

GOOGLE MAPS QR CODE

GOOGLE MAPS - <https://goo.gl/maps/4pY9s1G3ab9Gh5um6>

GOOGLE STREETVIEW - <https://goo.gl/maps/iASg31F2bq2f2ZKK8>

NOTES:

1. ALL DIMENSIONS IN MM UNLESS OTHERWISE NOTED.

DIRECTIONS TO SITE:

Head west on M23. At junction 11, take the A264 exit to Horsham/Pease Pottage Services. At Pease Pottage Interchange, take the 3rd exit onto A264. At Tollgate Hill Roundabout, take the 2nd exit and stay on A264. At the roundabout, take the 1st exit onto Horsham Rd/A264. At Kilnwood Vale Roundabout, take the 2nd exit onto Crawley Rd/A264. At the roundabout, take the 2nd exit and stay on Crawley Rd/A264. At Moorhead Roundabout, take the 1st exit onto Crawley Rd/B2195. At the roundabout, take the 2nd exit onto Harwood Rd/B2195. Turn left onto North S/B2195. Turn left onto Park Way/A281. Turn left onto East Street. Follow East Street and site location is on the left hand side.

Site Provider's
Property Boundary:



Access Route To Site:



Access Route:



Master:	MBNL / EE / H3G:	Project:	Purpose of Issue:	Issue:
M002	MBNL	3UK DNSW	As Built	AB1
Date:	17/12/22	Revision / Upgrade Description:		
Drawn:	CDN	As Built Issue		
Checked:	AF			
Approved:	AF			
Master:	MBNL / EE / H3G:	Project:	Purpose of Issue:	Issue:
M001	MBNL	3UK DNSW	Planning	A
Date:	26/04/2021	Revision / Upgrade Description:		
Drawn:	CDN	First Issue - Site nomination dated: TBC		
Checked:	DH			
Approved:	SD			

CK Hutchison
Networks (UK)
Limited

Great Brighams Mead,
Vastern Road, Reading,
Berkshire, England,
RG1 8DJ

Design Consultant & Principal Contractor:



WHP Telecoms

Unit 1 Maple Park,
Low Fields Avenue, Leeds
LS12 6HH

Tel: 01133023550
e-mail: info@whptelecoms.com

Site Name:	EAST STREET STREETWORKS		
Site ID:	HSM16223		
Address:	EAST STREET, NEW TOWN, HORSHAM, WEST SUSSEX, SOUTH EAST, RH12 1HR		
Title:	002 SITE LOCATION PLAN		
Project:	3UK DNSW		
Purpose of Issue:	AS BUILT		
EE Cell ID:	81430	MBNL Cell ID:	HSM109
3UK Cell ID:	RH0596		
Master Drawing No:	HSM16223_M002		Issue:
			AB1