



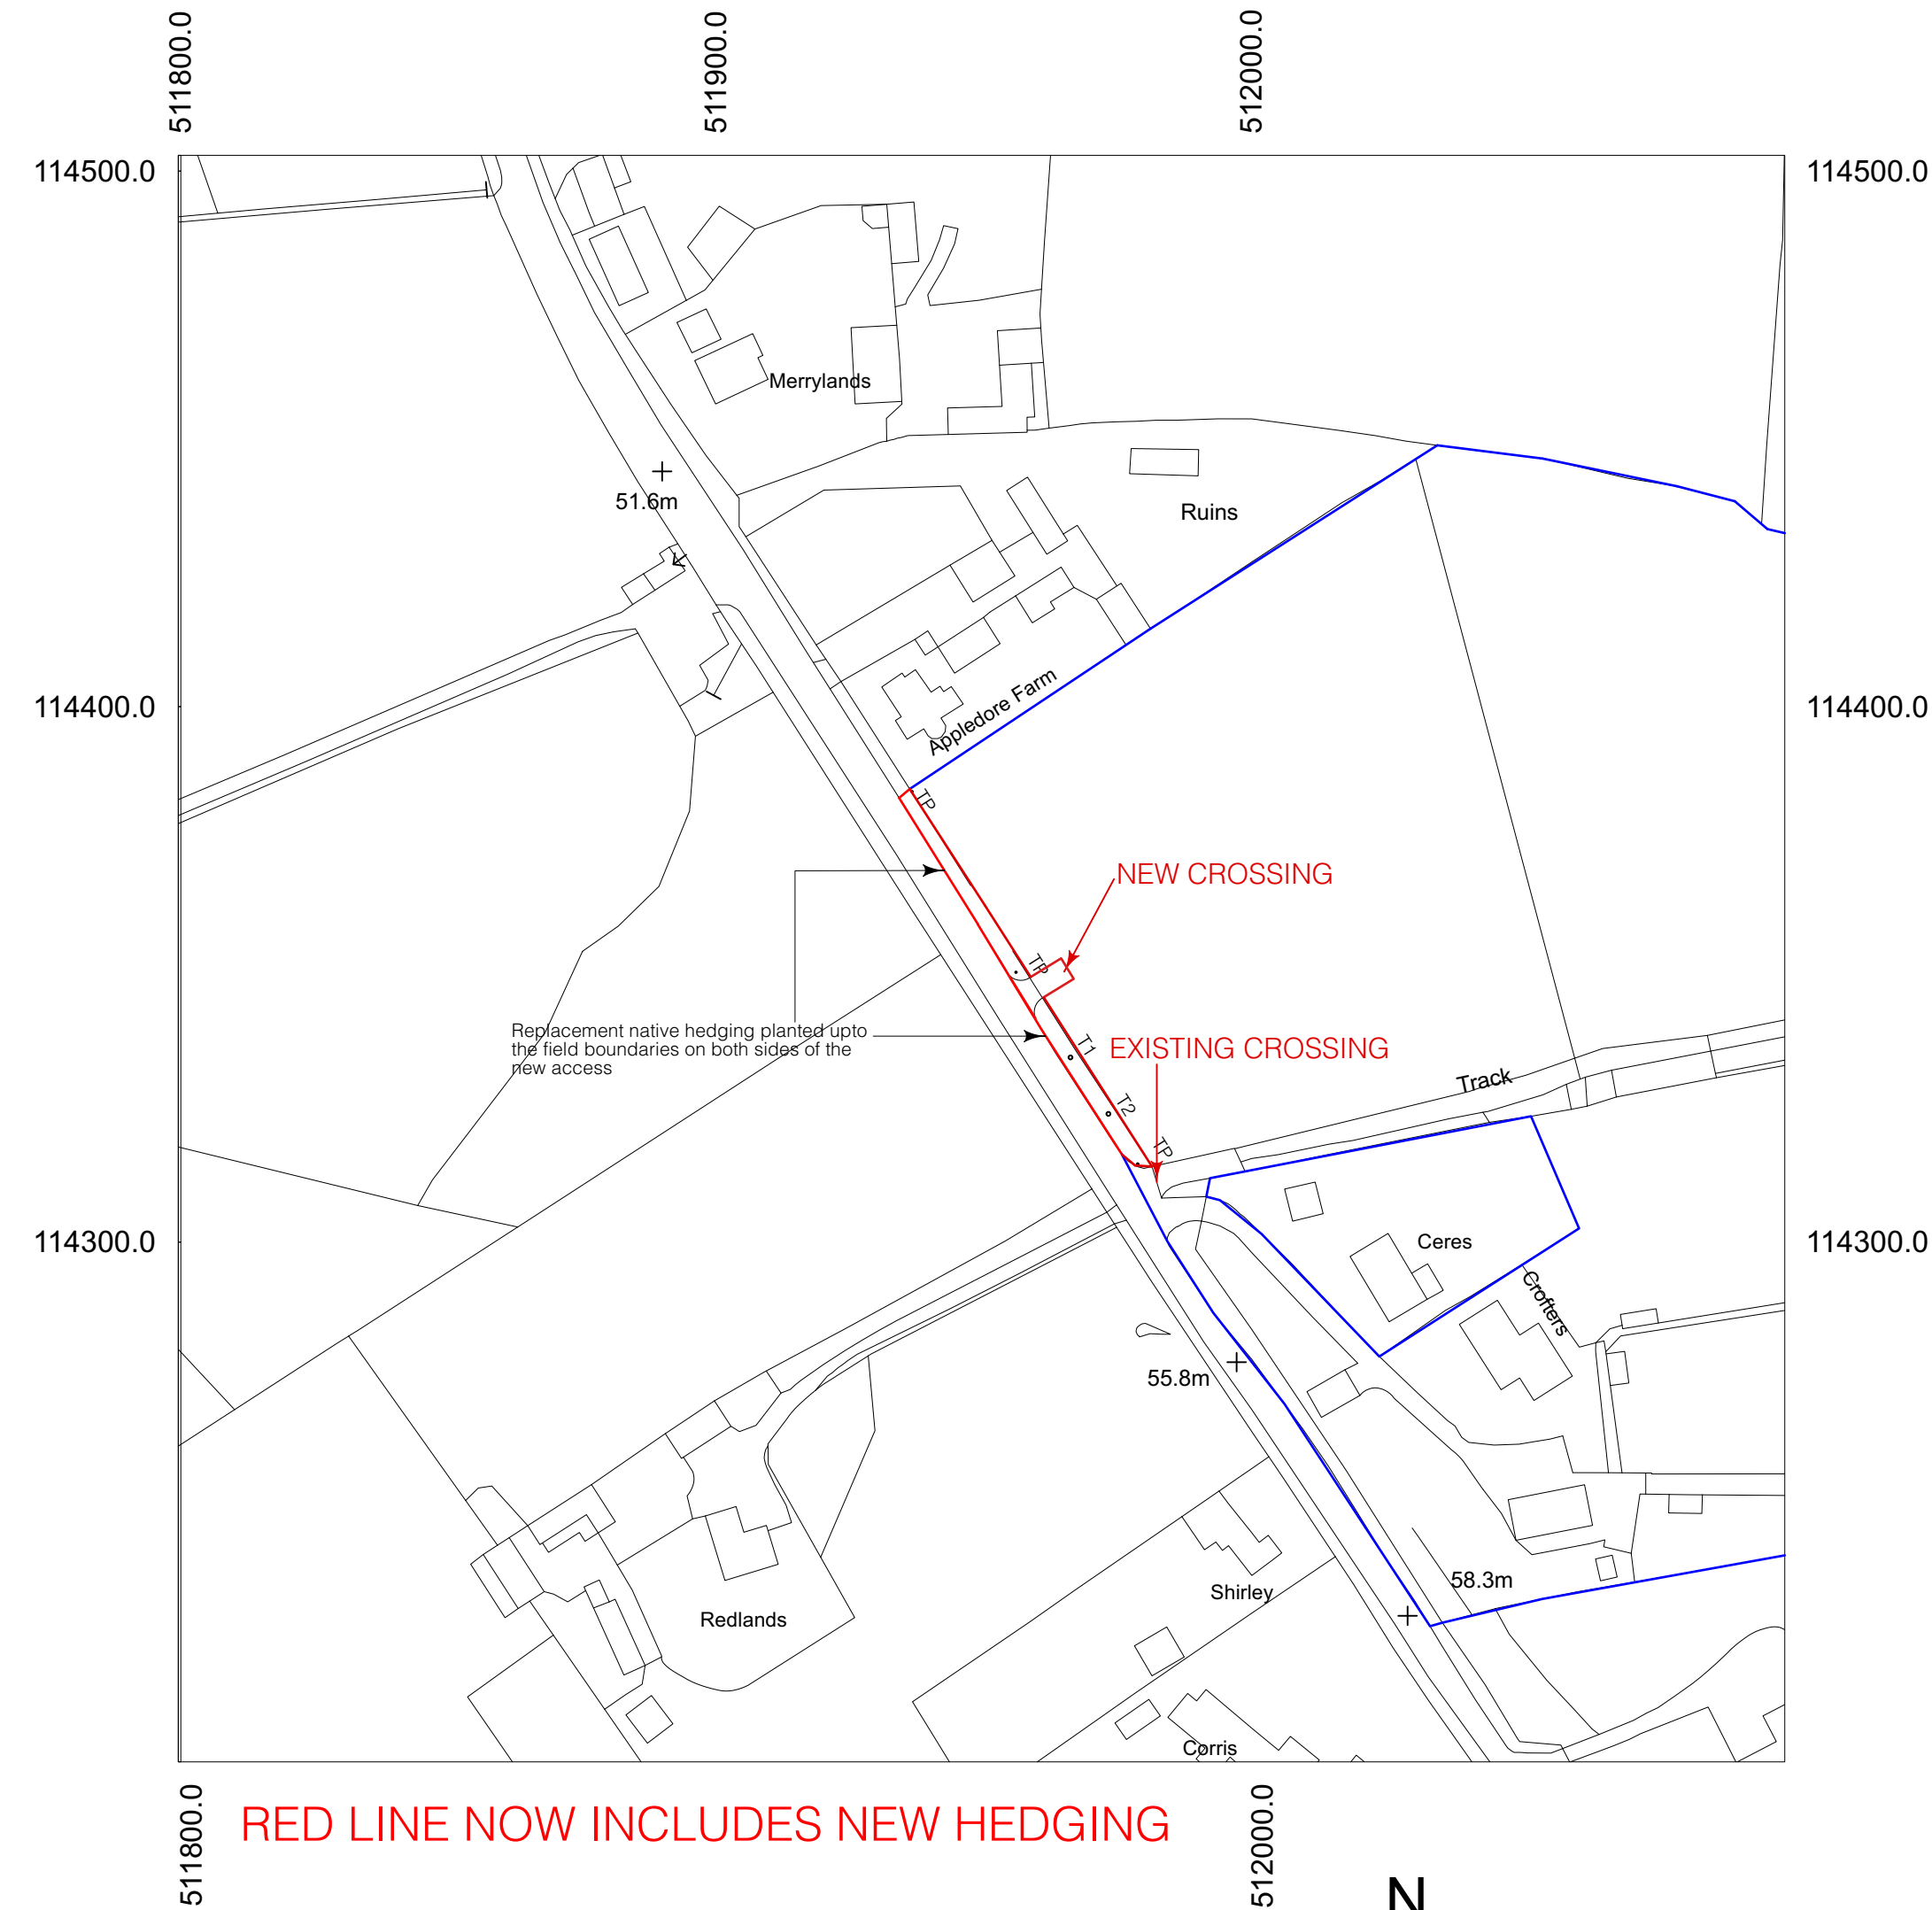

RED LINE NOW INCLUDES NEW HEDGING

Production Date: 21 August 2025
Top Left: 511799.523 114502.944 Bottom Right: 512099.523 114202.944
© Crown copyright and database rights 2025 Ordnance Survey AC0000824000.
Reproduction in whole or in part is prohibited without the permission of Ordnance Survey

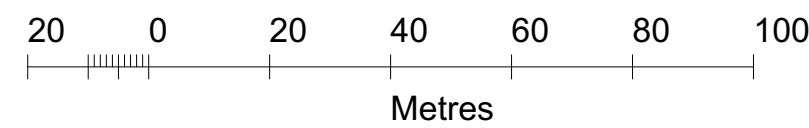

Sheet No: D 0825/765/01 C

Scales Page Size A1:
1:1250

Notes:

Project Name:
New Access of
Rock Road

Date: 21/08/2025

Client:
SEPS Ltd

Site Address:
Crofters
Rock Road
Thakeham
RH20 3BQ

PB
PROPERTIES
Paul Maggs MCIAI
Hazelwood, Harbottle Road,
West Chirlington RH20 2LG
Tel: 01796 813298
paul@pbproperties.co.uk
www.pbproperties.co.uk
Drawings produced using Vectorworks
CAD. Only written dimensions to be
respected. Copyright protected to
PB Properties

CIAT
CHARTERED PRACTICE