



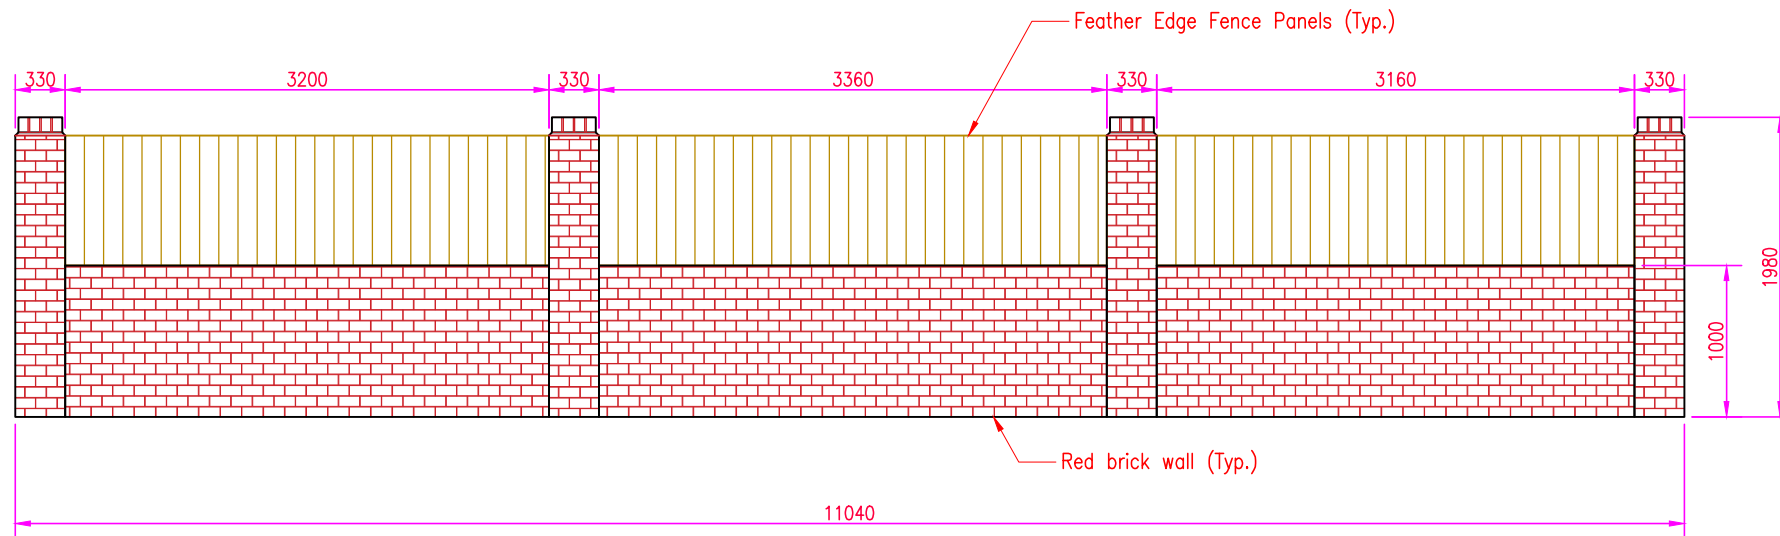

Wall Elevation

1:50

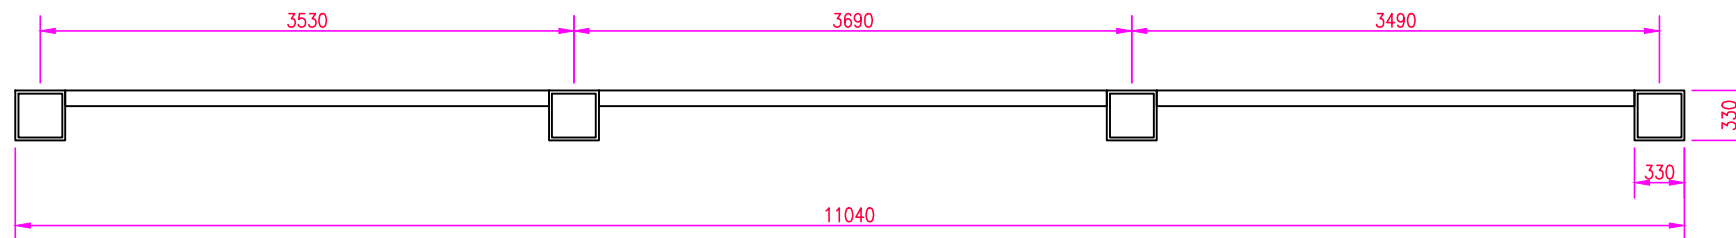

Wall Plan

1:50



1:50 Scale Bar

FOR PLANNING

18 Greenfields Way, Horsham, RH12 4LQ
Front Boundary Wall (As Built)

A	DRAWING TITLE UPDATED	07.08.26	DJS
-	FIRST ISSUE	08.08.26	DJS
REV:	REVISION:	REV DATE:	DRAWN:

Scale:
1:50
Date:
08.08.26

PA-001

Drawing No.
Sheet Size:
A3
Rev:
A