


Information contained within this drawing is the sole copyright of KPR Architects Ltd. and is not to be reproduced without express permission. No implied licence exists. This drawing not to be used for land transfer or valuation purposes. Do not scale from this drawing. All dimensions & levels are to be checked on site by the contractor. Issued for purposes indicated only. Drawing errors and omissions to be reported to the Architect.

Notes

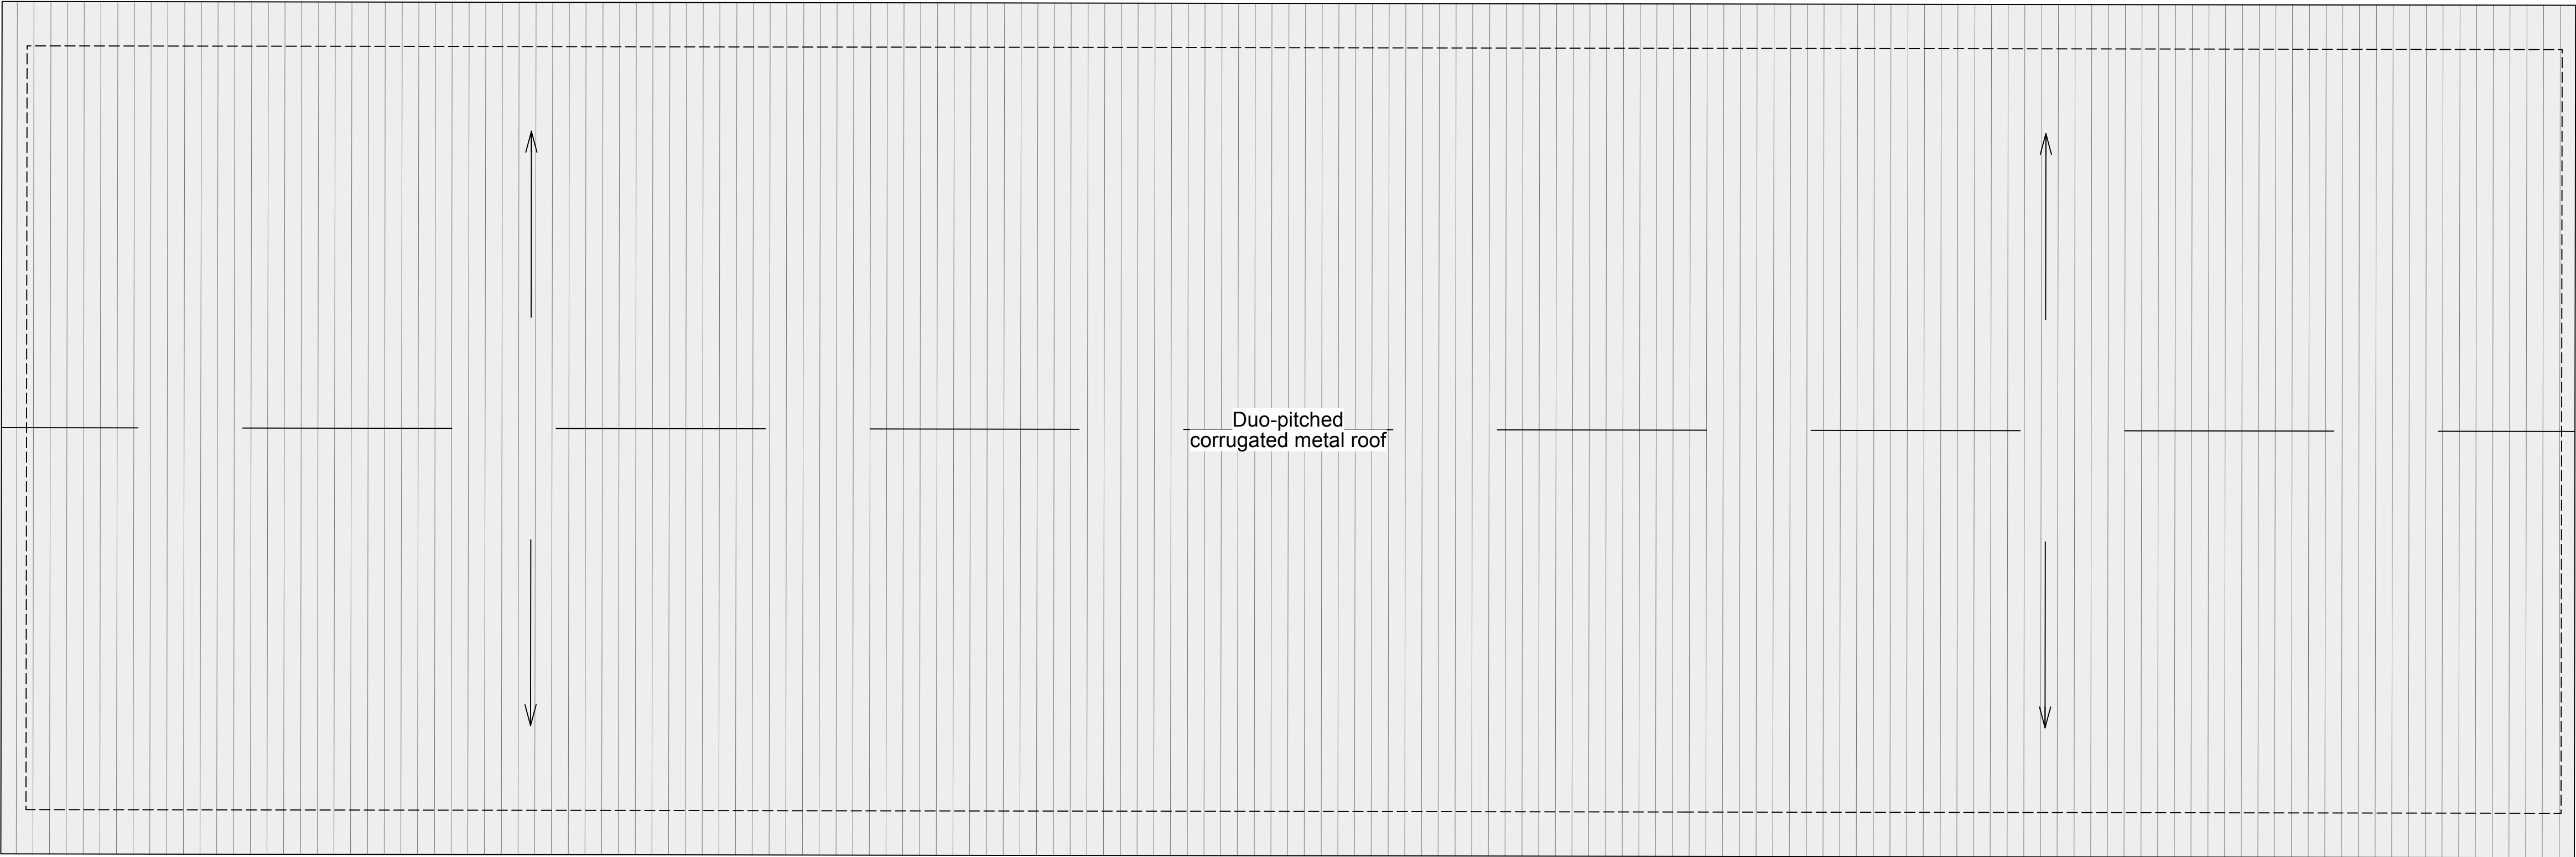

P3	16/04/2026	Issued for Planning
P2	26/03/2026	Issued for Planning
P1	21/04/2022	Issued for Planning

Revisions

KPR
Architects

KPR Architects
Bedford Heights
Brickhill Drive
Bedford MK41 7PH

info@kprarchitects.com
www.kprarchitects.com

Client
Hippo Golf Clubs Ltd

Project
Spinningwood Farm
Burnthouse Lane
Horsham RH13 6NN

Drawing Title
Proposed Roof Plan


Status Planning	Drawn MW	Checked PR
--------------------	-------------	---------------

Scale 1:50@A1 / 1:100@A3	Date 12/07/2021
-----------------------------	--------------------

Drawing No. & Revision 1119_GAR1_P3	Page No. 4
--	---------------

01 - Roof Plan - As Constructed

1:50@A1 / 1:100@A3

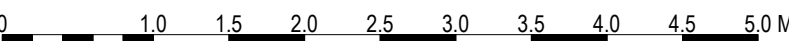

Drawing Notes:
1) Measured building survey based on survey undertaken in March 2026, following the construction of the industrial building.