



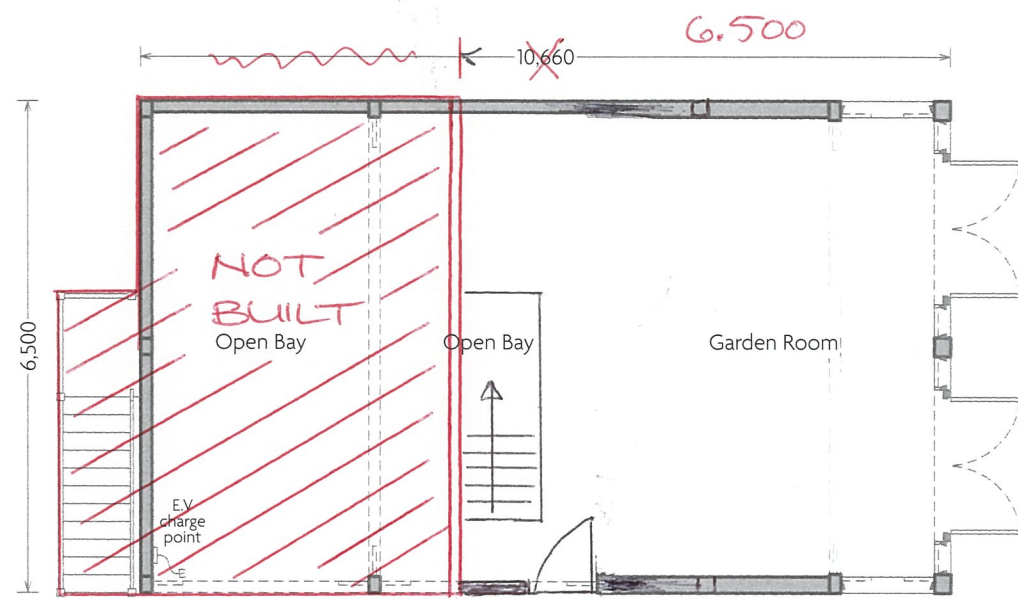


GROUND FLOOR PLAN

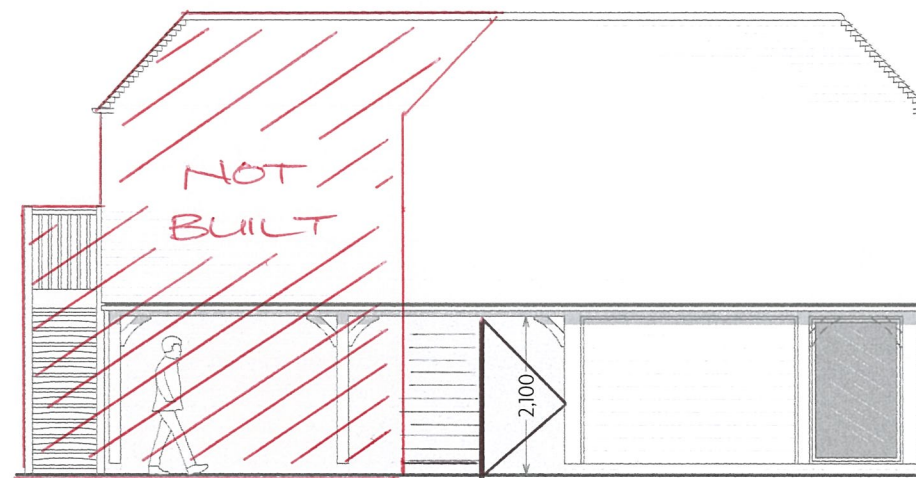


NORTH ELEVATION


2/3

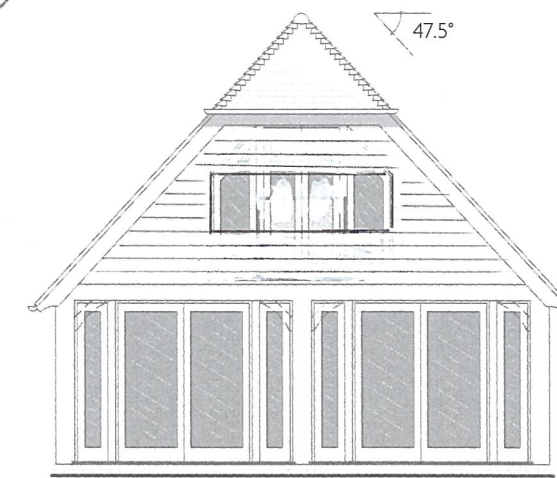


WEST ELEVATION

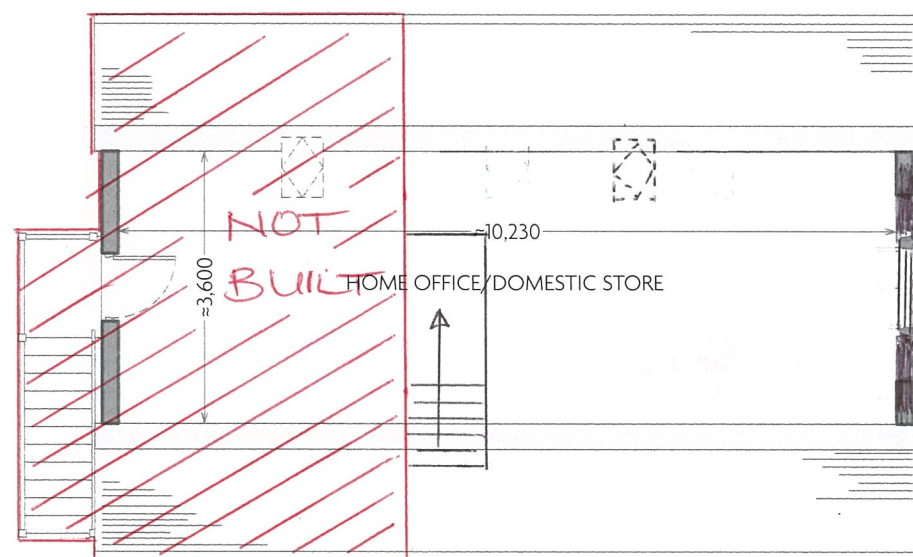

FIRST FLOOR PLAN

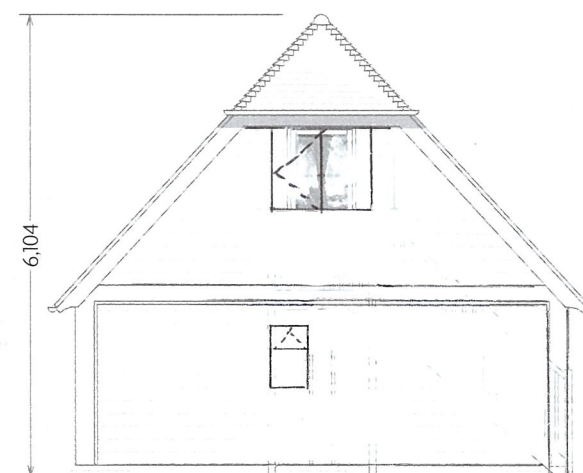

EAST ELEVATION

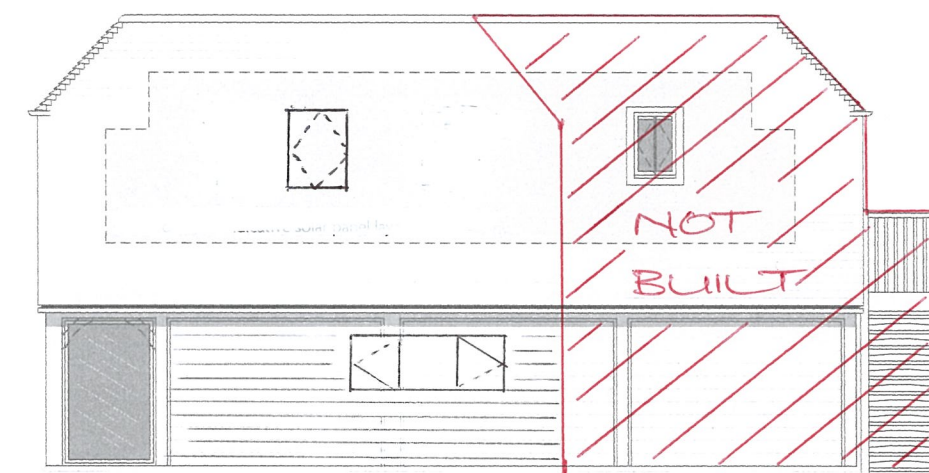

SOUTH ELEVATION



AS BUILT
DC/24/0235

Construction Notes

Roof Covering Clay tiles
Walls Feather edge weather boarded panels
Structure Traditionally jointed & pegged oak frame
Plinth Brickwork


Outbuilding at Lancasters Cottage . Littleworth Lane . Partridge Lane

for Mr & Mrs Brewer

FLOOR PLAN & ELEVATIONS

04/12/2023 • Original Issue

1 : 100 on A3 . 04/12/2023

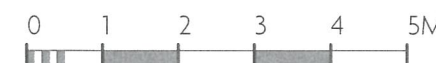

JS.124.00.

