
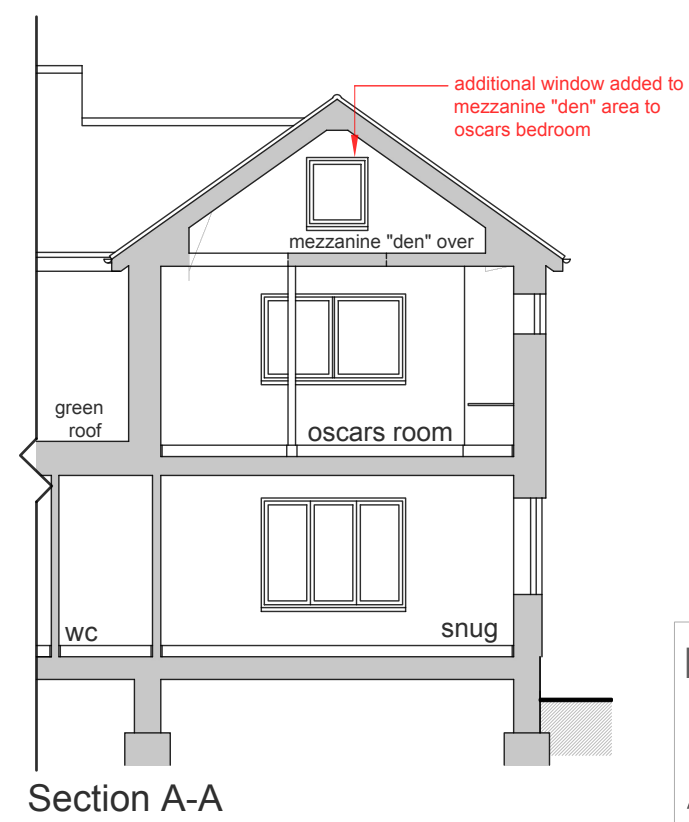
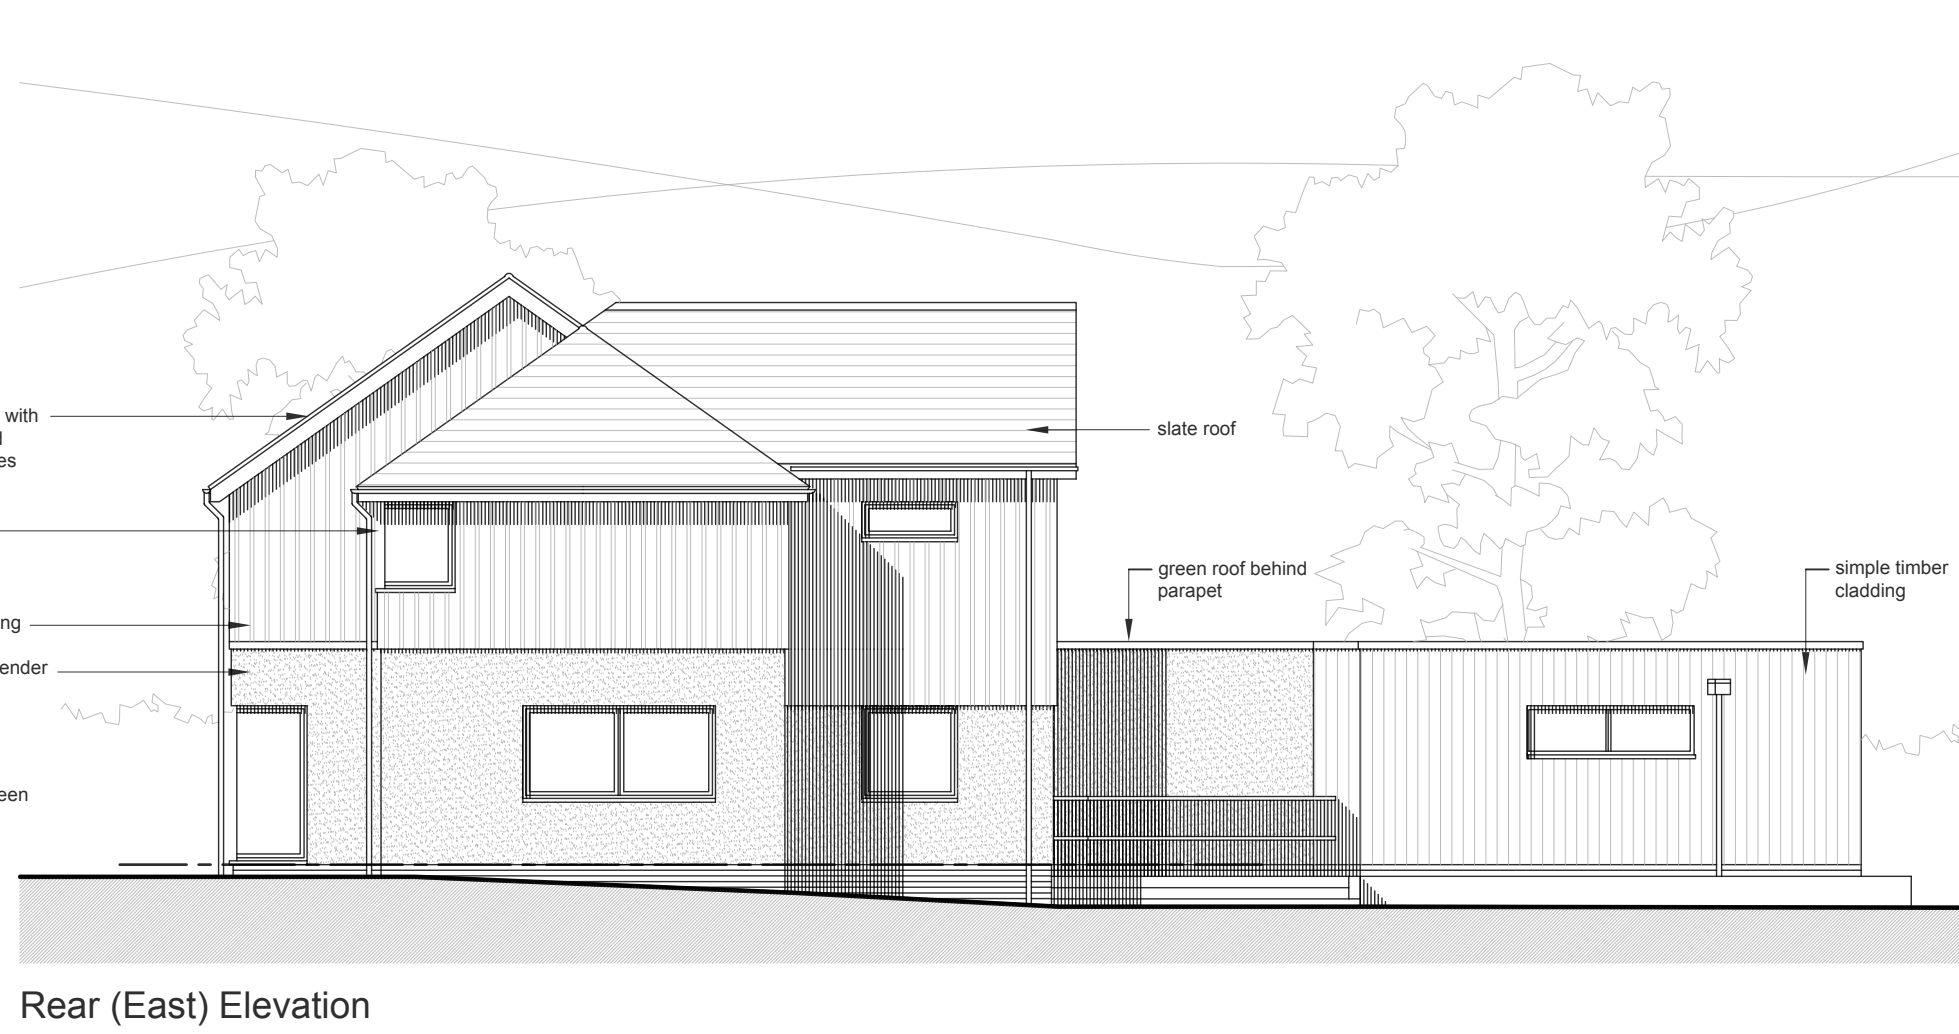
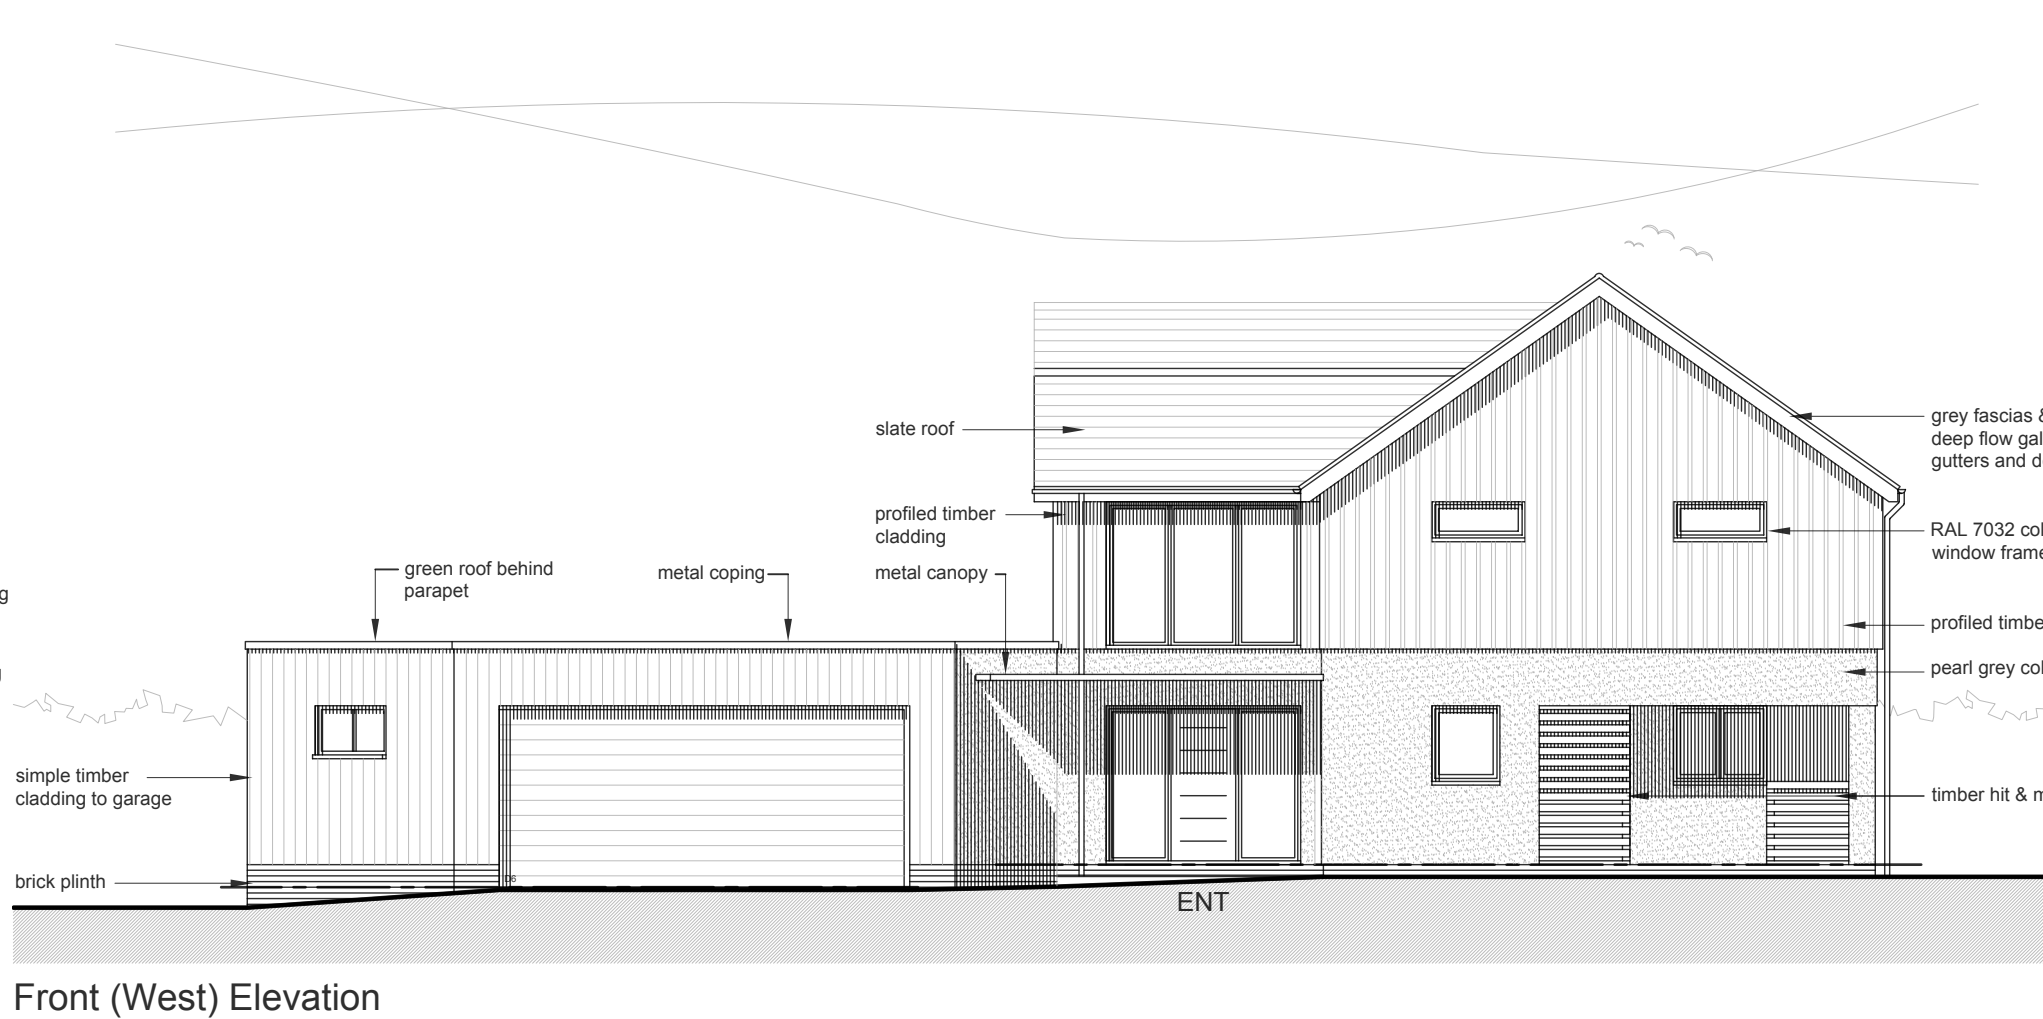
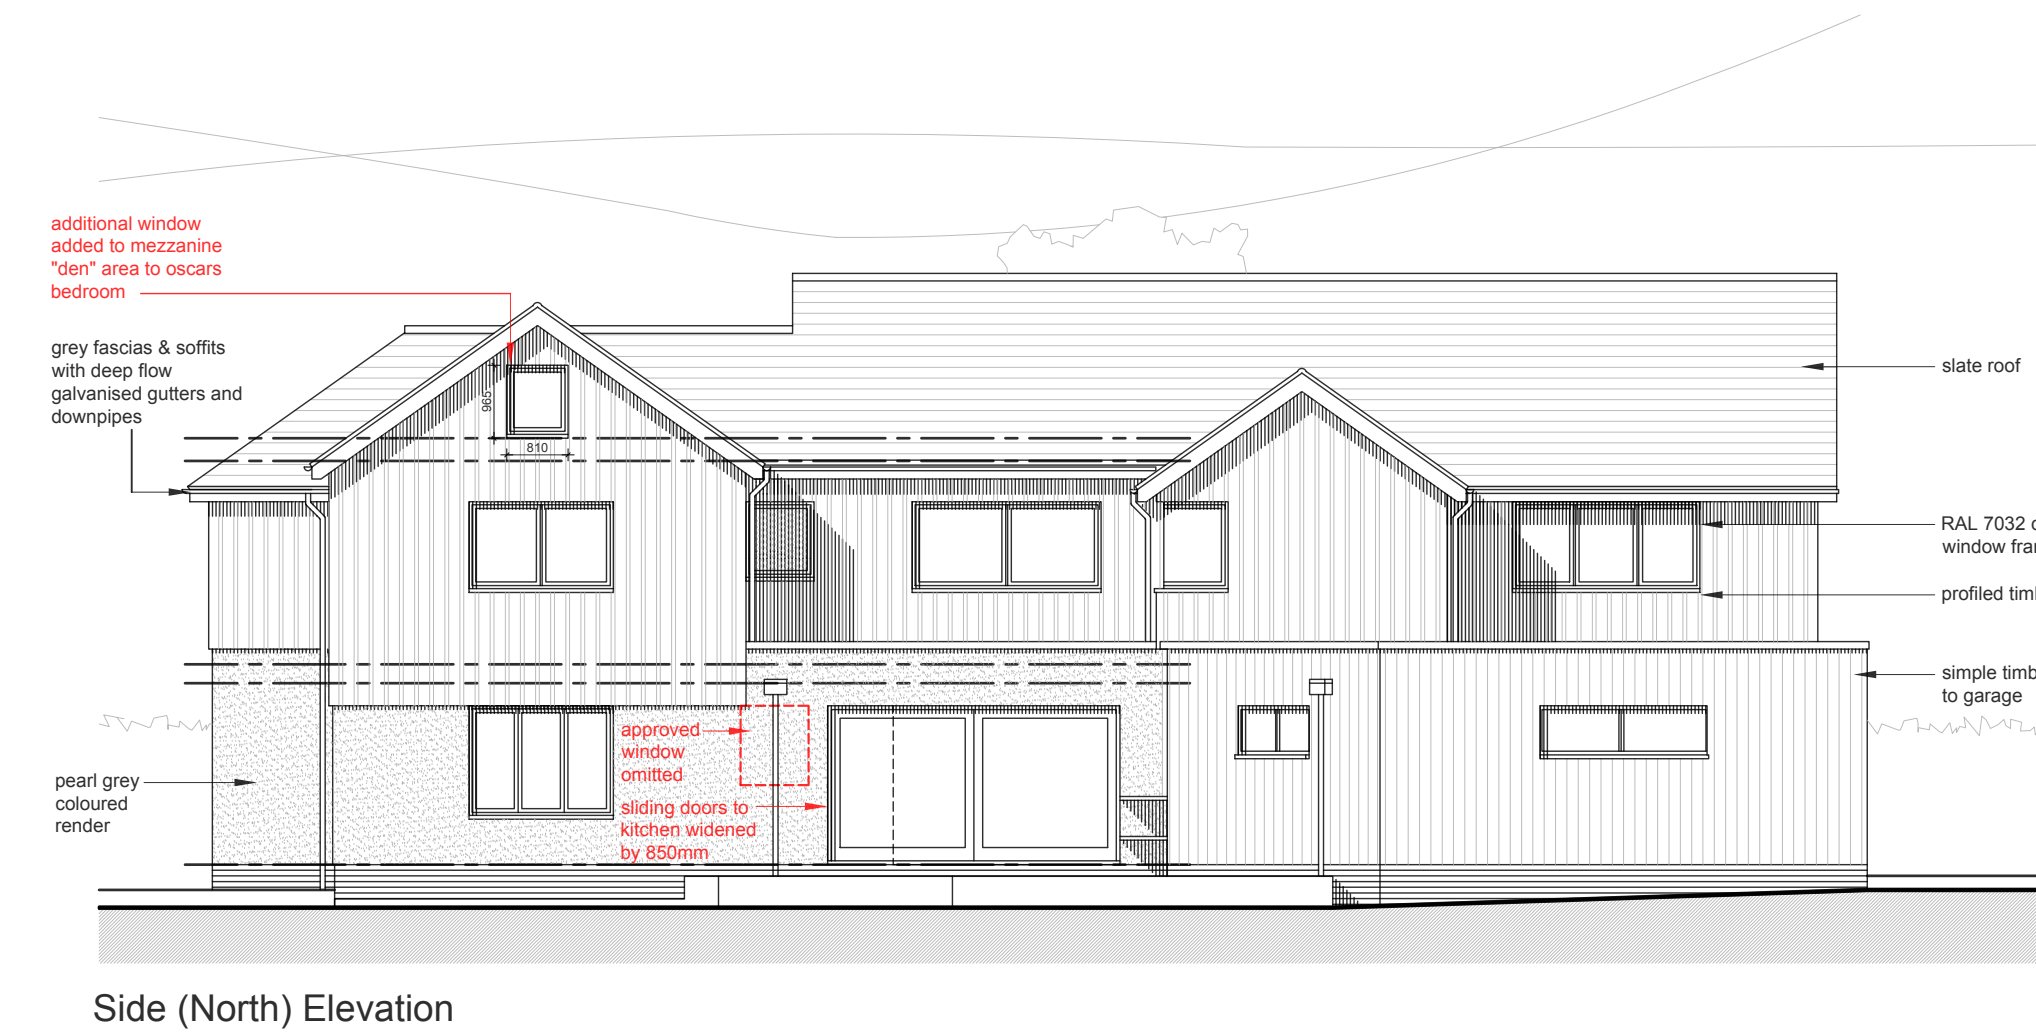
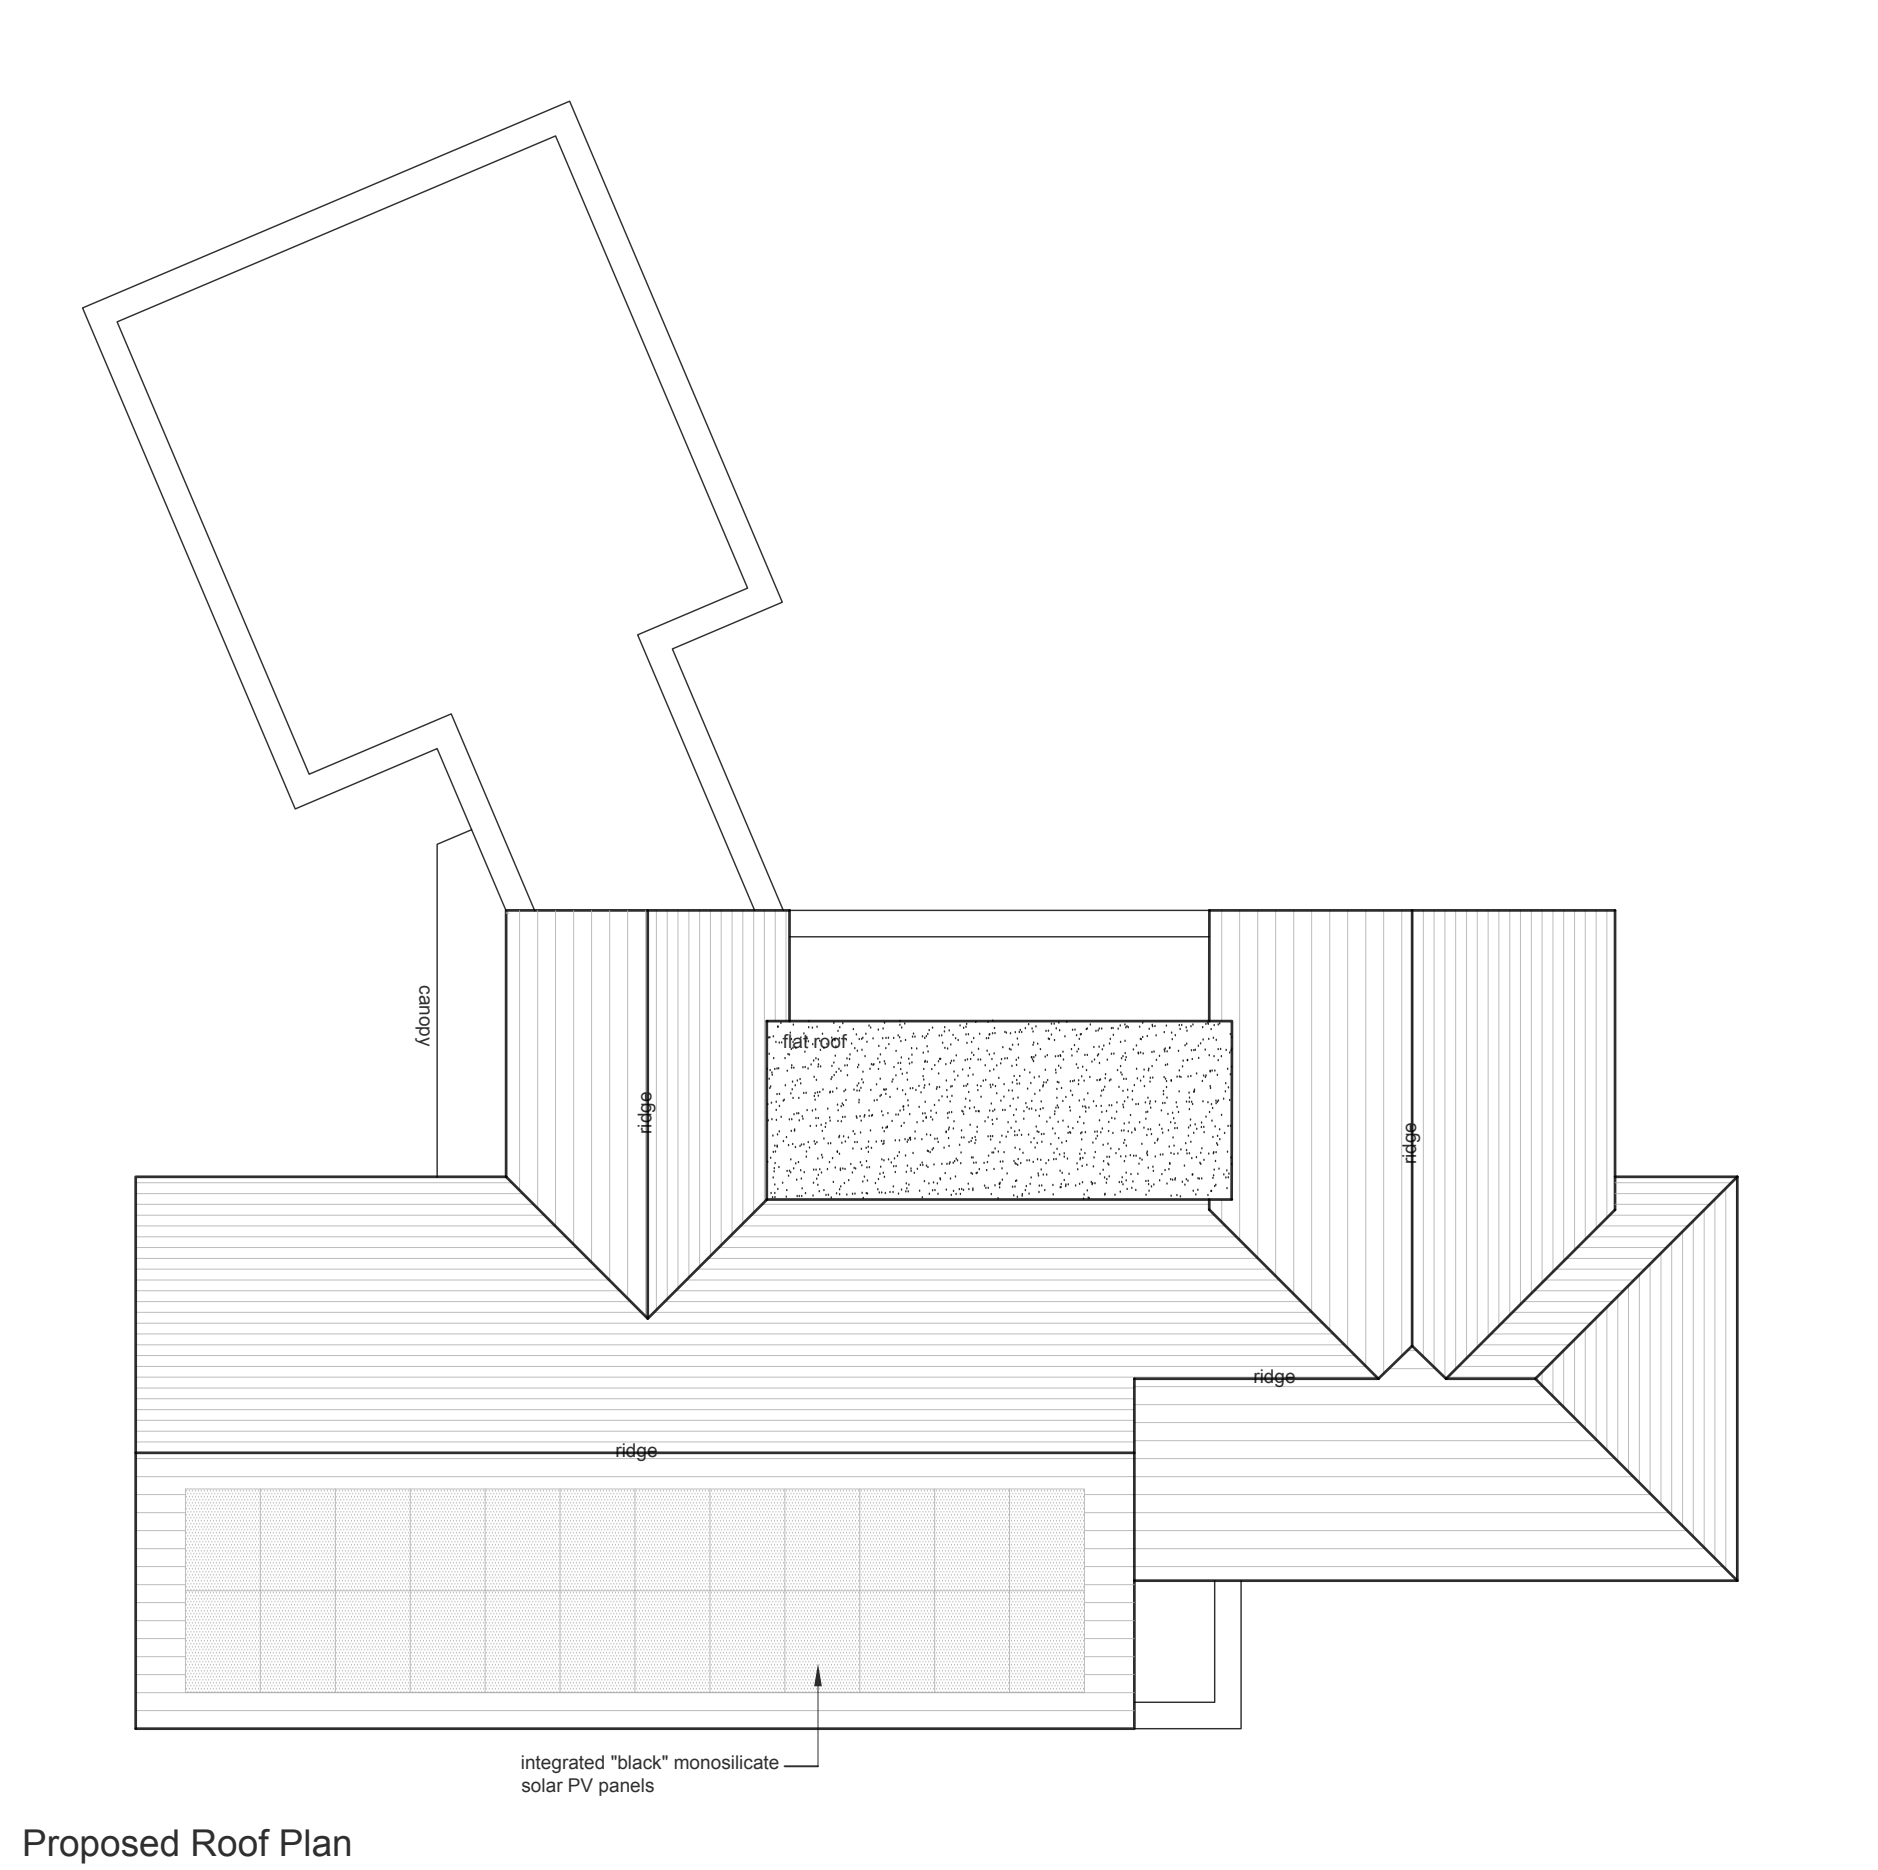
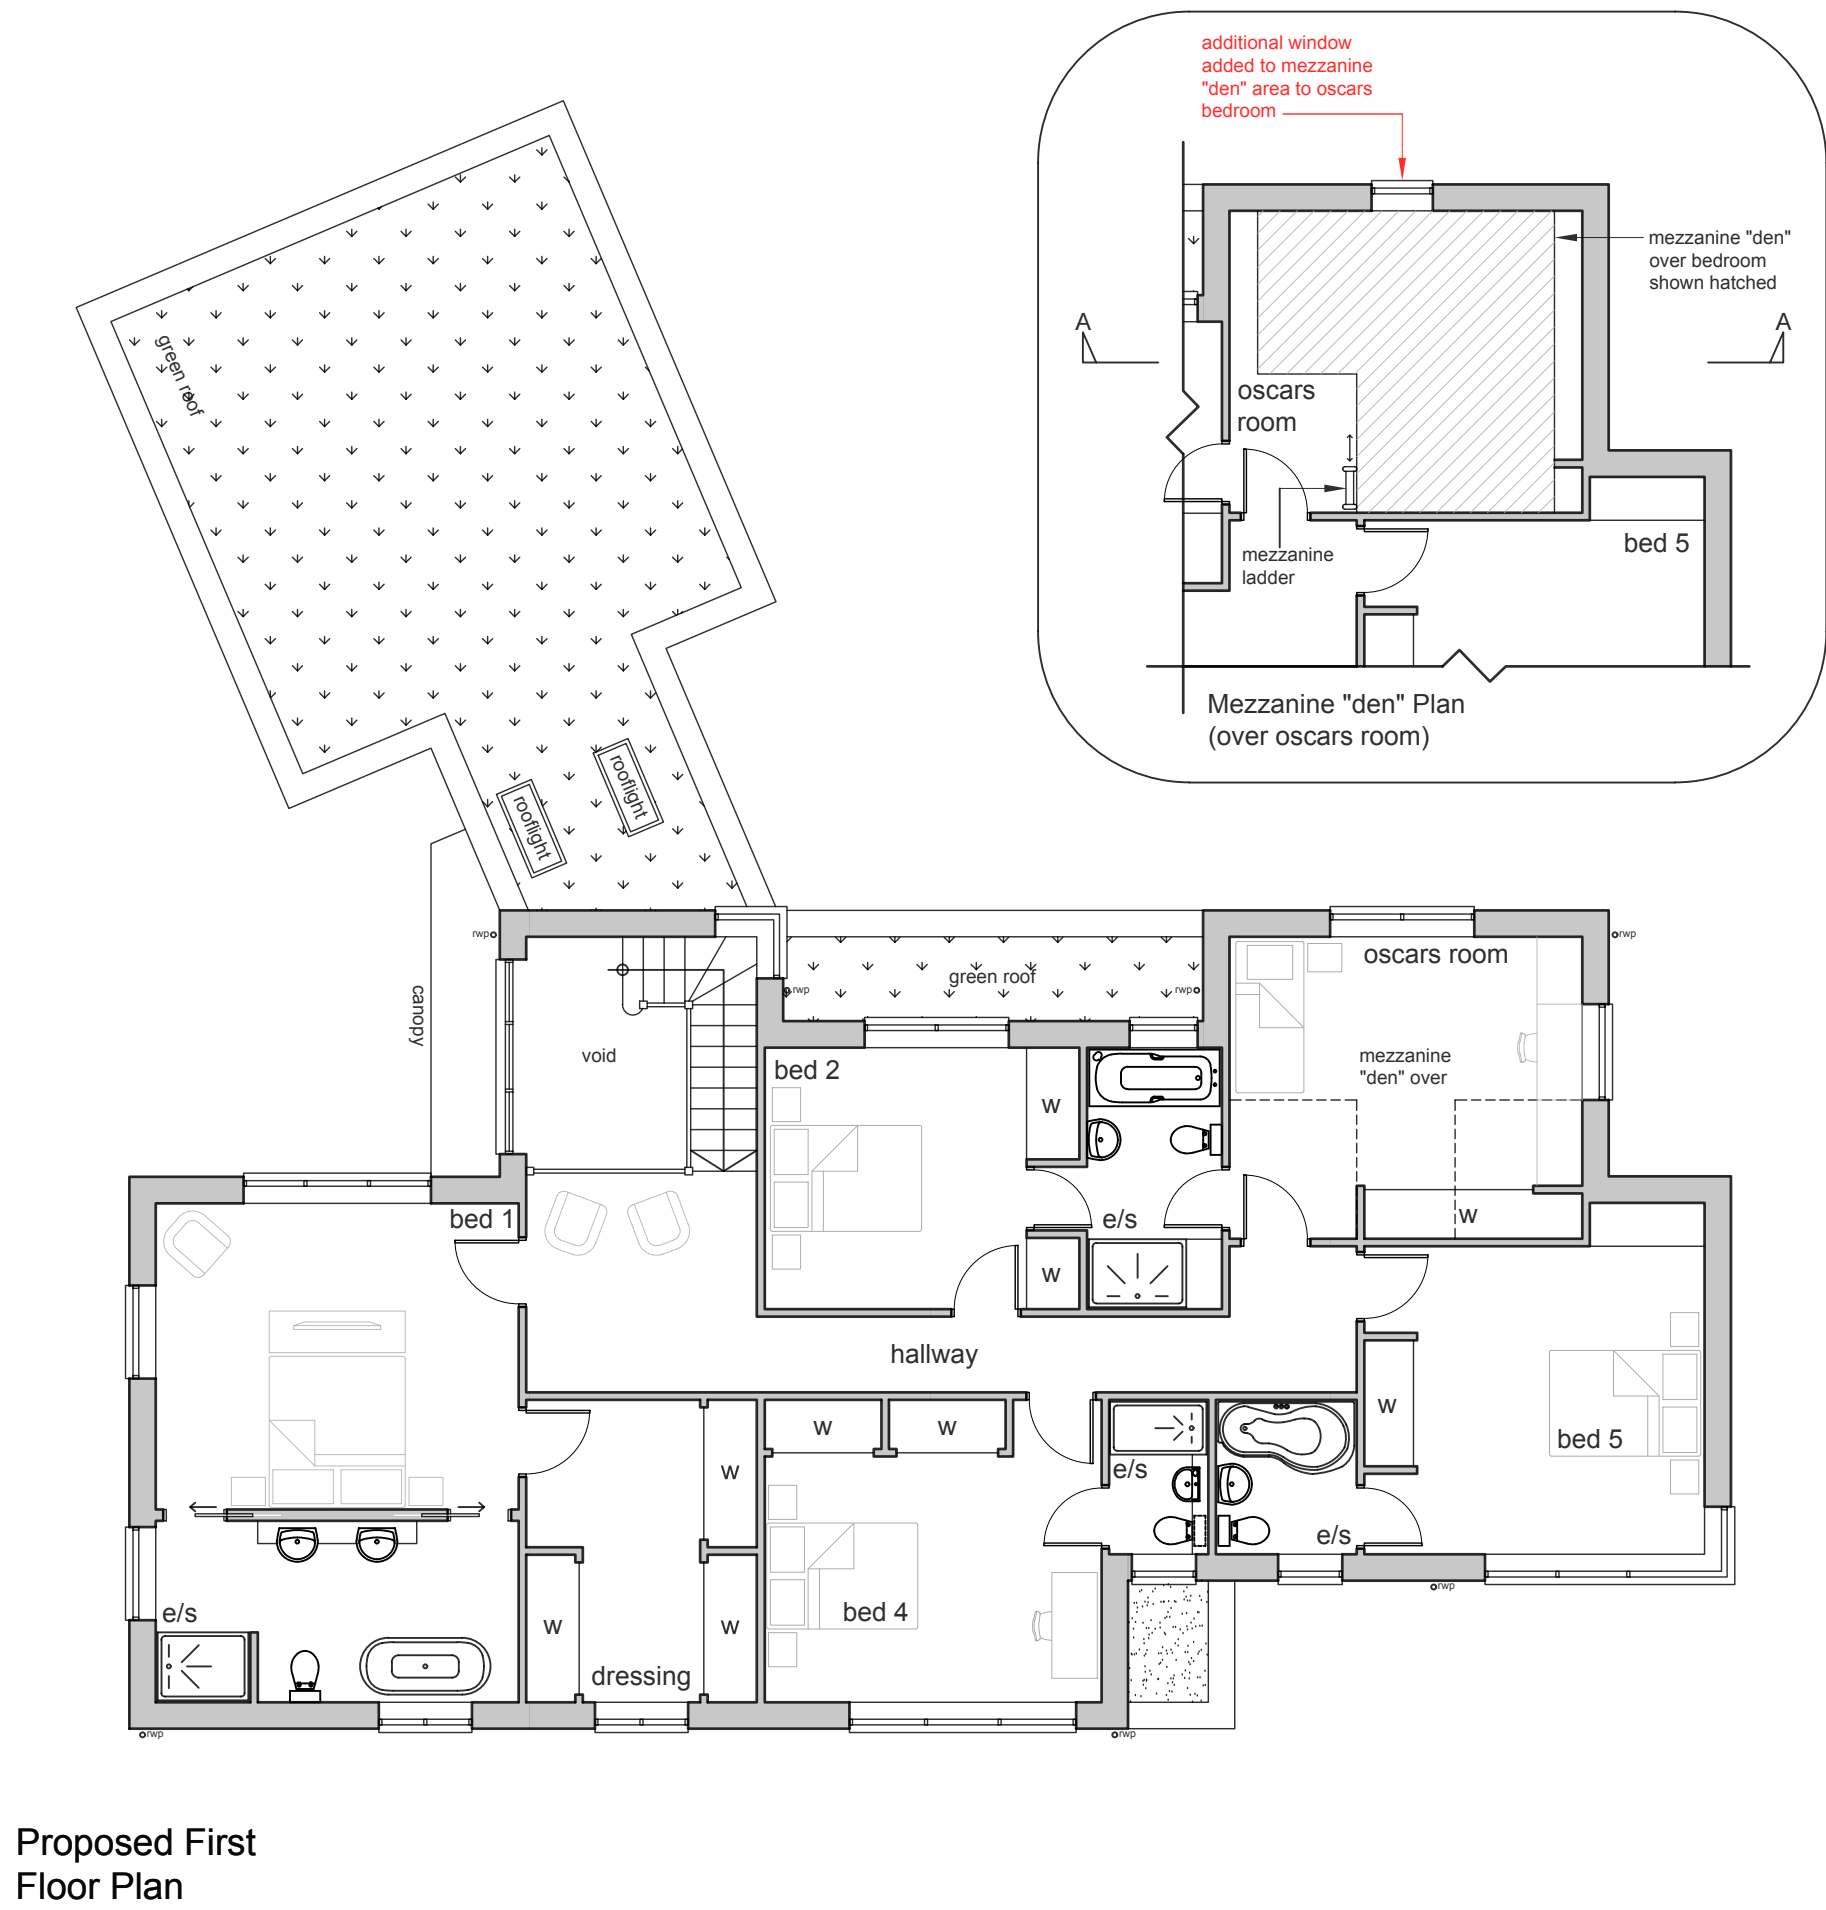


GENERAL NOTES:
This drawing has been produced for our client and is submitted as part of a planning application and is not intended for use by any other person or for any other purpose. Use of this drawing is subject to copyright.
The contractor is to check all site dims and levels before work starts and notify Architect of any discrepancies. This drawing must be read and checked against all structural and other specialist drawings and specifications etc. The contractor is to comply with all current British Standards and Building Regulations whether or not specifically stated on these drawings. Do not scale from this drawing.

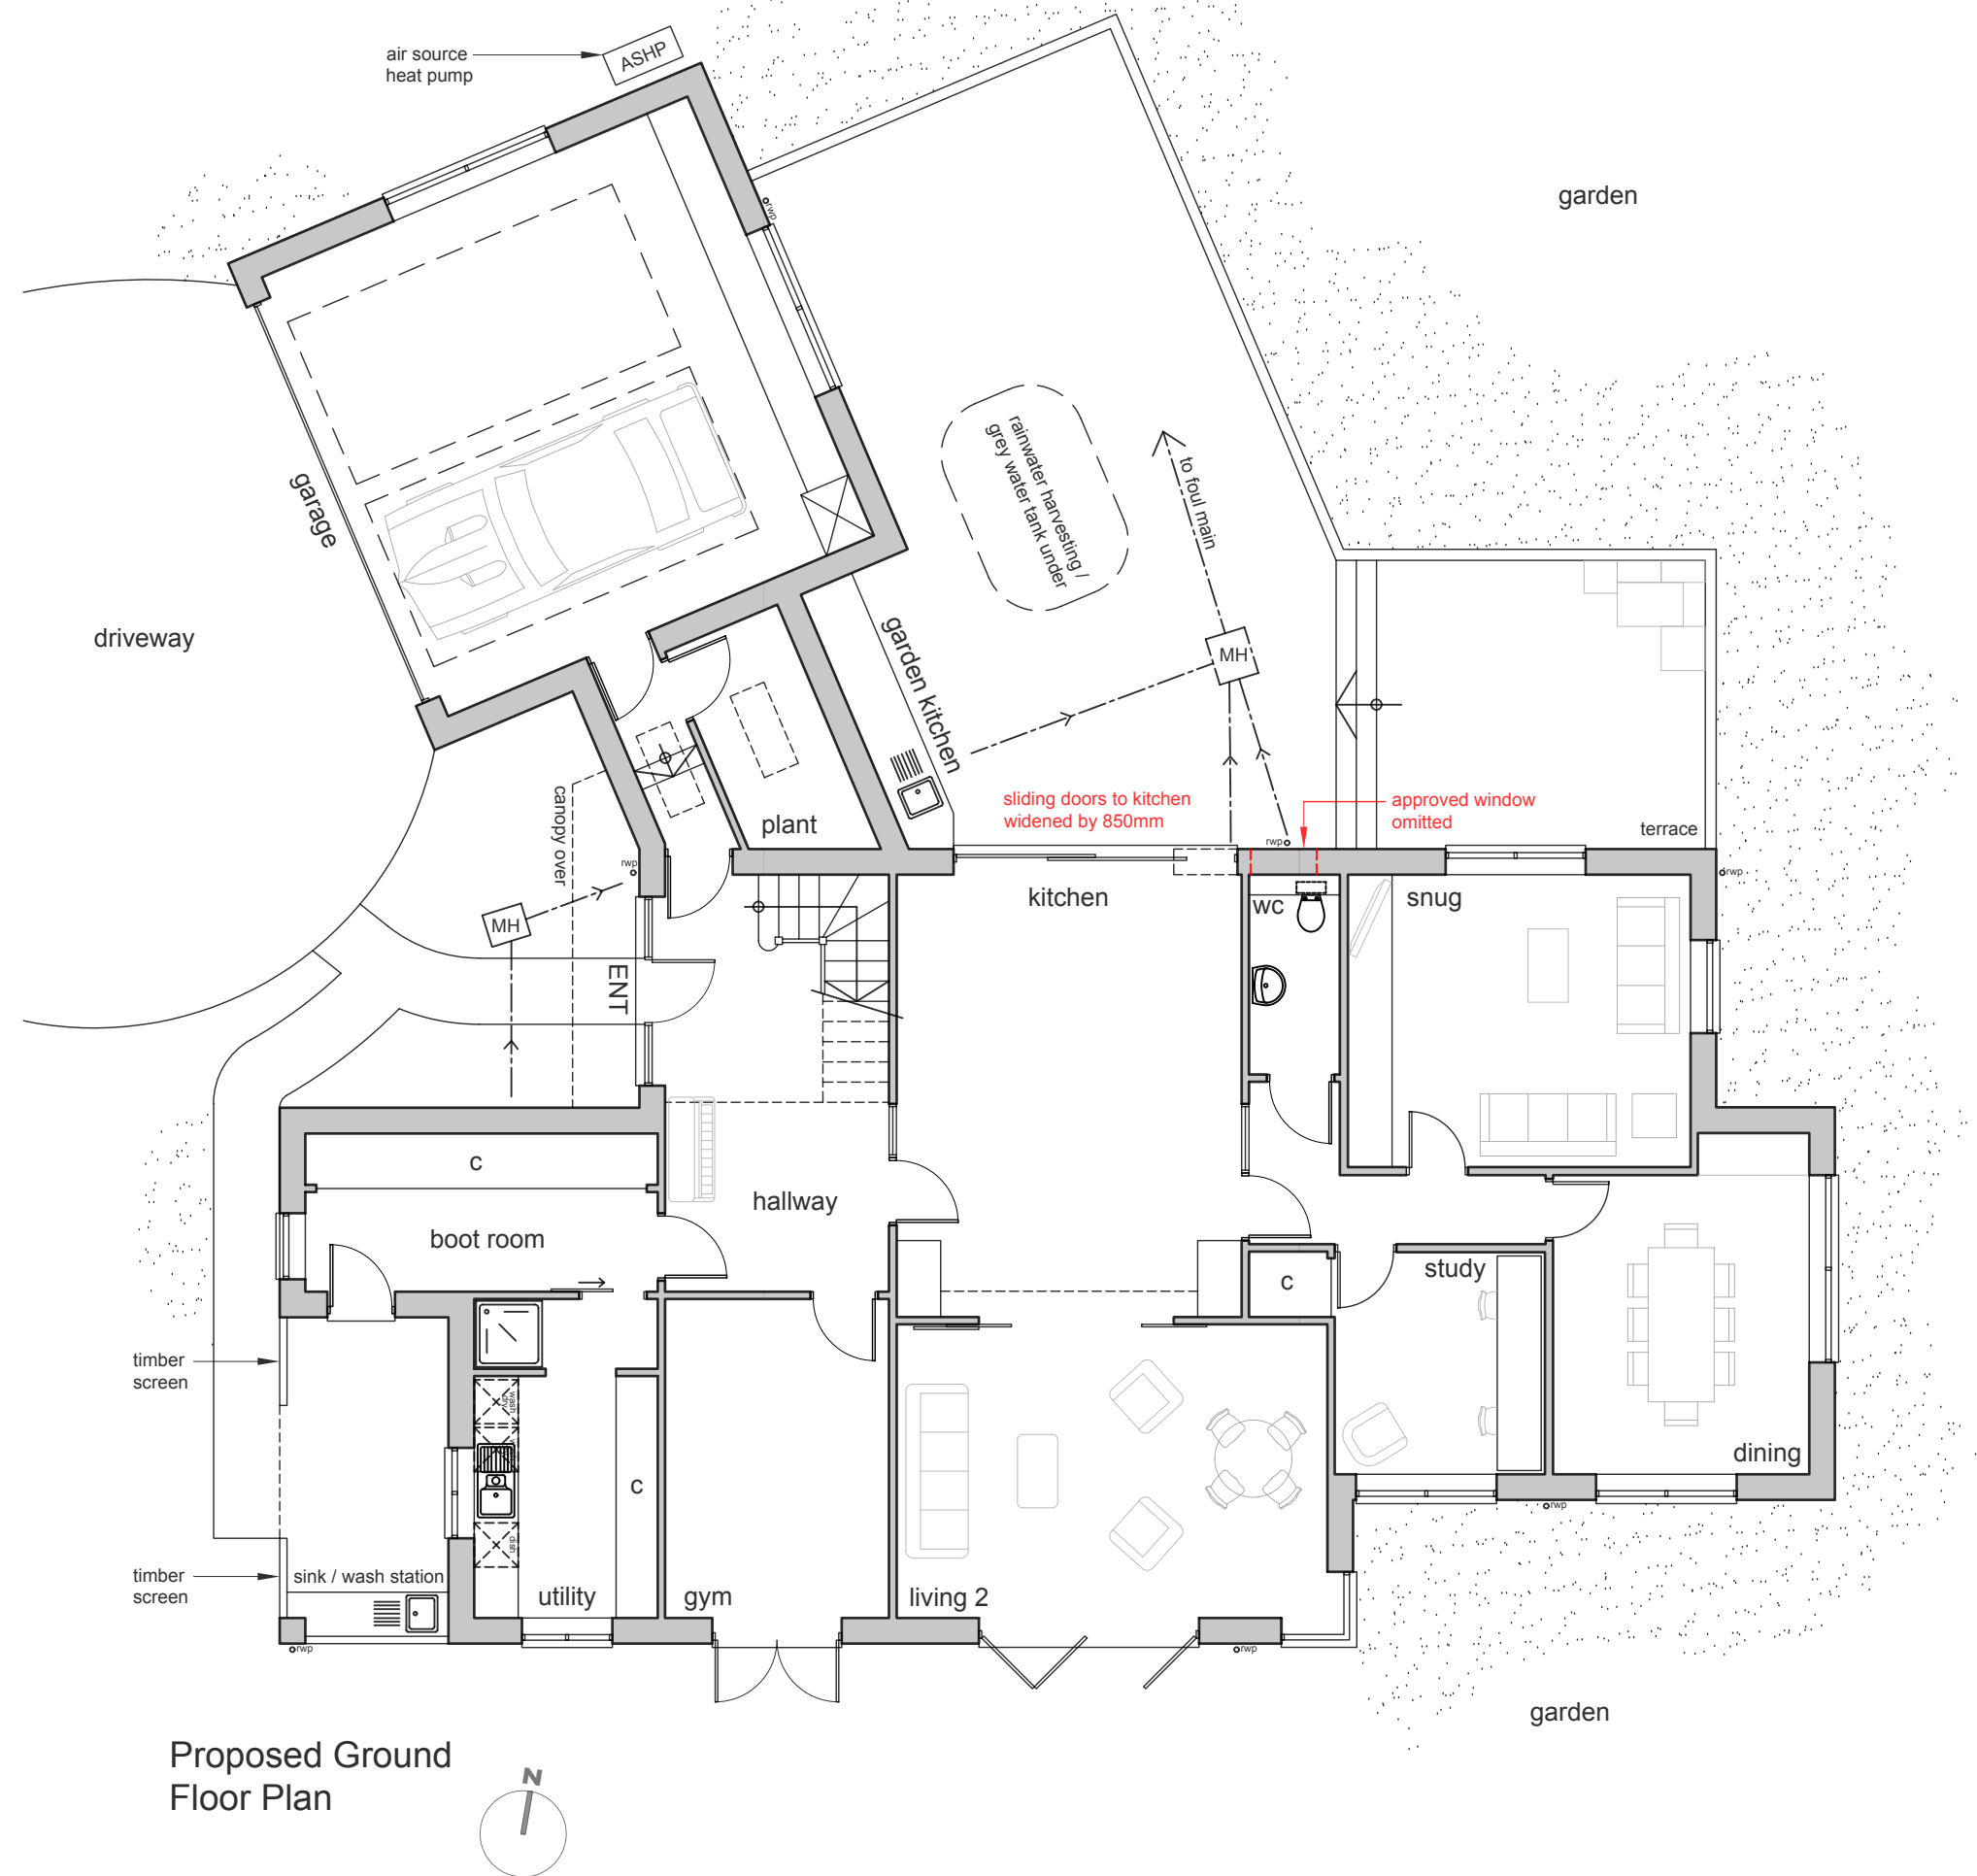


LIGHTBOX
ARCHITECTURE
LIMITED

121 Greenbank Avenue
Saltdean
East Sussex
BN2 8QP

07754 093827
email: info@lightboxarchitecture.com
web: www.lightboxarchitecture.com

© Lightbox Architecture Limited (UK) - 2019

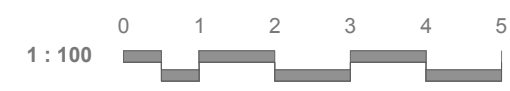

Client
Mr & Mrs Peck
Address
Ponderosa,
Mead Lane,
Storrington,
West Sussex, RH20 3PJ.

Drawing
Plans and Elevations :
Indicating "as built" fenestration changes

PRELIMINARY / PLANNING / BUILDING REGS

Drawing Number
21/142/P02

Revision
E

Rev.	Date	Description	By	Scale	Date	By
E	08.04.26	Changes made to reflect as-built works	AB	1:100 @ A1	17.12.2021	AB