

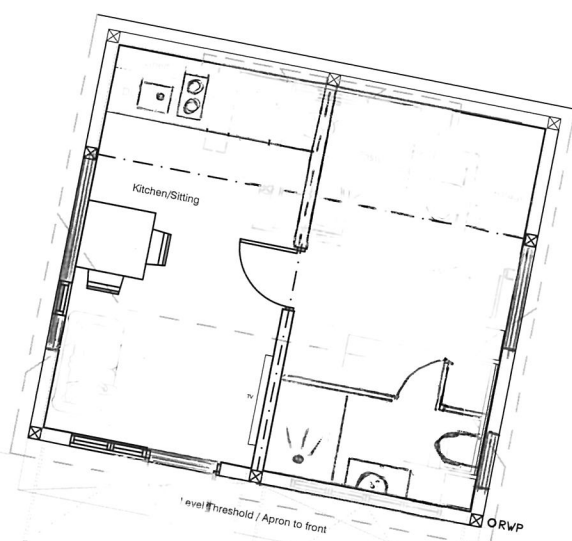
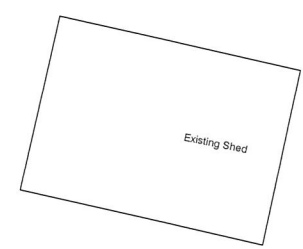



2/2

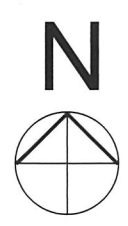


AS BUILT
DC/19/2452

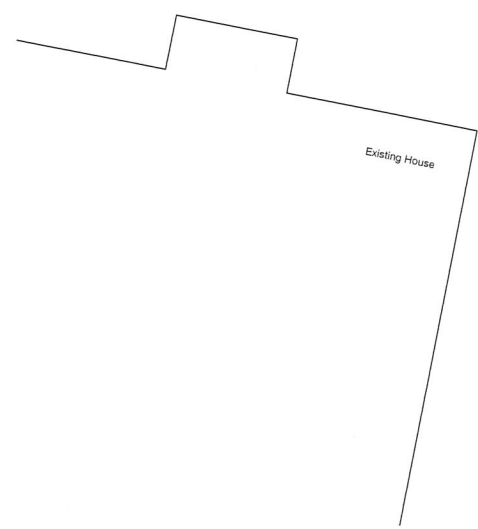


The Architects Office, Gower Road, Haywards Heath RH16 4PL

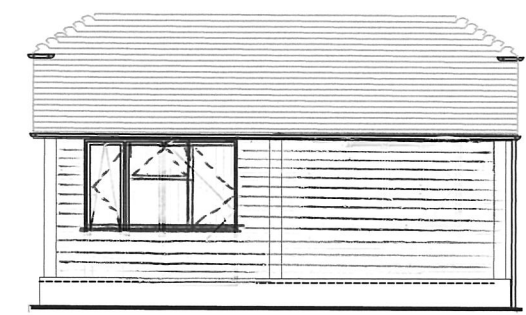


South West

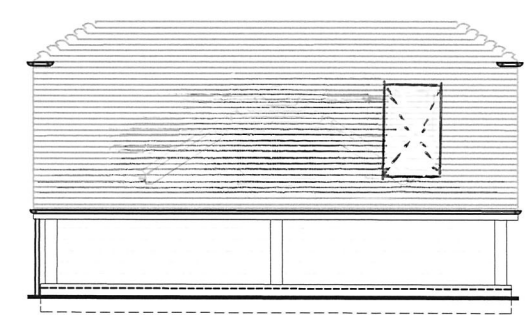

North East Obscured Glass in ensuite

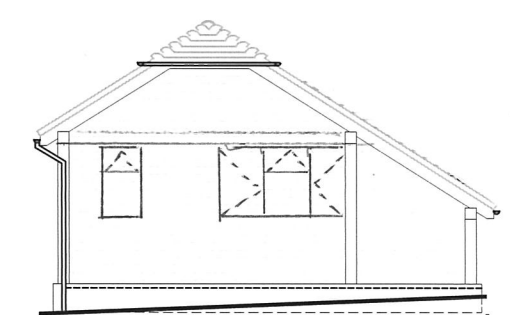

South East

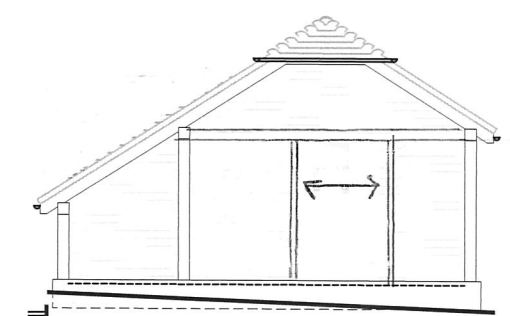

North West

- ☐ SURVEY
- ☐ FEASIBILITY
- ☒ PLANNING
- ☐ BUILDING REGULATIONS
- ☐ CONSTRUCTION

Notes

Do not scale, use figured dimensions only.

All dimensions to be verified on site prior to the commencement of any work or the production of any shop drawing. All discrepancies to be reported to the Architect.

This drawing is to be read in conjunction with all related Architect's and Engineer's drawings and any other relevant information. It is the contractors responsibility to ensure that all works are in compliance with Building Regulations.

This drawing is copyright of David Jenkins Design.

Date	Revision
L	
K	
J	
I	
H	
G	
F	
E	
D	
C	
B	06/03/2020 Amended Garage
A	05/12/2019 Planning

Client MR S BREWER & MS S GOOK

Project LANCASTER COTTAGE
LITTLEWORTH LANE, PARTRIDGE GREEN
HORSHAM, RH13 8EJ

Title PROPOSED GARAGE OPTION 1
AS PROPOSED

Date	Scales	Dwg. No.	Rev.
10/19	1:100 @ A3	659/03	B

