


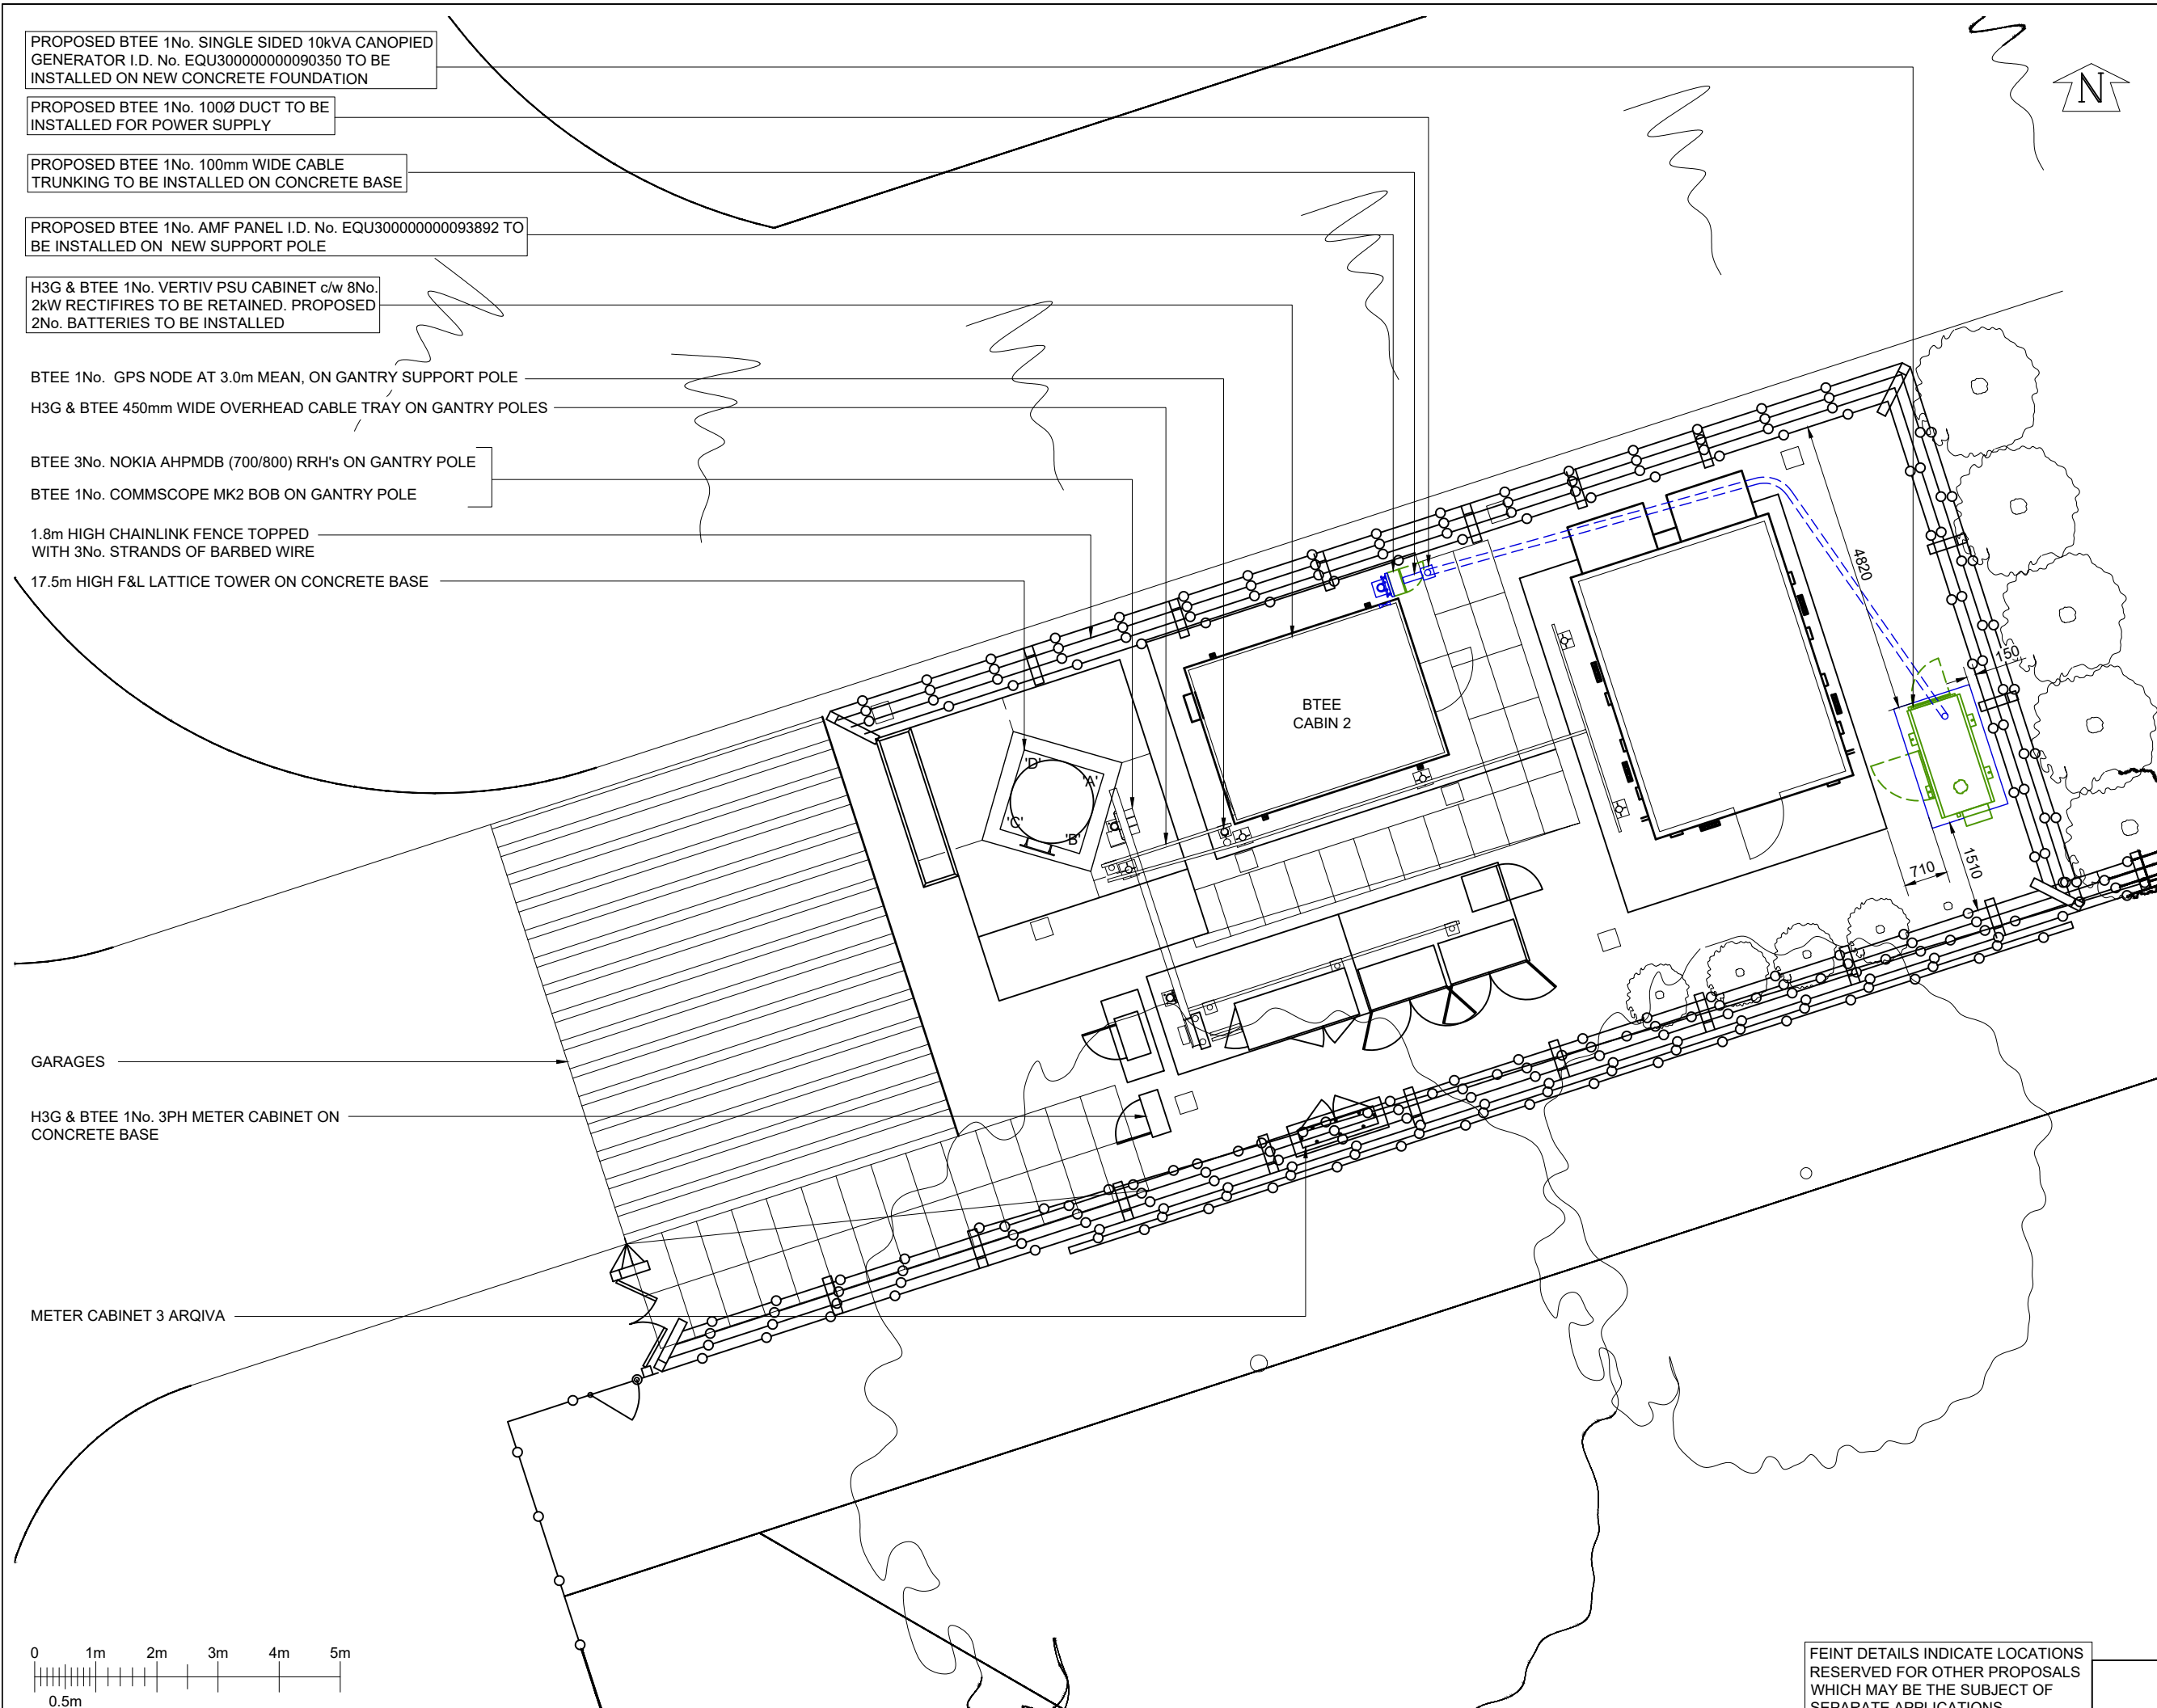

- PROPOSED BTEE 1No. SINGLE SIDED 10kVA CANOPIED GENERATOR I.D. No. EQU30000000090350 TO BE INSTALLED ON NEW CONCRETE FOUNDATION
- PROPOSED BTEE 1No. 100Ø DUCT TO BE INSTALLED FOR POWER SUPPLY
- PROPOSED BTEE 1No. 100mm WIDE CABLE TRUNKING TO BE INSTALLED ON CONCRETE BASE
- PROPOSED BTEE 1No. AMF PANEL I.D. No. EQU30000000093892 TO BE INSTALLED ON NEW SUPPORT POLE
- H3G & BTEE 1No. VERTIV PSU CABINET c/w 8No. 2kW RECTIFIERS TO BE RETAINED. PROPOSED 2No. BATTERIES TO BE INSTALLED

- BTEE 1No. GPS NODE AT 3.0m MEAN, ON GANTRY SUPPORT POLE
- H3G & BTEE 450mm WIDE OVERHEAD CABLE TRAY ON GANTRY POLES
- BTEE 3No. NOKIA AHPMDB (700/800) RRH's ON GANTRY POLE
- BTEE 1No. COMMScope MK2 BOB ON GANTRY POLE
- 1.8m HIGH CHAINLINK FENCE TOPPED WITH 3No. STRANDS OF BARBED WIRE
- 17.5m HIGH F&L LATTICE TOWER ON CONCRETE BASE

- GARAGES
- H3G & BTEE 1No. 3PH METER CABINET ON CONCRETE BASE
- METER CABINET 3 ARQIVA

©2020 Cellnex

All rights reserved. No part of this publication may be reproduced, stored in a retrieval system or transmitted in any form or by any means (Electronic, Mechanical, Photocopying, Recording or otherwise), without the prior written consent of the Company.

NOTES

PROJECT No.

COL.MOD.UK.0009930

BTEE No.

94720

MBNL ID:

HSM024

H3G ID:

RH0334

20.A	COL.MOD.UK.0009930 PLANNING		WHP	
20	COL.MOD.UK.0006198 AS BUILT	23/07/25	ULC	TS
19	COL.MOD.UK.0006198 PLANNING	10/12/24	GBC	GBC
18	208922 PLANNING ISSUE	13/12/18	MON	MC
17	N/A MASTER UPDATE	23/11/17	BH	BH
ISS	REVISION	DATE	DRN	APP

cellnex

driving telecom connectivity

CELLNEX UK

R+, 4TH FLOOR, 2 BLA GRAVE STREET, READING, RG1 1AZ

Tel. 020 4526 8553

SITE No

1494720

STAR RESERVOIR

COMPTONS BROW LANE

HORSHAM

WEST SUSSEX

RH13 6BY

NGR

TQ 19098 31559

OS GRID

519098 131559

TITLE

SITE PLAN

PROPOSED

BTEE - PRIMARY AREA POWER RESILIENCE

SCALE

1:100

DRAWN	IM	28/05/11
APPROVED	TS	23/07/25

DRG No.

Sheet 1 of 1

Rev

1494720-02-100-MD02020.A

FEINT DETAILS INDICATE LOCATIONS RESERVED FOR OTHER PROPOSALS WHICH MAY BE THE SUBJECT OF SEPARATE APPLICATIONS

NOTES

PROJECT No. COL.MOD.UK.0009930

BTEE No. 94720

MBNL ID: HSM024

H3G ID: RH0334

20.A	COL.MOD.UK.0009930 PLANNING		WHP	
20	COL.MOD.UK.0006198 AS BUILT	23/07/25	ULC	TS
19	COL.MOD.UK.0006198 PLANNING	10/12/24	GBC	GBC
18	208922 PLANNING ISSUE	13/12/18	MON	MC
17	N/A MASTER UPDATE	23/11/17	BH	BH
ISS	REVISION	DATE	DRN	APP



CELLNEX UK
R+, 4TH FLOOR, 2 BLA GRAVE STREET, READING, RG1 1AZ
Tel. 020 4526 8553

SITE No 1494720
STAR RESERVOIR
COMPTONS BROW LANE
HORSHAM
WEST SUSSEX
RH13 6BY

NGR TQ 19098 31559

OS GRID 519098 131559

TITLE
ELEVATION
PROPOSED
BTEE - PRIMARY AREA POWER RESILIENCE

SCALE 1:100

DRAWN IM 28/05/11

APPROVED TS 23/07/25

DRG No. Sheet 1 of 1 Rev

1494720-02-150-MD02020.A

BTEE 3No. AEQQ ANTENNAS AT 20.41m, BEARINGS 30°, 150° & 270° E.T.N.
ON SUPPORT POLES

BTEE 3No. RRZZVV-65B-R6N43 ANTENNAS AT 18.5m, BEARINGS 30°, 150° & 270°
E.T.N. ON SUPPORT POLES

H3G & BTEE 1No. ADU451604 ANTENNA AT 18.5m, BEARING 0° E.T.N.
I.D. No. EQU900187418 ON SUPPORT POLES

H3G & BTEE 2No. ADU451604 ANTENNAS AT 18.5m, BEARINGS 120° &
240° E.T.N. I.D. No's. EQU900187419 & EQU900187420

H3G & BTEE 3No. RDO448 (1800/2100) MHA's

BTEE 6No. E14R00P42 700/800 MHA's


H3G 3No. (800) MHA's

BTEE 3No. AHEGG (1800/2100) RRH's

BTEE 3No. ARHA (2600) RRH's

BTEE 3No. MK2 BOB's

H3G & BTEE 1No. SHF 0.3m HP DISH AT 19.0m, BEARING 241.63° E.T.N.
I.D. No. EQU900257713

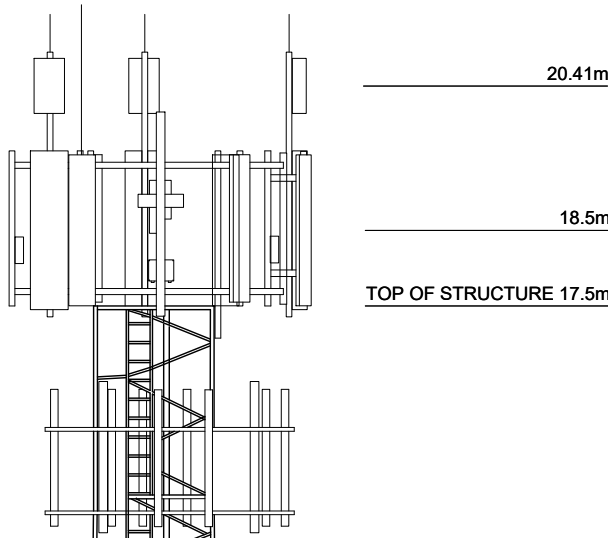

17.5m HIGH F&L LATTICE TOWER

BTEE 1No. GPS NODE AT 3.0m MEAN, ON GANTRY SUPPORT POLE

BTEE 3No. AHPMDB (700/800) RRH's ON GANTRY POLE

BTEE 1No. MK2 BOB ON GANTRY POLE

H3G & BTEE 1No. VERTIV PSU CABINET c/w 8No.
2kW RECTIFIRES TO BE RETAINED. PROPOSED
2No. BATTERIES TO BE INSTALLED (BEHIND)

PROPOSED BTEE 1No. AMF PANEL I.D. No. EQU300000000093892 TO
BE INSTALLED ON NEW SUPPORT POLE (BEHIND)


PROPOSED BTEE 1No. SINGLE SIDED 10kVA CANOPIED
GENERATOR I.D. No. EQU300000000090350 TO BE
INSTALLED ON NEW CONCRETE FOUNDATION (BEHIND)

H3G & BTEE 1No. 3PH METER CABINET ON CONCRETE BASE

GARAGES

0.0 GROUND LEVEL

SOUTH EAST ELEVATION

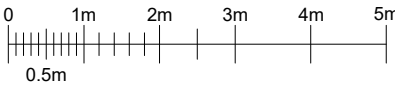

FEINT DETAILS INDICATE LOCATIONS
RESERVED FOR OTHER PROPOSALS
WHICH MAY BE THE SUBJECT OF
SEPARATE APPLICATIONS