



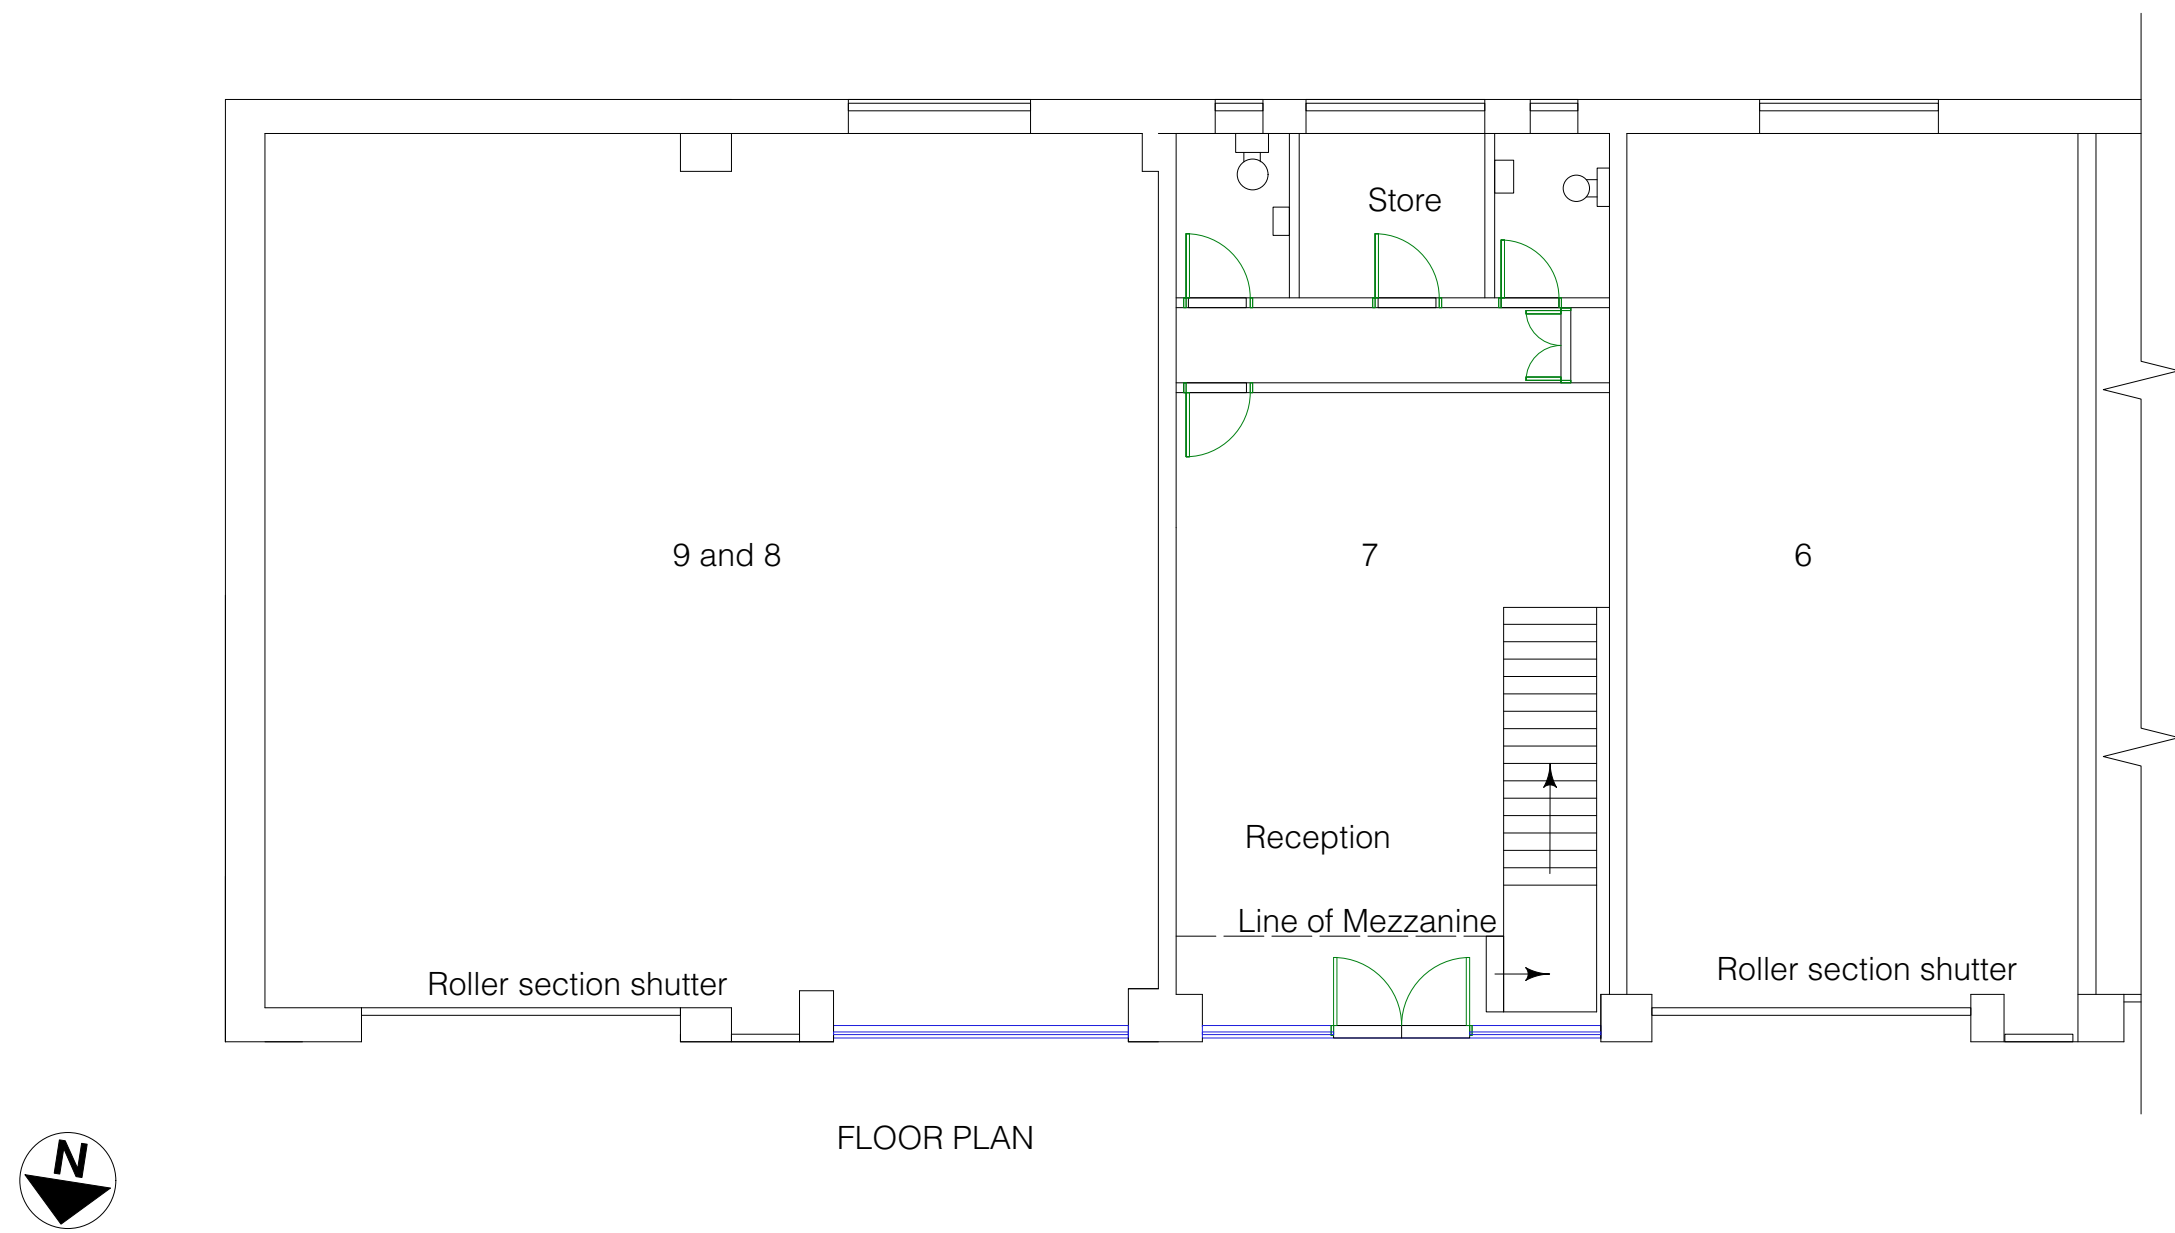

ORIGINAL LAYOUT UNITS 6,7, 8&9

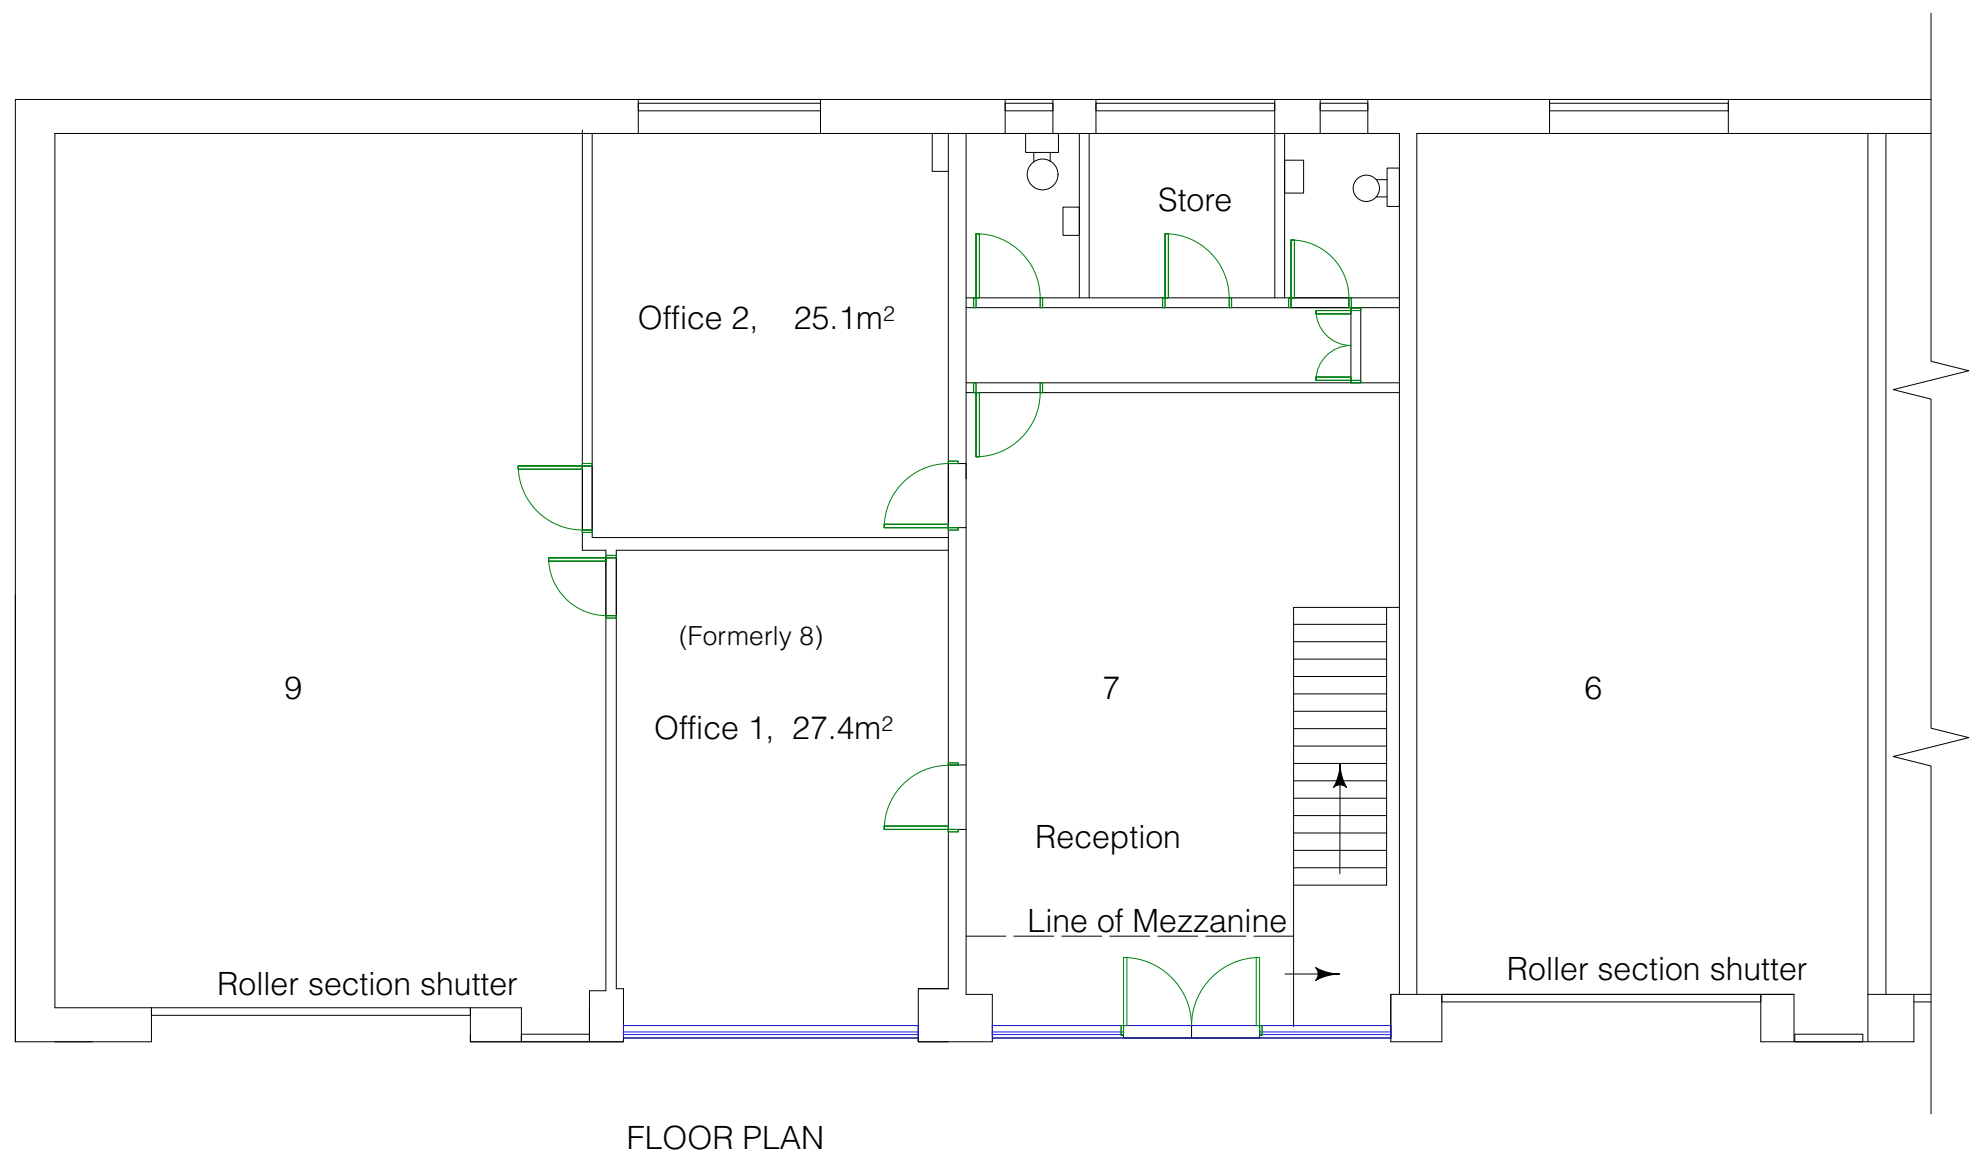

NEW LAYOUT UNITS 6, 7&8, 9



ELEVATIONS (North)



ELEVATIONS (North)

FLOOR PLANS & ELEVATIONS ORIGINAL AND NEW LAYOUT AS BUILT



Sheet No: D 0326/791/02 A

Scales Page Size A3:
1:100

Notes:

Project Name:
Conversion part of
workshop 8 to 2 no.
Offices used by 7

Date: 04/03/2026

Client:
Maltaward Ltd

Site Address:
Maltaward Ltd
Unit 7
Holmbush Potteries
Crawley RH12 4SE

PB
PROPERTIES

Paul Maggi MCAT
Hazelwood, Harpolets Road,
West Chilmington RH20 2LG
Tel: 01798 813298
paul@pbproperties.co.uk
www.pbproperties.co.uk
Drawings produced using Vectorworks
CAD. Only written dimensions to be
respected. Copyright protected to
PB Properties

CIAT
CHARTERED PRACTICE