



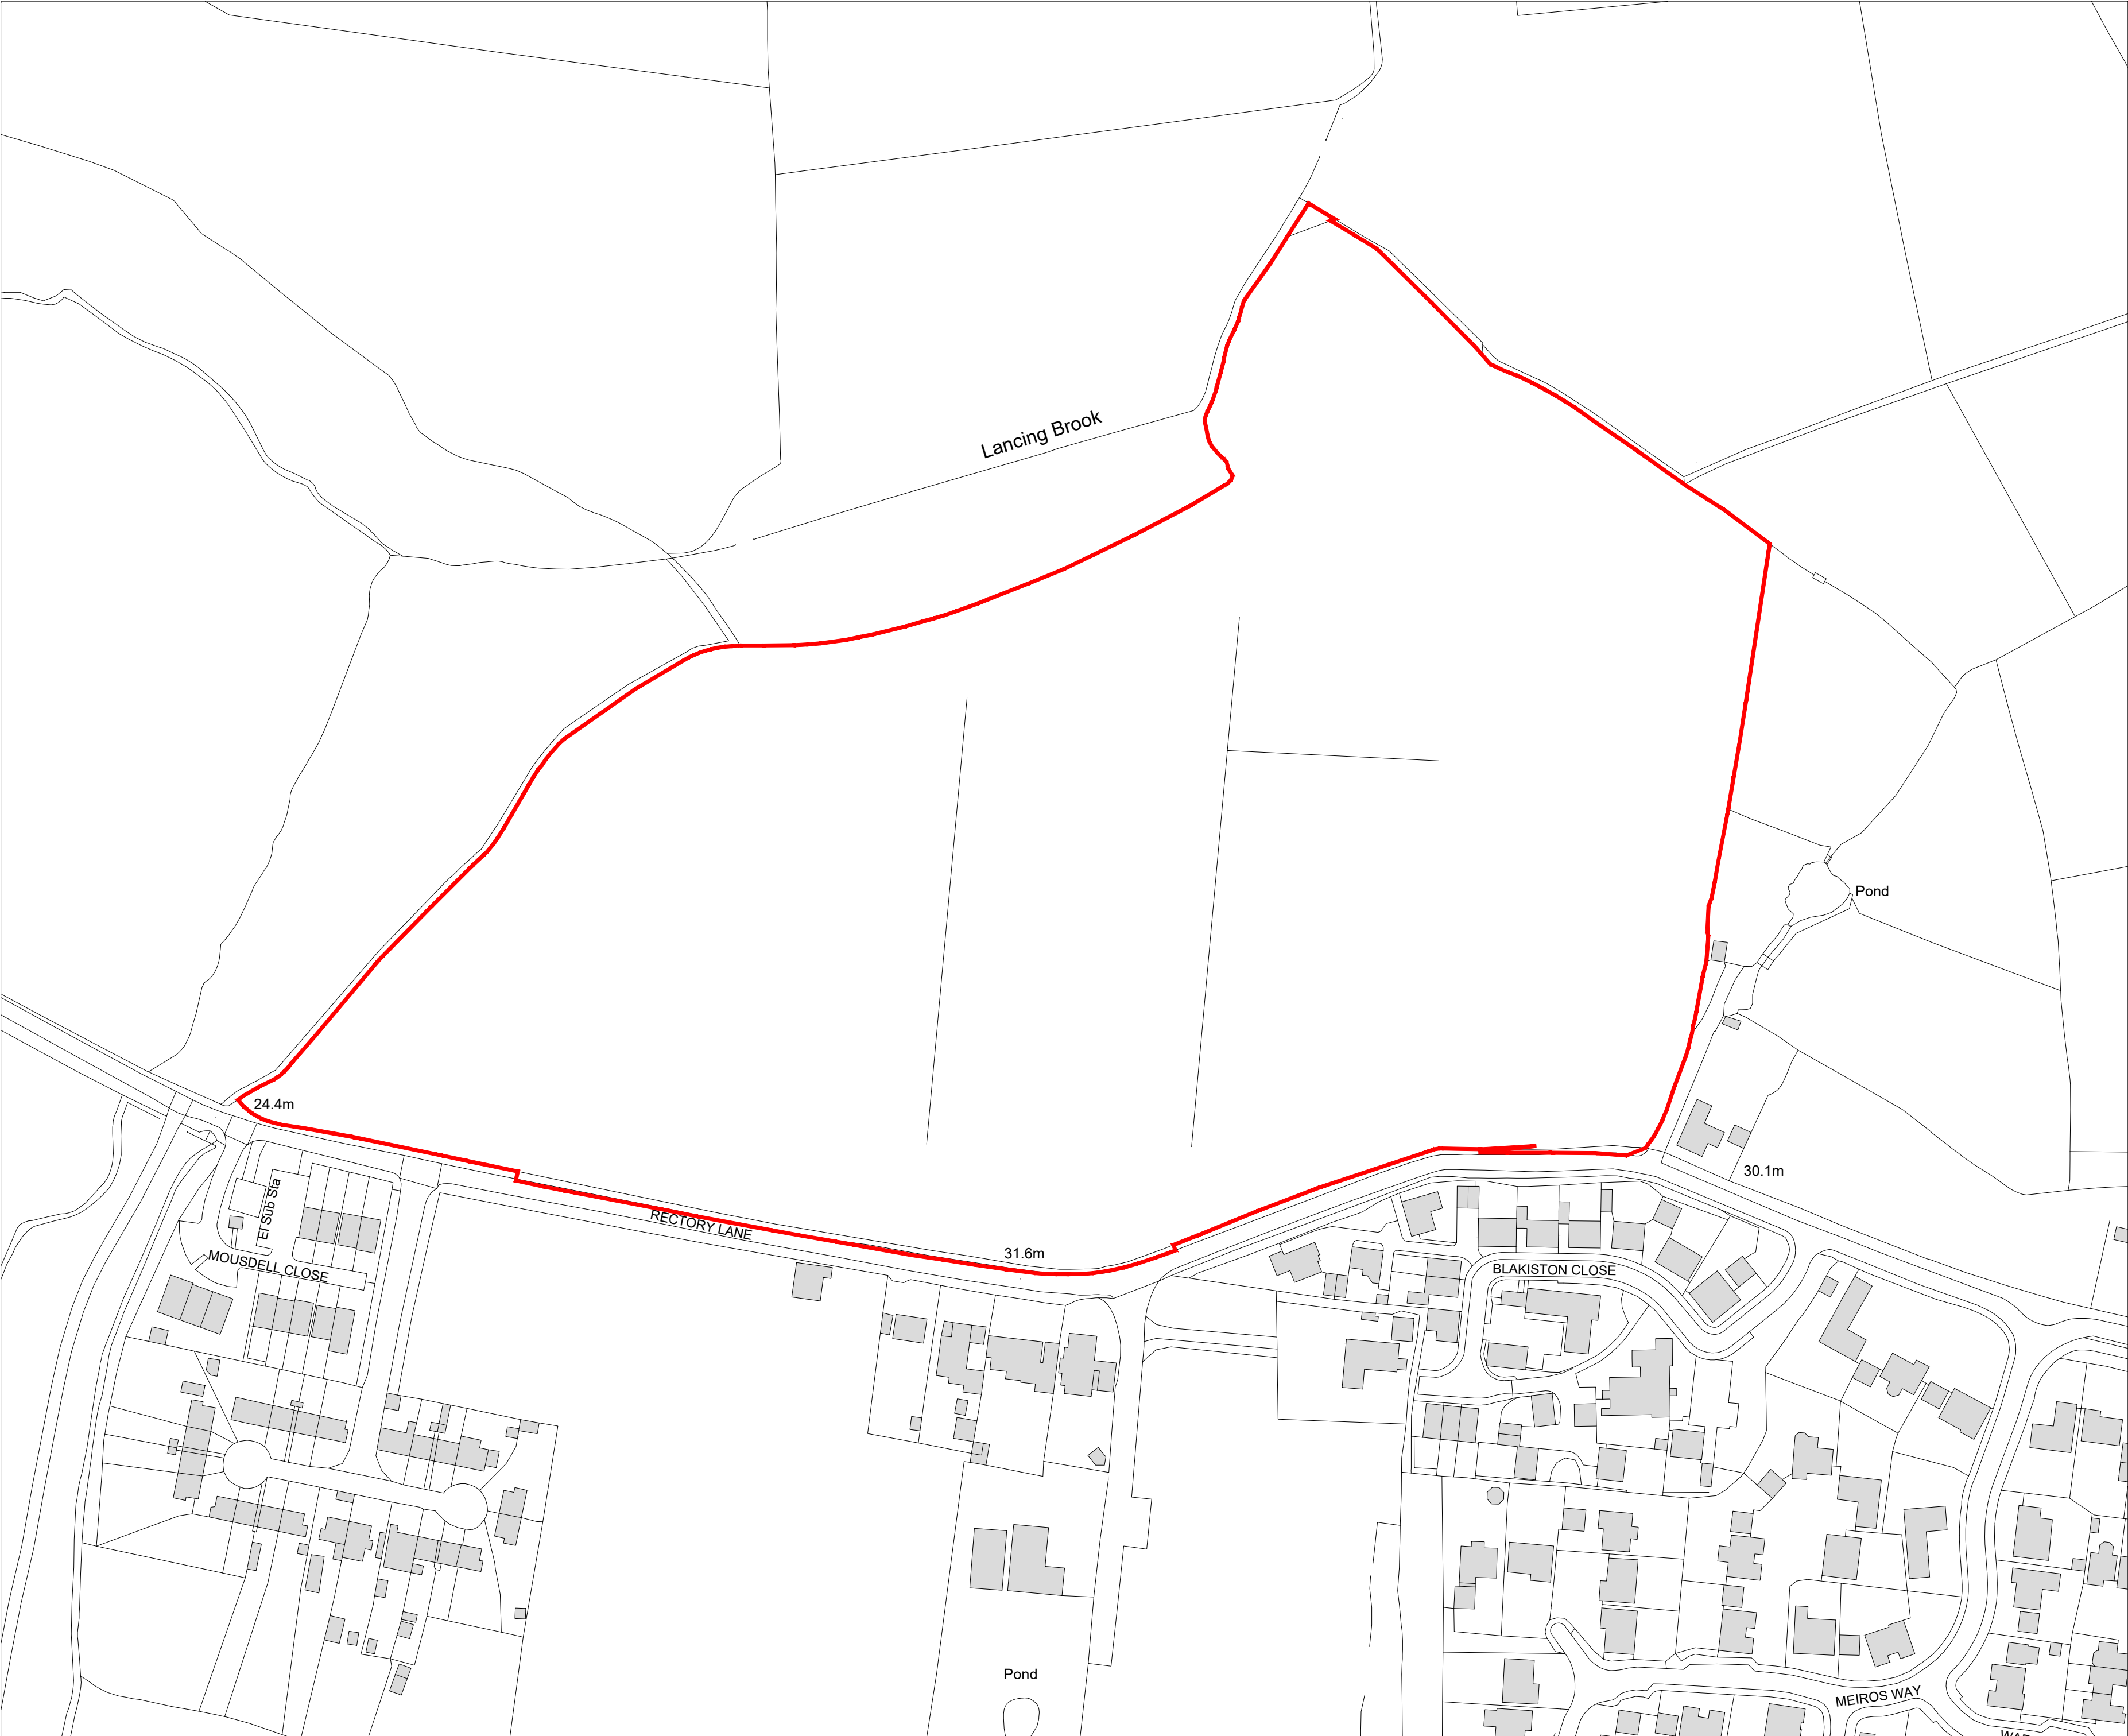

Date	Rev.	Revisions
07/07/26	A	Red line change at access points, and northern tip as per title

Site Boundary
(7.39Ha)

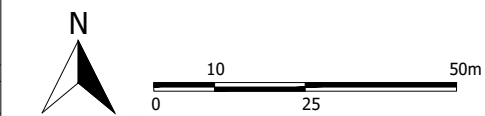

Project		
Land north of Rectory Lane Ashington		
Title		
Site Boundary		
Job	Drawing No.	Rev.
26001	01	A
Drawn	Scale	Date
TS	1:1250@A2	07/2026



37 Stoke Fields, Guildford, GU1 4LT, Tel 07887 743567
Copyright: This drawing is the property of Urban Place Lab Ltd. No disclosure or copy of it may be made without the written permission of Urban Place Lab Ltd.