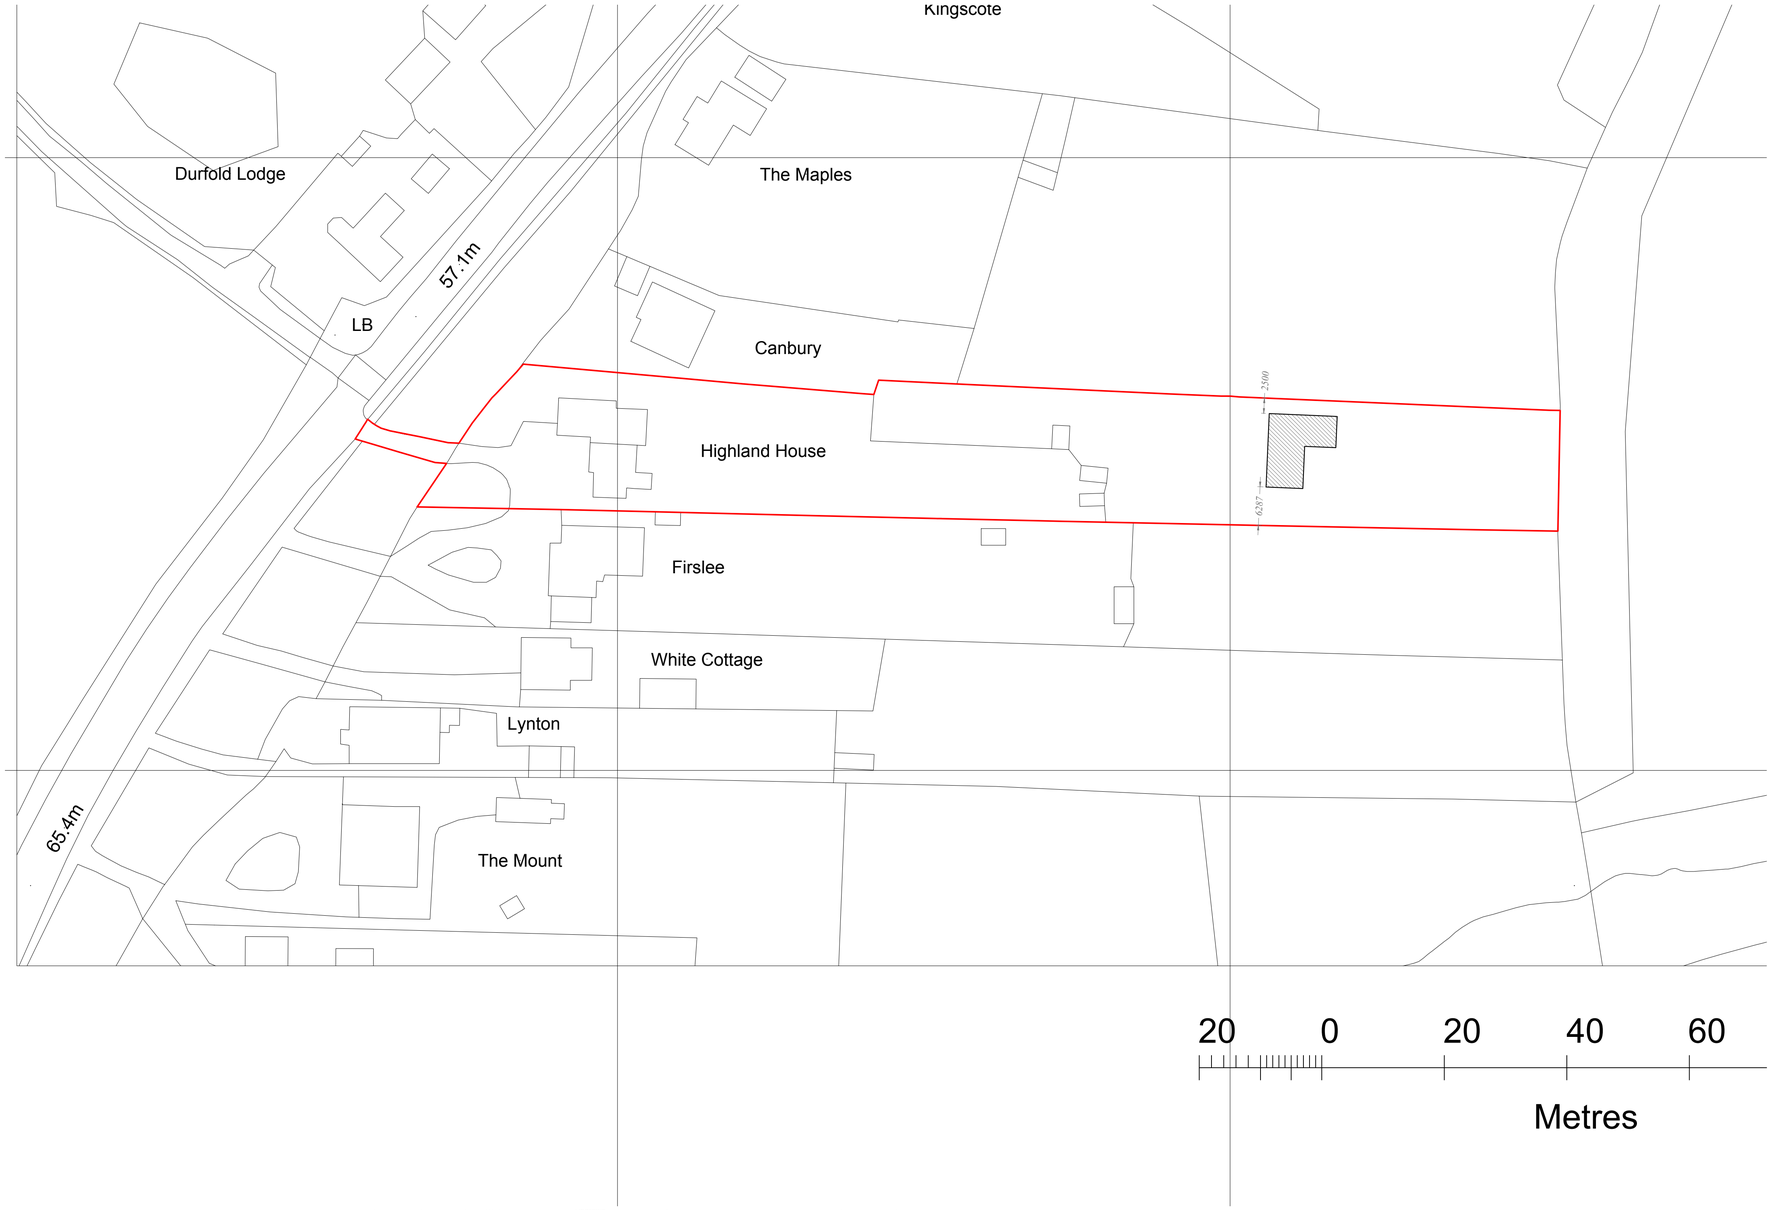

BLOCK PLAN SCALE 1:500

PROPOSED ALTERATIONS

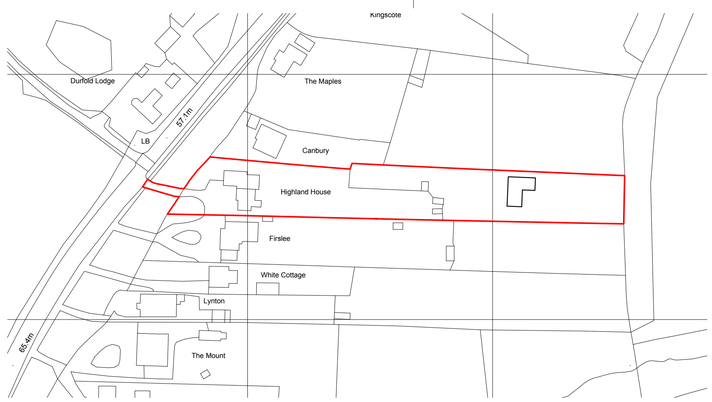

LOCATION MAP SCALE 1:1250

rev	date	description

RB Design
Corner Cottage, The Limes, Felbridge RH19 2QY
Tel: 01342 523 766 Mob 07988 998 928 e.mail: info@rosbowditchdesign.co.uk

project	drawing	date	job no
Highlands House, Dorking Road, Warnham, HORSHAM, RH12 3RZ	WORKS STORE/WORKSHOP LOCATION MAP/BLOCK PLAN AS BUILT	01.04.26	
client Mr & Mrs Cunningham		scale @	drwg no PLN 02 rev