

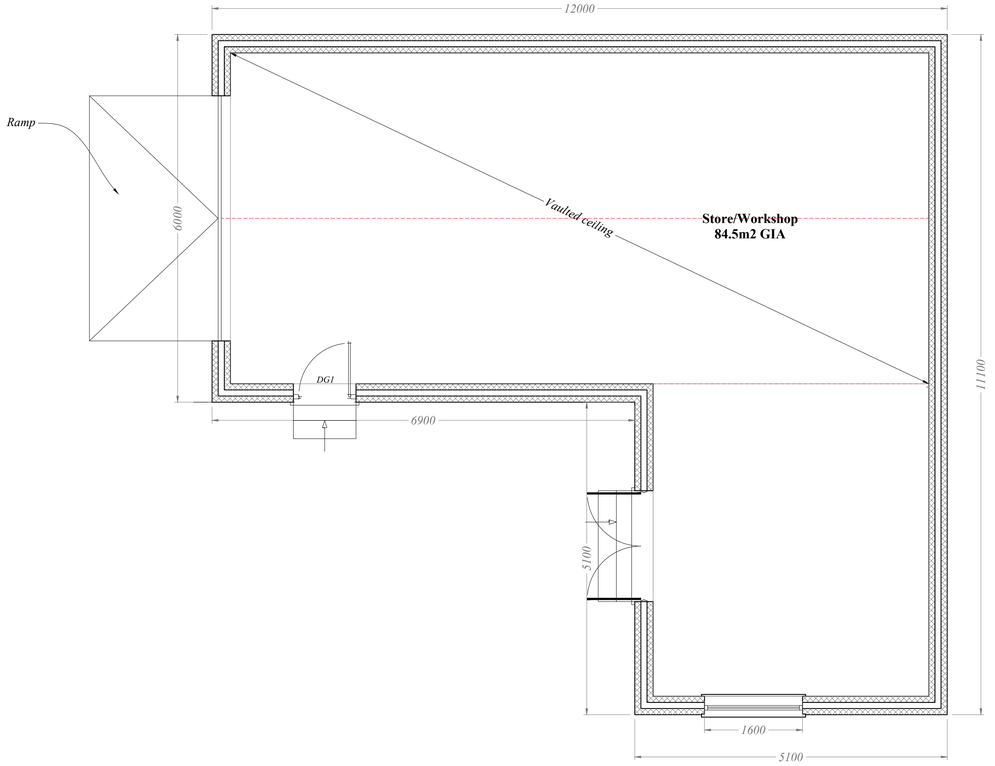



Ground Floor Plan

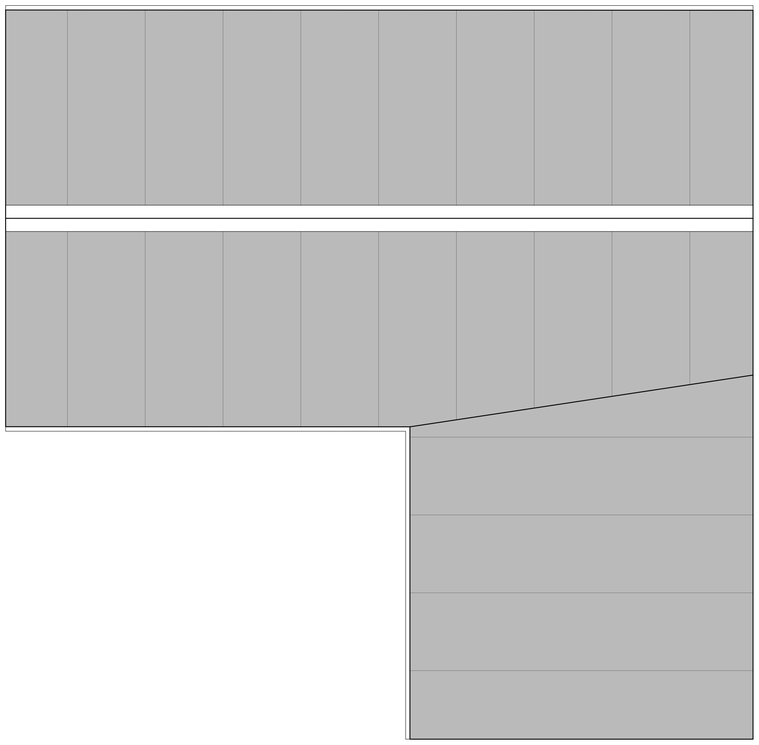


Roof Plan

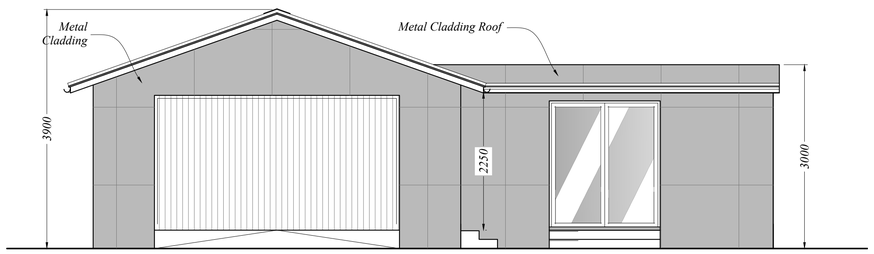


Front Elevation

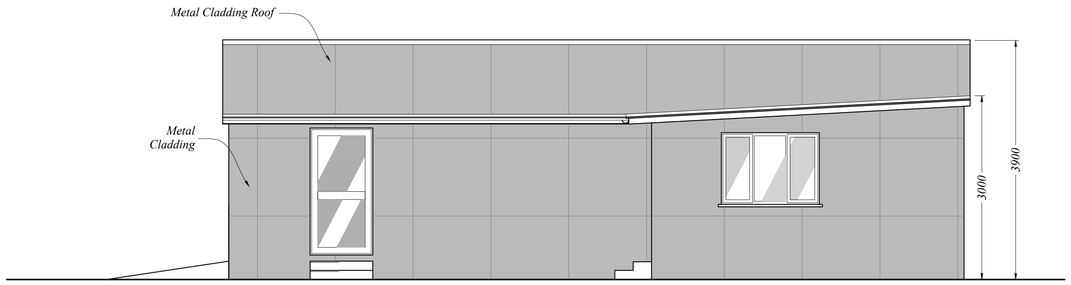

Side Elevation

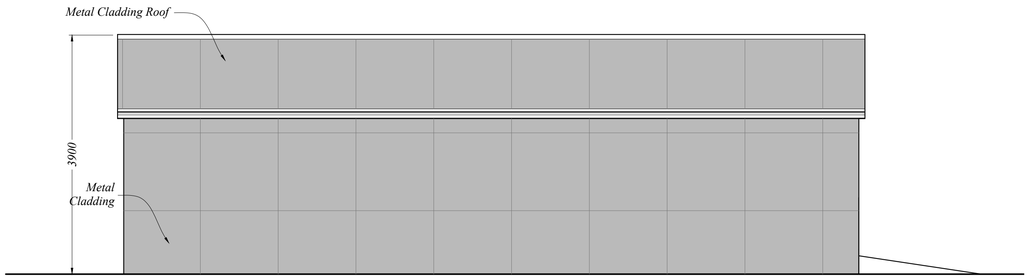

Side Elevation

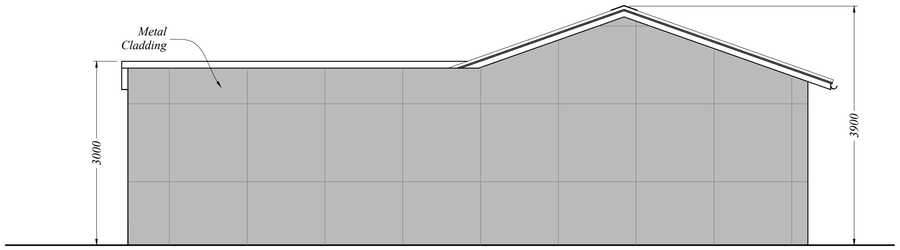

Rear Elevation

METRES

0 5

SCALE

rev	date	description

RB Design
Corner Cottage, The Limes, Fellbridge RH19 2QY
Tel: 01342 323 766 Mob 07888 990 928 email: info@rosbowditchdesign.co.uk

project: Highlands House, Dorking Road, Warnham, HORSHAM, RH12 3RZ	drawing: WORKS	date: 01.04.26	job no:
client: Mr & Mrs Cunningham	STORE/WORKSHOP AS BUILT	scale @ A1: 1:50	dwg no: PLN 01