


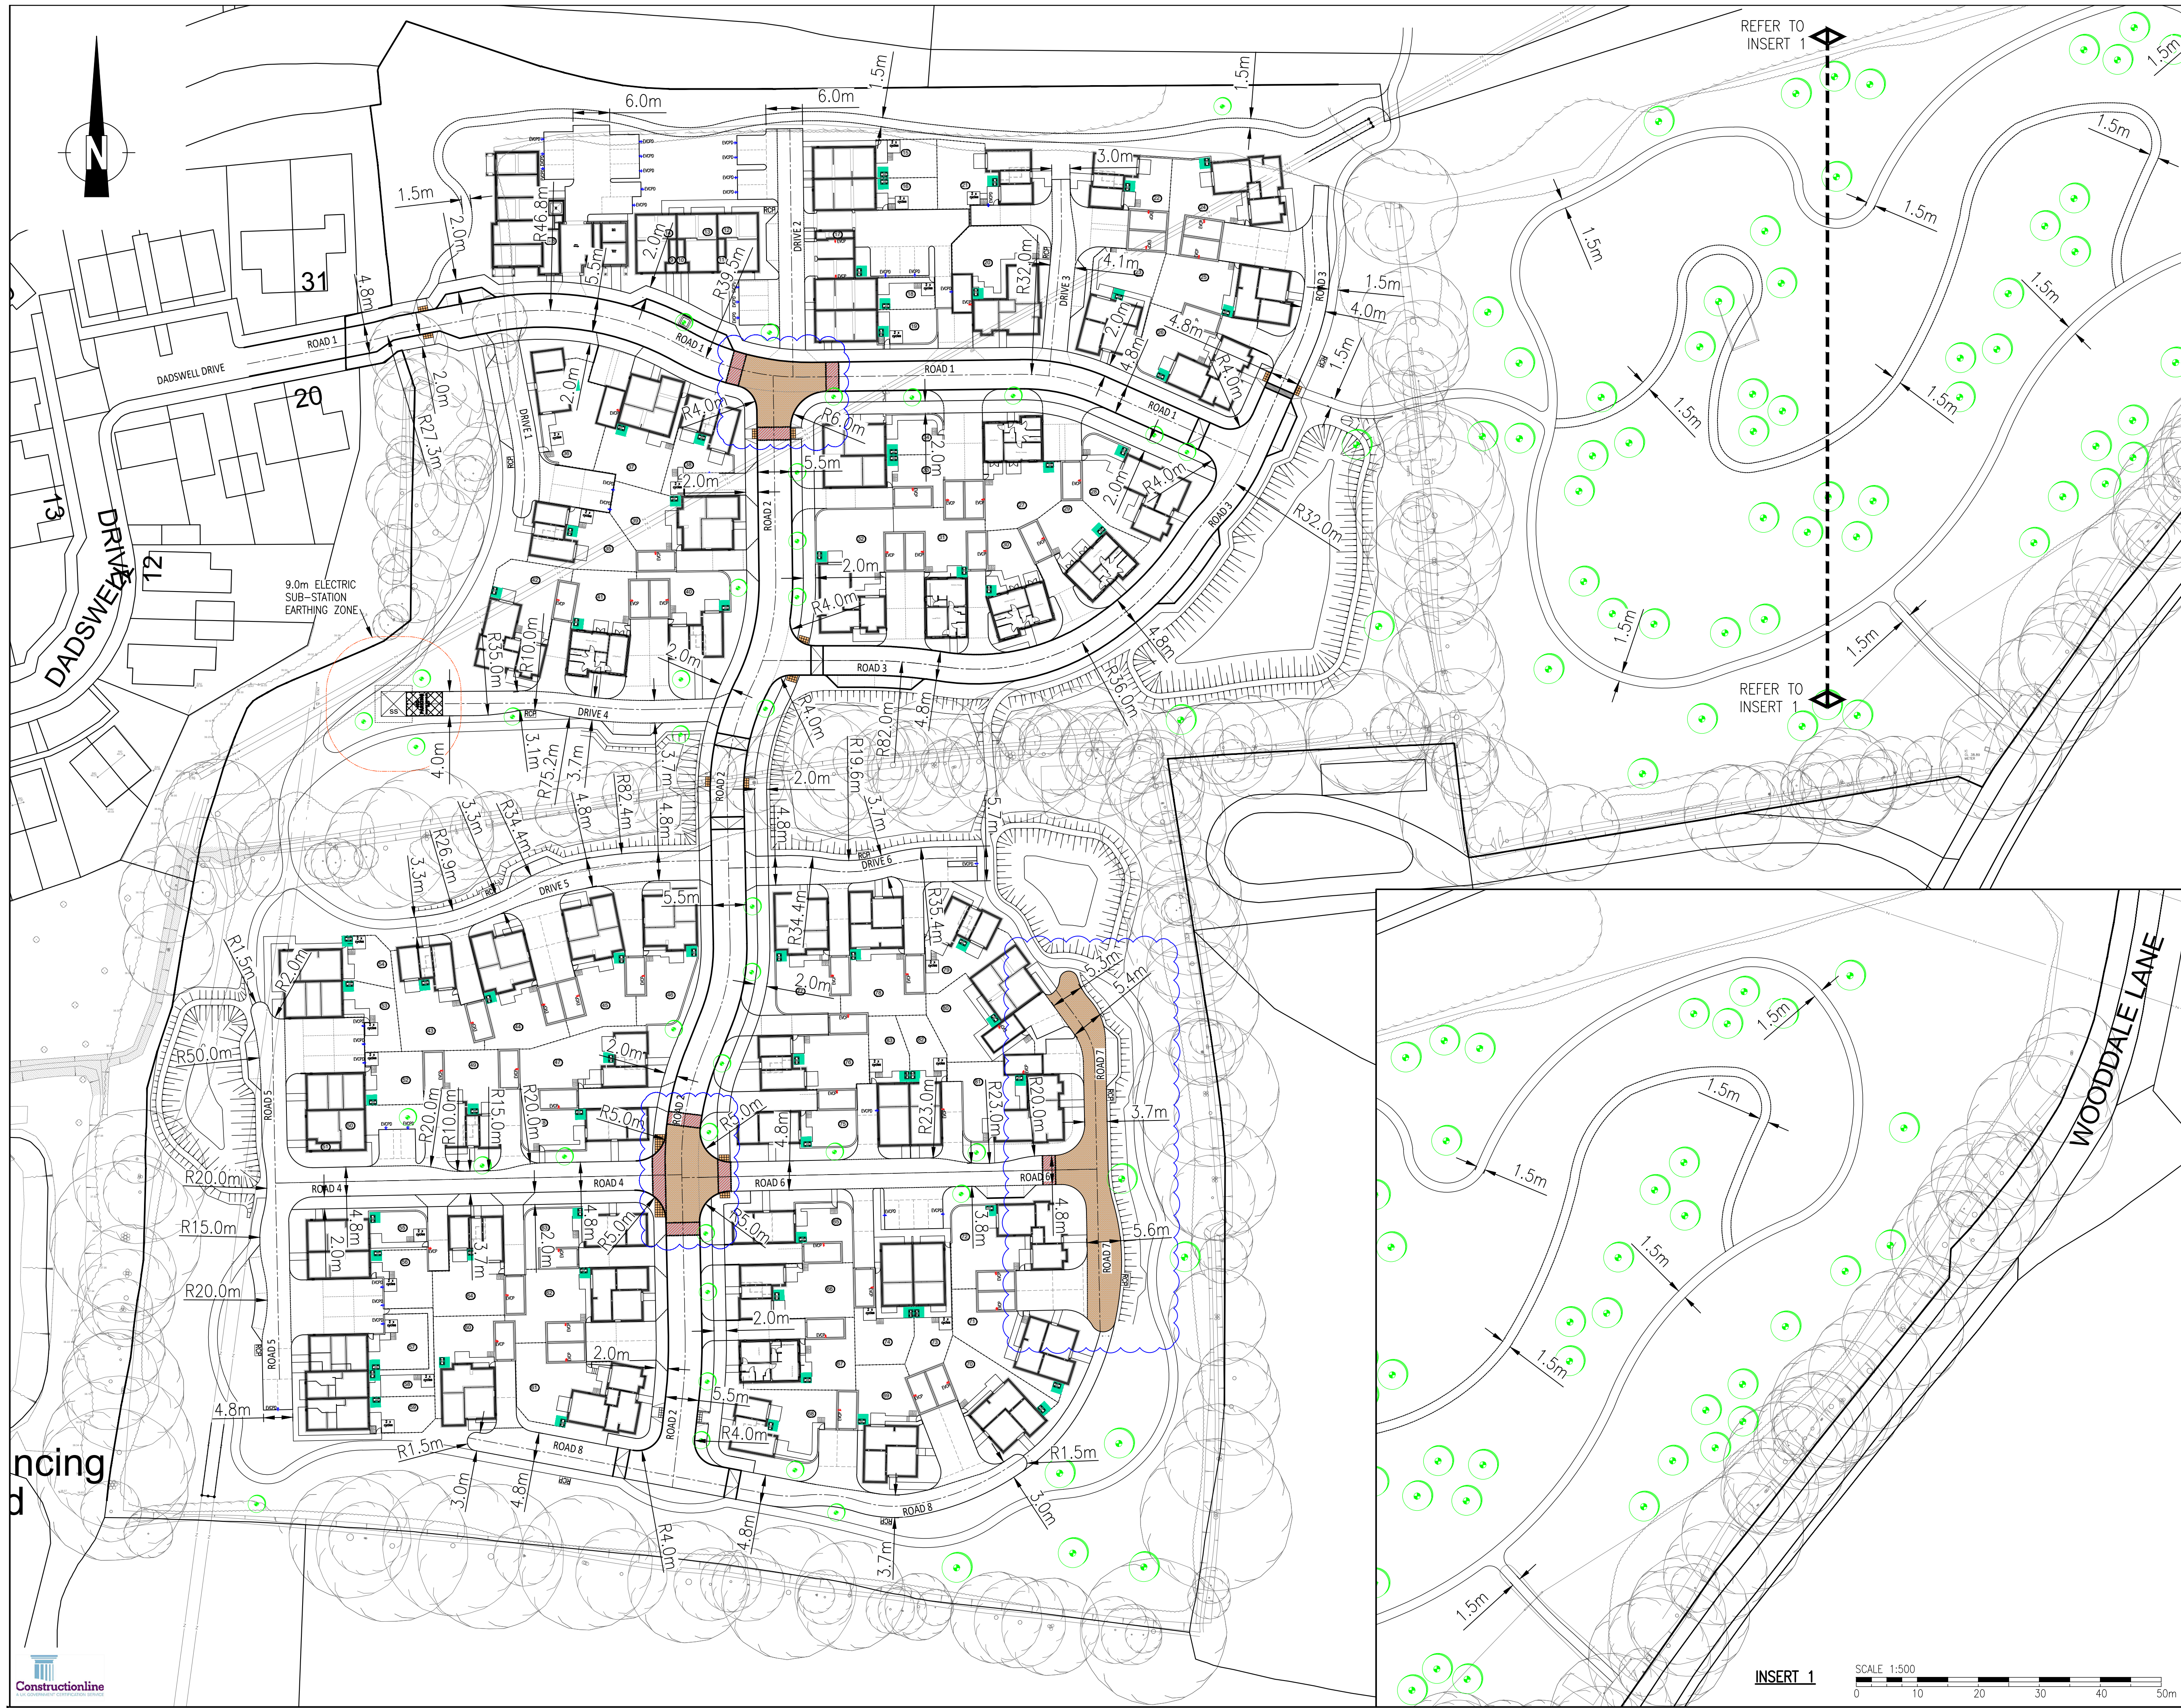

- NOTES: GENERAL
- G1. DO NOT SCALE FROM THIS DRAWING
 - G2. ALL DIMENSIONS SHOWN ARE IN METRES UNLESS STATED OTHERWISE.
 - G3. THIS DRAWING IS BASED ON TOPOGRAPHICAL SURVEY COMPILED BY: MKSURVEYS HORSHAM TEL: 01403243162 HORSHAM@MKSURVEYS.CO.UK
 - G4. GRID AND LEVELS BASED ON ORDNANCE DATUM, DERIVED FROM THE NATIONAL GNSS NETWORK. LOCAL SCALE FACTOR 0.99975 APPLIED.
 - G5. THIS DRAWING SHALL BE READ IN CONJUNCTION WITH ALL RELEVANT SCHEME DRAWINGS AND SPECIFICATIONS.
 - G6. ALL WORKS TO BE CARRIED OUT IN STRICT ACCORDANCE WITH "THE SPECIFICATION FOR HIGHWAY WORKS - MODIFIED AND EXTENDED", INCLUDING WEST SUSSEX COUNTY COUNCIL'S SUPPLEMENTARY CLAUSES.
 - G7. ALL WORKS WITHIN THE PUBLIC HIGHWAY SHALL BE CARRIED OUT AND COMPLY WITH THE REQUIREMENTS OF THE DTP "TRAFFIC SIGNS MANUAL CHAPTER 8 - TRAFFIC SAFETY MEASURES AND SIGNS FOR ROAD WORKS AND TEMPORARY SITUATION".
 - G8. ALL ROAD MARKINGS AND TRAFFIC SIGNS SHALL COMPLY WITH "THE TRAFFIC SIGNS REGULATIONS AND GENERAL DIRECTIONS 2016".
 - G9. ALL EXISTING LEVELS TO BE CONFIRMED ON SITE PRIOR TO COMMENCEMENT OF ANY WORKS.
 - G10. BEFORE ANY WORKS ARE COMMENCED THE WEST SUSSEX COUNTY COUNCIL AREA HIGHWAY MANAGER MUST BE CONTACTED.

- 2.4mX25m VISIBILITY SPLAY
- RCP BIN COLLECTION POINT
- 2 x cycles BIN STORE
- EVCPD ELECTRIC VEHICLE CHARGING POINT - SOLO
- EVCP ELECTRIC VEHICLE CHARGING POINT - SOLO
- HIGH FRICTION SURFACING COLOUR: RED
- HIGH FRICTION SURFACING COLOUR: BUFF
- GRANITE SETTS

CONSTRUCTION ISSUE						
-	C11	GRANITE SETTS & HIGH FRICTION SURFACING ADDED	DJ	MSR	20.05.26	
-	C10	BASIN 1 SHAPE/SIZE REVISED		MSR	05.03.26	
-	C09	PLOTS 79, 82 & 83 SHED POSITION REVISED	FP	MSR	30.01.26	
-	C08	PLOT 38 DRIVE/PATH REVISED. PLOTS 15,16,18,19,21,35,36,52,53,54,56,57,58,59,73 & 74 CYCLE SHEDS/PATHS REVISED		MSR	27.01.26	
-	C07	PLOT 53/54 & 79/80 FENCE REVISED. PLOT 45 ROTATED. PLOTS 1-8 BLOCK REVISED		MSR	11.11.25	
-	C06	ELECTRIC SUB-STATION LOCATION REVISED AND EARTHING ZONE ADDED		MSR	28.10.25	
-	C05	PATHS TO CYCLE STORE ADDED		FP	MSR	03.10.25
-	C04	PATHS NEAR NORTHERN TERMINAL POLES REVISED		MSR	20.08.25	
-	C03	PATH REVISED, AREA SHOWN IN ABYSSANCE		MSR	29.05.25	
-	C02	LAYOUT REVISED		FP	MSR	29.01.25
-	C01	BUILDINGS UPDATED & LAYOUT REVISED		FP	MSR	16.01.25
-	P01	CONSTRUCTION ISSUE				
-	P01	INITIAL ISSUE				
-	Dt	Description	Drm	Chk	Date	24.10.24
REVISIONS						
Preliminary Issue			Submitted for S104			
Planning Issue			Issued for Tender			
Submitted for S38			Issued for Construction			
Submitted for S278			As Built			
DRAWING STATUS						

STUART MICHAEL ASSOCIATES
CONSULTING ENGINEERS

Stuart Michael Associates Ltd
Coombe House, Coombe Square, Thatcham, Berkshire RG19 4JF

T: 01635 867 711 e: mail@stuartmichael.co.uk
F: 01635 861 715 w: www.stuartmichael.co.uk



JOB TITLE: **WOOD VALE EAST BILLINGHURST**

DRAWING TITLE: **GENERAL ARRANGEMENT LAYOUT**

DATE	DRAWN	CHECKED	SCALE	BY
OCT. 2024	JS	CL	1:500	0A1
7276-SMA-XX-XX-DR-C-0500 C11 SO				
This drawing is the copyright of Stuart Michael Associates Limited. It may not be reproduced or amended without the written approval of Stuart Michael Associates				

