
0 50

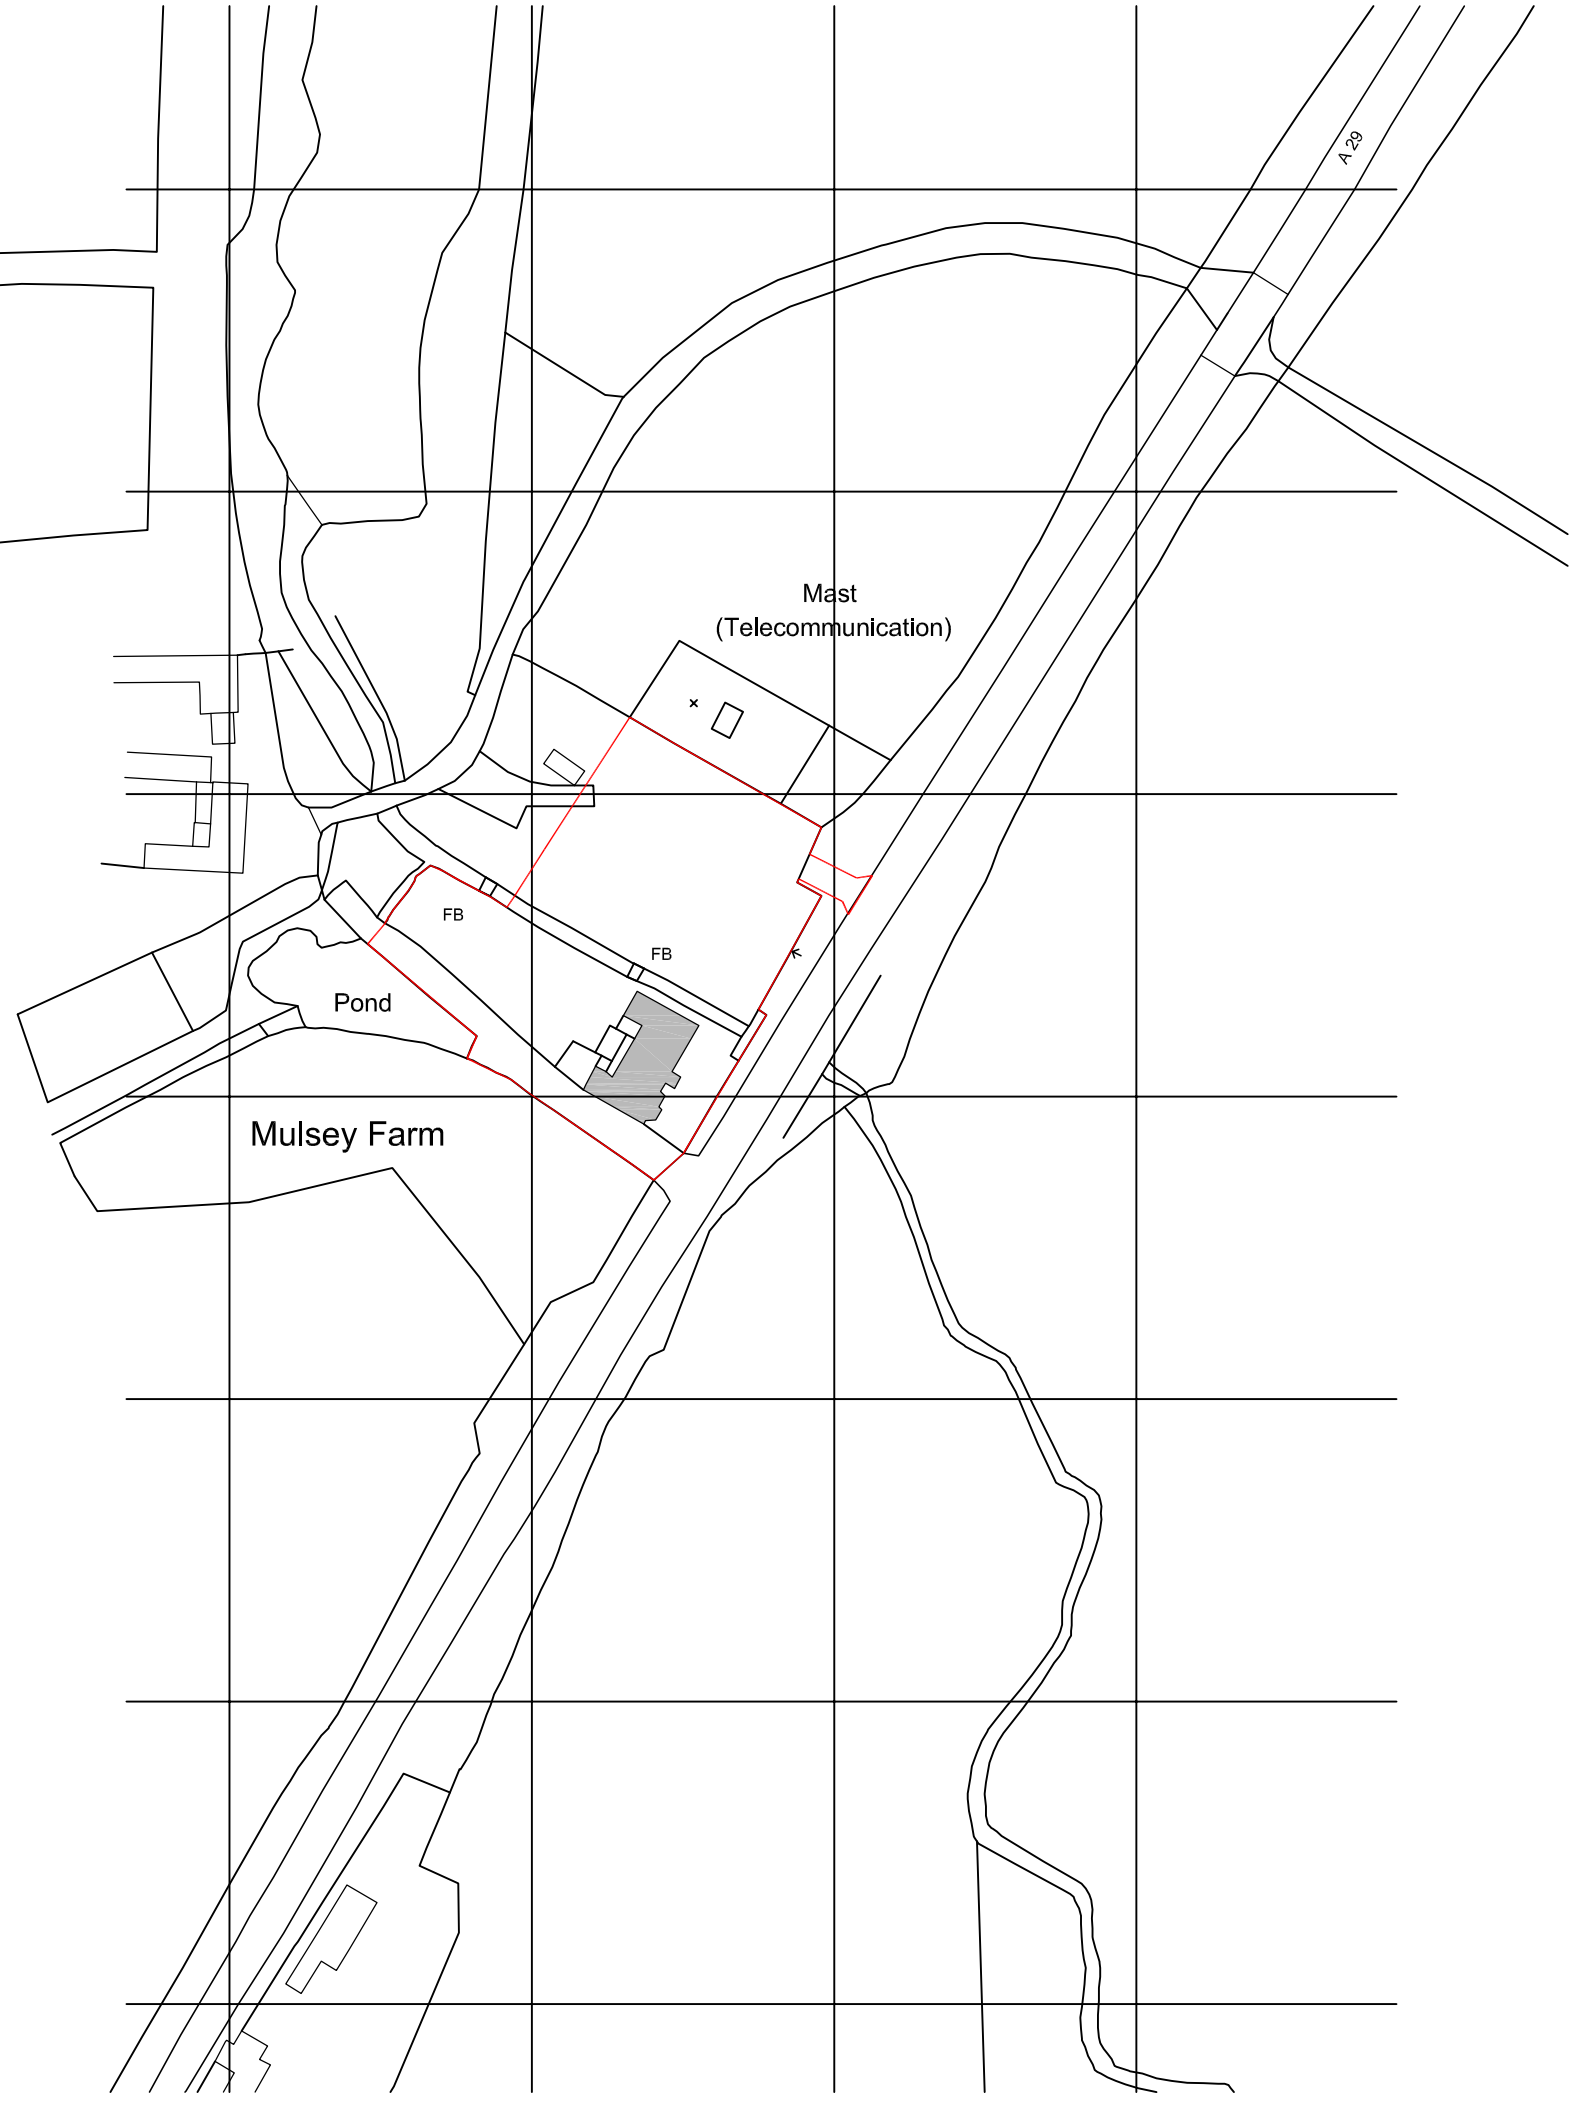

This drawing is to be read in conjunction with all other relevant drawings and specifications.
Do not scale from this drawing (Unless for planning purposes). Use figured dimensions only.
All levels and dimensions to be checked on site prior to commencement of works on site.
All dimensional discrepancies are to be brought to the immediate attention of the originator.
Responsibility cannot be accepted for alteration and/or deviation from this design without prior knowledge.
Copyright reserved.
This drawing may only be used under licence for the client and location specified in the title block. It may not be copied or disclosed to any other third party without prior written consent.

It is the responsibility of the Client to check Legal Boundaries are correctly indicated and that relevant Party Wall Notices (usually served via a Surveyor) where required have been served to adjoining neighbours prior to any commencement of works. No responsibility will be held by Simon Harvey Designs Ltd for any failure in the above.

B - Red line amended to include access across Highways land. Notice served to WSCC Highways. - 05.10.2023

A - Scheme revised to omit Workshop. Boundary treatments and driveway revised.

Revision

PLANNING

SIMON HARVEY DESIGNS LTD

2 Greenfield Way,
Storrington,
West Sussex.
RH20 4PY

t: 07833 178649
e:office@simonharveydesigns.com

Client: Mr J. Bird

Project: New driveway access, boundary treatments and electric gates at;

Address:
Mulsey Farmhouse,
Stane Street,
Pulborough,
West Sussex.
RH20 1DJ.

Drawing Title: SITE LOCATION PLAN

Drawing Number: 89_100

Date: March 2023

Scale:1:1250@A3