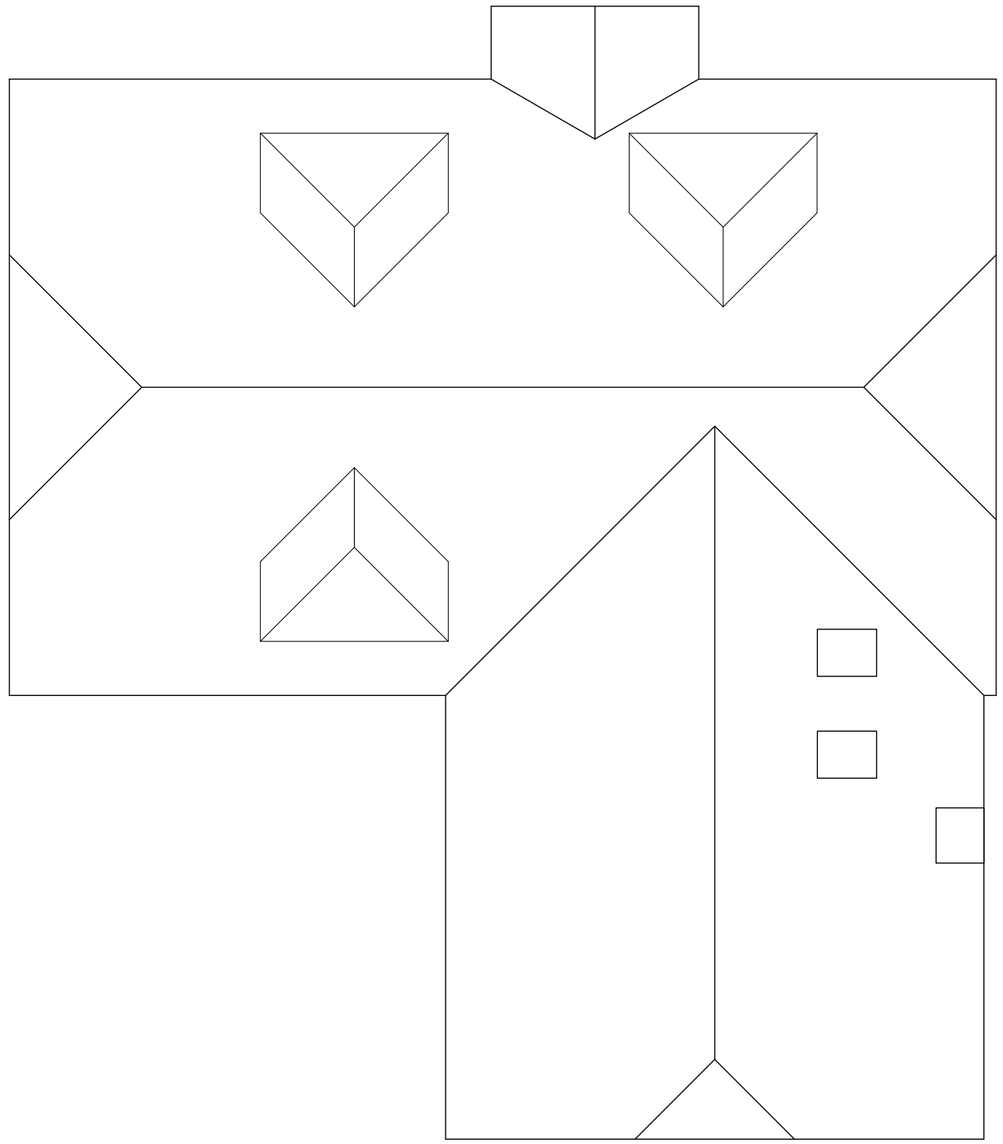


N

EXISTING ROOF

0 0 0 1.0 2.0 3.0 4.0 5.0 M

Sheet No. D 1224/725/06

Scales Page Size A3:
1:100

Notes:

Project Name:
As Built Dwelling
and workshop

Date: 04/12/2024

Client:
Sadler

Site Address:
Butlers Ghyll Farmhouse
Pollards Drive
Southwater
RH13 9AQ

PB PROPERTIES
the design to build on

Paul Maggs MCIAT

Hazelwood, Harbolets Road,
West Chltington RH20 2LG

Tel: 01798 813298

paul@pbproperties.co.uk
www.pbproperties.co.uk

Drawings produced using Vectorworks CAD. Only written dimensions to be respected. Copyright protected to PB Properties

CIAT
CHARTERED PRACTICE