



Front East Elevation

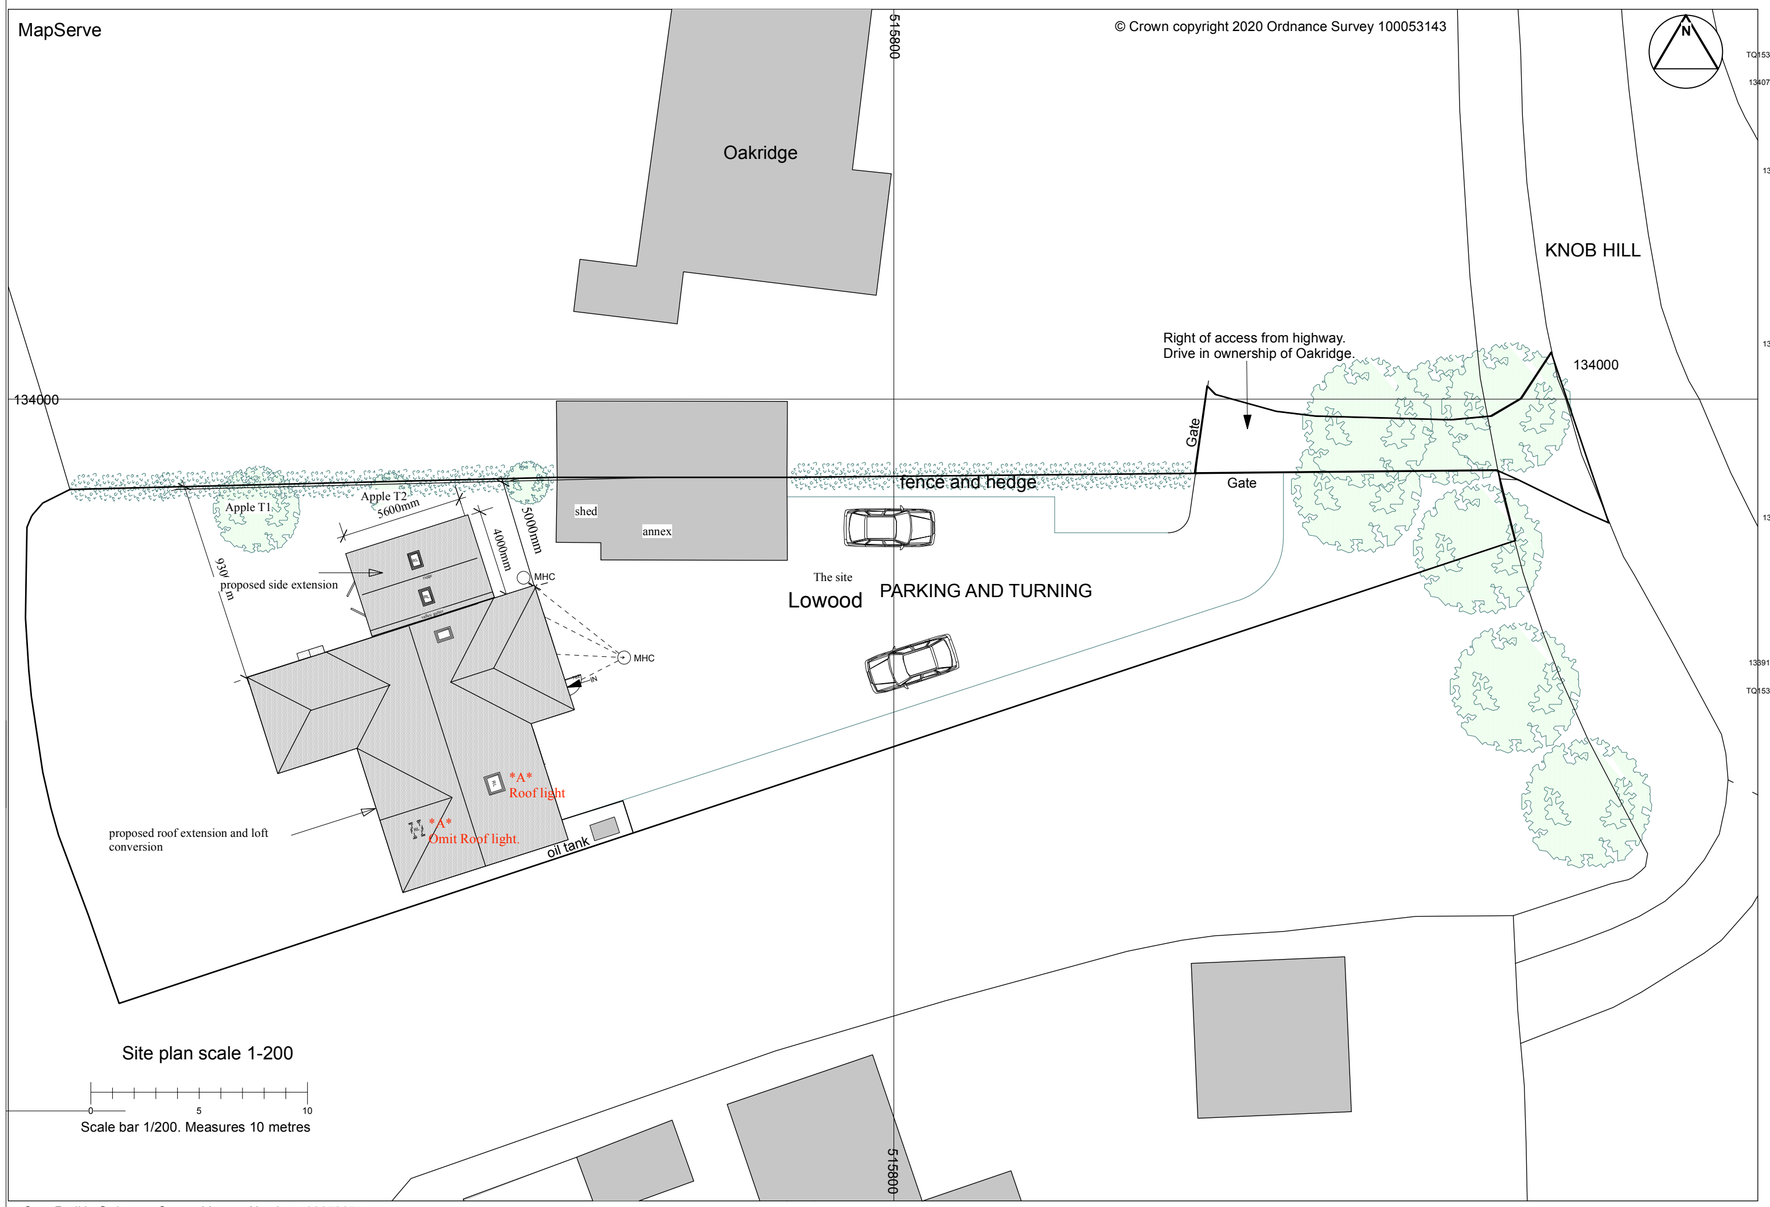

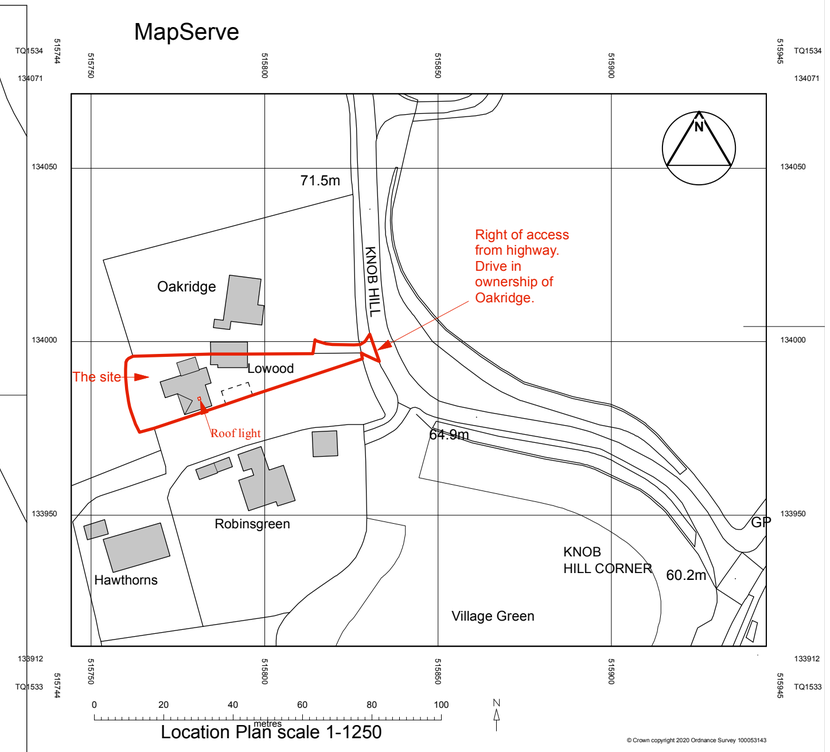

Sara Rudkin Ordnance Survey Licence Number 100053651

Drawing submitted as planning application
one of three drawings numbered BD-20-01A, 02 & 03.
12th December 2020
Horsham DC Ref: DC/20/2490
Planning permission granted 16th February 2021
with 4 conditions. Valid for 3 years

Sara Rudkin RIBA Architect
5 Thornden Cowfold Horsham West Sussex, RH13 8AG **Tel: 01403 864 530.**
e-mail: sararudkin@btinternet.com www.sararudkin.co.uk

Original size A2

Title of project: Retrospective Planning Application for Roof light in front elevation

REV A Dec 2020 Hatching removed from red line
REV B JANUARY 2024 Velux window in front elevation.

This drawing is Copyright: Refer to Architect concerning Licence for use.

Client: **Mr and Mrs Daniel**
Location: **Lowood Knob Hill Warnham West Sussex RH12 3SN**

Date: **January 2024** Drawn : **SER** Scale(s): **1:1250, 1: 200**

Title: **Location Plan site plan and Photos**
Drawing No: **BD/20/01B**