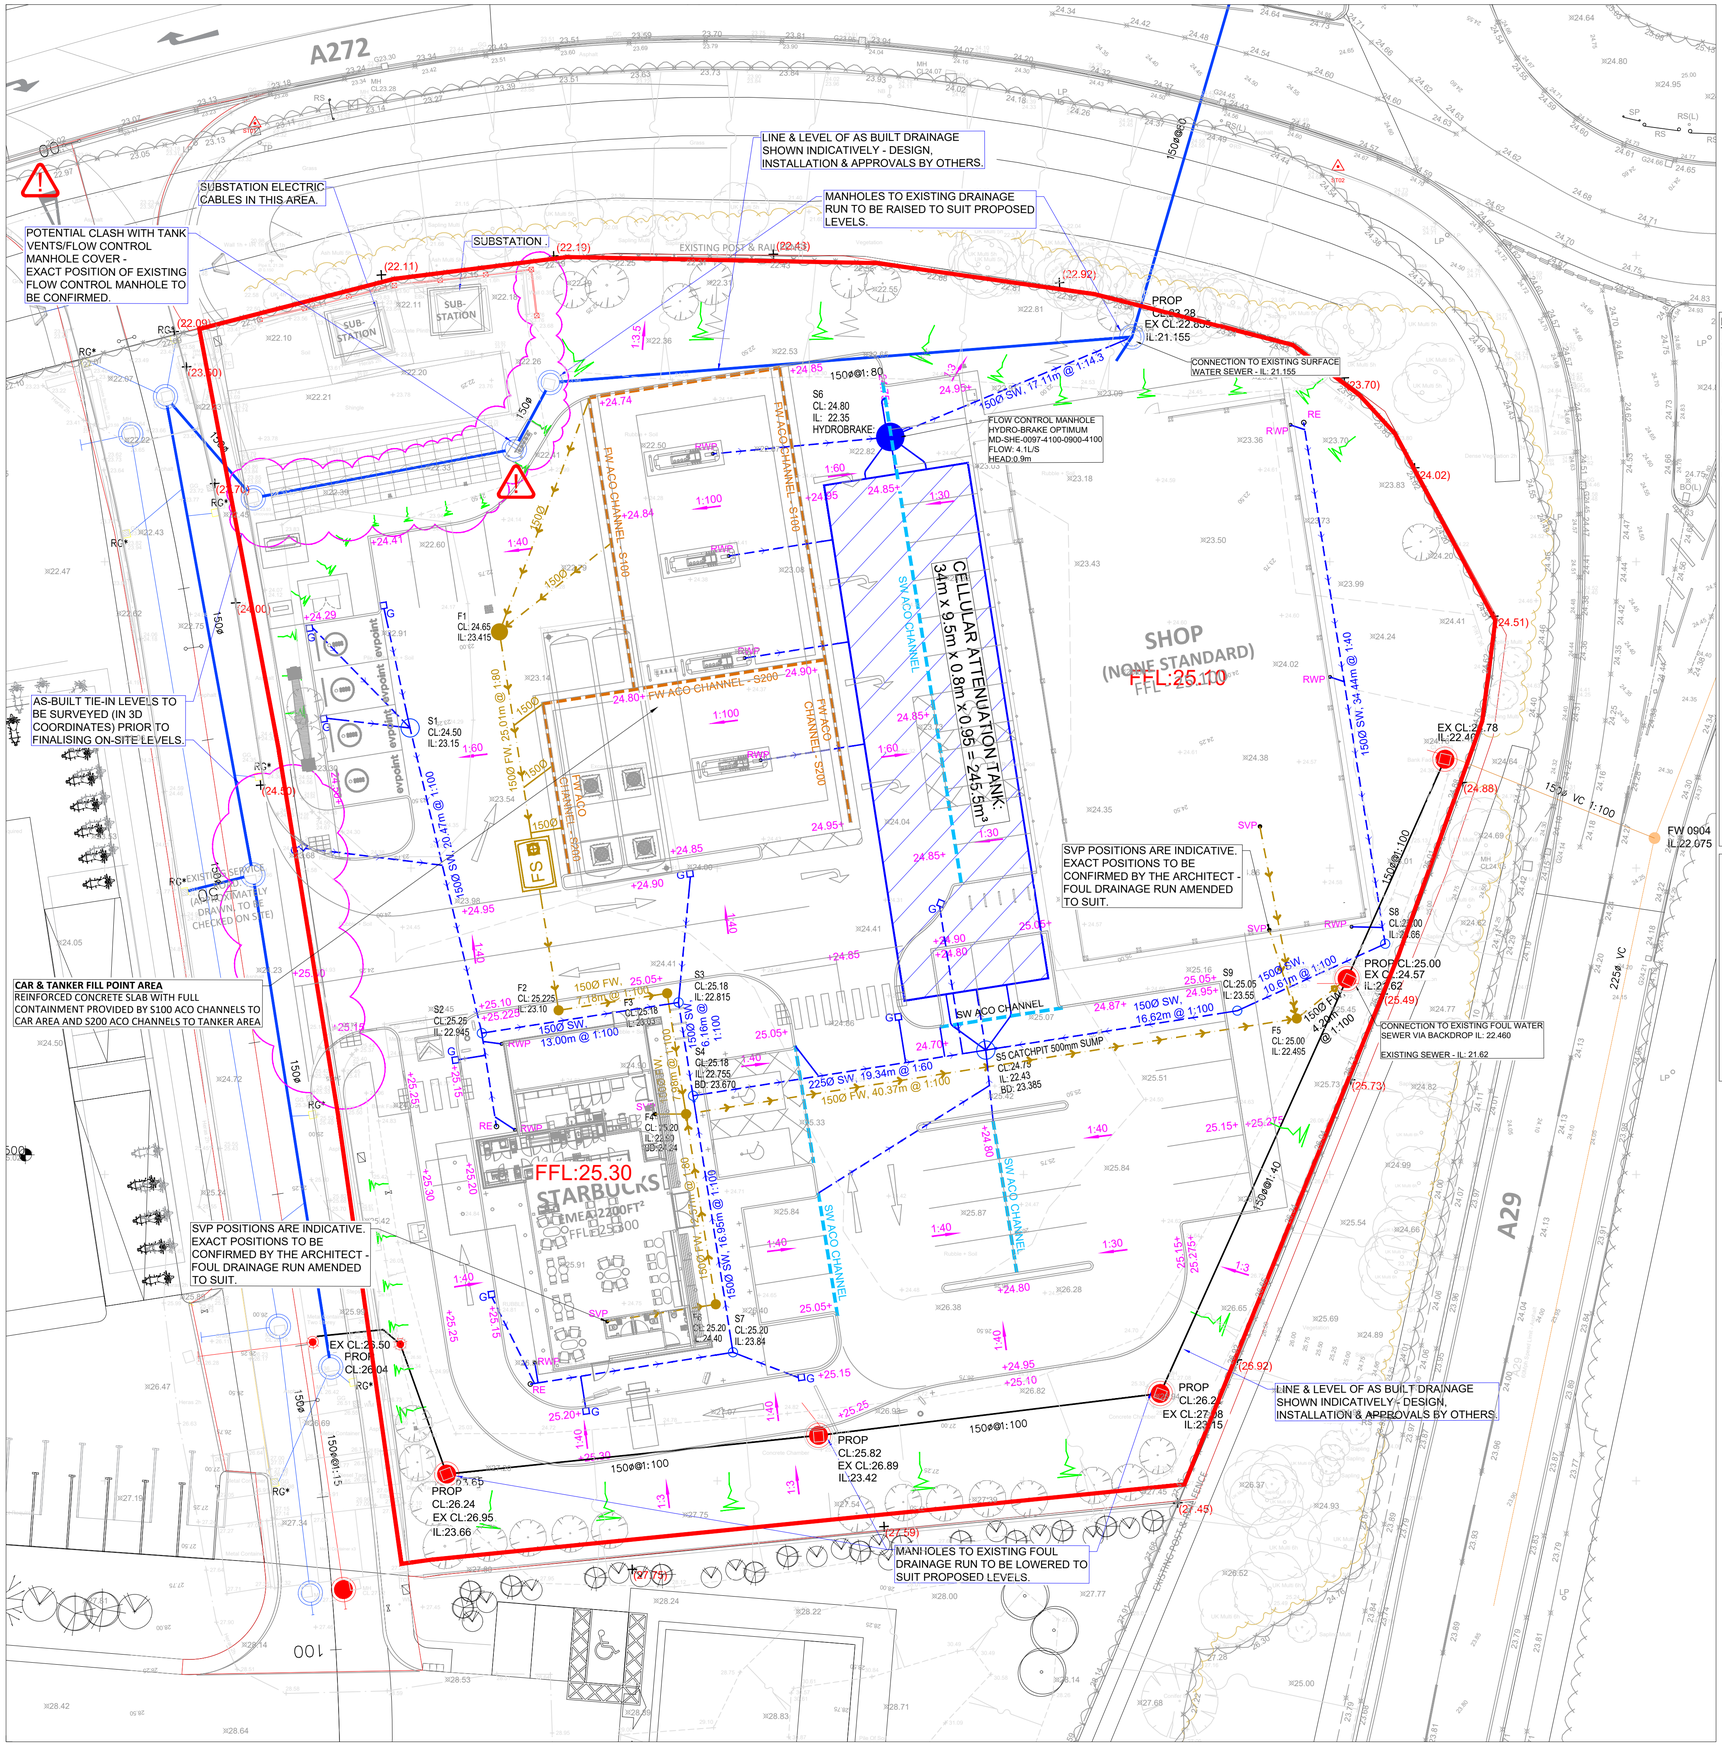

OPERATION AND MAINTENANCE REQUIREMENTS FOR ATTENUATION STORAGE TANKS

MAINTENANCE SCHEDULE	REQUIRED ACTION	TYPICAL FREQUENCY
REGULAR MAINTENANCE	INSPECT & IDENTIFY ANY AREAS THAT ARE NOT OPERATING CORRECTLY. IF REQUIRED, TAKE REMEDIAL ACTION	MONTHLY FOR 3 MONTHS THEN ANNUALLY
	REMOVE DEBRIS FROM THE CATCHMENT SURFACE (WHERE IT MAY CAUSE RISK TO PERFORMANCE)	MONTHLY
	REMOVE SEDIMENT FROM PRE-TREATMENT ROAD GULLIES & SILT TRAP MANHOLE	MONTHLY FOR 3 MONTHS THEN ANNUALLY OR AS REQUIRED
REMEDIAL ACTIONS	REPAIR/REHABILITATE INLETS, OUTLETS, OVERFLOWS & VENTS	AS REQUIRED
MONITORING	INSPECT/CHECK ALL INLETS, OUTLETS, VENTS & OVERFLOWS TO ENSURE THAT THEY ARE IN GOOD CONDITION & OPERATING AS DESIGNED	ANNUALLY
	CCTV SURVEY INSIDE OF TANK FOR SEDIMENT BUILD-UP & REMOVE IF NECESSARY	AFTER CONSTRUCTION, 1 YEAR, & THEN EVERY 5 YEARS OR AS REQUIRED

PROPOSED DRAINAGE KEY:

- SW000 CL: IL: — 150Ø, Xm @ 1:X — SURFACE WATER MH & DRAINAGE RUN
- FW000 CL: IL: — 150Ø, Xm @ 1:X — FOUL WATER MH & DRAINAGE RUN
- SW CL: IL: HYDROBRAKE: — FLOW CONTROL MANHOLE
- SW ACO CHANNEL — SURFACE ACO CHANNEL
- FW ACO CHANNEL — FOUL ACO CHANNEL
- G — SURFACE GULLY
- RE — SURFACE RODDING EYE
- RWP — RAINWATER PIPE
- SVP — SOIL VENT PIPE
- FS — PROPOSED FUEL SEPARATOR KLARGESTER - 10,000L CAPACITY - CLASS 1

PROPOSED LEVELS KEY:

- 1:3 — PROPOSED BANKING
- +3.20 — PROPOSED LEVELS
- 1.60 — PROPOSED GRADIENTS
- +(2.59) — EXISTING BOUNDARY LEVELS
- (x.xxm) — FLAG ON EDGE (F.O.E) RETAINING WALL

EXISTING DRAINAGE KEY:

- Existing Public SW Sewer (& Manhole)
- Existing Public FW Sewer (& Manhole)
- Proposed SW Sewer (& Manhole)
- Proposed FW Sewer (& Manhole)
- RG — 450Ø P.C.C. Road Gully

DO NOT SCALE, IF IN DOUBT ASK. DO NOT INTERROGATE CAD BASE

DRAINAGE NOTES:

1. THIS DRAWING HAS TO BE READ IN CONJUNCTION WITH ALL RELEVANT ARCHITECTS & ENGINEERS DRAWINGS AND SPECIFICATIONS.
2. FOR DRAINAGE DETAILS REFER TO DRAWING ?????/???.
3. FOR LOCATION OF ALL R.W.P's & INTERNAL POP-UP's REFER TO ARCHITECTS DRAWING. ALL DOWN PIPES TO BE FITTED WITH ACCESS HANDHOLES ABOVE F.F.L. OR GROUND LEVEL.
4. ALL GULLY CONNECTIONS TO BE 150Ø U.N.O. ALL S.V.P. CONNECTIONS TO BE MINIMUM 100Ø OR TO MATCH S.V.P. DOWNPIPE IF GREATER. ALL R.W.P. CONNECTIONS TO BE 150Ø OR TO MATCH R.W.P. DOWNPIPE.
5. ALL PIPES UP TO 450Ø TO BE UPVC PIPES. PIPES GREATER THAN 450Ø TO BE CONCRETE.
6. PIPES UNDER ROADS HAVING 1200mm OR LESS COVER ARE TO BE ENCASED IN CONCRETE IN ACCORDANCE WITH THE MANUFACTURERS RECOMMENDATIONS.
7. MANHOLE COVER LEVELS ARE INDICATIVE AND SHOULD BE SET TO SUIT FINISHED ROAD LEVEL AND CAMBER.
8. ALL INTERNAL MANHOLES, INSPECTION COVERS & RODDING EYES TO BE FITTED WITH DOUBLE SEAL COVERS AND MECHANICALLY SCREWED DOWN.
9. ALL EXTERNAL MANHOLES WITHIN ROADS TO BE FITTED WITH LOADCLASS D400 COVERS U.N.O. ALL EXTERNAL MANHOLES WITHIN SOFT LANDSCAPING TO BE FITTED WITH LOADCLASS B125 COVERS U.N.O. ALL IN ACCORDANCE WITH BS EN 124:2015 (ALL PARTS).
10. INVERT LEVELS OF EXISTING DRAINS AND MANHOLES TO BE CONFIRMED ON SITE PRIOR TO COMMENCING OPERATIONS. NO EXISTING SEWER MANHOLE TO BE OPENED OR ENTERED WITHOUT THE PERMISSION OF THE LOCAL AUTHORITY DRAINAGE DEPARTMENT AND THE ATTENDANCE OF SEWER PERSON AS REQUIRED.
11. DRAINAGE DESIGN AND INSTALLATION TO BE TO THE SATISFACTION OF THE LOCAL BUILDING CONTROL DEPARTMENT AND TO COMPLY WITH BS EN 752:2017, BS EN 1610:2015, BS EN 12056-1:2000, BS EN 12056-2:2000 and BS EN 12056-3:2000.
12. ADOPTABLE DRAINAGE WORKS TO BE CARRIED OUT IN ACCORDANCE WITH THE LATEST EDITION OF 'SEWERS FOR ADOPTION'.
13. ALL SUDS COMPONENTS TO BE MAINTAINED IN ACCORDANCE WITH CIRIA C 768.

SURFACE WATER ATTENUATION

CELLULAR TANK

PROPOSED IMPERMEABLE AREA: 3778m²

DISCHARGE RATE = 4.1L/S

CELLULAR TANK DIMENSIONS: 31m x 6.5m x 1.2m x 0.95 = 229.7m³

STORM EVENT: 1 IN 100YR + 40% CLIMATE CHANGE

CDM NOTES

1. ACCESS AND EGRESS TO THE SITE FROM BUSY ROAD.
2. POTENTIAL GROUND INSTABILITY IN DEEP EXCAVATIONS
3. NO HEAVY PLANT OR STOCK PILES PERMITTED OVER OR WITHIN 3m OF THE CONSTRUCTED TANK
4. TANK TO BE FULLY PROTECTED FROM SILT AND DEBRIS INGRESS DURING CONSTRUCTION, AND TO BE INSPECTED AND MAINTAINED DURING OPERATION AS DETAILED ABOVE
5. TANKS NOT DESIGNED TO RESIST UPLIFT UNTIL FULLY BACKFILLED
6. EXISTING SERVICES IDENTIFIED ON SITE.
7. ADEQUATE SEGREGATION HOARDING REQUIRED TO SEPARATE PUBLIC FROM THE CONSTRUCTION SITE.
8. ADEQUATE MEASURES REQUIRED TO CONTROL NOISE, DUST, FUMES & VIBRATION.

REV.	DATE.	REVISION.	BY.	CHK.
–		FIRST ISSUE.	PH	NB
A	21.06.21	AMENDED TO SUIT LATEST SITE LAYOUT PLAN 20106BH-CA-S1-XX-M3-A-S0-210_02 - PROPOSED SITE PLAN.	PH	NB
B	06.03.23	AMENDED TO SUIT LATEST SITE LAYOUT PLAN BILLINGHURST - 221013 - SITE CONSTRUCTION - ISSUE 7 - 03.03.23. EXISTING DRAINAGE TIE-IN LEVELS AMENDED TO SUIT AS-BUILT ARRANGEMENT.	PH	NB
C	08.03.23	ADDITIONAL INFORMATION ADDED TO TANKER AREA. FLOW CONTROL INFORMATION ADDED.	PH	NB

Euro Garages Ltd

Proposed PFS & Drive 'Thru' Restaurant
Newbridge Road, Billingshurst, West Sussex

Drawing Title: Drainage Layout Plan

Goodson Associates
Tel: +44 (0)113 369 7925
Fax: -
Email: leeds@goodsons.com
Web: www.goodsons.com
Consulting Civil, Structural & Transportation Engineers
Fountain House, 4 South Parade,
Leeds, LS1 5QX
Also at Aberdeen, Edinburgh and Glasgow.

CONSTRUCTION

DATE CREATED:	SCALE:	
May 2021	1:200	@ A1

CONTRACT No:	DRAWING No:	REV:
P14923	500	C