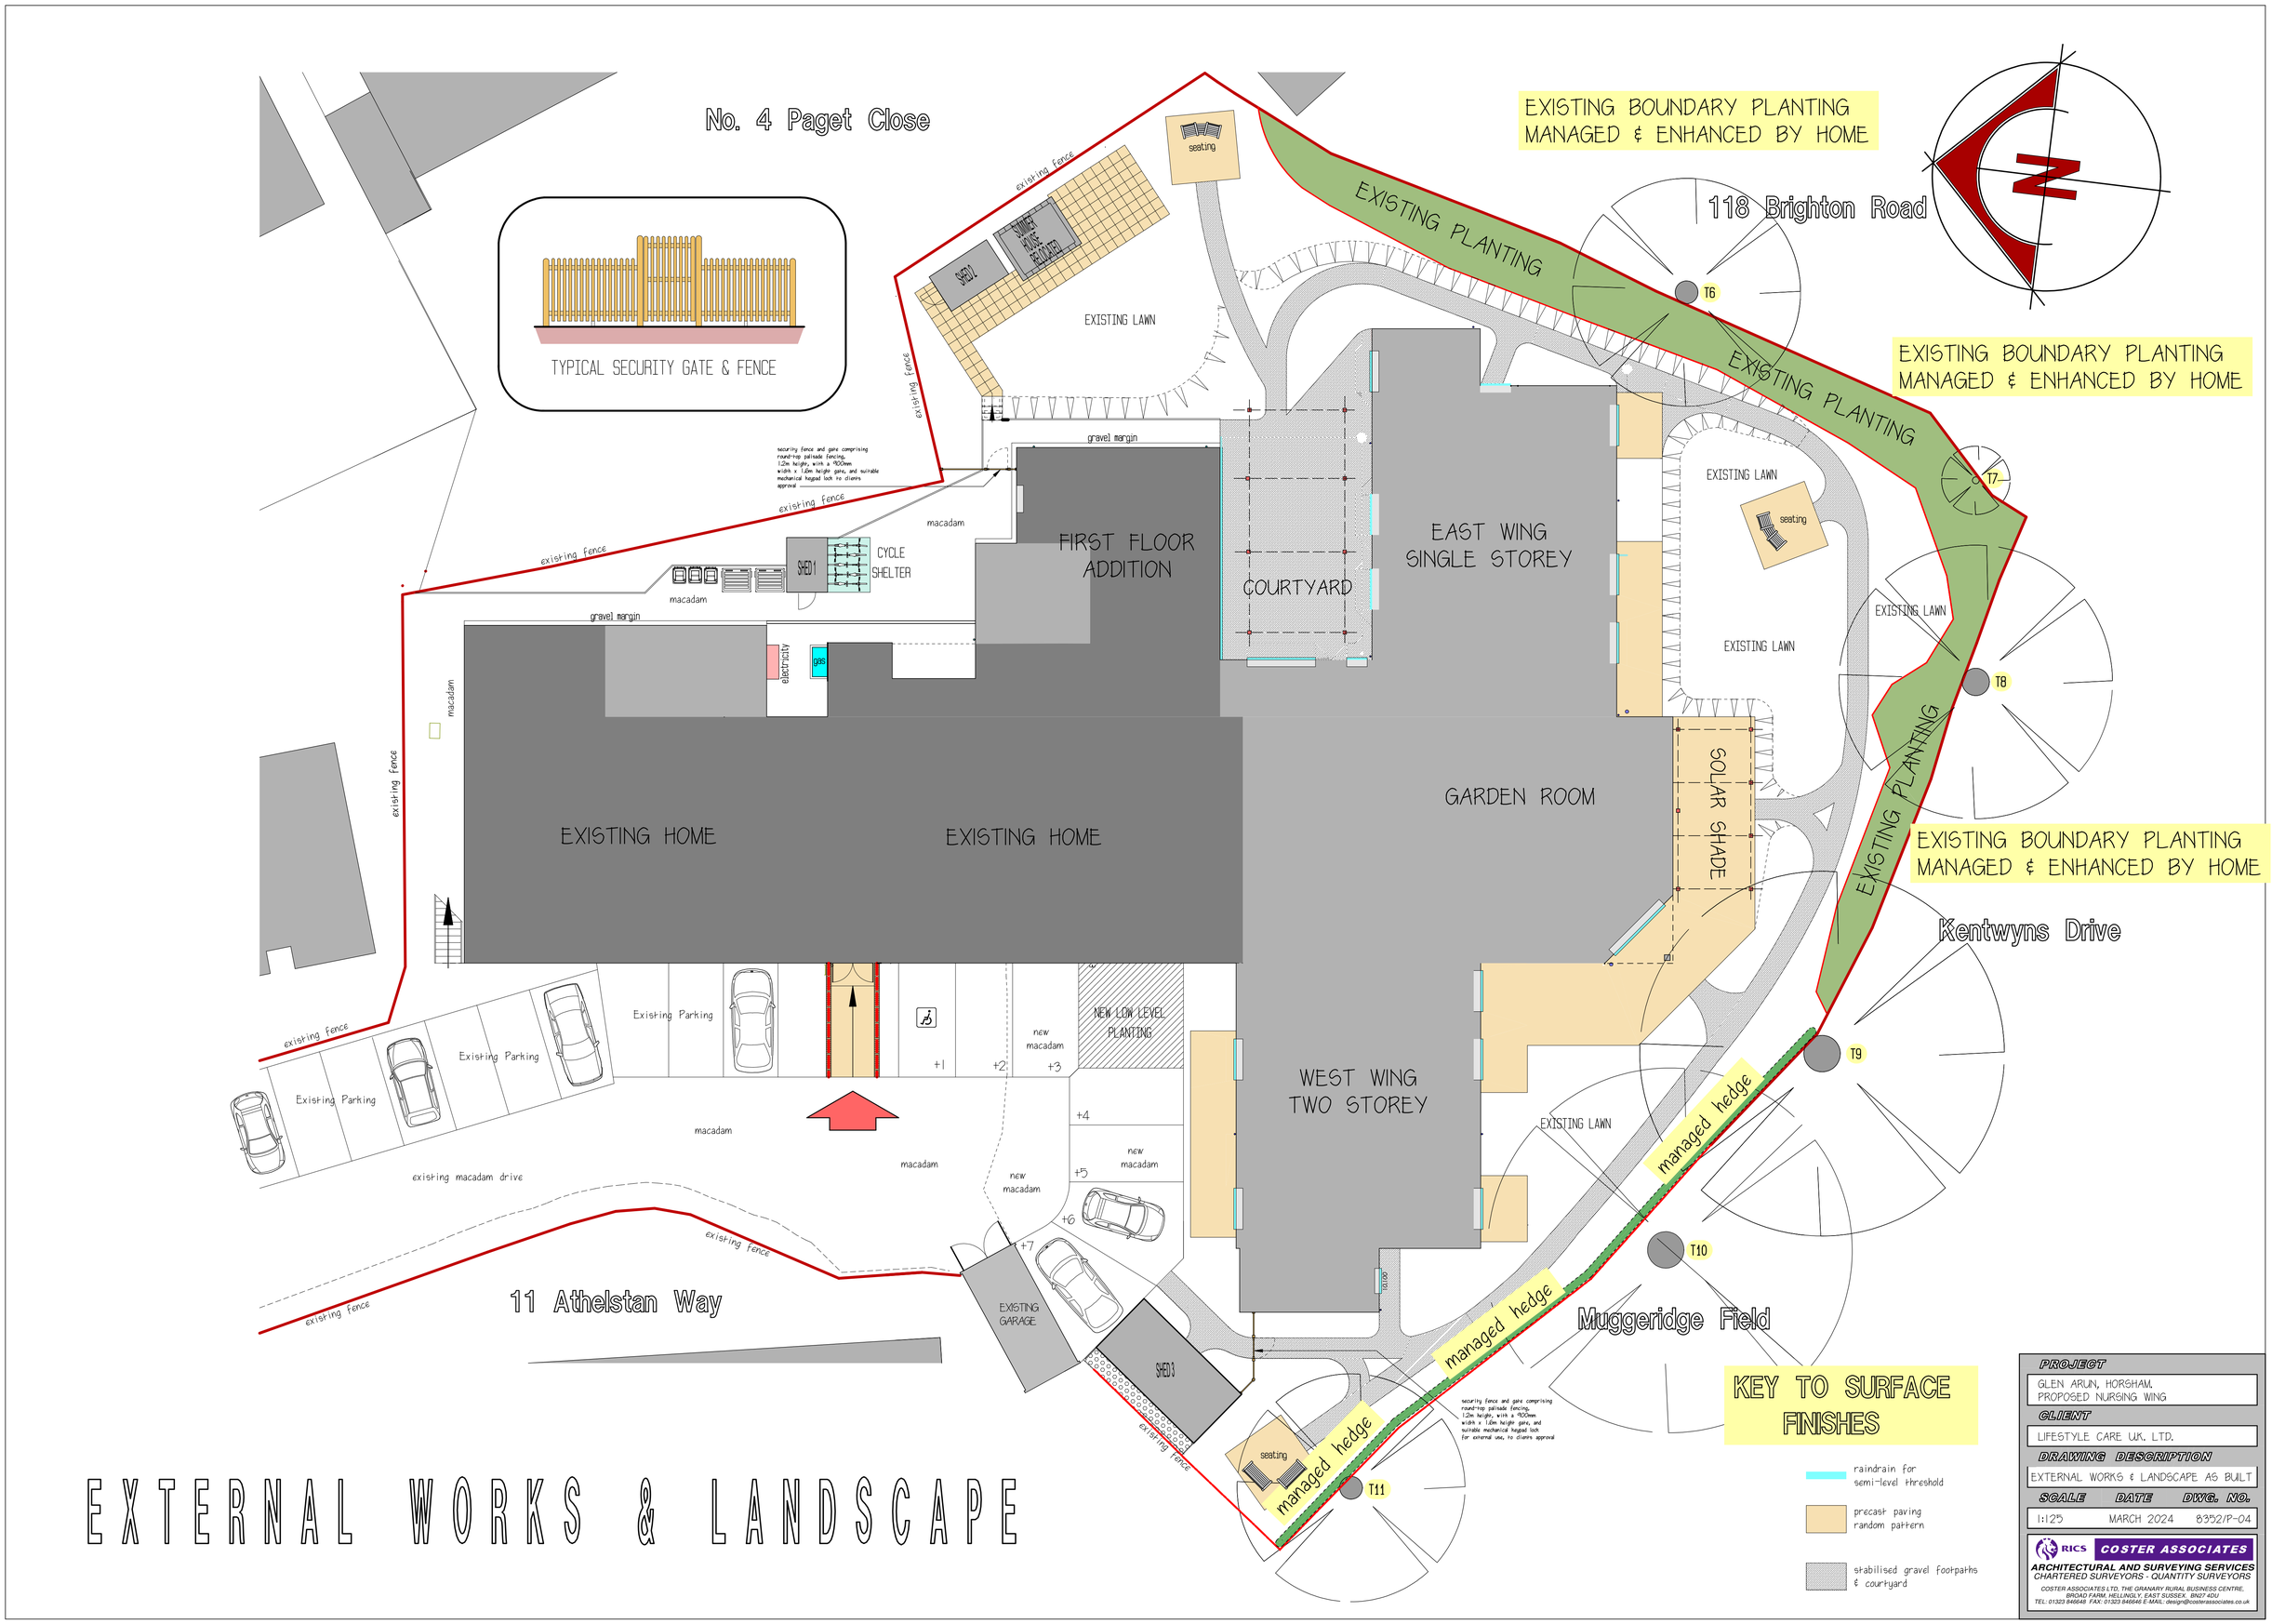

No. 4 Paget Close
TYPICAL SECURITY GATE & FENCE
EXISTING BOUNDARY PLANTING MANAGED & ENHANCED BY HOME
118 Brighton Road
EXISTING PLANTING
EXISTING LAWN
seating
SHED 2
SUMMER HOUSE RELOCATED
existing fence
gravel margin
macadam
CYCLE SHELTER
SHED 1
FIRST FLOOR ADDITION
COURTYARD
EAST WING SINGLE STOREY
electricity
gas
EXISTING HOME
EXISTING HOME
GARDEN ROOM
SOLAR SHADE
T6
T7
T8
T9
T10
T11
Kentwyns Drive
Existing Parking
NEW LOW LEVEL PLANTING
new macadam
WEST WING TWO STOREY
existing macadam drive
11 Athelstan Way
EXISTING GARAGE
SHED 3
managed hedge
Muggeridge Field
KEY TO SURFACE FINISHES
raindrain for semi-level threshold
precast paving random pattern
stabilised gravel footpaths & courtyard
EXTERNAL WORKS & LANDSCAPE
PROJECT
GLEN ARUN, HORSHAM. PROPOSED NURSING WING
CLIENT
LIFESTYLE CARE UK. LTD.
DRAWING DESCRIPTION
EXTERNAL WORKS & LANDSCAPE AS BUILT
SCALE
DATE
DWG. NO.
1:125
MARCH 2024
8352/P-04
RICS
COSTER ASSOCIATES
ARCHITECTURAL AND SURVEYING SERVICES
CHARTERED SURVEYORS - QUANTITY SURVEYORS
COSTER ASSOCIATES LTD, THE GRANARY RURAL BUSINESS CENTRE, BROAD FARM, HELLINGLY, EAST SUSSEX. BN27 4DU
TEL: 01323 846648 FAX: 01323 846646 E-MAIL: design@costerassociates.co.uk