



FRONT ELEVATION FROM ANDREWS LANE (NORTH)

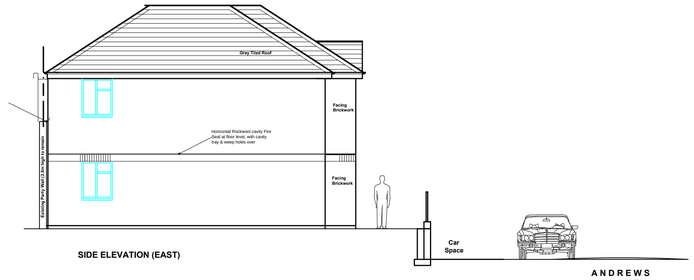


SIDE ELEVATION (EAST)

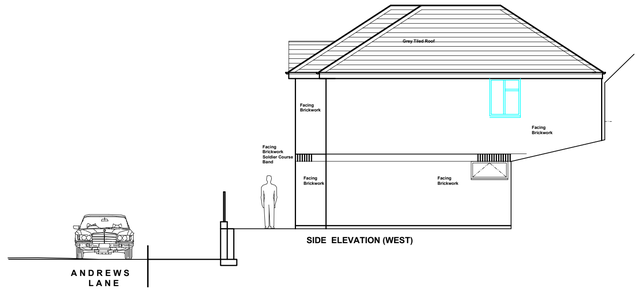

SIDE ELEVATION (WEST)


0 1 2 3 4 5 6 7 8 9 10
Scale - Meters

GF.

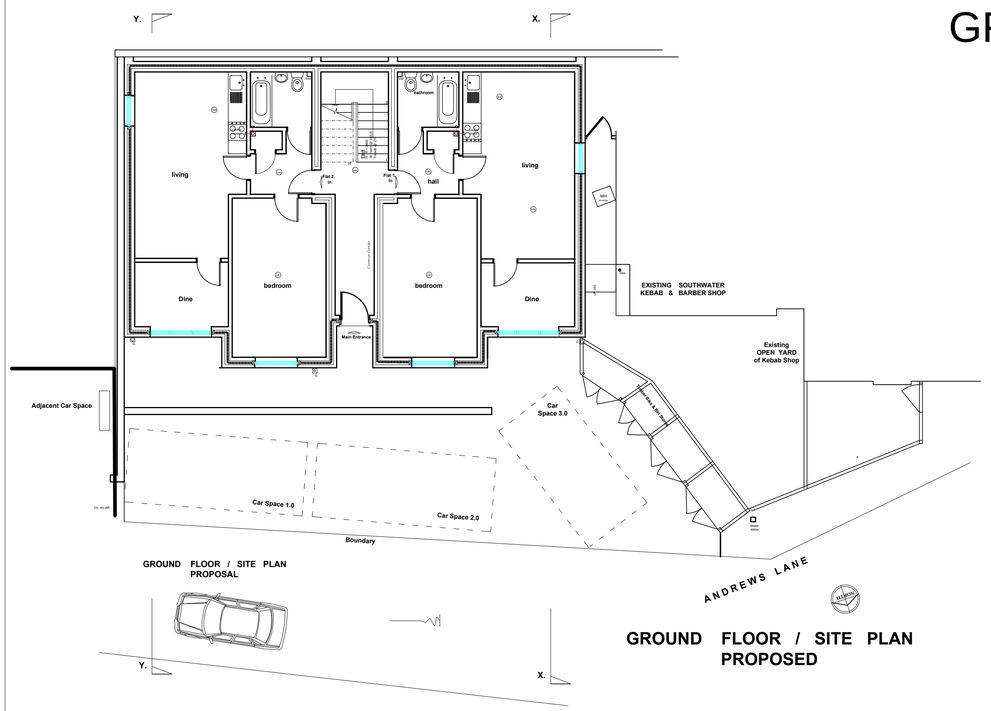

GROUND FLOOR / SITE PLAN PROPOSAL

GROUND FLOOR / SITE PLAN PROPOSED

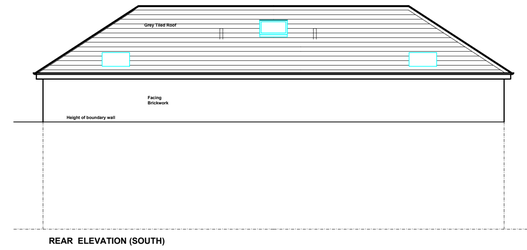

REAR ELEVATION (SOUTH)

IMPORTANT NOTES :

1. GENERAL
(i) The design is to scale shown, work to figured dimensions and relative position, confirm to designer.
(ii) This drawing is to be read in conjunction with all relevant drawings, detailed specifications where applicable and all associated drawings in this series. (if any)
(iii) Any discrepancy on this drawing is to be reported immediately to the partnership for clarification.
(iv) The contractor is responsible for all temporary works and for the stability of the works in progress.

Revision	Date	By	Rev. No.

Client

Project: The Old Bake House, RO Southwater Kebabs, Worthing Road, Southwater

Title: 4 New build Flats As built

CLIVE HAWKINS
ARCHITECTS LTD
DESIGN@CLIVEHAWKINSONLINE.COM Tel: 01273 245249

Date	Scales	Project No.	Dwg. No.	Rev. Date	Rev. No.
June 24	1:100 @ A1	902	21		

902240620Plan appli for Min Amd