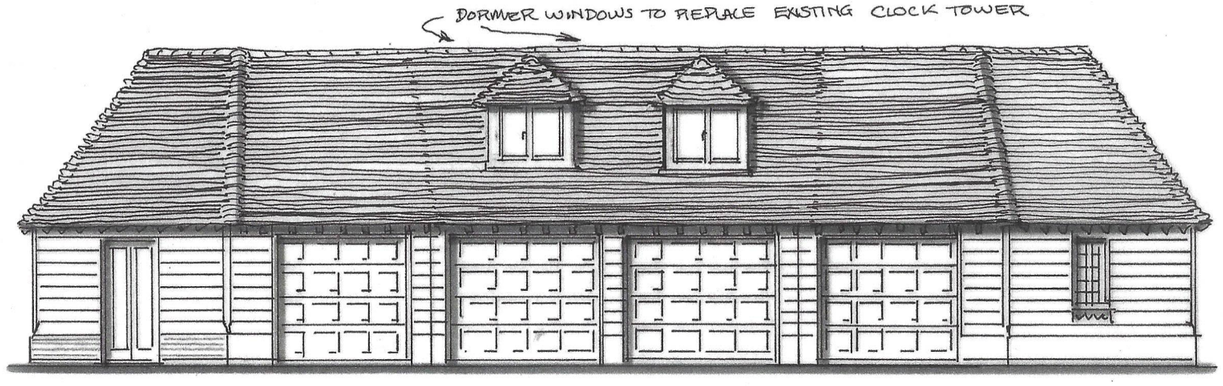

WEST ELEVATION

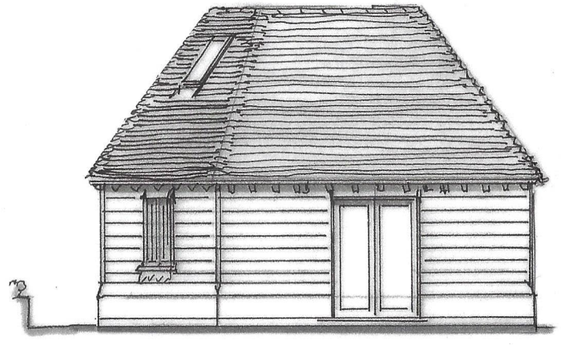

NORTH ELEVATION

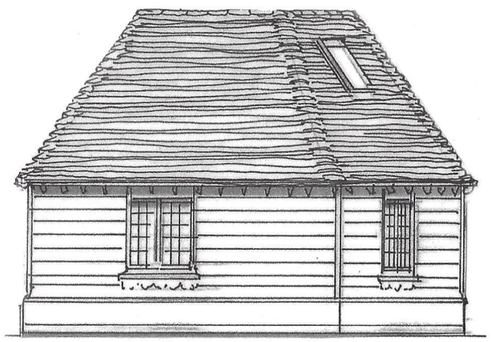

SOUTH ELEVATION

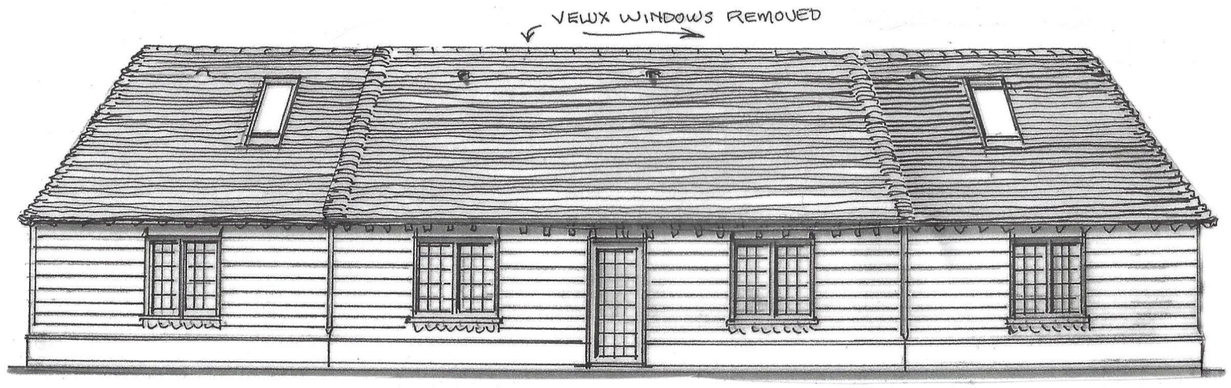

EAST ELEVATION

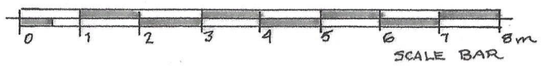

REV	DATE	DESCRIPTION
A	25/11/2024	AS BUILT DWG – TWO FLANKING ROOFLIGHTS RETAINED.

OKEWOOD HOUSE
THE HAVEN · BILLINGSHURST
SUSSEX · RH14 9BS
for M/s Mrs Gregson

ELEVATIONS 1:100 @ A3

SARAH SULLIVAN
THE FORGE · HASCOMBE
SURREY · GU8 4JL
Tel: 01483 208041

DATE: JUNE 2023 | DWG No 2306 05A