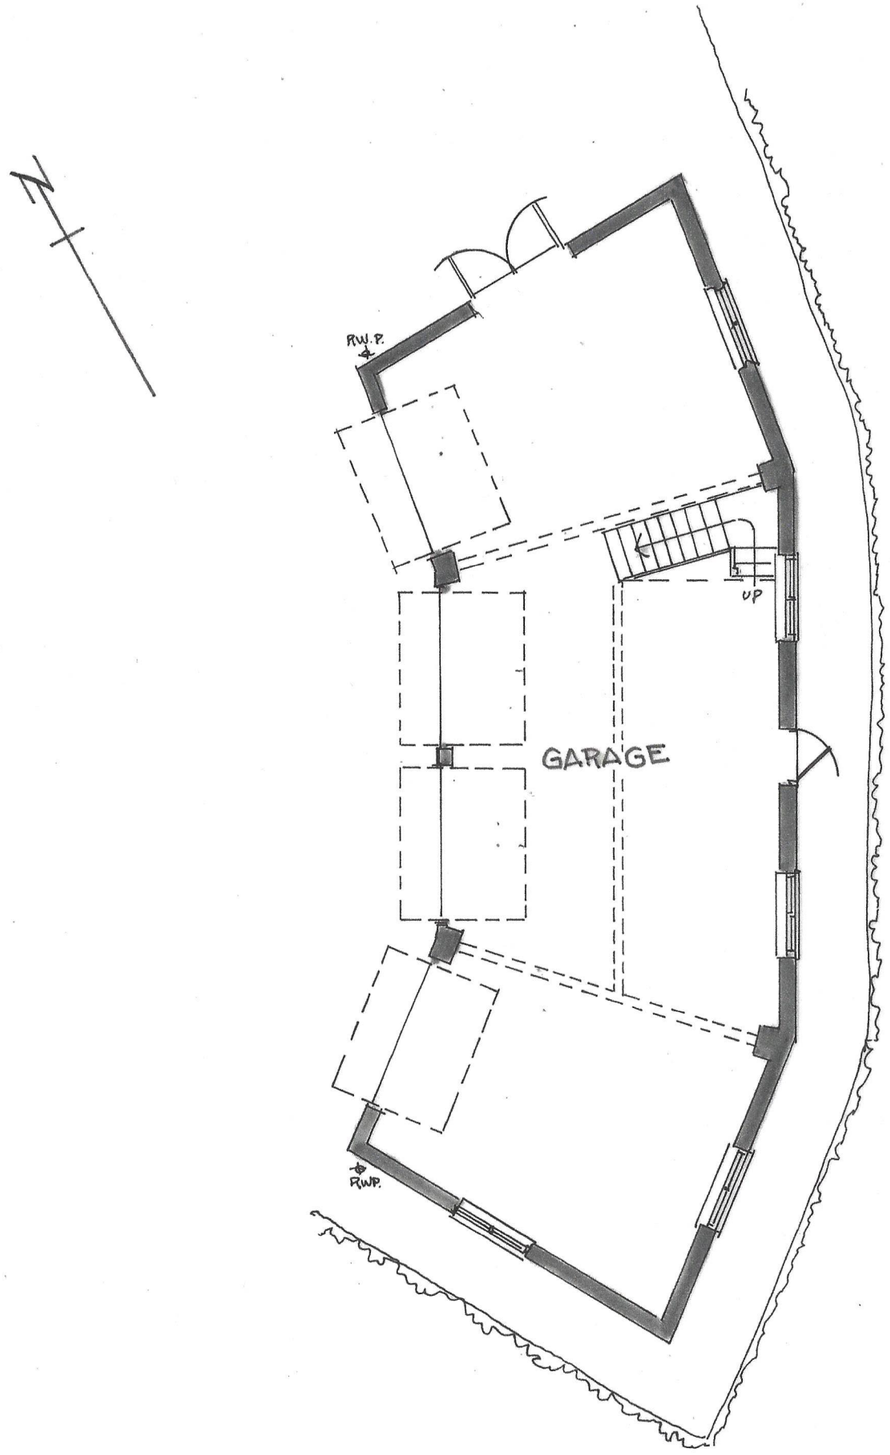

GROUND
FLOOR PLAN 1:100

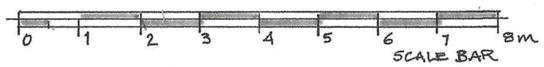

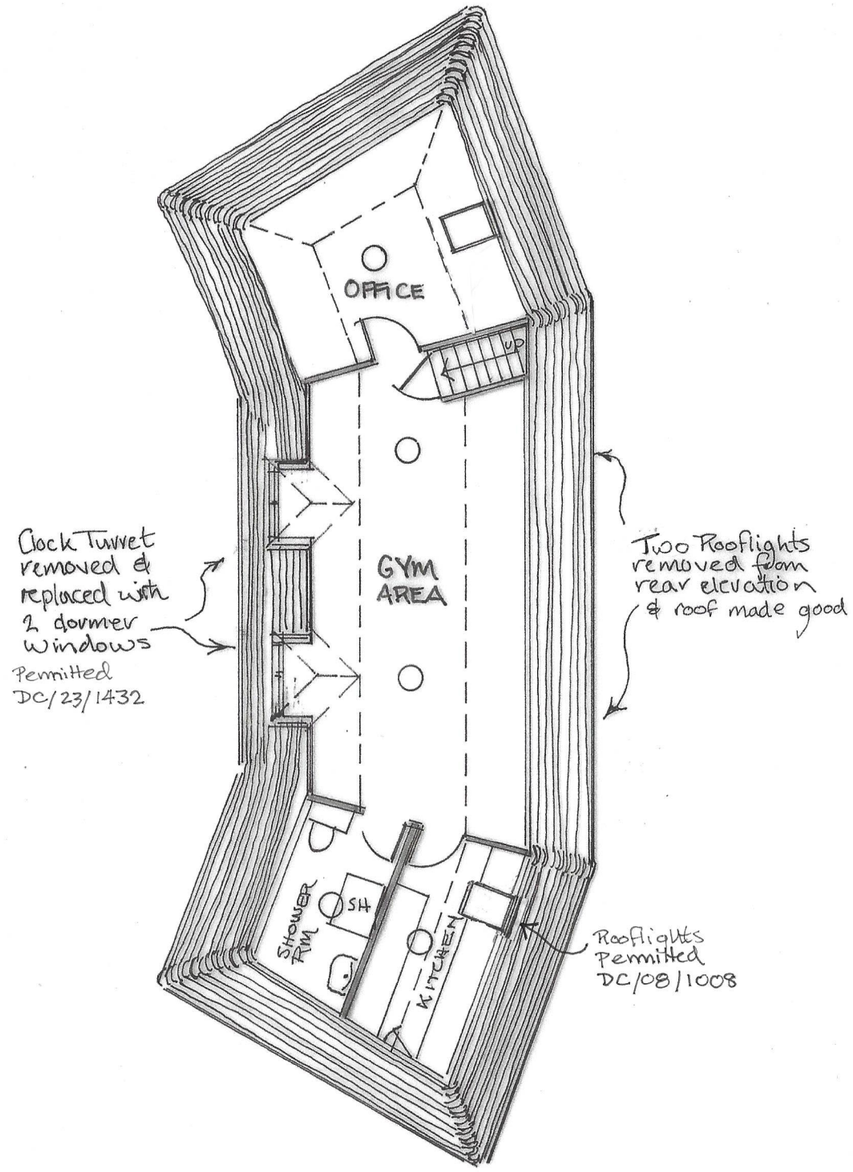

FIRST
FLOOR PLAN 1:100

A	25/11/2024	AS BUILT PLNG. TWO FLANKING ROOFLIGHTS RETAINED
REV	DATE	DESCRIPTION

OKEWOOD HOUSE
THE HAVEN · BILLINGSHURST
SUSSEX · RH14 9BS
for Mr & Mrs Gregson

PLANS 1:100 @ A3

SARAH SULLIVAN
THE FORGE · HASCOMBE
SURREY · GU8 4JL
Tel: 01483 208 041

DATE: JUNE 2023 | DWG No. 2306~~04~~A