

Proposed South (Front) Elevation

0 1m 2m 3m 4m 5m



Proposed North (Rear) Elevation

0 1m 2m 3m 4m 5m

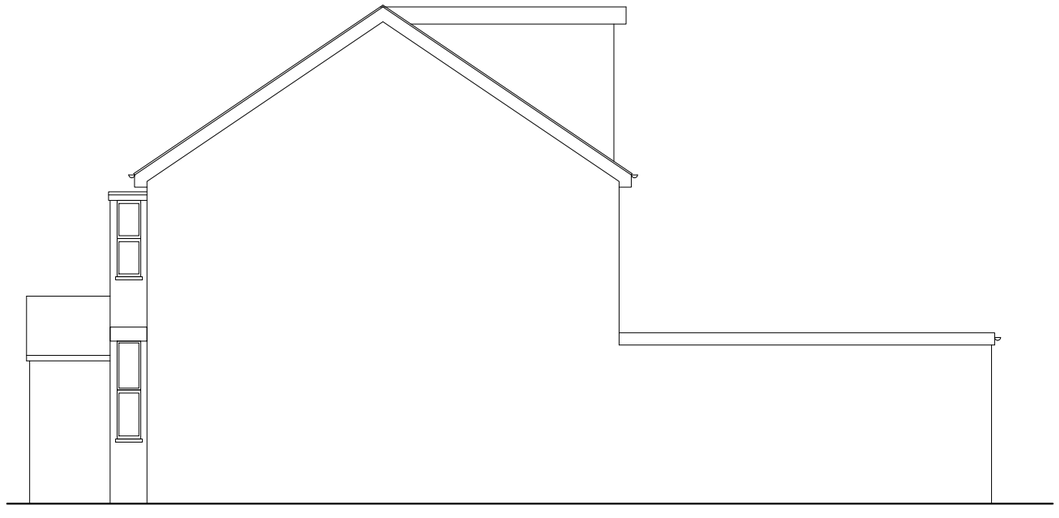

Existing West (Flank) Elevation

0 1m 2m 3m 4m 5m

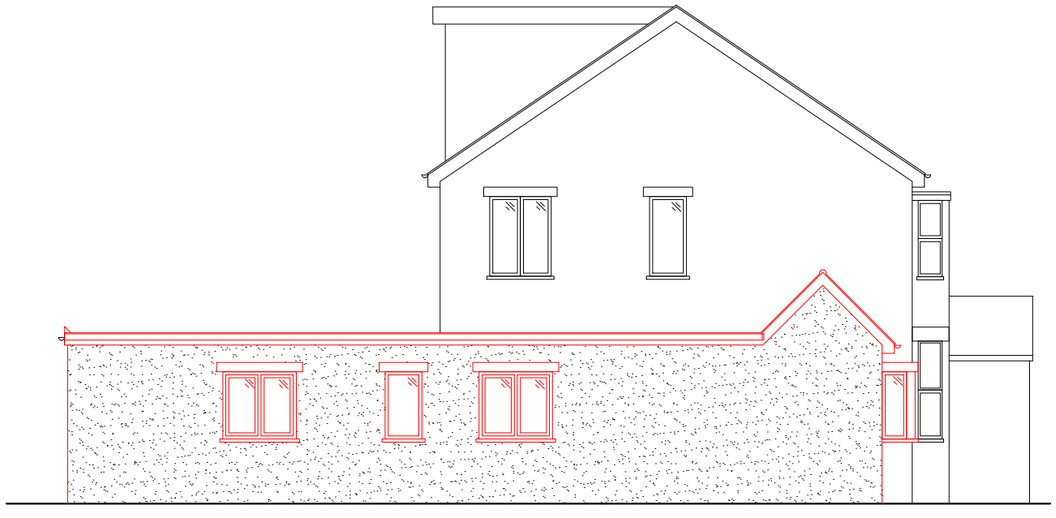

Proposed East (Flank) Elevation

0 1m 2m 3m 4m 5m

DRAWINGS ARE FOR PLANNING PURPOSES ONLY

REV A DATE 08.08.25 DESCRIPTION *Existing dormer added to plans and elevations*

THE CONTRACTOR IS RESPONSIBLE FOR ALL TEMPORARY WORKS AND THE STABILITY OF THE NEW AND EXISTING BUILDING WHILST THE WORKS ARE PROCEEDING. THE CONTRACTOR MUST ENSURE THAT ADEQUATE RISK ASSESSMENTS AND SAFETY MEASURES HAVE BEEN TAKEN.

This drawing is the sole copyright of ADS Ltd. Do not reproduce without written authority.

A. D. S. Ltd.
BUILDING ENGINEERS & SURVEYORS
BROCKHAM HOUSE, 4 SMALLFIELD ROAD, HORLEY ,RH6 9AU
TEL: 01293 782670 MOB: 07876338893 EMAIL: INFO@ADSLTDOFFICE.COM

A3

CDM REGULATIONS 2015 & PARTY WALL ETC. ACT 1996. CLIENTS AND CONTRACTORS ARE REMINDED THAT THE PROJECT IS WITHIN THE SCOPE OF THESE REGULATIONS. ADS LTD. ARE ENGAGED AS DESIGNERS ONLY AND WILL NOT ACCEPT ANY LIABILITY FOR FAILURE OF THOSE PARTIES TO CARRY OUT THEIR DUTIES AS REQUIRED BY THESE STATUTES.

CLIENT	PROJECT	DRAWING	DATE	DRAWING NO.
31 DEPOT ROAD, HORSHAM, RH13 5HE	*SINGLE STOREY SIDE EXTENSION TO FORM ANNEX - RETROSPECTIVE*	*AS BUILT ELEVATIONS*	*APRIL 2025*	*PLN 05*
			SCALE@ A3 *1: 100*	REV *A*