
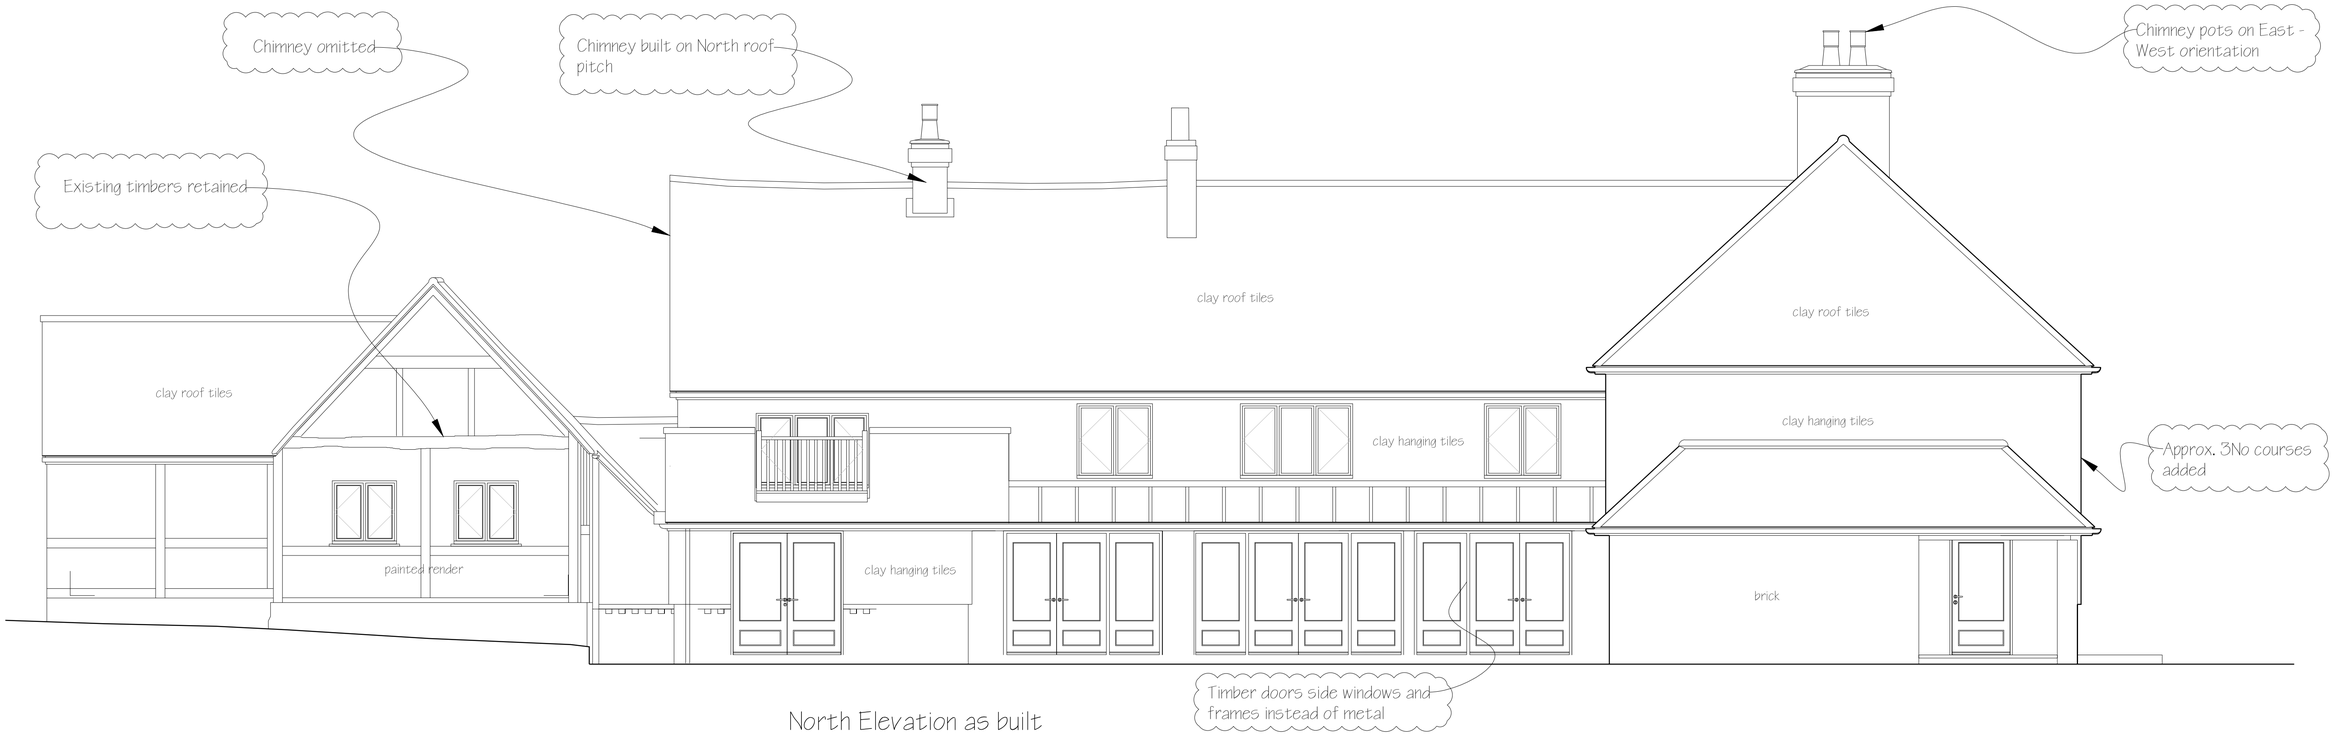


North Elevation as built

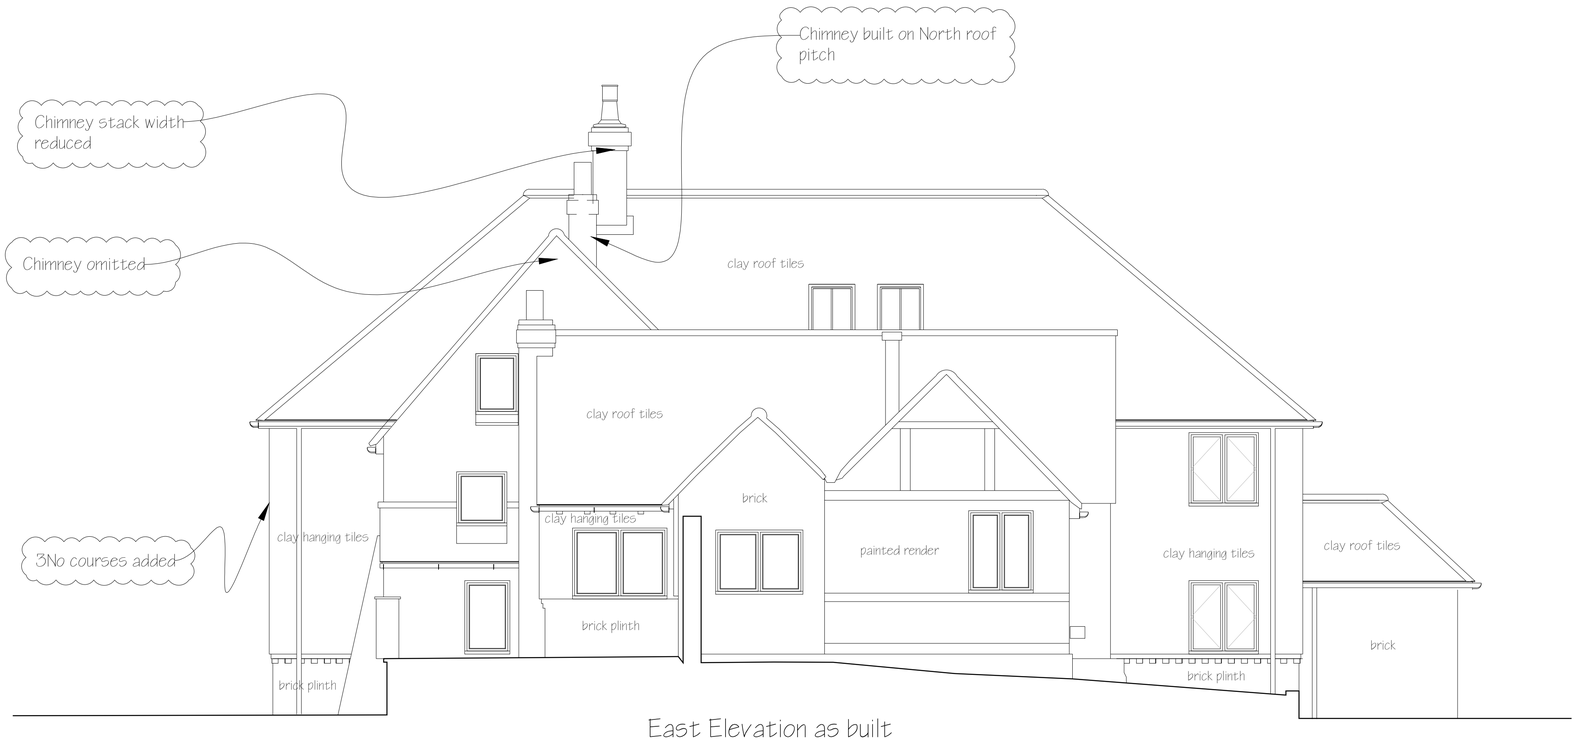

East Elevation as built

1. THIS DRAWING CAN BE SCALED FOR PLANNING
2. Use figured dimensions where given.
3. Report any errors or omissions immediately
4. Check all dimensions on site prior to construction.

Meters
0 1 2 3
for Scale 1:50

North and East elevations
Amendments to approved planning drawing
As prepared by Fowler Architecture & Design
Scale 1:50 @ A3

Client:	Mr. C. Gregson
Project:	Okewood
Drawing:	North and East elevations Amendments to as as built DC/22/0871
Scale:	1:50 @ A1
Drawing No:	OKE 011
Revision:	