


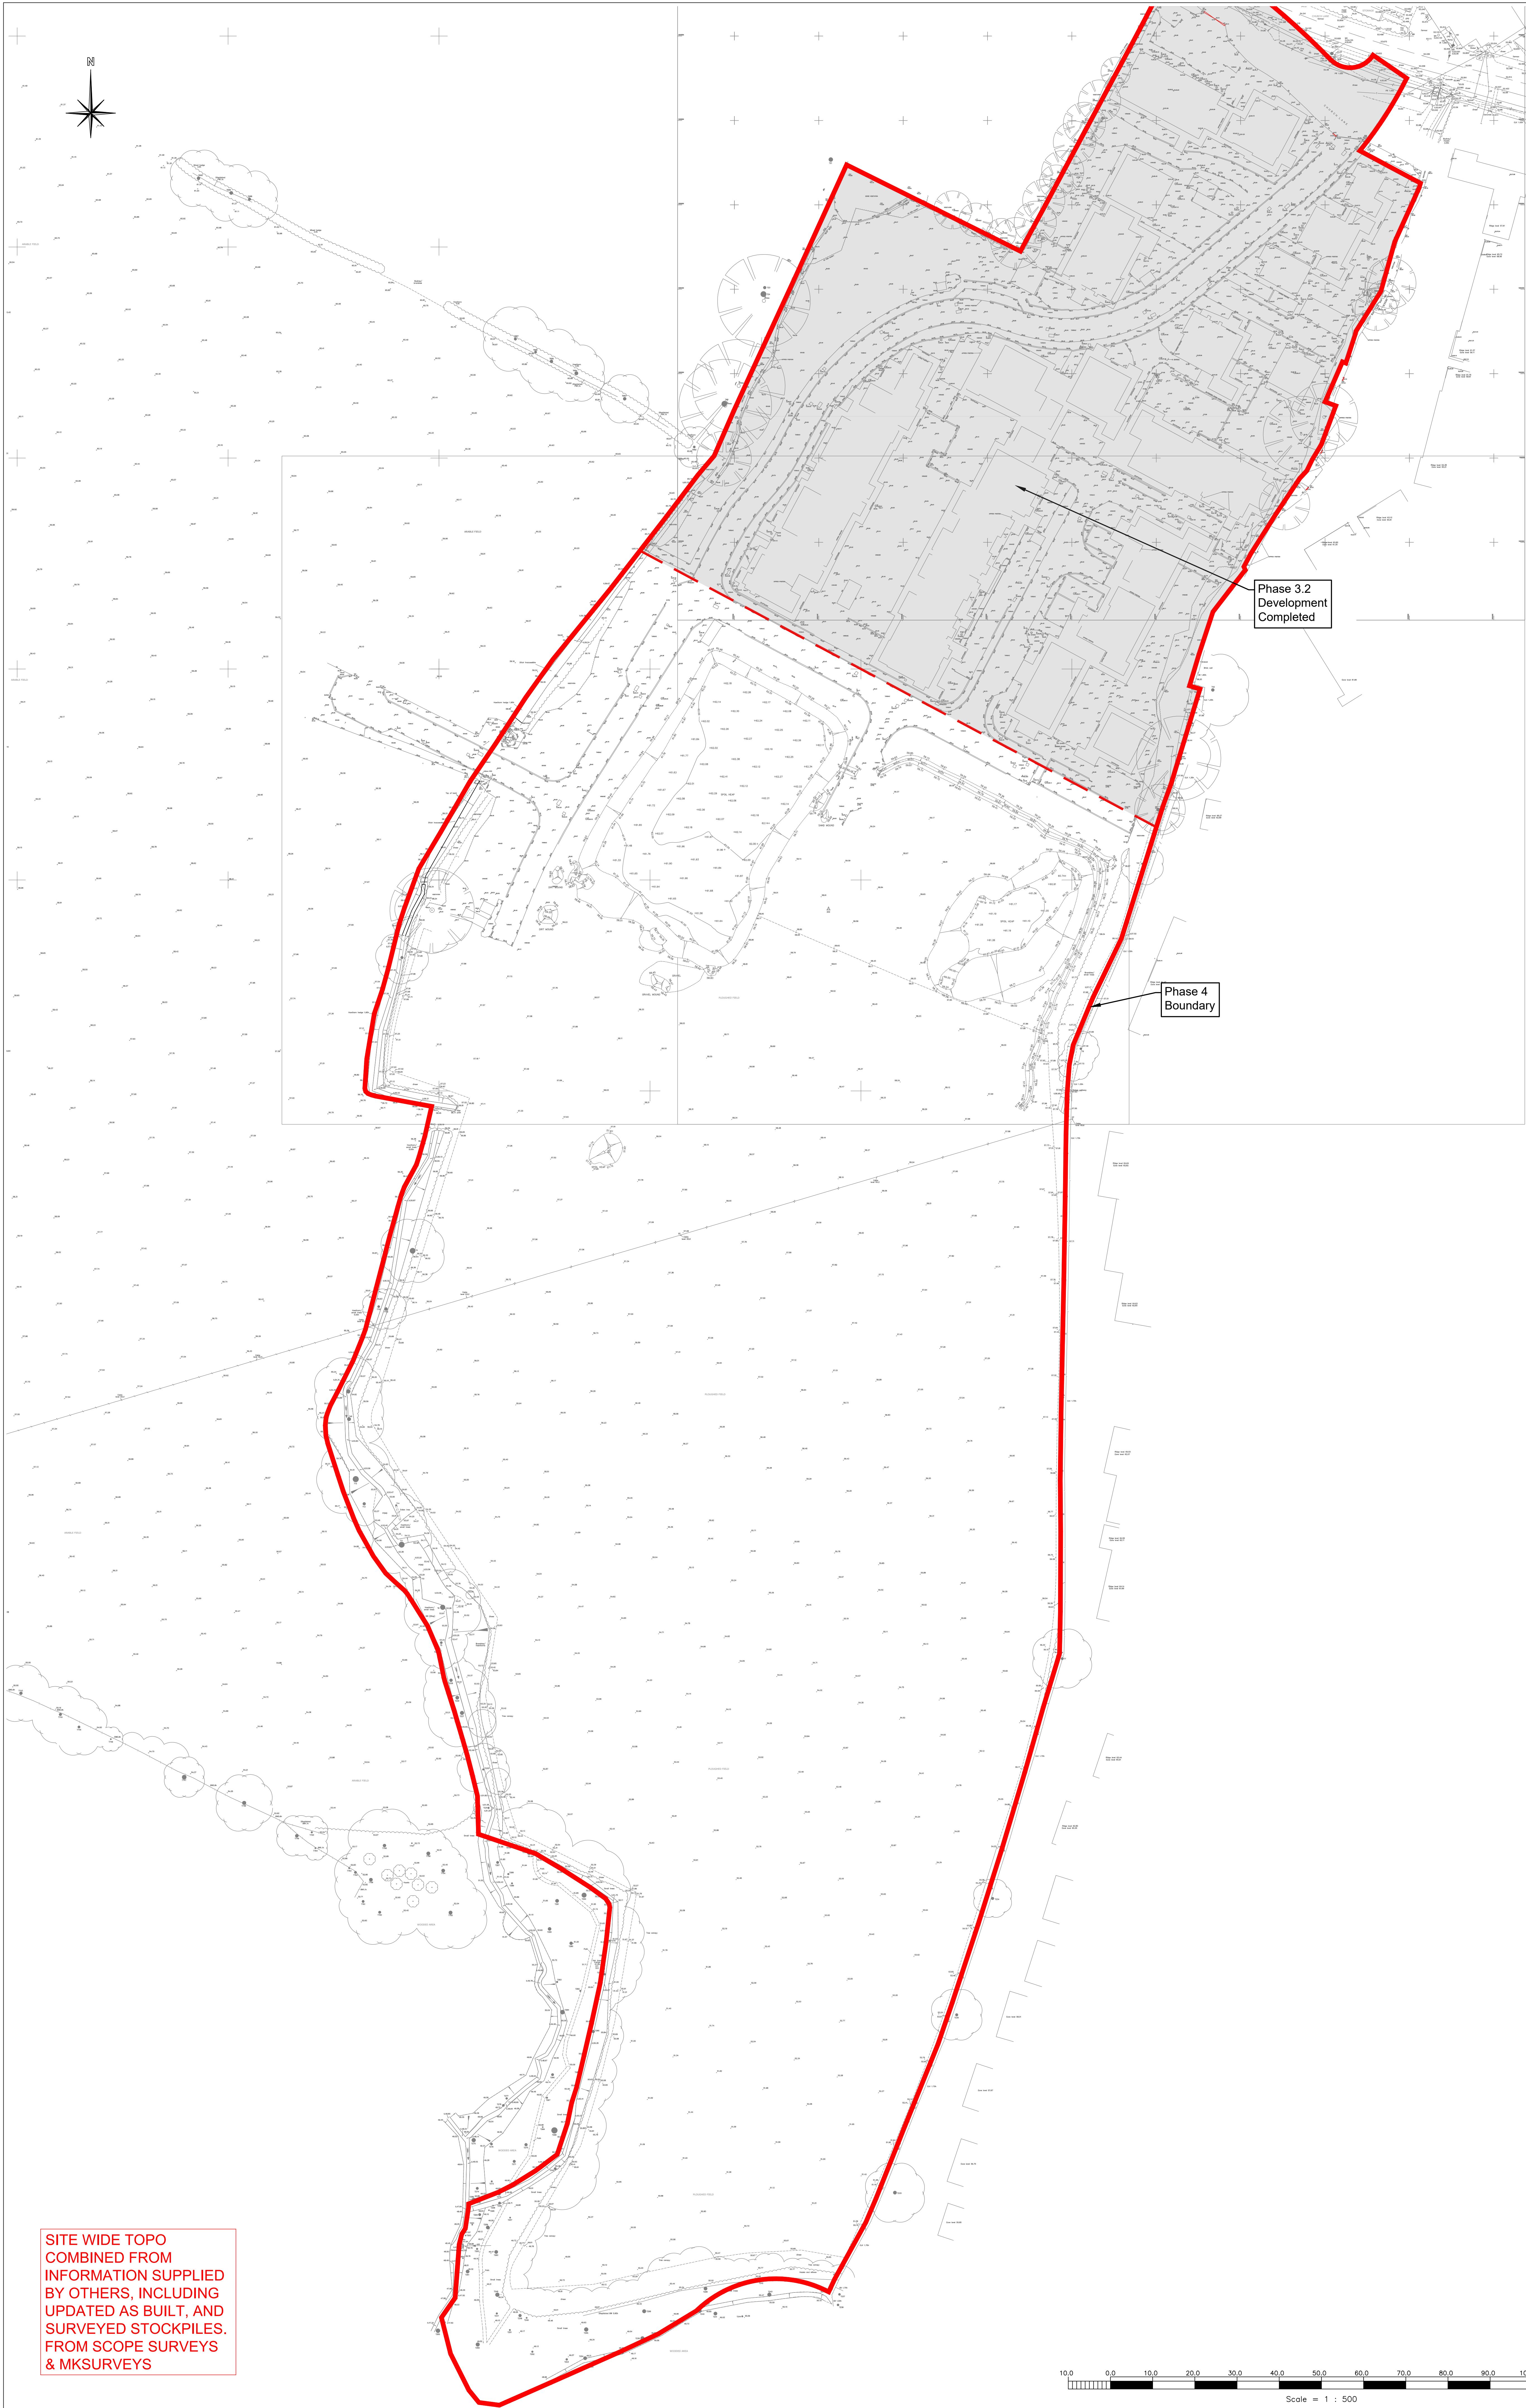

SITE WIDE TOPO
COMBINED FROM
INFORMATION SUPPLIED
BY OTHERS, INCLUDING
UPDATED AS BUILT, AND
SURVEYED STOCKPILES.
FROM SCOPE SURVEYS
& MKSURVEYS

GENERAL NOTES

- 1.1. THIS DRAWING IS COPYRIGHT AND SHOULD NOT BE REPRODUCED IN WHOLE OR PART WITHOUT THE WRITTEN CONSENT OF PPCE GROUP LTD.
- 1.2. ALL DIMENSIONS TO BE CHECKED ON SITE AND CO-ORDINATE WITH RELEVANT ARCHITECT'S DRAWINGS. ANY DISCREPANCIES TO BE REPORTED TO THE ENGINEER PRIOR TO CONSTRUCTION.
- 1.3. ALL DIMENSIONS IN METRES UNLESS NOTED OTHERWISE.
- 1.4. ALL LEVELS IN METRES.
- 1.5. SIZES HEREON SHALL NOT BE MODIFIED WITHOUT THE WRITTEN APPROVAL OF THE ENGINEER.
- 1.6. THIS DRAWING IS TO BE READ IN CONJUNCTION WITH ALL RELEVANT ENGINEERS DRAWINGS & SPECIFICATIONS.

LEVELS RELATED TO:
ORDNANCE SURVEY LEVEL DATUM OSGM15GB
VIA GNSS SMARTNET AT A SINGLE CONTROL STN

GRID RELATED TO:
OSGB36(15) NATIONAL GRID VIA GNSS SMARTNET
AT A SINGLE CONTROL STN ORIENTATED TO
GRID NORTH WITH A SCALE FACTOR OF 1.000

P2	MINOR AMENDMENTS					
	AM	26/06/24	DB	26/06/24	DB	26/06/24
P1	INITIAL ISSUE					
	JH	18/06/24	DB	18/06/24	DB	18/06/24
REVISION NOTE/COMMENT						
REV	DRAWN BY	DATE	CHK BY	DATE	APP BY	DATE



Satellite house, 2 Nexus Park
Lyons Avenue, Ash Vale
Guildford
GU12 5GE
United Kingdom
T: +44 01276 700 400
E: info@patrickparsons.co.uk
W: www.patrickparsons.co.uk

Client
Berkeley Homes (Southern) Ltd

Project
Southwater, Phase 4 & 5

Drawing
PHASE 4
TOPOGRAPHICAL SURVEY

Drawn
JH
Date
JUNE 2024
Patrick Parsons Project No.
Scale @ A0
1:500

Status Description
INFORMATION
Drawing No. (insert original volume/revision number)
SOU-PPC-00-XX-DR-C-0122
Revision
P2

