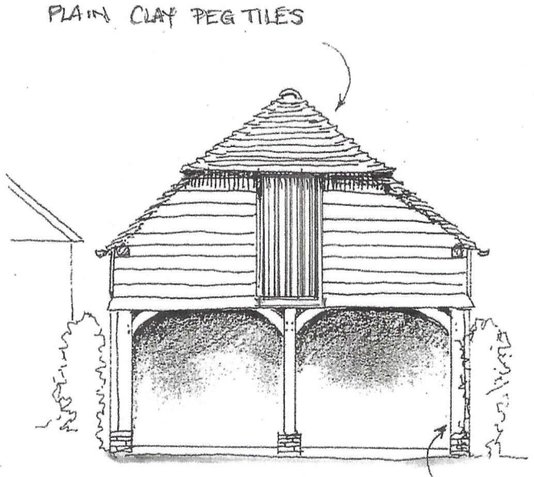

NORTH ELEVATION

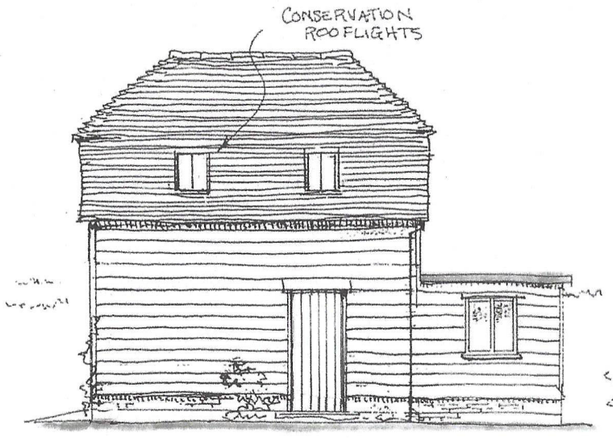

WEST ELEVATION

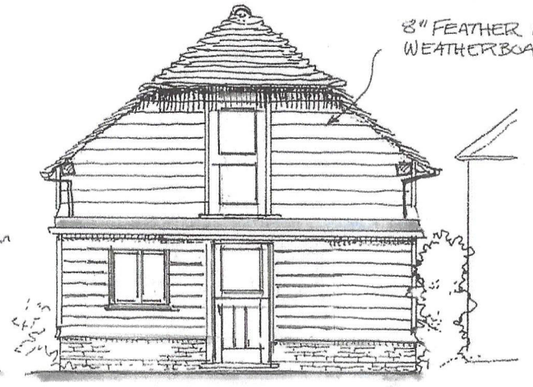

SOUTH ELEVATION

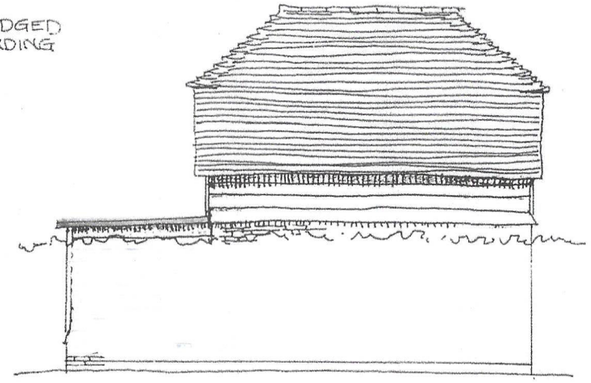

EAST ELEVATION

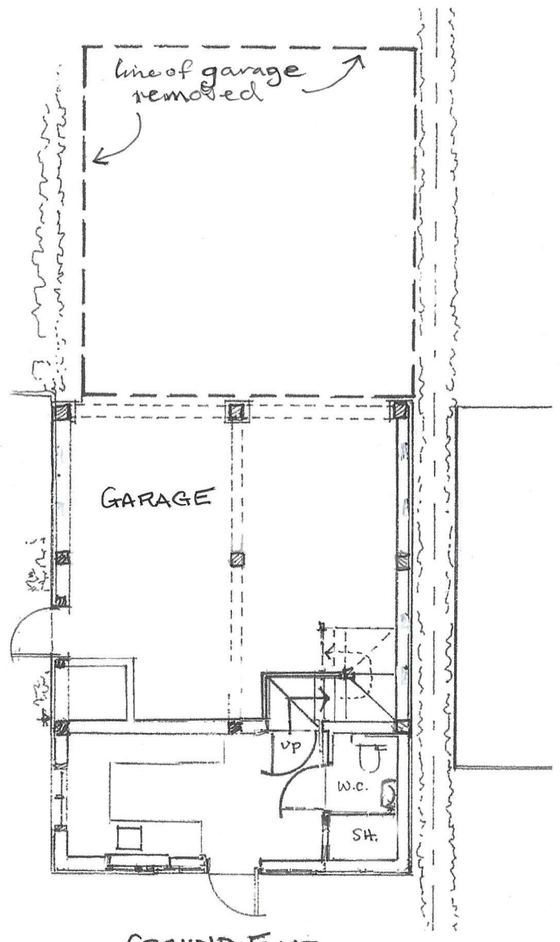

GROUND FLOOR PLAN 1:100

FIRST FLOOR PLAN 1:100



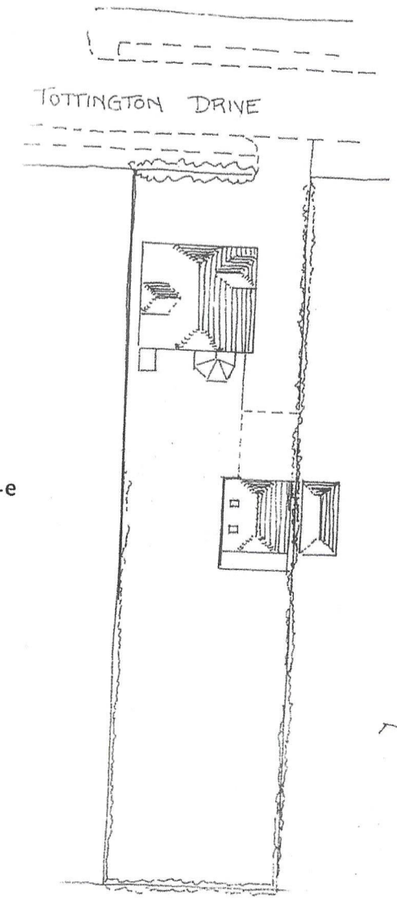

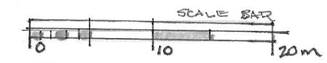

BLOCK PLAN 1:500

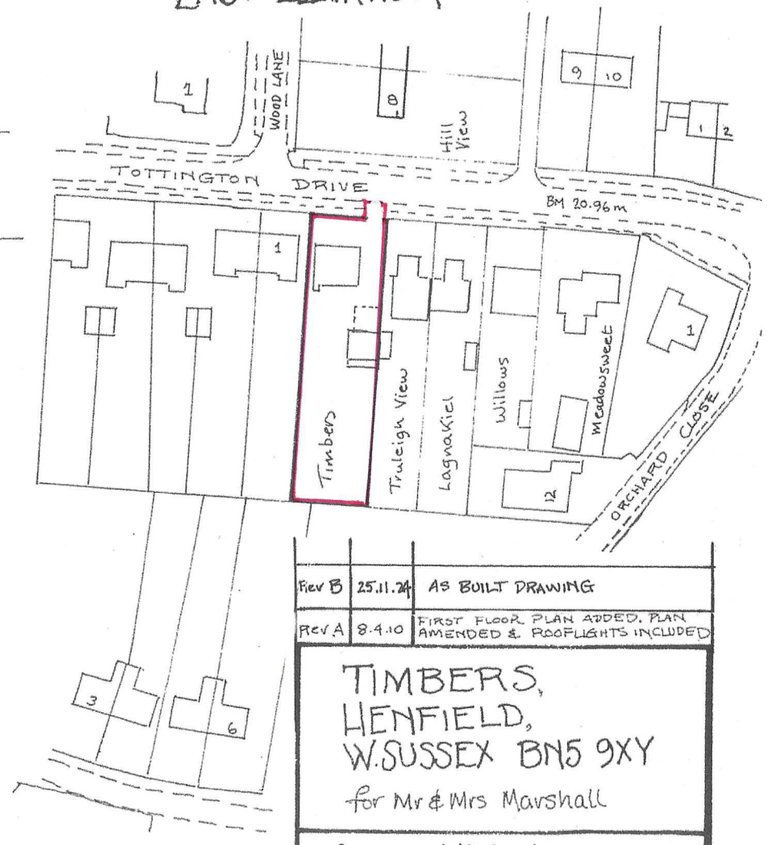

LOCATION 1:1250
LICENCE No. 078263

Rev B	25.11.24	AS BUILT DRAWING
Rev A	8.4.10	FIRST FLOOR PLAN ADDED. PLAN AMENDED & ROOFLIGHTS INCLUDED

TIMBERS, HENFIELD, W.SUSSEX BN5 9XY

for Mr & Mrs Marshall

GARAGE, ANCILLARY ACCOMMODATION & SECURE STORAGE

PLANS & ELEVATIONS	1:100
BLOCK PLAN	1:500
LOCATION	1:1250

DWG No. 0907 01 | DATE: JULY 2009 B