


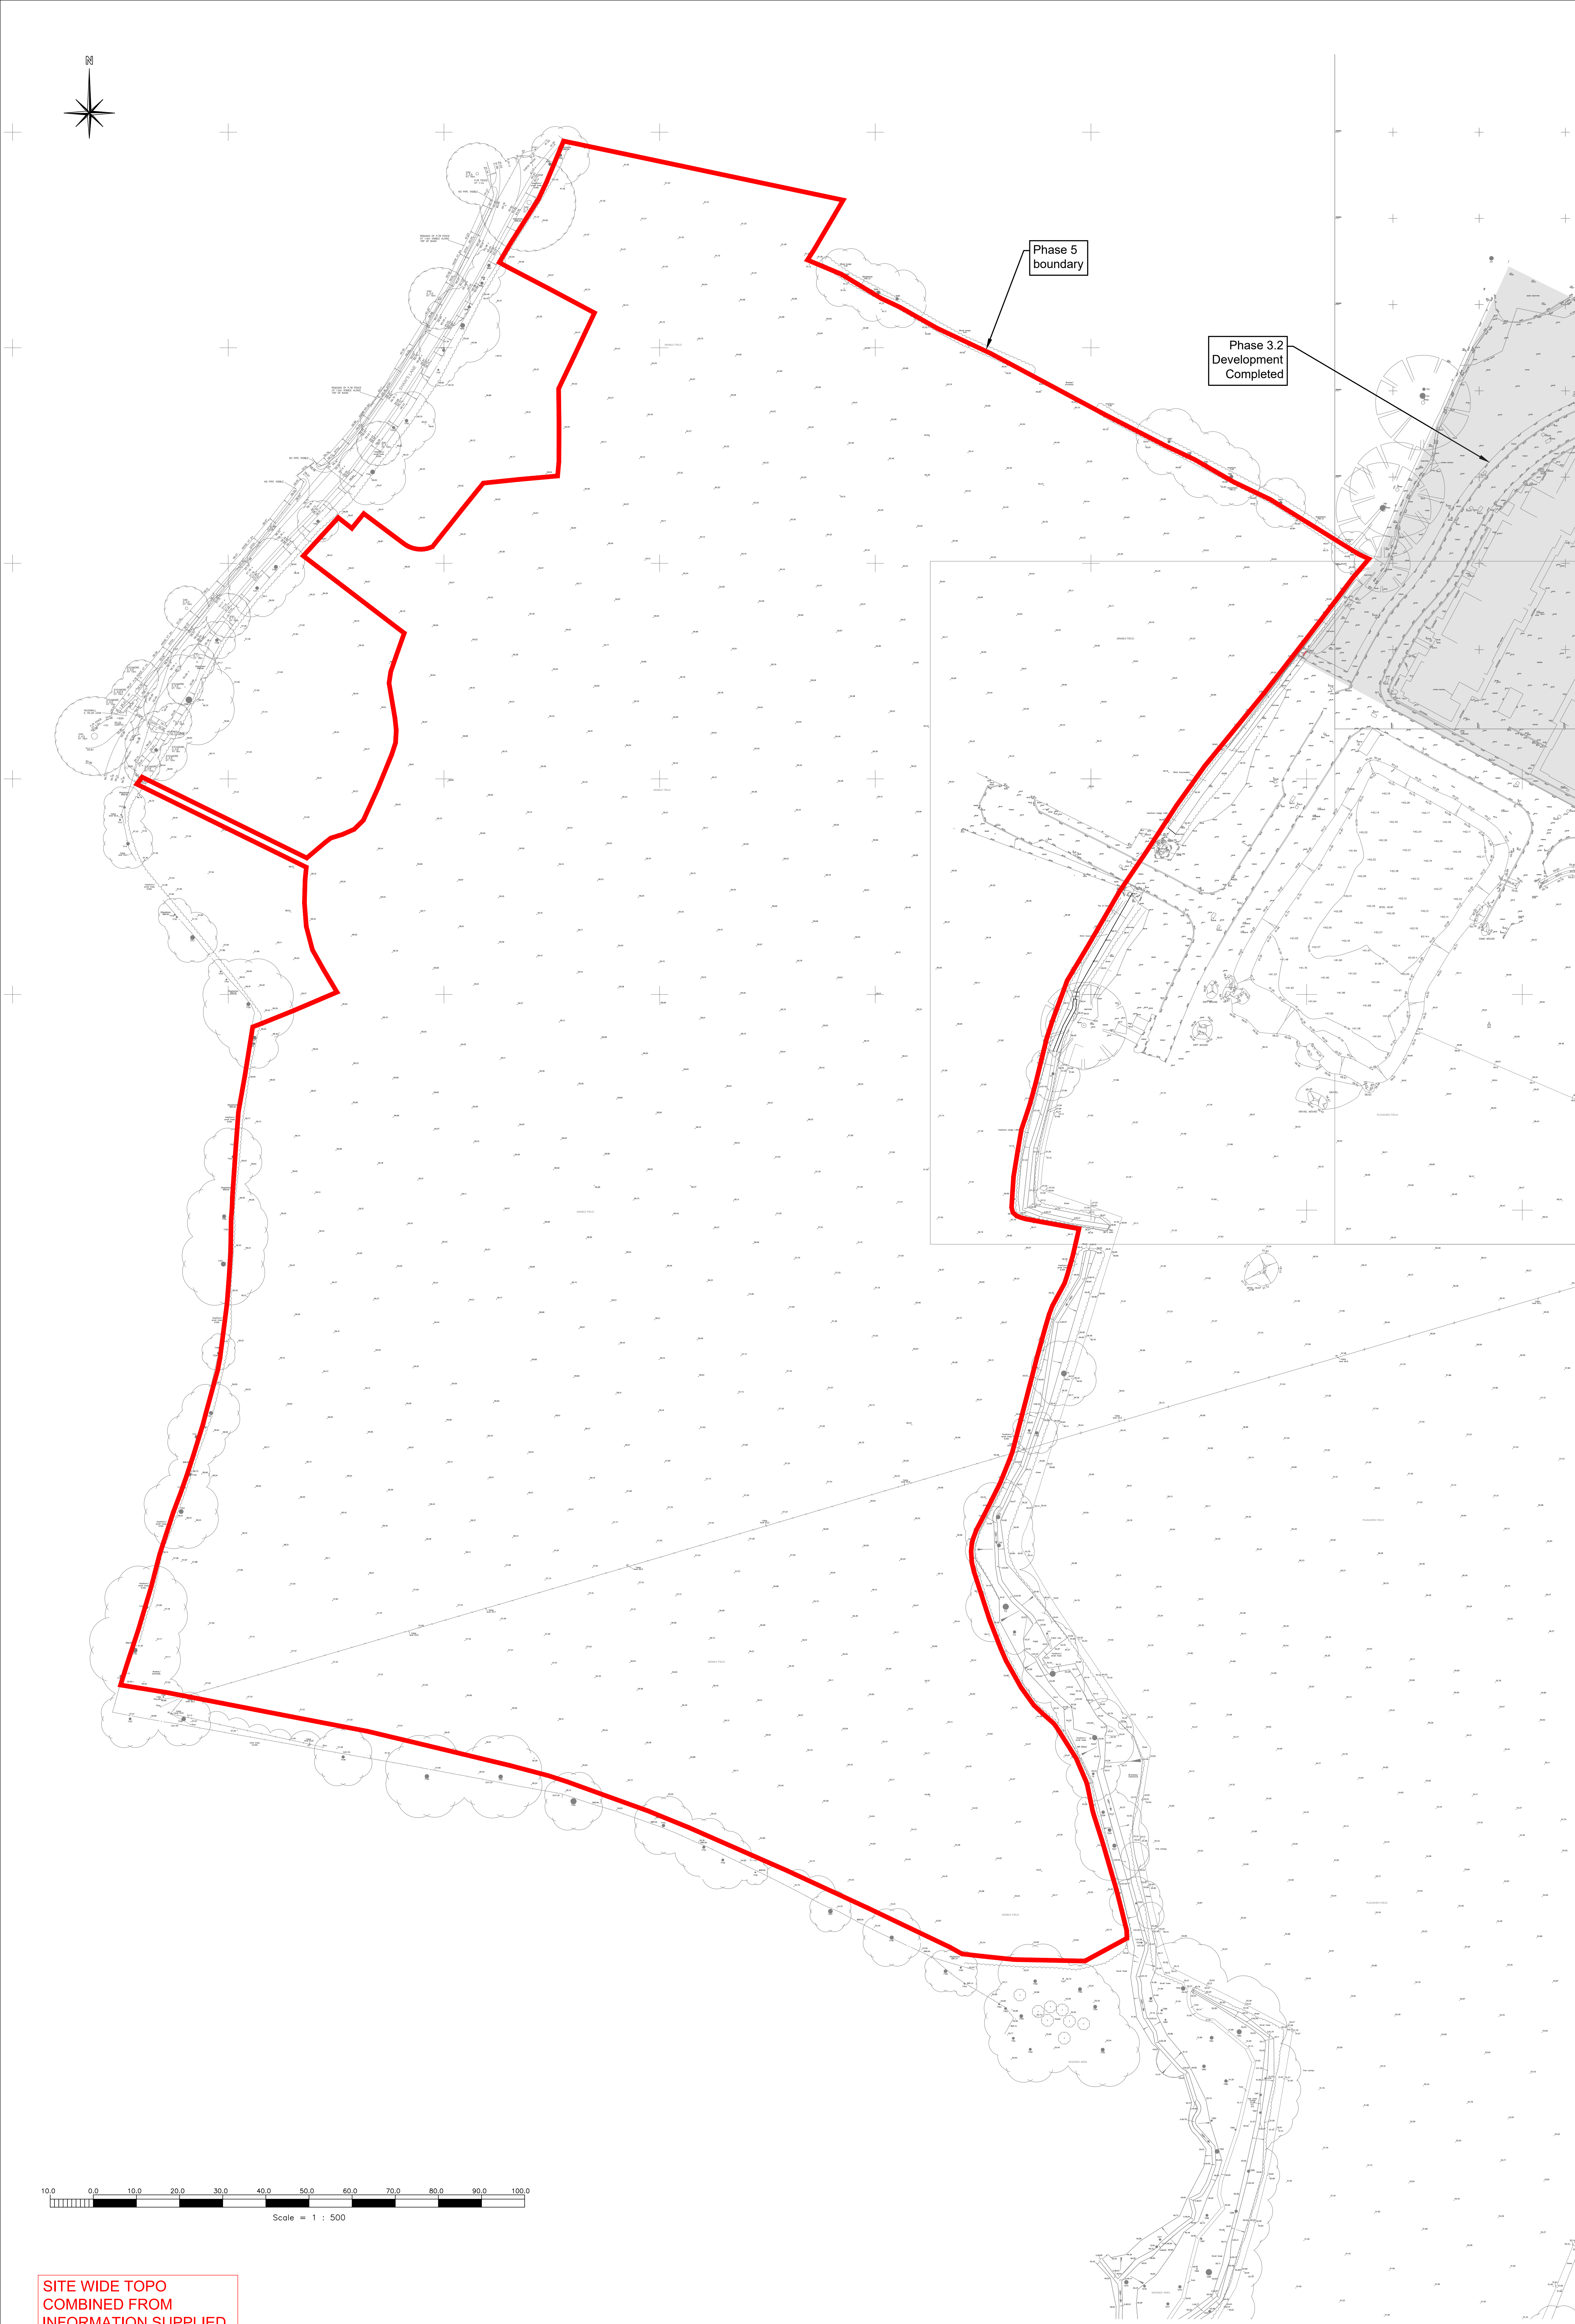

SITE WIDE TOPO
COMBINED FROM
INFORMATION SUPPLIED
BY OTHERS, INCLUDING
UPDATED AS BUILT, AND
SURVEYED STOCKPILES.
FROM SCOPE SURVEYS
& MKSURVEYS

GENERAL NOTES

1.1. THIS DRAWING IS COPYRIGHT AND SHOULD NOT BE REPRODUCED IN WHOLE OR PART WITHOUT THE WRITTEN CONSENT OF PPCE GROUP LTD.

1.2. ALL DIMENSIONS TO BE CHECKED ON SITE AND CO-ORDINATE WITH RELEVANT ARCHITECT'S DRAWINGS. ANY DISCREPANCIES TO BE REPORTED TO THE ENGINEER PRIOR TO CONSTRUCTION.

1.3. ALL DIMENSIONS IN METRES UNLESS NOTED OTHERWISE.

1.4. ALL LEVELS IN METRES.

1.5. SIZES HEREON SHALL NOT BE MODIFIED WITHOUT THE WRITTEN APPROVAL OF THE ENGINEER.

1.6. THIS DRAWING IS TO BE READ IN CONJUNCTION WITH ALL RELEVANT ENGINEERS DRAWINGS & SPECIFICATIONS.

LEVELS RELATED TO:
ORDNANCE SURVEY LEVEL DATUM OSGM15GB
VIA GNSS SMARTNET AT A SINGLE CONTROL STN

GRID RELATED TO:
OSGB36(15) NATIONAL GRID VIA GNSS SMARTNET
AT A SINGLE CONTROL STN ORIENTATED TO
GRID NORTH WITH A SCALE FACTOR OF 1.000

P2	MINOR AMENDMENTS				
AM	26/06/24	DB	26/06/24	DB	26/06/24
P1	INITIAL ISSUE				
JH	18/06/24	DB	18/06/24	DB	18/06/24
REVISION NOTE/COMMENT					
REV	DRW BY	DATE	CHK BY	DATE	APP BY

Satellite house, 2 Nevva Park
Lyons Avenue, Ash Vale
Guildford
GU12 5GE
United Kingdom
T +44 01276 700 400
E info@patrickparsons.co.uk
W www.patrickparsons.co.uk

Client

Berkeley Homes (Southern) Ltd

Project

Southwater, Phase 4 & 5

Drawing

PHASE 5
TOPOGRAPHICAL SURVEY

Drawn	Date
JH	JUNE 2024
Patrick Parsons Project No	Scale @ A0
12345	1:500

Status Description	S2
INFORMATION	
Drawing No. (used on site and in reports)	Revision
SOU-PPC-00-XX-DR-C-0121	P2