
FOR PLANNING PURPOSES ONLY

NOT FOR CONSTRUCTION

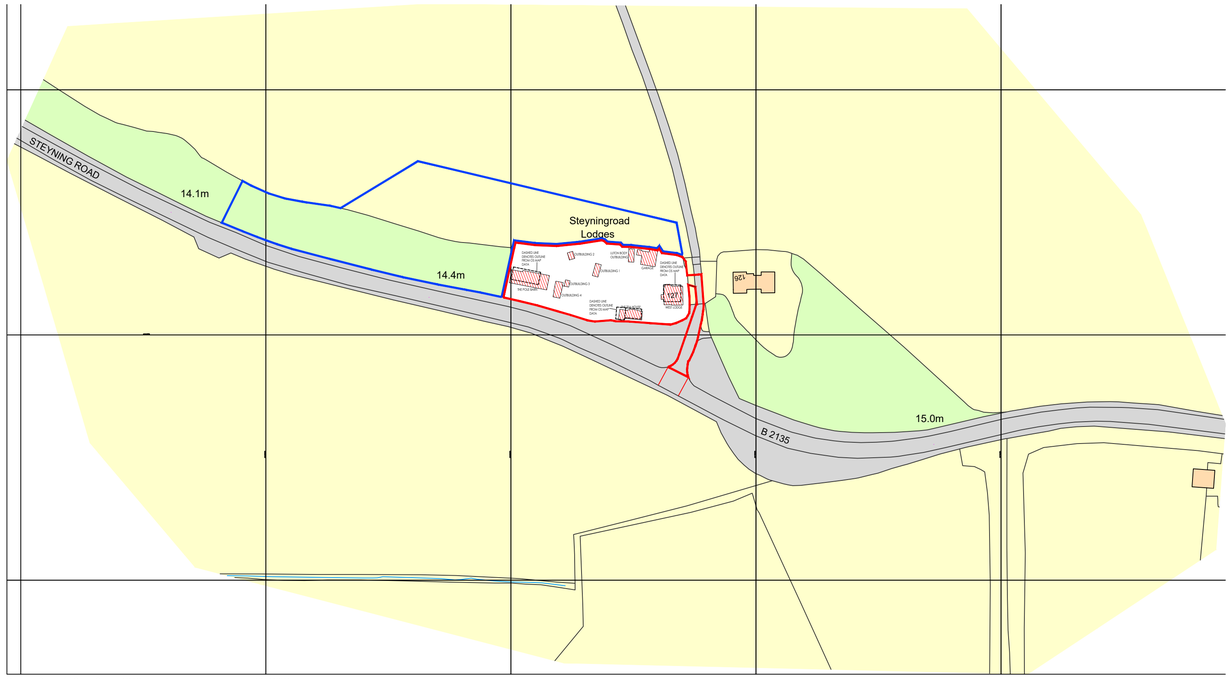

Ordnance Survey, (c) Crown Copyright 2024. All rights reserved. Licence number 100022432

SITE LOCATION PLAN - AS BUILT

SCALE @ 1:1250 ON AN A1 SHEET

0m 25m 50m 75m 100m 125m

VISUAL SCALE 1:1250 @ A1

REV.	DATE.	BY.	AMENDMENT.	CHK.
A	23.09.24	RH	Red line extents updated to include shared driveway	*

PLANNING

gould baxter

2 Lucastes Mews, Paddockhall Road,
Haywards Heath,
West Sussex, RH16 1HE
(01444) 452604
hh@gouldbaxter.co.uk
www.gouldbaxter.co.uk

NOTES.
DO NOT SCALE OFF THIS DRAWING UNLESS FOR PLANNING PURPOSES.

CHECK ALL DIMENSIONS ON SITE BEFORE ANY WORK IS COMMENCED.

ALL GOODS MATERIALS AND WORKMANSHIP MUST CONFORM WITH CURRENT BUILDING REGULATIONS, BRITISH STANDARDS AND CODES OF PRACTICE.

COPYRIGHT OF THIS DRAWING IS RETAINED BY GOULD PROPERTY CONSULTANTS LLP T/A GOULD BAXTER AND IT MUST NOT BE REPRODUCED WITHOUT WRITTEN CONSENT.

CLIENT.

Mr. & Mrs. J. Butcher

PROJECT.

West Lodge
Steyning Road
West Grinstead, West Sussex
RH13 8LR

DRAWING.

Site Location Plan As Built

DATE.	SCALE AT A1.	DRAWN BY.
23.08.2024	1:1250	RH
		CHECKED BY. MC

JOB NO.	DRAWING NO.	REV.
GH755	PL.15	A