Our Ref: 33184295 Your Ref: DC/24/0319

Wednesday, 24 April 2024

Guy Everest
Parkside Chart Way
Horsham
WSX
RH12 1RL

Dear Guy Everest

**Indigo Pipelines Ltd - Asset Network Plans**

In response to your enquiry regarding the location of network and equipment at the requested location, copies of our Record Plans are enclosed.

The plans show the positions and normal depths for the buried Indigo Pipelines Ltd Gas Plant. When they were installed. It must be stressed, however, that alterations to road alignments, surface levels and buildings may have been made subsequent to the records being taken. If you find buried Gas Plant that are not marked or are incorrectly marked, then you are required to contact us as soon as possible to give us the opportunity to amend our records.

Please note that the plans supplied are based on the location/map information supplied by yourselves and, therefore, YOU MUST SATISFY YOURSELF THAT OUR PLANS SUPPLIED ADEQUATELY COVER THE AREA THAT YOU REQUIRE.

Please note that these records only show Gas plant owned by Indigo Pipelines Ltd.
There may be other privately owned buried Gas Plant in the area, which is outside the control of Indigo Pipelines Ltd. You should also check with the Local Authority, Cadent; Southern Gas Networks, Scotland Gas networks & Wales & West Utilities before proceeding.

For more information, consult the Health & Safety Executive's booklet HS (G) 47 - obtainable from the HSE.

I would particularly draw your attention to the need to take trial holes to determine the exact position and depth of buried Gas Plant to avoid the risk of injury to staff or damage to the existing Plant.

General Advice:
---

a) Please ensure, where appropriate, that your CONTRACTORS have a copy of this letter and the enclosed plan(s).

b) Please note that the cost of any repairs or claims against Indigo Pipelines Ltd as a result of your works will be invoiced to you or your contractor.

c) Indigo Pipelines Ltd retains the right to its property, including disconnected cables and recoverable materials.

Should you require further information, please do not hesitate to contact me on the below telephone number.

Kind regards,

Indigo Pipelines Ltd

**Contact Us**


**Emergency and Supply issues**
In an emergency call 0800 111 999, 24 hours a day.

**Mapping Enquiries**
If you have an enquiry relating to this letter or the attached map plan, please contact us using the following information:

Telephone: 0345 070 7386.
Email: DBYDEnterpriseEnquiries@sse.com

**LinesearchbeforeUdig**
If you have an enquiry relating to the use of the LinesearchbeforeUdig website please contact LinesearchbeforeUdig using the following information:

Telephone: 0845 437 7365
Email: enquiries@linesearchbeforeudig.co.uk
Website: www.linesearchbeforeudig.co.uk

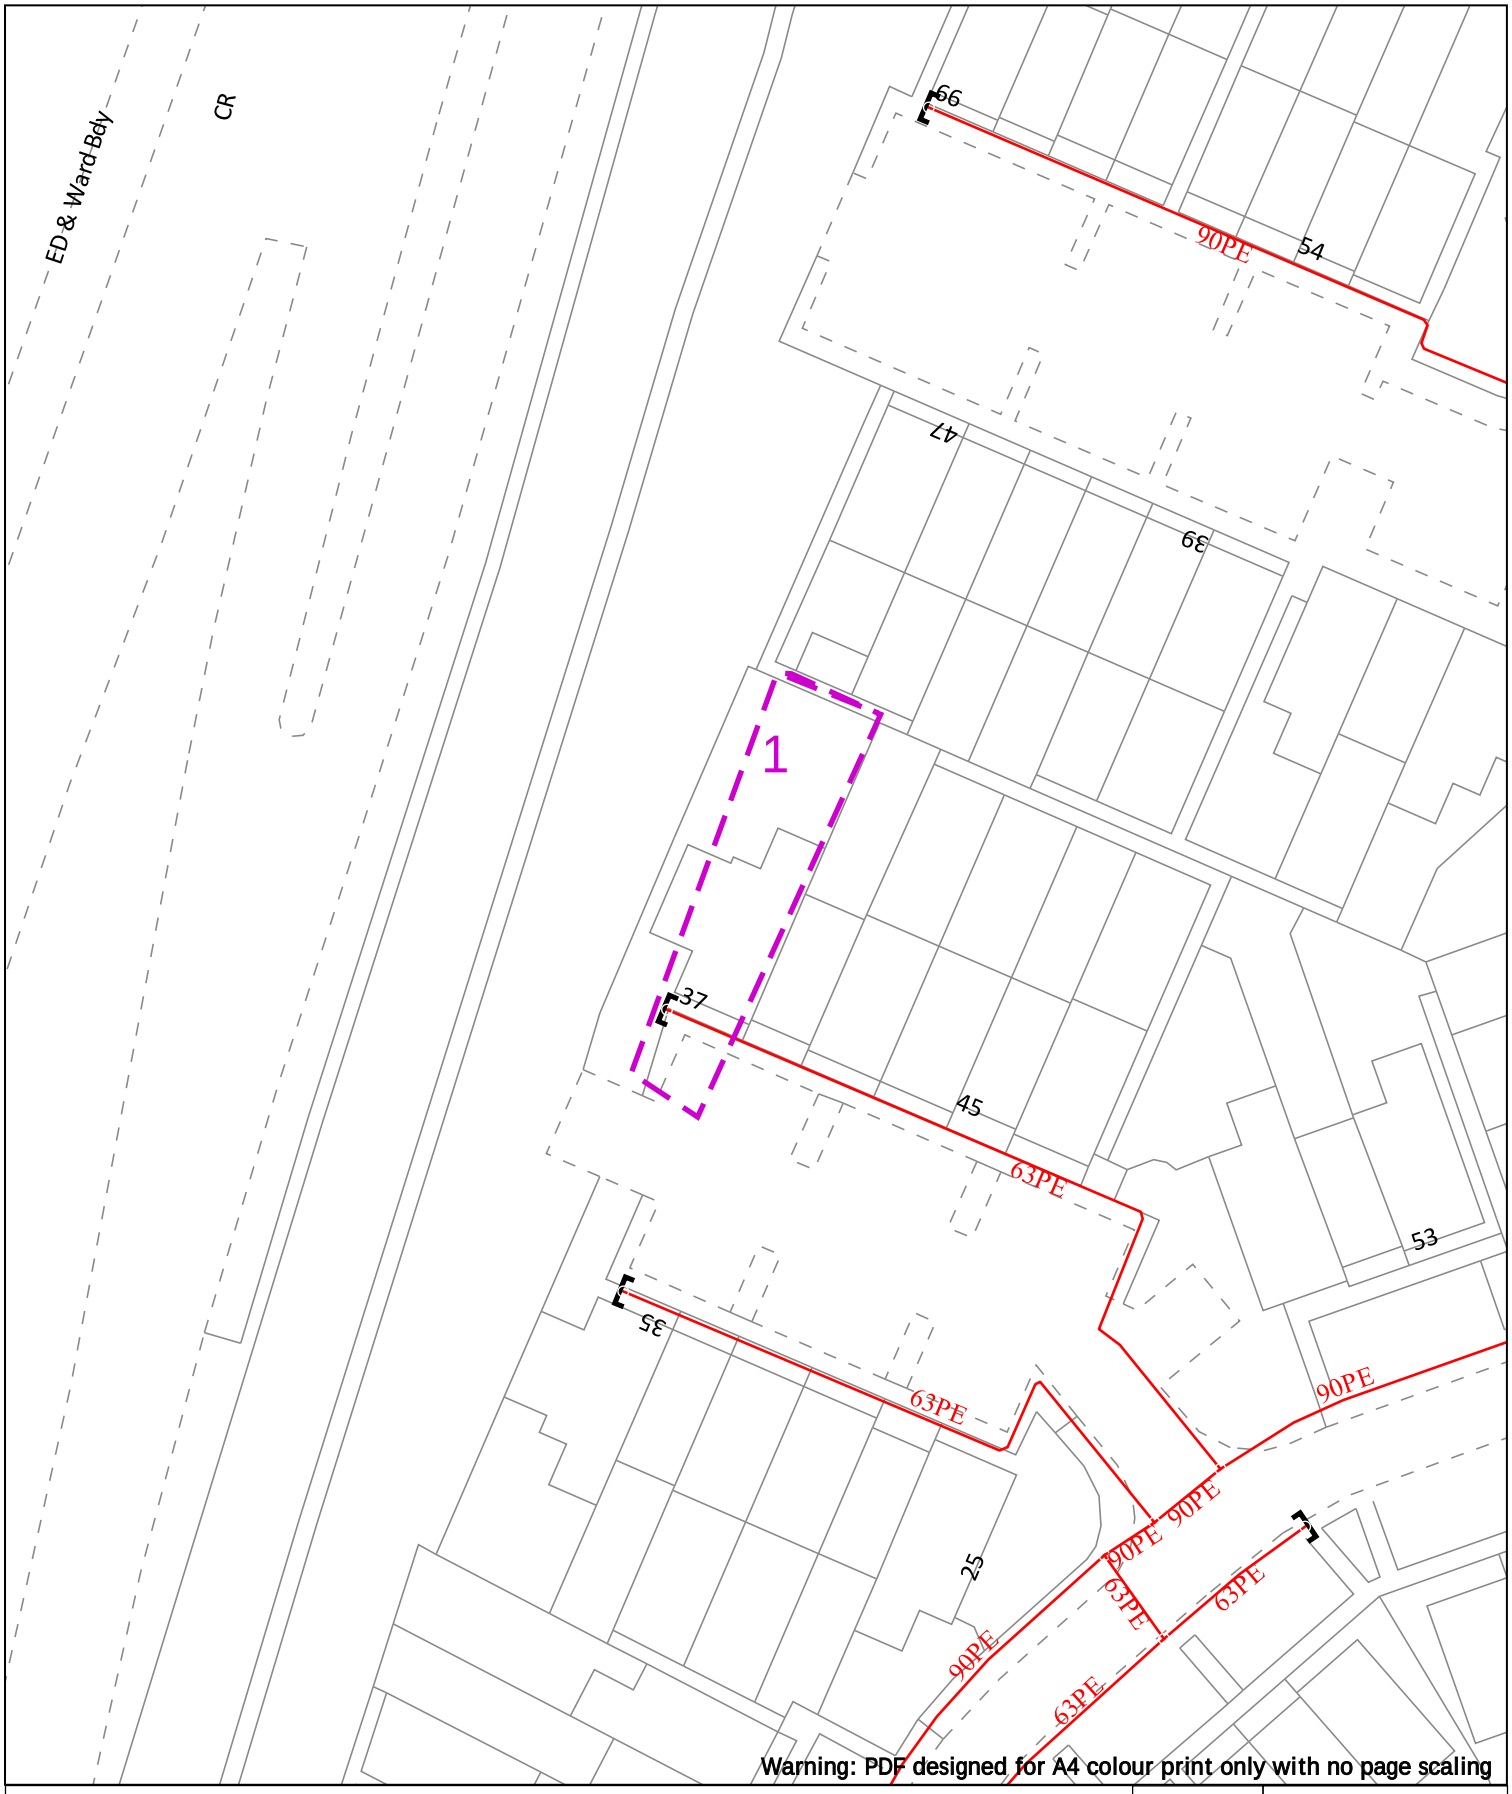


Warning: PDF designed for A4 colour print only with no page scaling

0 20m Dig Sites Area: Line:

Date Requested: 24/04/2024
Job Reference: 33184295
Site Location: 515301 130699
Requested by: Mr Guy Everest
Your Scheme/Reference: DC/24/0319

Scale: 1:500 (When plotted at A4)

LP Main
LP Service
MP Main
MP Service
IP Main

Valve Closed
Valve Open
CSEP
Pressure Reduction Station
End Closure

Reducer
Ducting
Gas Supply Point

**IMPORTANT NOTICES**

- This information is given as a guide only and its accuracy cannot be guaranteed
- The plan only shows pipes owned by SSE Utility Solutions Limited, Indigo Pipelines Limited
- Service pipes etc. may not be shown but their presence should be anticipated
- You must use safe digging practices in accordance with HS(G)47 to establish the actual position of mains, services and other apparatus before any mechanical excavation is used
- It is your responsibility to ensure this information is provided to all persons working near our plant
- If in doubt call the SSE Enterprise Dial Before You Dig team on 0345 070 7386.

**Please note**: If you have overlaps or misalignments between base maps that make it difficult to understand please contact DBYDEnterpriseEnquiries@sse.com or call 0345 070 7386

**Indigo Pipelines Ltd.**
Registered Office:
Loddon Reach,
Reading Road,
Arborfield,
Reading,
Bearkshire, RG2 9HU

Crown Copyright © - Reproduced by permission of Ordnance Survey on behalf of HMSO. and database right 2019. All rights reserved.
Ordnance Survey Licence number 100030994 (ESRI) and 100048660 (direct).Plans generated by DigSAFE Pro™ software provided by LinesearchbeforeUdig.