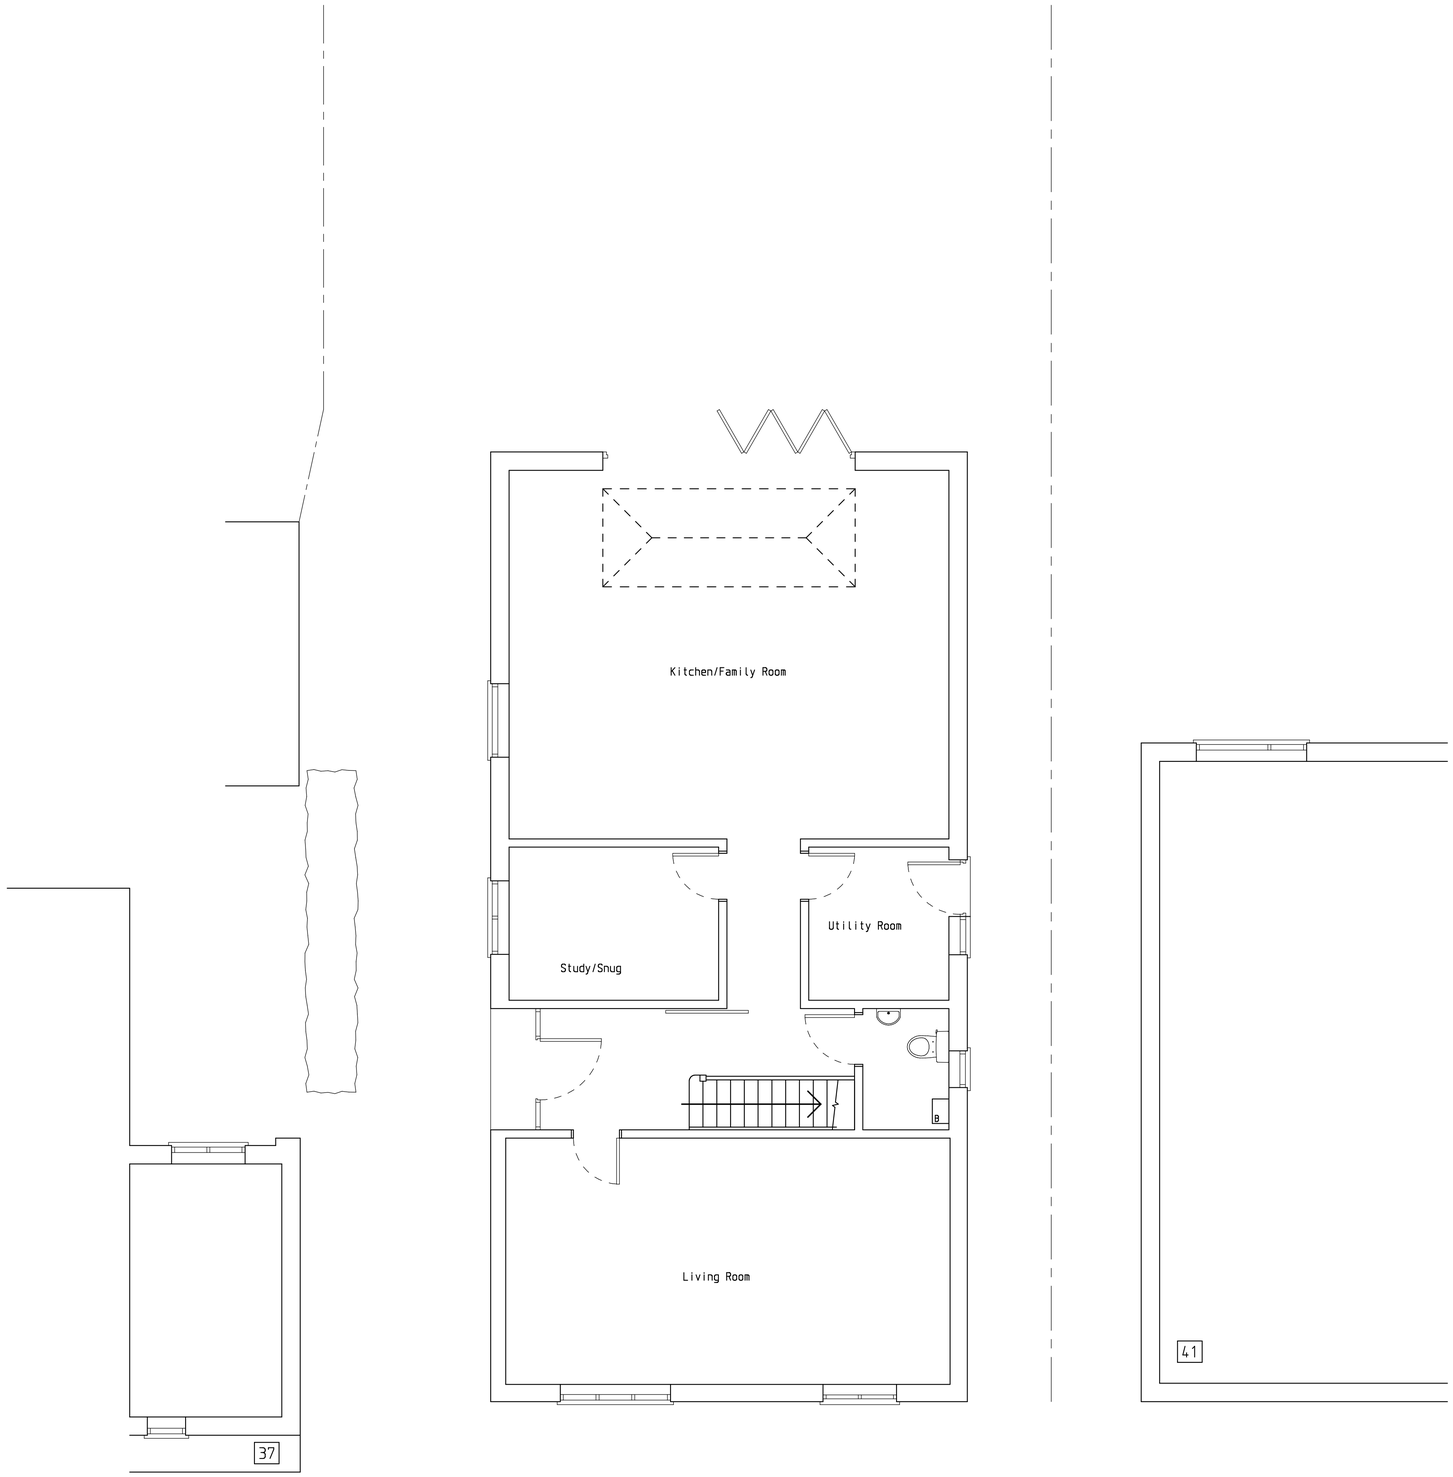

0 1 2 3

Scale Bar 1:50 at A1

Revisions			
No.	Date		By
B	18.04.24	Revised to as built.	PDR
A	20.05.19	Bay window removed.	PDR

Project

39, Warnham Road, Horsham

Drawing Title

Proposed Ground Floor Plan

Client

Mr & Mrs D. Grover

Scale 1:50

Date 01.10.18	Drawn PDR	Checked
Drawing No. 18/37/2		Rev. B

Peter Routley Associates

Chartered Building Surveyors
Architectural Designers

Gainsborough House
High Street
Cranleigh
GU6 8RL
(01483) 272338