

Front Elevation (North East)




Front Elevation and Street Scene (North West)



Side Elevation (South East)

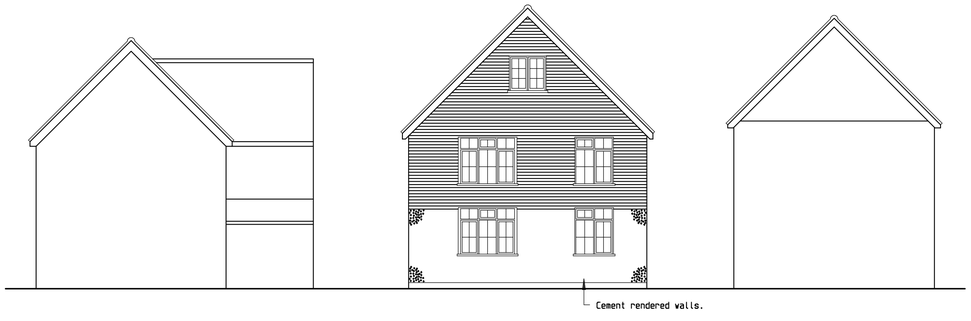


Side Elevation (South East)



Rear Elevation (South West)




Side Elevation (North West)



Side Elevation (North West)

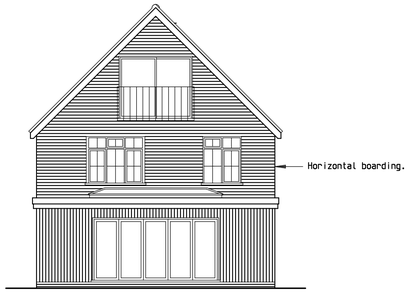


Side Elevation (South West)

## EXISTING ELEVATIONS

## PROPOSED ELEVATIONS

0 1m 2m 3m

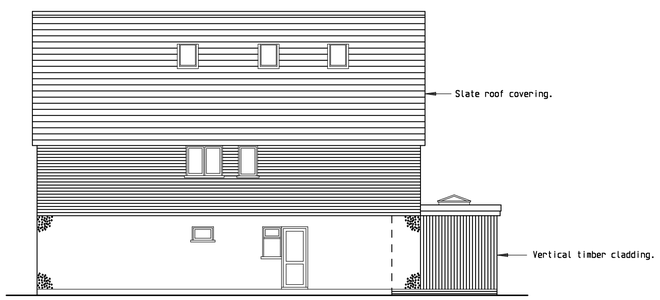Scale Bar 1:100 at A1

| Revisions | | | |
|---|---|---|---|
| No. | Date | | By |
| D | 18.04.24 | Revised to as built. | PDR |

Project

39, Warnham Road, Horsham

Drawing Title

Existing and Proposed Elevations

Client

Mr & Mrs D. Grover

Scale 1:100

| Date 18.08.18 | Drawn PDR | Checked |
|---|---|---|
| Drawing No. 18/37/4 | | Rev. D |

Peter Routley Associates

Chartered Building Surveyors
Architectural Designers

Gainsborough House
High Street
Cranleigh
GU6 8RL
(01483) 272338