

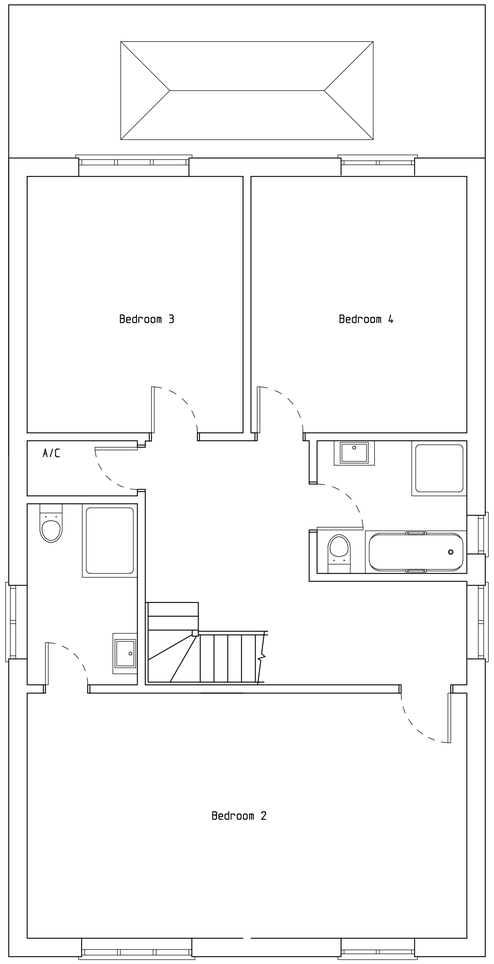

First Floor Plan

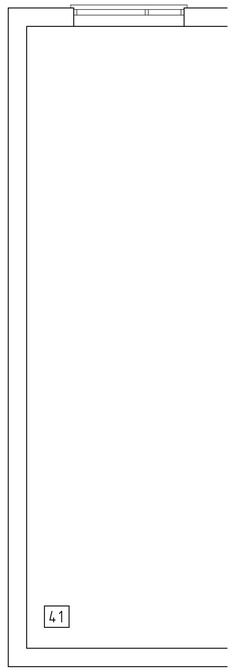

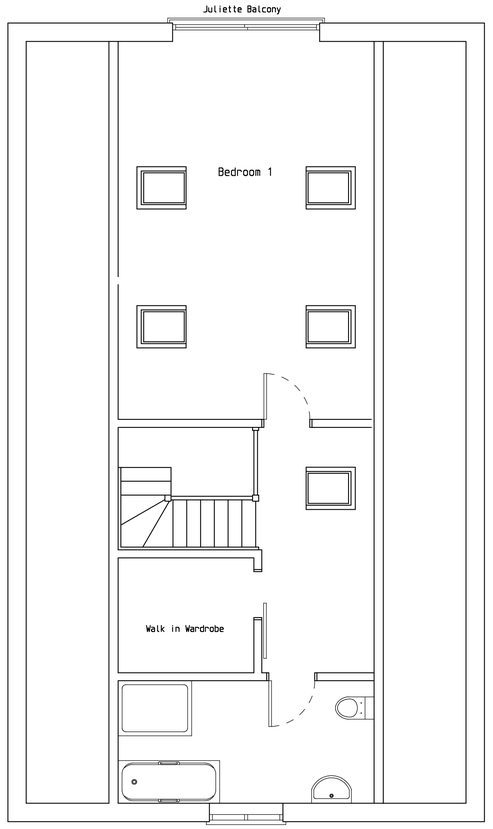

Second Floor Plan

0 1 2 3

Scale Bar 1:50 at A1

Revisions			
No.	Date		By
D	18.04.24	Revised to as built.	PDR

Project

39, Warnham Road, Horsham

Drawing Title

Proposed First and Second Floor Plans

Client

Mr & Mrs D. Grover

Scale 1:50

Date 01.10.18	Drawn PDR	Checked
Drawing No. 18/37/3		Rev. D

Peter Routley Associates

Chartered Building Surveyors
Architectural Designers

Gainsborough House
High Street
Cranleigh
GU6 8RL
(01483) 272338