
EXISTING AS BUILT GROUND/ROOF PLAN

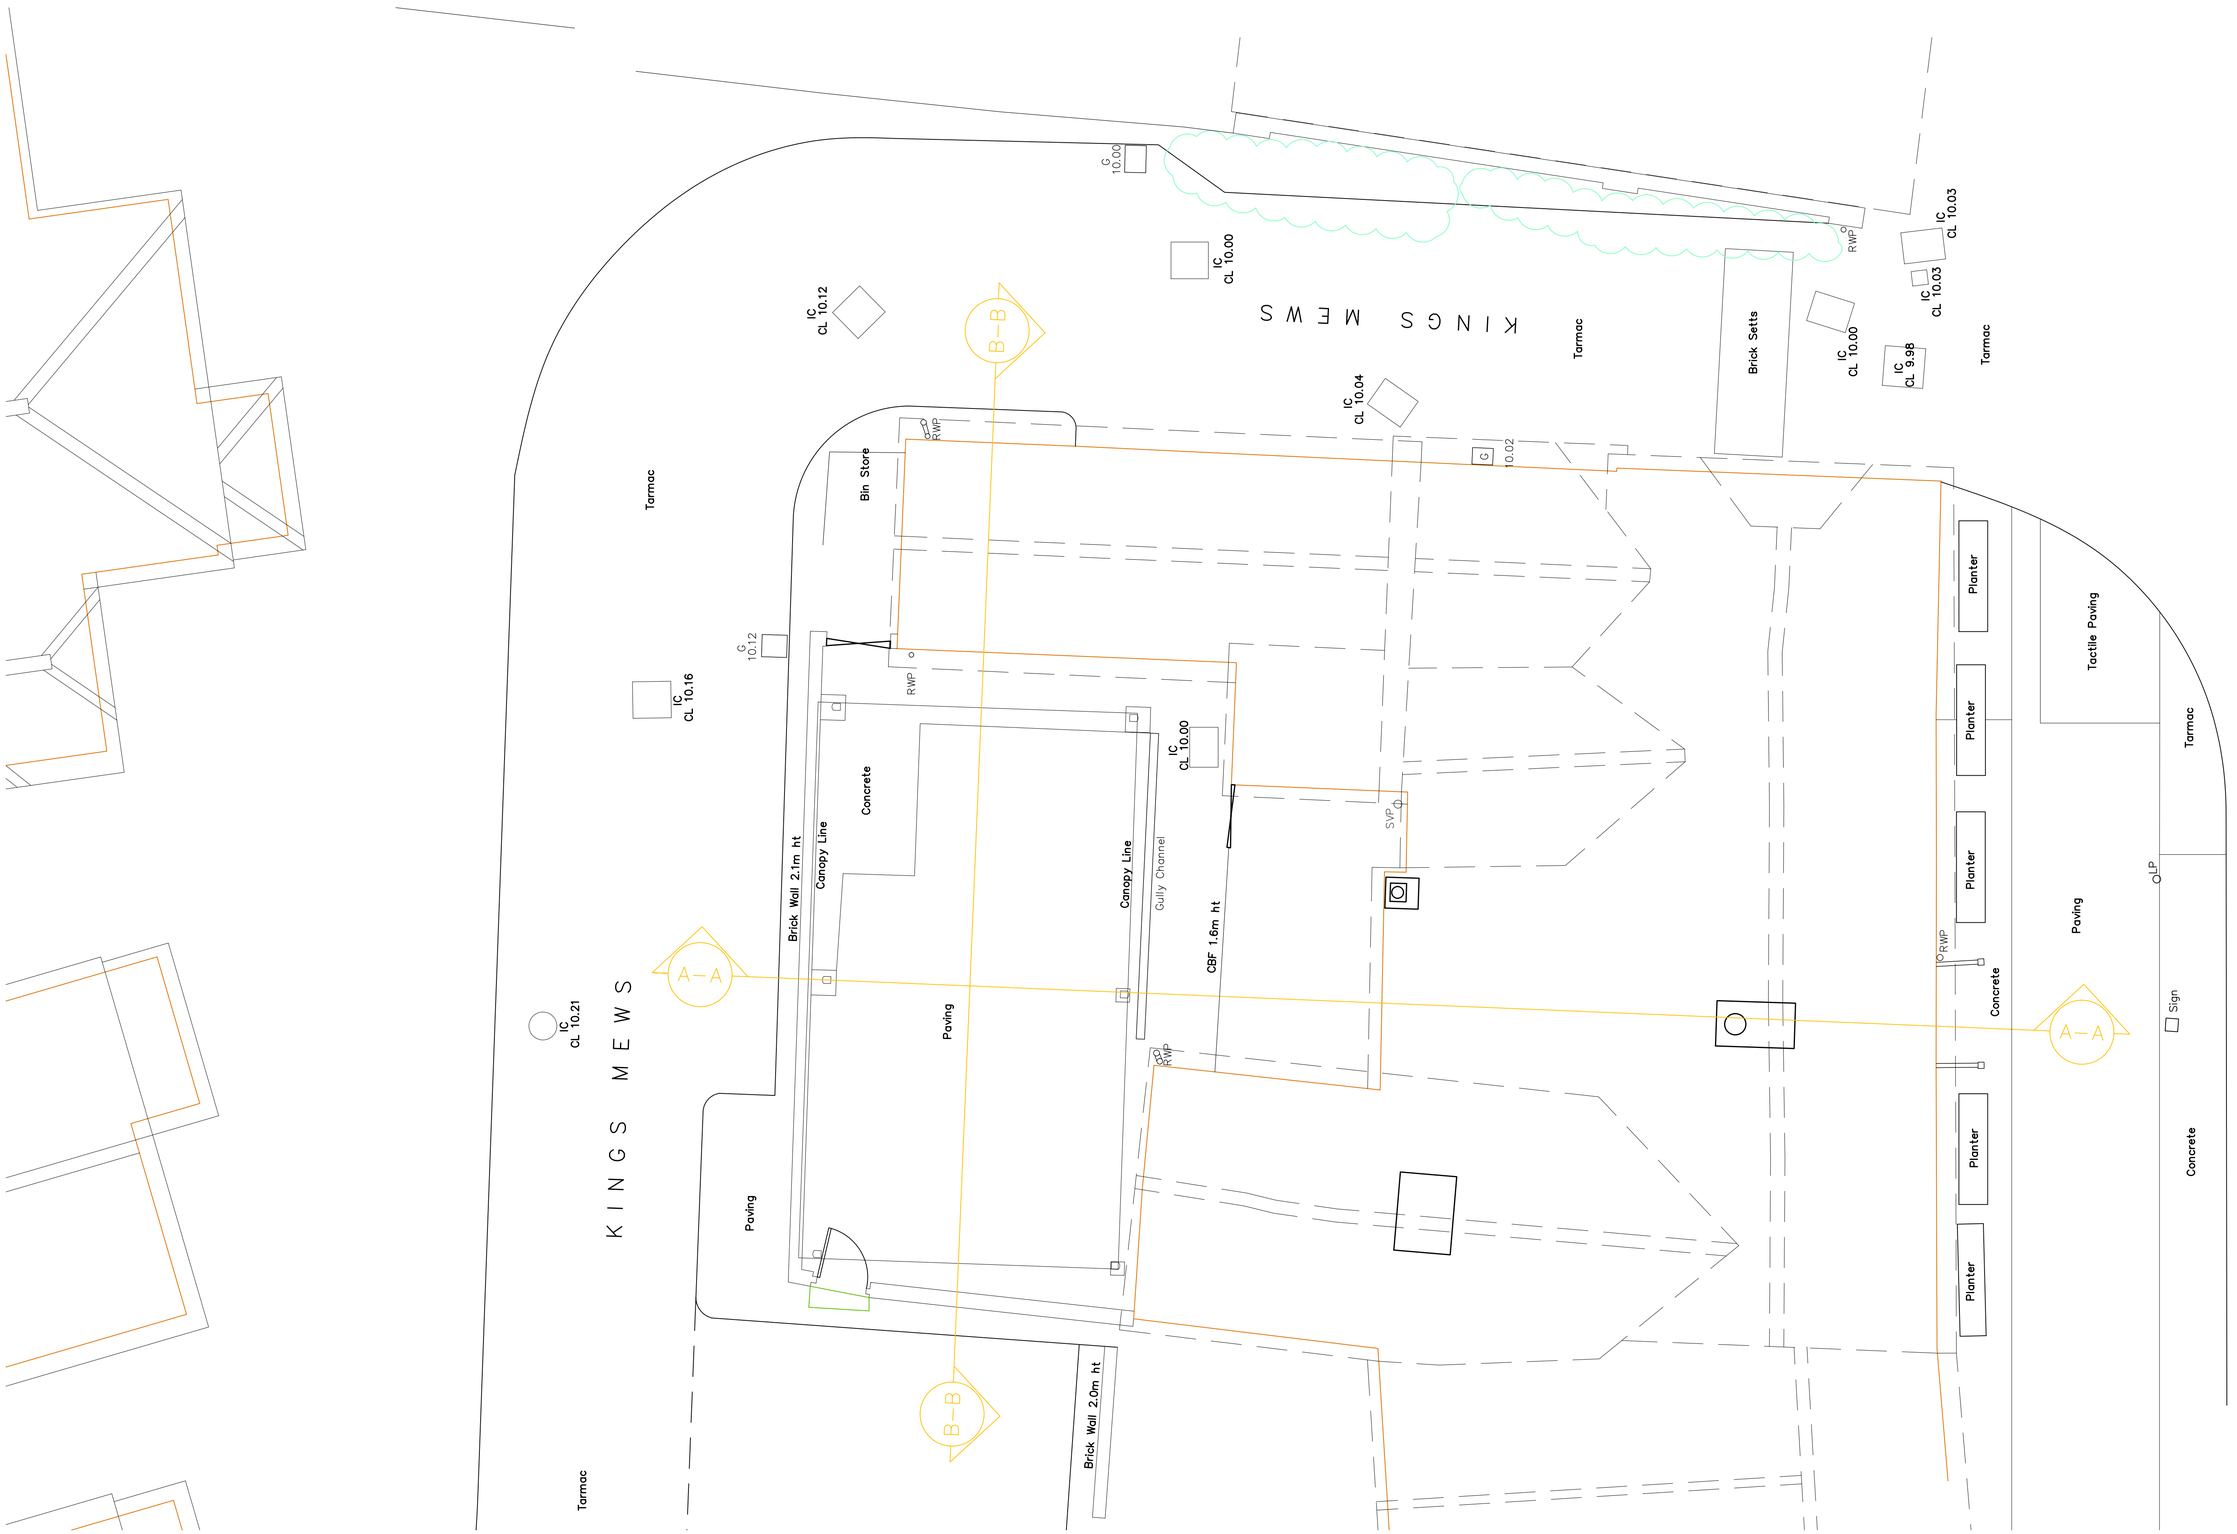

Note:
All levels and dimensions are to be checked on site.
This drawing is to be read in conjunction with all relevant consultants' requirements, drawings and specifications.
Any discrepancies between consultants' drawings to be reported to the Contract Administrator before any relevant work commences.

Copyright: 2024 Eye For Detail Architects ©

0 10m 50m 100m 1:1250
0 10m 20m 30m 40m 50m 1:500
1:100
0 1m 2m 3m 4m 5m 1:50

AS BUILT - PLANNING

Richard Grady
North & South Leisure Ltd t/a The Kings Arms Horsham
Kings Arms, 64 Bishopric, Horsham, W. Sussex
RH12 1QN

Proposed Retractable Roof For Year Round Use In Rear Garden
Existing As Built Ground/Roof Plan

Scale	Job	Dwg	Rev
1:50	4143	AD02	.

Eye For Detail ARCHITECTS
Oakwood House
North Heath Lane
Horsham
W. Sussex
RH12 5PJ
T: 01403 211868
Mob: 07540787365
info@efdarchitects.co.uk
info@efdarchitects.com
www.efdarchitects.co.uk
RIBA arb