




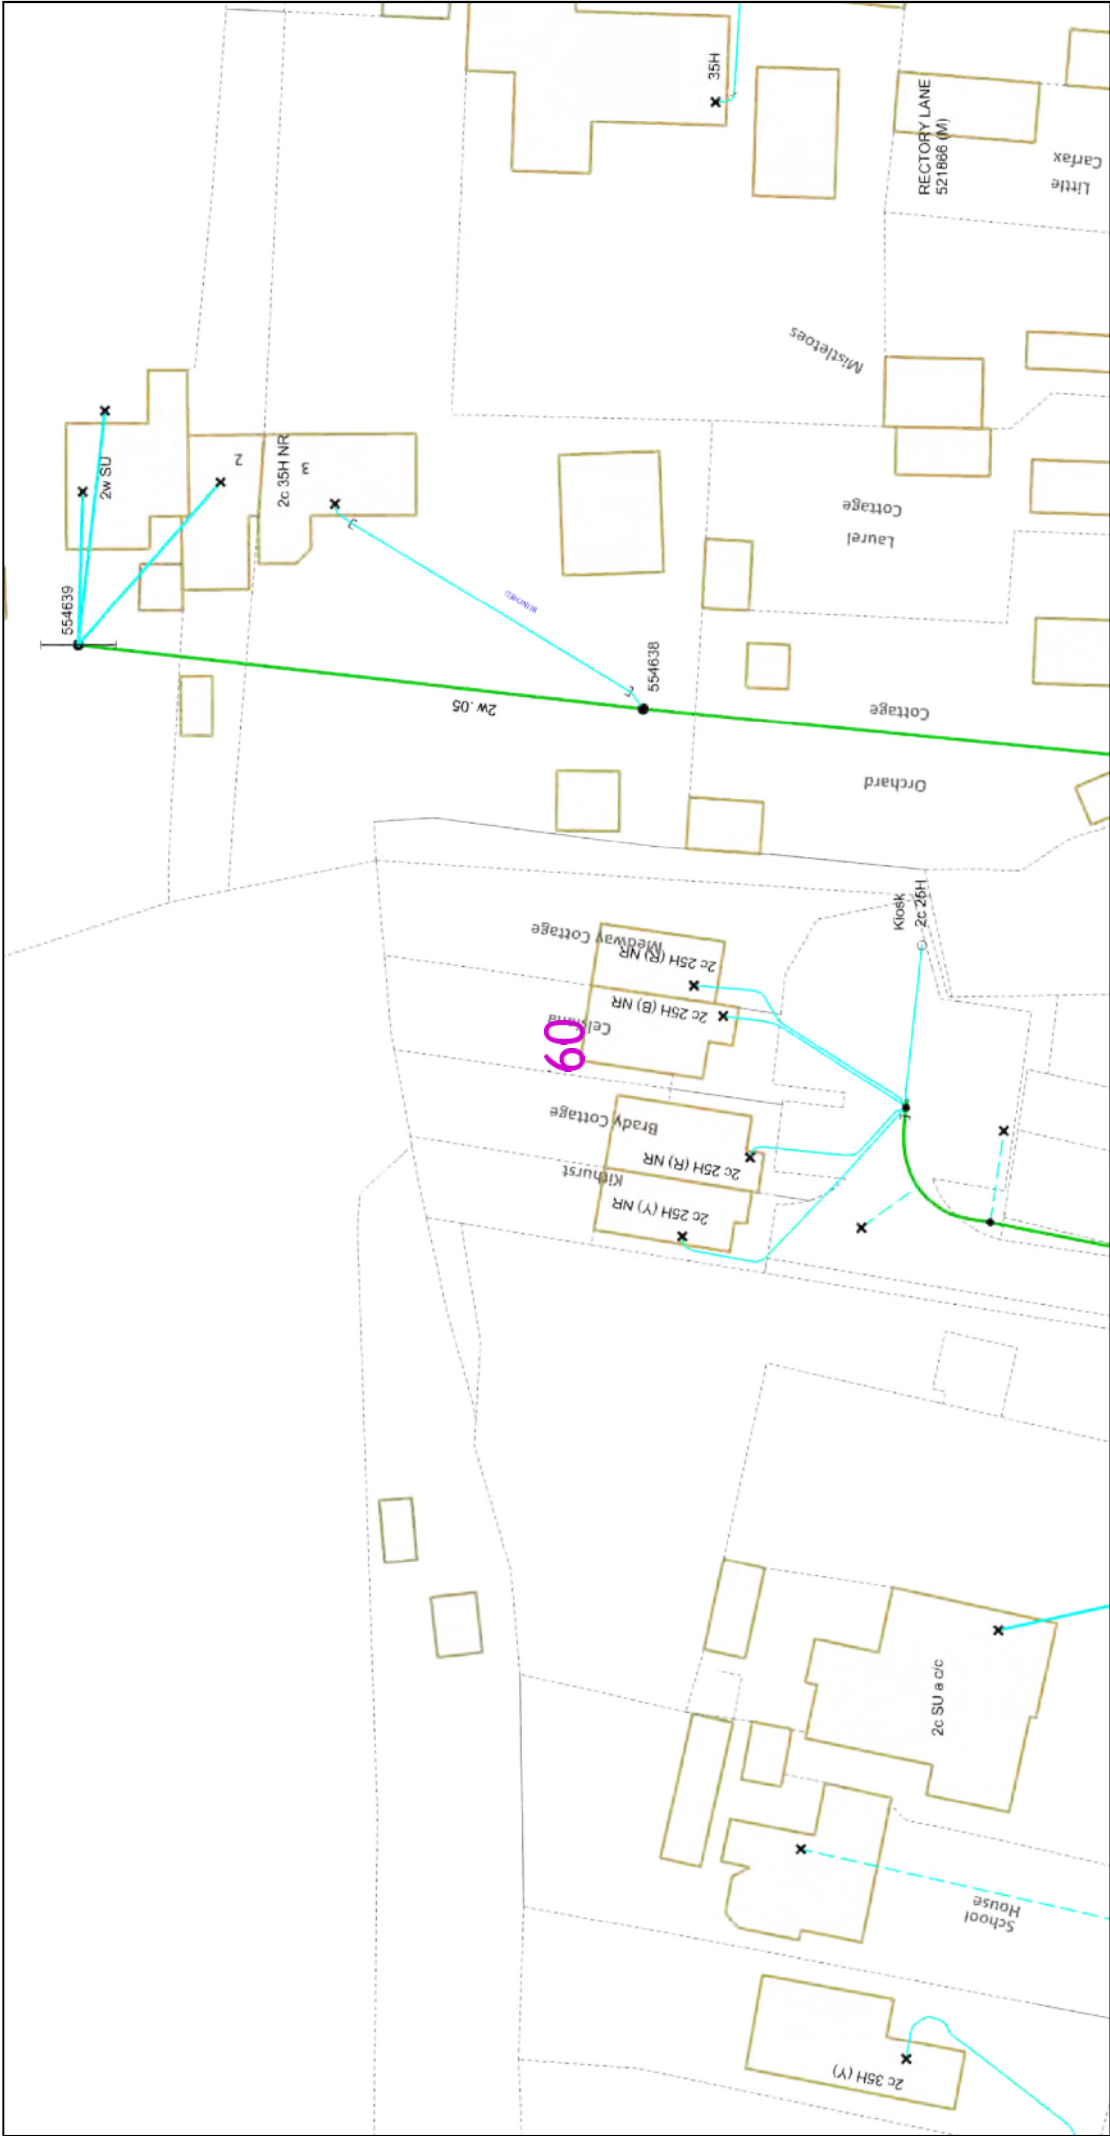

This plan must be used with the attached 'Symbols' document. Date requested: 27/02/2026 Job Reference: 40622801 Site Location: 512247 116283 Requested by: Mr Ben Evans Your Scheme/Reference: 264092/SAK Scale: 1:500 (When plotted at A4)		1. The position of the apparatus shown on this drawing is believed to be correct but the original landmarks may have been altered since the apparatus was installed. 2. The information provided must be given to all people working near UK Power Networks plant and to excavation using suitable hand tools. 3. It is essential that trial holes are carefully made avoiding the use of mechanical tools or picks until the exact location of all the cables have been determined. 4. It must be assumed that there is a service cable into each property, lamp column and street sign, etc. 5. All cables must be treated as being live unless proved otherwise by UK Power Networks. 6. The information provided must be given to all people working near UK Power Networks plant and to excavation using suitable hand tools. 7. Please be aware that electric cables/lines belonging to other owners of licensed electricity distribution systems may be present and it is your responsibility to identify their location. 8. Please be aware the Low Voltage Overhead power lines are not currently displayed for the Eastern Region via this service. If you require records on the location of these please contact our Plan Provision team directly via plans@ukpowernetworks.co.uk		1. UK Power Networks does not warrant that the information provided to you is correct. You rely upon it at your own risk. UK Power Networks does not exclude or limit its liability if it causes the death of any persons or causes personal injury to a person. 2. Subject to paragraph 2 UK Power Networks has no liability to you in contract, in tort (including negligence), for breach of statutory duty or otherwise for any loss, damage, cost, claims, demands, or expenses that you or any third party may suffer or incur as a result of using the information provided whether for physical damage to property or for any economic loss (including without limitation loss of profit, loss of opportunity, loss of savings, loss of goodwill, loss of business, loss of use) or any special or consequential loss or damage whatsoever. 3. This plan has been provided to you on the basis of the terms of use set out in the covering letter that accompanies this plan and must not be used for any other purpose and the terms of use set out in the covering letter you must not use the plan and must return it to the sender of the letter. 4. You are responsible for the security of the information provided to you. It must not be given, sold or made available upon payment of a fee to a third party. 5. Please Note: The Overview map does not display UK Power Networks electricity network and should not be used for the location of UK Power Networks assets. For detail of the electricity network please view the relevant page as highlighted in the Overview map.		IF IN DOUBT - ASK! PHONE 0800 056 5866 EMERGENCY - If you damage a cable or line Phone 0800 783 8838 (24hrs) URGENTLY		LOOK UP		ALWAYS LOOK UP BEFORE YOU START WORK Refer to HSE Guidance note G56	
Maps produced at 1:500 scale are GeoSchematics which show LV mains cables and overhead lines (in some cases all voltages). Prior to carrying out excavations you must refer to the 1:500 records to determine the location of all known underground plant and equipment. Maps produced by permission of Ordnance Survey on behalf of HMSO. © Crown copyright and database rights 2026. All rights reserved. Ordnance Survey Licence numbers 100019626, 100019826 and 100019450. Data has been added to the Ordnance Survey base map; all proprietary rights in such additional data are and shall remain the exclusive property of © London Power Networks plc or South Eastern Power Networks plc each Being a Distribution Licensee under section 6(1)(G) of the Electricity Act 1989 for the relevant distribution services area as that term is defined in such licensee's distribution licence. All rights in such data reserved. Plans generated by DigSAFE Pro™ software provided by LinesearchbeforeDigging.											

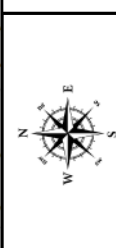

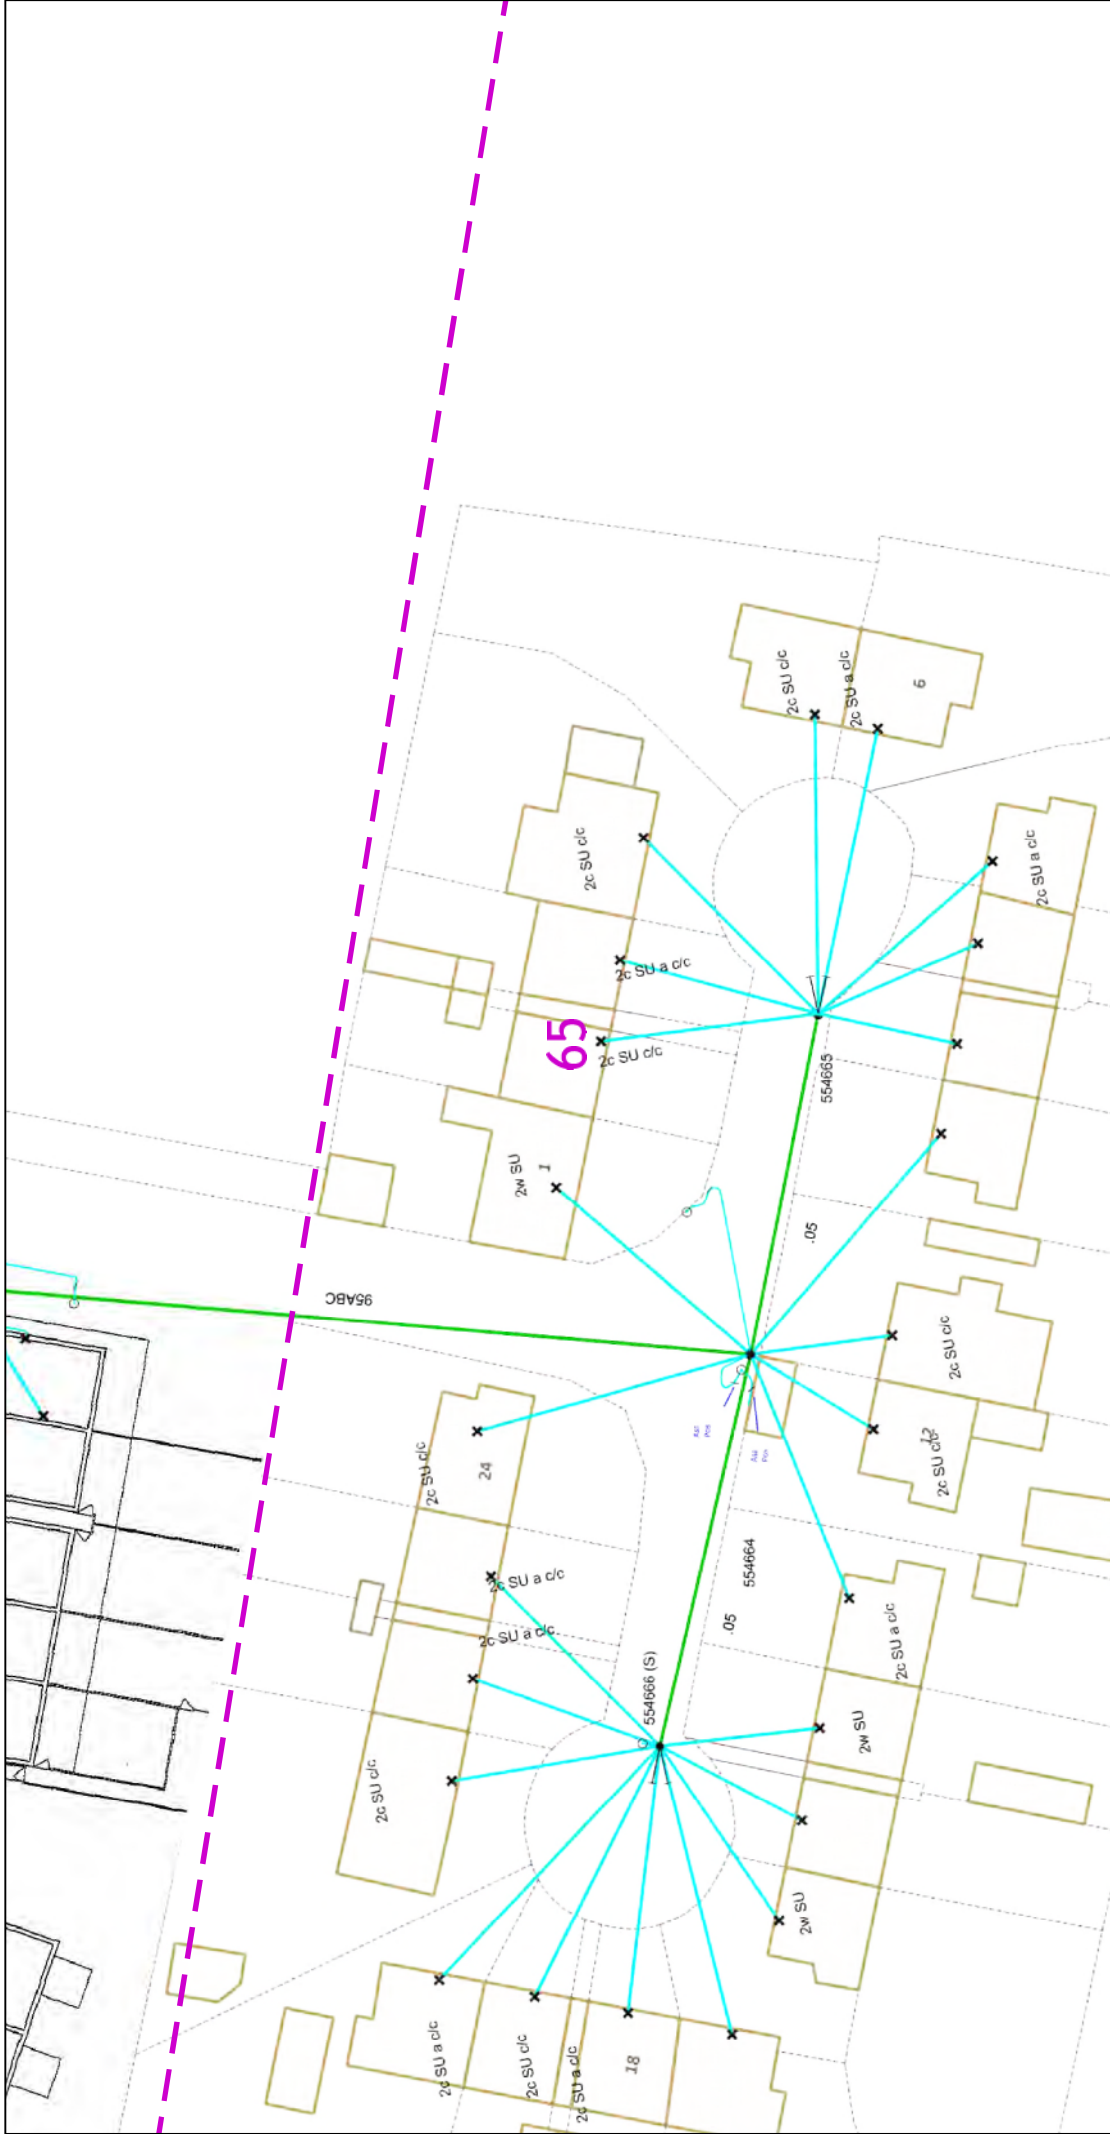

IF IN DOUBT - ASK! PHONE
0800 056 5866
EMERGENCY - if you damage a
cable or line
Phone 0800 783 8838 (24hrs)
URGENTLY

ALWAYS LOOK UP
BEFORE
YOU START WORK
Refer to HSE Guidance
note G56

This plan must be used with the
attached 'Symbols' document.

Date Requested: 27/02/2026

Job Reference: 40622801

Site Location: 512247 116283

Requested by: Mr Ben Evans

Your Scheme/Reference:
264092/SAK

Scale: 1:500 (When plotted at A4)

1. The position of the apparatus shown on this drawing is believed to be correct but the original
landmarks may have been altered since the apparatus was installed.

2. The information provided must be given to all people working near UK Power Networks plant and
until the exact location of all the cables have been determined.

3. It is essential that trial holes are carefully made avoiding the use of mechanical tools or picks
until the exact location of all the cables have been determined.

4. It must be assumed that there is a service cable into each property, lamp column and street sign,
etc.

5. All cables must be treated as being live unless proved otherwise by UK Power Networks.

6. The information provided must be given to all people working near UK Power Networks plant and
until the exact location of all the cables have been determined.

7. Please be aware that electric cables/lines belonging to other owners of licensed electricity
distribution systems may be present and it is your responsibility to identify their location.

8. Please be aware the Low Voltage Overhead power lines are not currently displayed for the Eastern
Region via this service. If you require records on the location of these please contact our Plan
Provision team directly via plans@ukpowernetworks.co.uk

1. UK Power Networks does not warrant that the information provided to you is correct. You rely upon it at your own
risk. UK Power Networks does not exclude or limit its liability if it causes the death of any persons or causes personal injury
to a person.


2. Subject to paragraph 2 UK Power Networks has no liability to you in contract, in tort (including negligence), for breach
of statutory duty or otherwise for any loss, damage, cost, claims, demands, or expenses that you or any third party may
suffer or incur as a result of using the information provided whether for physical damage to property or for any economic
loss (including without limitation loss of profit, loss of opportunity, loss of savings, loss of goodwill, loss of business, loss
of use) or any special or consequential loss or damage whatsoever.

4. This plan has been provided to you on the basis of the terms of use set out in the covering letter that accompanies
this plan and must remain the property of UK Power Networks. You must not use the plan or the information contained in it for any other purpose than the one for which it was provided to you.

5. You are responsible for the security of the information provided to you. It must not be given, sold or made available
upon payment of a fee to a third party.

6. Please Note: The Overview map does not display UK Power Networks electricity network and should not be used for
the location of UK Power Networks assets. For detail of the electricity network please view the relevant page as
highlighted in the Overview map.


Reproduced by permission of Ordnance Survey on behalf of HMSO. © Crown copyright and database rights 2026. All rights reserved. Ordnance Survey Licence numbers 100019626, 100019626 and 100019450. Data has been added to the Ordnance Survey base map; all proprietary rights in such additional data are and shall remain the exclusive
property of © London Power Networks plc or South Eastern Power Networks plc each being a distribution licensee under section 6(1)(c) of the Electricity Act 1989 for the relevant distribution services area as that term is defined in such licensee's distribution licence. All rights in such data reserved.
Plans generated by DigSAFE Pro™ software provided by LinesearchbeforeUd.

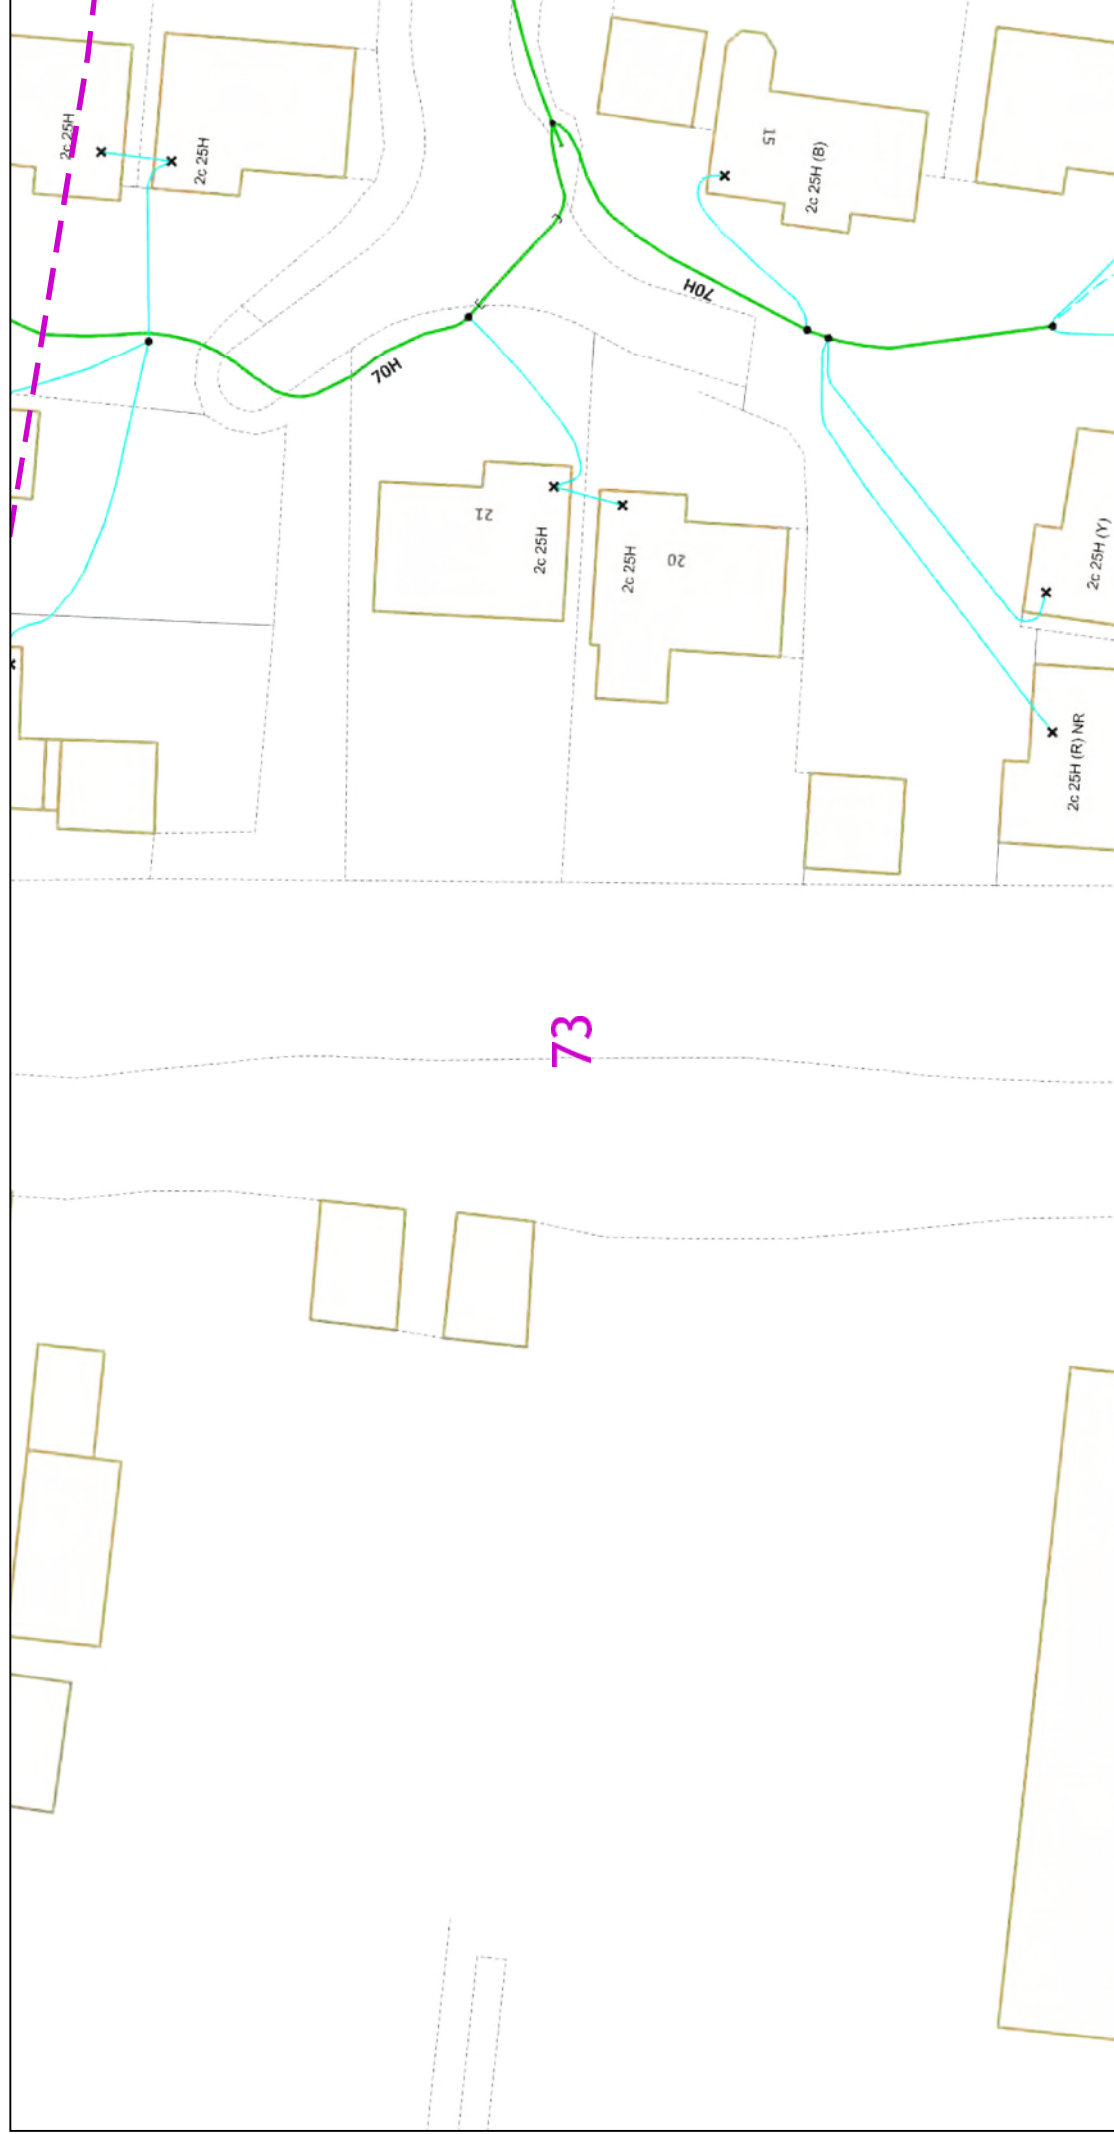


Sites: ---- Area: ---- Line: ----

The quality and accuracy of any print will depend on your printer, your computer and its print settings. Measurements scaled from this plan may not match measurements between the same points on the ground.

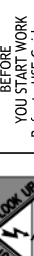


		IF IN DOUBT - ASK! PHONE 0800 056 5866 EMERGENCY - If you damage a cable or line Phone 0800 783 8838 (24hrs) URGENTLY		ALWAYS LOOK UP BEFORE YOU START WORK Refer to HSE Guidance note G56
This plan must be used with the attached 'Symbols' document. Date Requested: 27/07/2026 Job Reference: 4062Z801 Site Location: 512247 116283 Requested by: Mr Ben Evans Survey/Reference: 264092/SAK Scale: 1:500 (When Plotted at A4)	1. The position of the apparatus shown on this drawing is believed to be correct but the original landmarks may have been altered since the apparatus was installed. 2. The exact position of the apparatus should be verified - use approved cable avoidance tools prior to excavation using suitable hand tools. 3. Any third party made avoiding the use of mechanical tools or picks until the exact location of all the cables have been determined. 4. It must be assumed that there is a service cable into each property, lamp column and street sign, etc. 5. All cables must be treated as being live unless proved otherwise by UK Power Networks. 6. The information provided must be given to all people working near UK Power Networks plant and equipment. 7. Please be aware that electric cables/lines belonging to other owners of licensed electricity distribution systems may be present and it is your responsibility to identify their location. 8. Please be aware the Low Voltage Overhead power lines are not currently displayed for the Eastern Region via this service, If you require records on the location of these please contact our Plan Provision team directly via plans@ukpowernetworks.co.uk	1. UK Power Networks does not warrant that the information provided to you is correct. You rely upon it at your own risk. 2. UK Power Networks does not exclude or limit its liability if it causes the death of any persons or causes personal injury to a person. 3. Paragraph 2 UK Power Networks has no liability to you in contract, in tort (including negligence), for breach of statutory duty or otherwise for any loss, damage, cost, claims, demands, or expenses that you or any third party may suffer or incur as a result of using the information provided whether for physical damage to property or for any economic loss (including without limitation loss of profit, loss of opportunity, loss of savings, loss of goodwill, loss of business, loss of use) or any special or consequential loss or damage whatsoever. 4. This plan has been provided to you on the basis of the terms of the use set out in the covering letter that accompanies this plan. You do not accept and do not intend to understand the terms of use set out. In the covering letter you must not use the plan and you must not rely on the information provided to you. 5. You are responsible for the security of the information provided to you. It must not be given, sold or made available upon payment of a fee to a third party. 6. Please Note: The Overview map does not display UK Power Networks electricity network and should not be used for the location of UK Power Networks assets. For detail of the electricity network please view the relevant page as highlighted in the Overview map.	Maps produced at 1:2500 scale are GeoSchematics which show LV mains cables and overhead lines (in some cases all voltages). Prior to carrying out excavations you must refer to the 1:500 records to determine the location of all known underground plant and equipment.	Reproduced by permission of Ordnance Survey on behalf of HMSO. © Crown copyright and database rights 2026. All rights reserved. Ordnance Survey Licence numbers 100019626, 100019626 and 100019450. Data has been added to the Ordnance Survey base map; all proprietary rights in such additional data are and shall remain the exclusive property of © London Power Networks plc or Eastern Power Networks plc each being a distribution licensee under section 61(1)(c) of the Electricity Act 1989 for the relevant distribution services area as that term is defined in such licensee's distribution licence. All rights in such data reserved. Plans generated by DigSafe Pro™ software provided by LinsearchbeforeUdig.

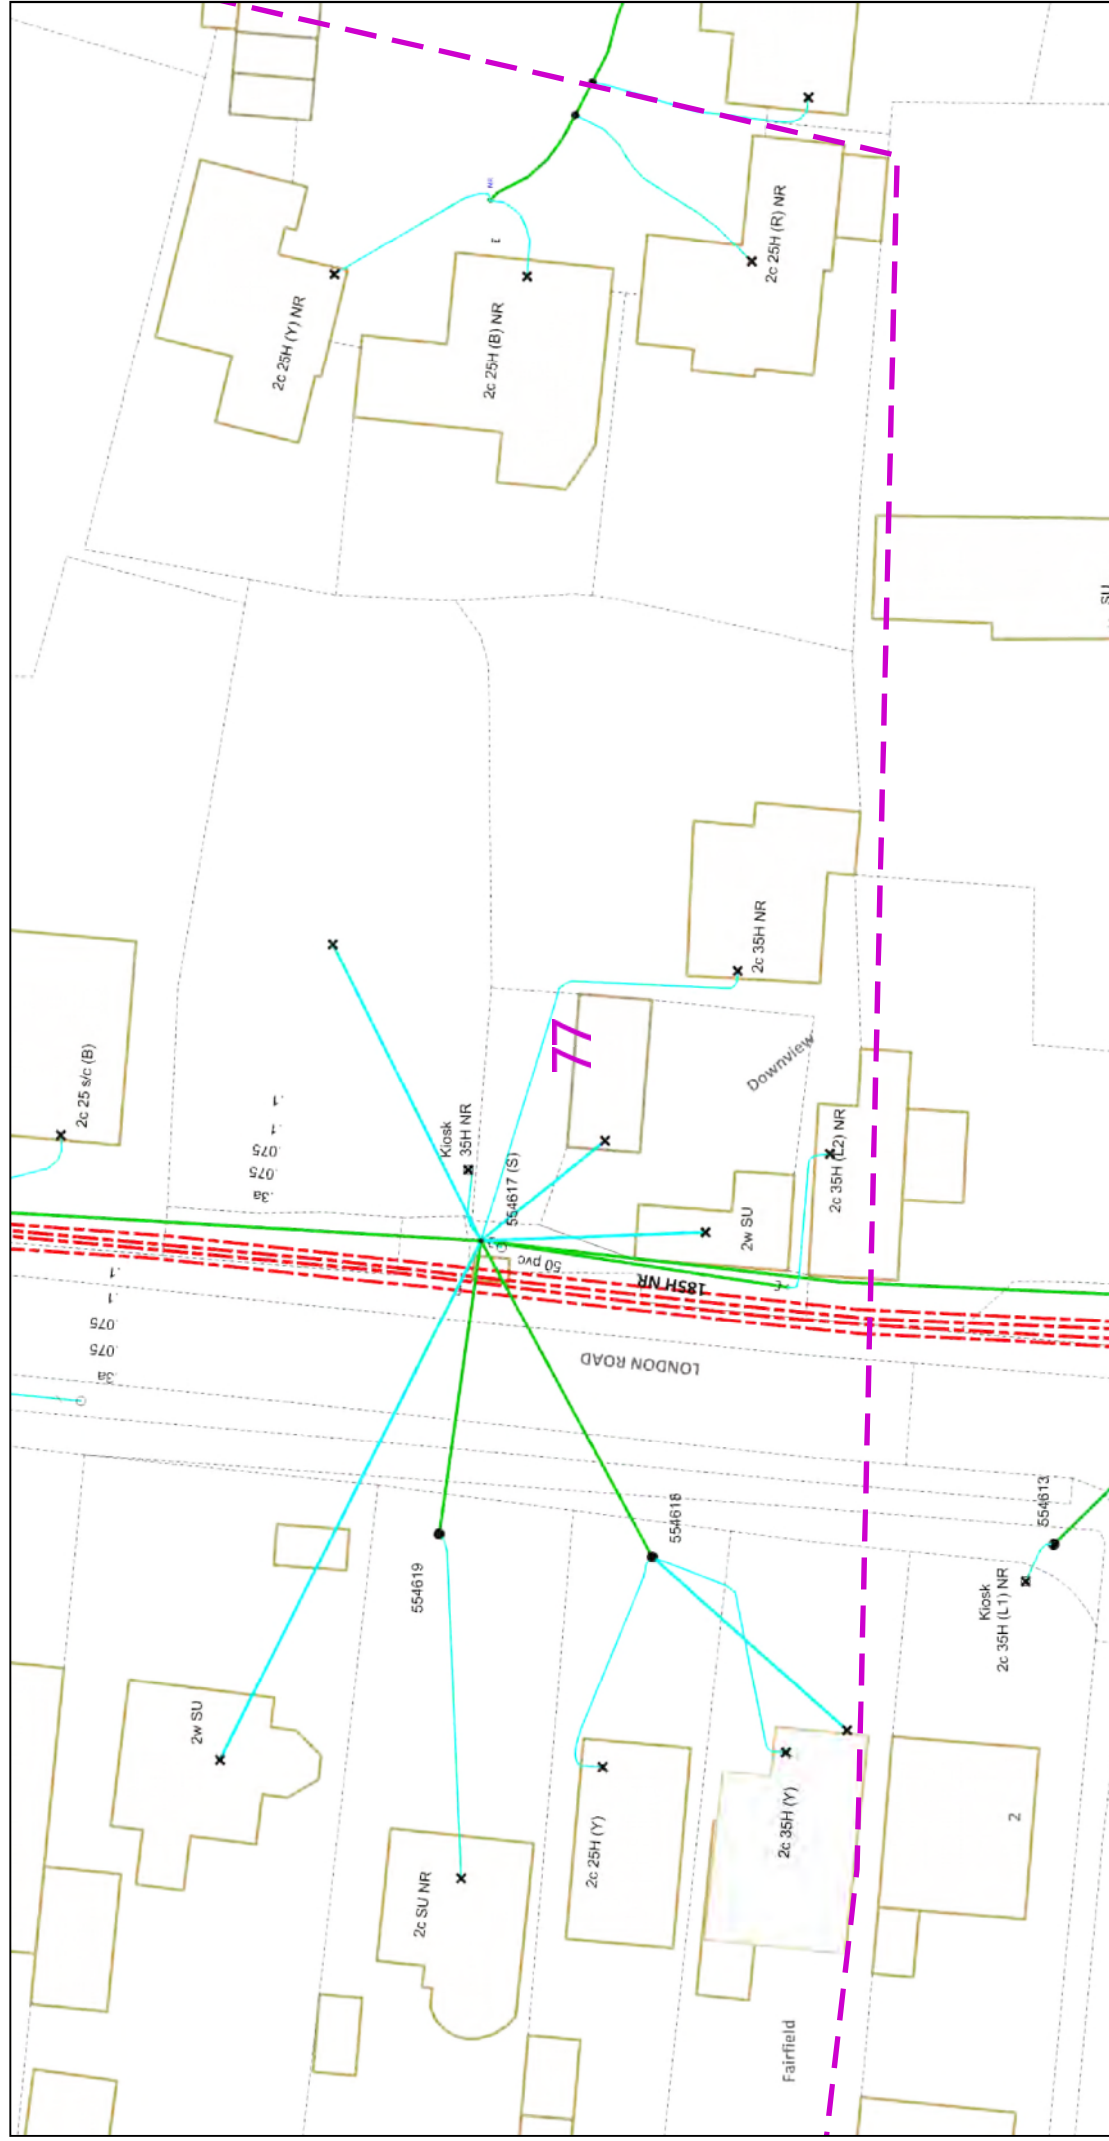


0 12.5 25
metres

Dig Sites  **Area:**  **Line:** 

The quality and accuracy of any print will depend on your printer, your computer and its print settings. Measurements scaled from this plan may not match measurements between the same points on the ground.

 N



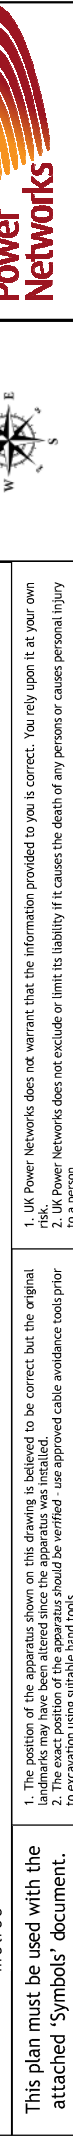

Date Requested: 27/02/2026 Job Reference: 4062801 Site Location: 512247 116283 Requested by: Mr Ben Evans		IF IN DOUBT - ASK! PHONE 0800 056 5866 EMERGENCY - If you damage a cable or line Phone 0800 783 8838 (24hrs) URGENTLY			ALWAYS LOOK UP BEFORE YOU START WORK Refer to HSE Guidance note C56
--	--	---	--	---	--

3. Subject to paragraph 2 UK Power Networks has no liability to you in contract, in tort (including negligence), for breach of statutory duty or otherwise for any loss, damage, costs, claims, demands, or expenses that you or any third party may suffer or incur as a result of using the information provided whether for physical damage for any economic loss (including without limitation loss of profit, loss of opportunity, loss of savings, loss of goodwill, loss of business, loss of use) or any special or consequential loss or damage whatsoever.

4. This plan has been provided to you on the basis of the terms of use set out in the covering letter that accompanies this plan. If you do not accept and/or do not understand the terms of use set out in the covering letter you must not use the plan and must return it to the sender of the letter.

5. All cables must be treated as being live unless proved otherwise by UK Power Networks.

6. The information provided must be given to all people working near UK Power Networks plant and equipment. Do not use plans more than 3 months after the issue date for excavation purposes.

7. Please be aware that electric cables/lines belonging to other owners of licensed electricity

Your Scheme/Reference:
264097 / 5AK
Date: 1/500 (When plotted at A4)

7. Please be aware the Low Voltage Overhead power lines are not currently displayed for the Eastern Region with this scheme. To enquire records on the location of these please contact our Planning team directly via plan@powernetworks.co.uk.

8. Please be aware the Low Voltage Overhead power lines are not currently displayed for the Eastern Region with this scheme. To enquire records on the location of these please contact our Planning team directly via plan@powernetworks.co.uk.


9. You are responsible for the security of the information provided to you. It must not be given, sold or made available upon payment of a fee to a third party.

10. The map does not display UK Power Networks electricity network and should not be used for the location of UK Power Networks assets. For detail of the electricity network please view the relevant page as highlighted in the Overview page.

11. Maps produced at 1:2500 scale are GeoSchematics which show LV mains cables and overhead lines (in some cases all voltages). Prior to carrying out excavations you must refer to the 1:500 records to determine the location of all known underground plant and equipment.

Reproduced by permission of Ordnance Survey on behalf of HMSO. © Crown copyright and database rights 2026. All rights reserved. Ordnance Survey licence numbers: 100019626, 100019826 and 100019450. Data has been added to the Ordnance Survey base map; all proprietary rights in such additional data are and shall remain the exclusive property of © London Power Networks plc or Eastern Power Networks plc or South Eastern Power Networks plc each being a distribution licensee under section 61(c) of the Electricity Act 1989 for the relevant distribution services area as that term is defined in such licensee's distribution licence. All rights in such data reserved.

Plans generated by DigSAFE Pro™ software provided by Linesearchbeforelding.

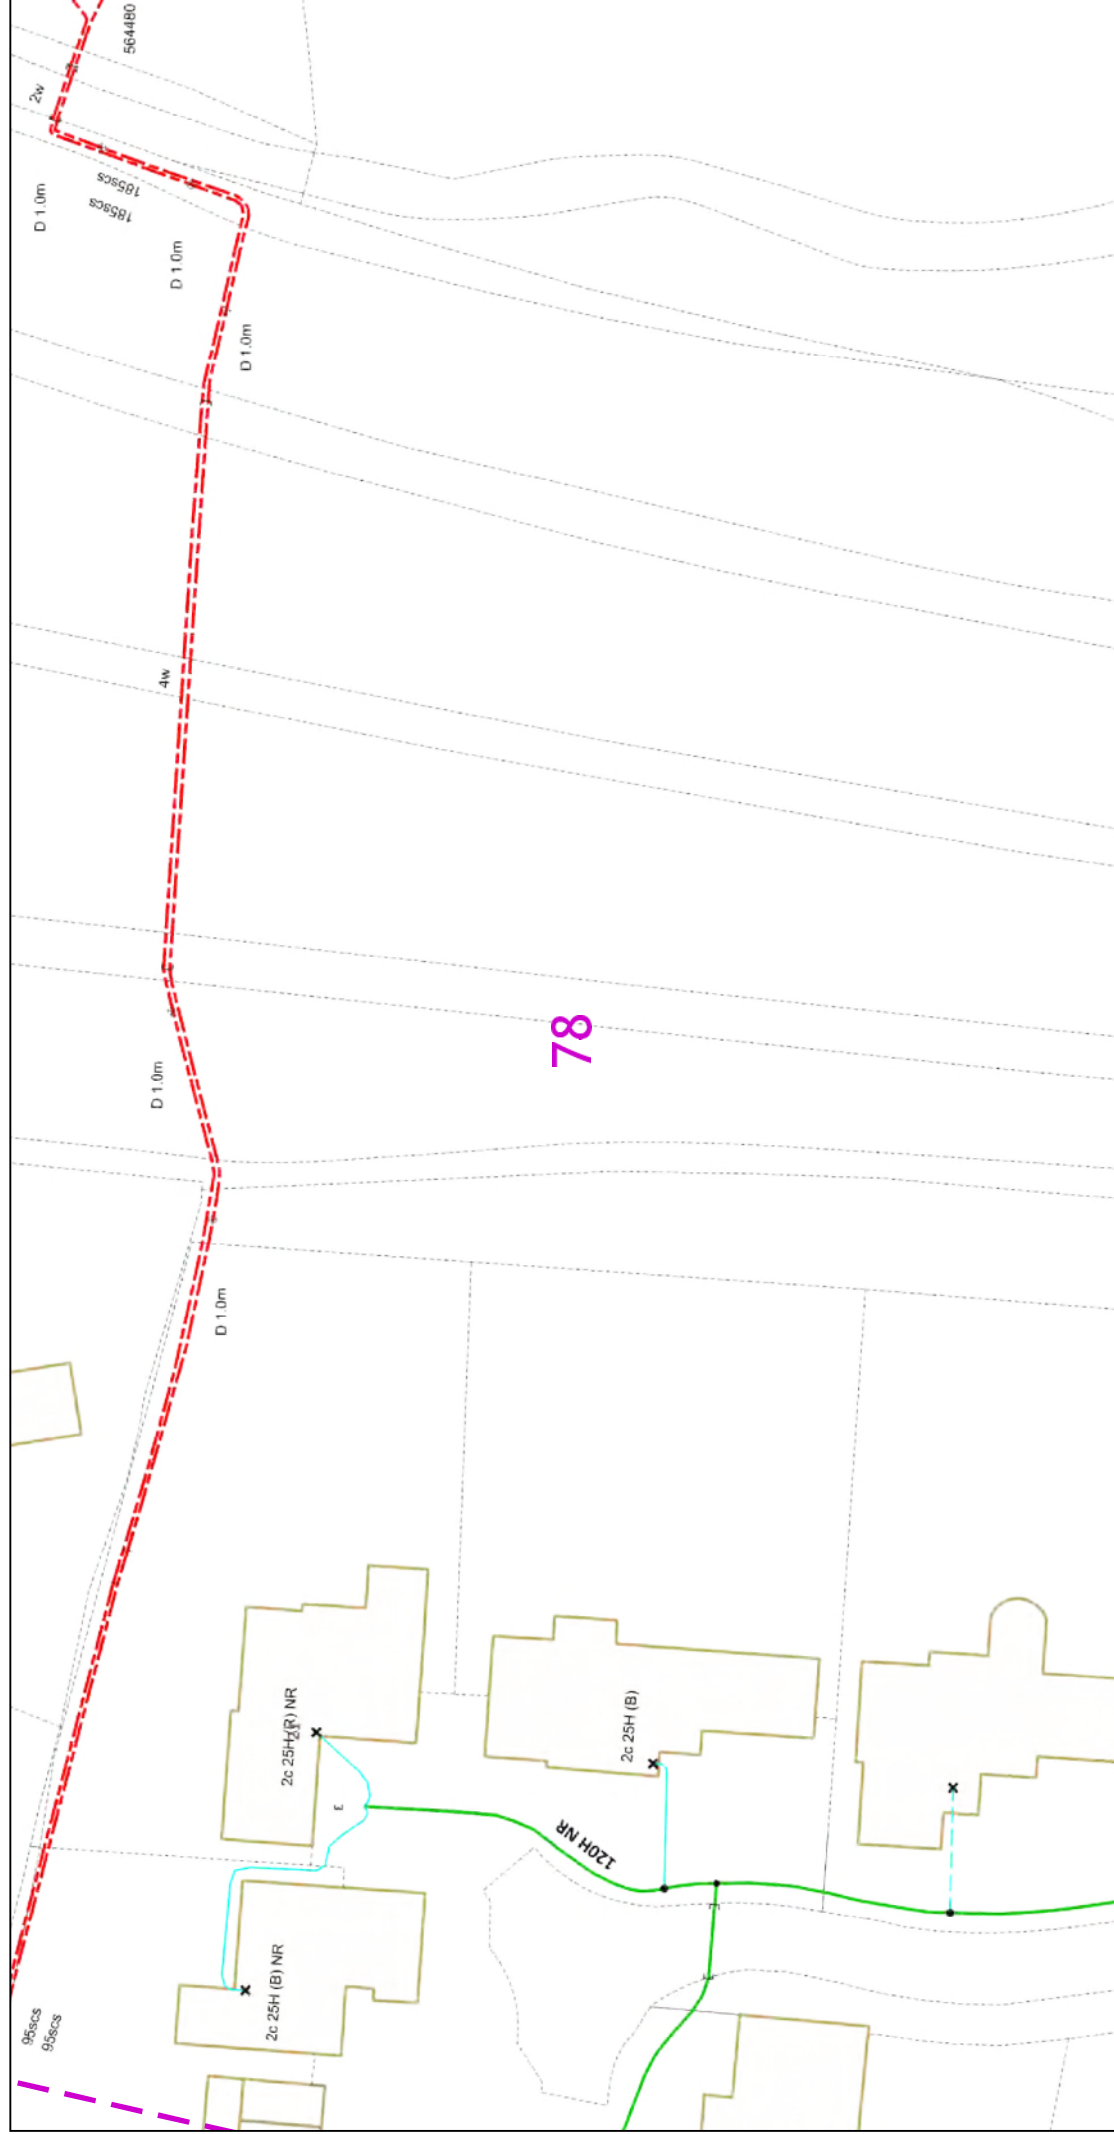

The quality and accuracy of any print will depend on your printer, your computer and its print settings. Measurements scaled from this plan may not match measurements between the same points on the ground.

1. UK Power Networks does not warrant that the information provided to you is correct. You rely upon it at your own risk.
2. UK Power Networks does not exclude or limit its liability if it causes the death of any persons or causes personal injury to a person.
3. See paragraph 7 UK Power Networks has no liability to you in contract, in tort (including negligence), for breach of statutory duty or otherwise for any loss, damage, cost, claims, costs, or expenses that you or any third party may suffer or incur as a result of using the information provided whether for physical damage to property or for any economic loss (including limitation loss of profit, loss of opportunity, loss of savings, loss of goodwill, loss of business, loss of use) or any special or consequential loss or damage whatsoever.
4. This plan has been provided to you on the basis of the terms of use set out in the covering letter that accompanies this plan. If you do not accept and/or do not understand the terms of use set out in the covering letter you must not use the plan and must return it to the sender of the letter.
5. You are responsible for the security of the information provided to you. It must not be given, sold or made available to any third party.
6. Any payment of a fee to a third party.
7. UK Power Networks does not display UK Power Networks electricity network and should not be used for the location of UK Power Networks assets. For detail of the electricity network please view the relevant page as highlighted in the Overview map.


1. The position of the apparatus shown on this drawing is believed to be correct but the original landmarks may have been altered since the apparatus was installed.
2. The exact position of the apparatus should be verified - use approved cable avoidance tools prior to excavation and/or ground rods.
3. If the location of the trial borehole successfully made avoiding the use of mechanical tools or picks until the exact location of all cables have been determined.
4. It must be assumed that there is a service cable into each property, lamp column and street sign, etc.
5. All cables must be treated as live unless proved otherwise by UK Power Networks.
6. The information provided must be given to all people working near UK Power Networks plant and equipment. Do not use plants more than 3 months after the issue date for excavation purposes.
7. Please be aware that electric cables/lines belonging to other owners of licensed electricity distribution systems may be present and it is your responsibility to identify their location.
8. Please be aware the Low Voltage Overhead power lines are not currently displayed for the Eastern Region.

Provision team directly via plans@ukpowernetworks.co.uk


This plan must be used with the attached 'Symbols' document.
Date Requested: 27/02/2026 Job Reference: 40622801 Site Location: 512247 116283 Requested by: Mr Ben Evans Your Scheme/Reference: 264092 / SAK Scale: 1:500 (When plotted at A4)

Reproduced by permission of Ordnance Survey on behalf of HMSO. © Crown copyright and database rights 2026. All rights reserved. Ordnance Survey Licence numbers 100019826 and 100019450. Data has been added to the Ordnance Survey base map; all proprietary rights in such additional data are and shall remain the exclusive property of © London Power Networks plc or Eastern Power Networks plc each being a distribution licensee under section 6(1)(c) of the Electricity Act 1989 for the relevant distribution services area as that term is defined in such licensee's distribution licence. All rights in such data reserved.

Plans generated by DigSAFE Pro™ software provided by LineasafebeforeUdId.

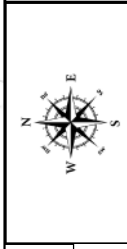

**ALWAYS LOOK UP
BEFORE
YOU START WORK**
Refer to HSE Guidance
note G56

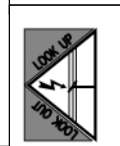

IF IN DOUBT - ASK! PHONE
0800 056 5866
EMERGENCY - If you damage a
cable or line
Phone 0800 783 8838 (24hrs)
URGENTLY

Maps produced at 1:2500 scale are Geo-Schematics which show LV mains cables and overhead lines (in some cases all voltages). Prior to carrying out excavations you must refer to the 1:500 records to determine the location of all known underground plant and equipment.